THE GARDENS AT NORTH CAREFREE EL PASO COUNTY, COLORADO PUD DEVELOPMENT / PRELIMINARY PLAN

GENERAL PROVISIONS:

- Authority. This PUD is authorized by Chapter 4 of the El Paso County Land Development Code, adopted pursuant to the Colorado Planned Unit Development Act of 1972, as amended.
- B. Applicability. The provisions of this PUD shall run with the land. The landowners, their successors, heirs, or assigns shall be bound by this Development Plan, as amended and approved by the Planning and Community Development Director or Board of County Commissioners.
- C. Adoption. The adoption of this development plan shall evidence the findings and decisions of the El Paso County Board of County Commissioners that this Development Plan for The Gardens at North Carefree is in general conformity with the El Paso County Master Plan, El Paso County Policy Plan and applicable Small Area Plan; is authorized under the provision of the El Paso County Land Development Code; and that the El Paso County Land Development Code and this development plan complies with the Colorado Planned Unit Development Act of 1972, as amended.
- Relationship to County Regulations. The provisions of this Development Plan shall prevail and govern the development of The Gardens at North Carefree, provided, however, that where the provisions of this Development Plan do not address a particular subject, the relevant provisions of the El Paso County Land Development Code in effect at the time of the PUD plan approval (or owner acknowledge the PUD changes with the Code), or any other applicable resolutions or regulations of El Paso County, shall be applicable.
- E. Enforcement. To further the mutual interest of the residents, occupants, and owners of the PUD and of the public in the preservation of the integrity of this development plan, the provisions of this plan relating to the use of land and the location of common open space shall run in favor of El Paso County and shall be enforceable at law or in equity by the County without limitation on any power or regulation otherwise granted by law.
- F. Conflict. Where there is more than one provision within the development plan that covers the same subject matter, the provision which is most restrictive or imposes higher standards or requirements shall govern.
- G. Maximum Level of Development. The total number of dwellings or the total commercial, business, or industrial intensity shown on the development plan for development within the specified planning areas is the maximum development requested for platting or construction (plus any approved density transfers). The actual number of dwellings or level of development may be less due to subdivision or Site Development Plan requirements, land carrying capacity, or other requirements of the Board of County Commissioners.
- Project Tracking. At the time of any final plat application, the applicant shall provide a summary of the development, to date, to Planning and Community Development, in order to assure maximum development limits are not exceeded.
- Overall Project Standards. The standard zoning requirements of El Paso County Land Development Code, as amended, including off-street parking, landscaping, site development, accessory and temporary uses, and use by special review and variance processes shall apply to this PUD, except as modified

no additional uses/allowances were added. This is a PUD where the developer dictates the allowances and standards. Staff recommends reviewing and considering additional uses.


DEVELOPMENT GUIDELINES:

- A. <u>Project Description</u>: The Gardens at North Carefee is a planned residential community on 11.56 acres of land located Southeast of N. Carefree Circle and Akers Drive. The project is planned as a single family detached community with a main looping road and centralized open spaces.
- B. Permitted Uses: Permitted uses within the The Gardens at North Carefree subdivision include single family detached, and single family attached dwelling units, open space, and trails. The use of any property within the subdivision as a Child Care Center, Family Care Home or Group Home shall be subject to the regulations of Chapter 5 of the El Paso County Land Development Code, as may be amended. Marijuana Clubs and Marijuana Grow Facilities are not permitted within this subdivision.
- C. Temporary Uses: Temporary uses are limited to model home/subdivision sales office, yard sales, and seasonal produce sales, and are subject to the regulations of Chapter 5 of the El Paso County Land Development Code, as may be amended.
- D. Accessory Uses: Accessory uses shall be subject to the regulations of Chapter 5 of the El Paso County Land Development Code, as may be amended. Accessory uses within this subdivision are limited to the following:


Animal keeping of up to 4 pets (excludes chicken, pigeon or bee keeping). Residential home occupation.


- E. Accessory Structures. Accessory structures are not permitted either within the lot or within the common open space owned & maintained by the Home
- F. Signs. Signs shall be permitted to identify entryways to The Gardens at North Carefree community. The maximum size of the Community Entryway Sign shall be 100 square feet with a maximum height of (6) feet. Sign size shall be measured by drawing the smallest rectangle around the text of the sign. For double sided signs, only one sign face shall contribute to the maximum size.
- G. Development Standards.
 - Maximum building height: thirty-five (35) feet. Setback minimums:
 - Front: 10' Minimum (20' minimum from back of sidewalk to front of garage)
 - Side: 5' Minimum (15' for corner lots) Rear: 10' Minimum
 - Minimum Lot Width: 45' at garage setback.
 - Minimum Lot Size: 3,100 sf
 - No projections into the tracts owned and maintained by The Gardens at North Carefree will be permitted.
- H. <u>Streets</u>. Streets within The Gardens at North Carefree subdivision provide general vehicular circulation throughout the development. All Streets shall be paved unless otherwise indicated on the Development Plan. Sidewalks will be provided as illustrated on this plan.


LOT TYPICALS:

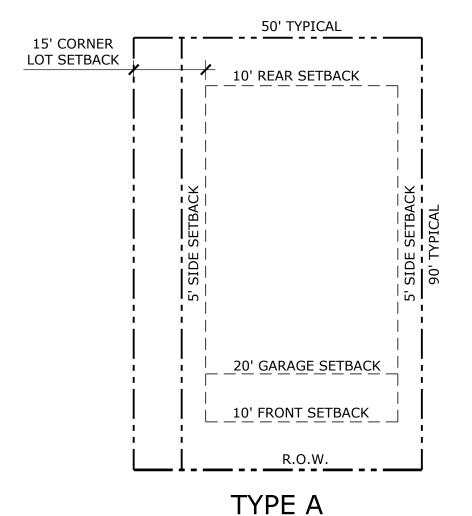

45' TYPICAL 10' REAR SETBACK 20' GARAGE SETBACK 10' FRONT SETBACK

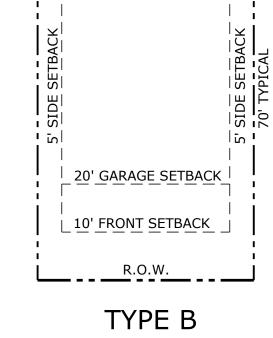

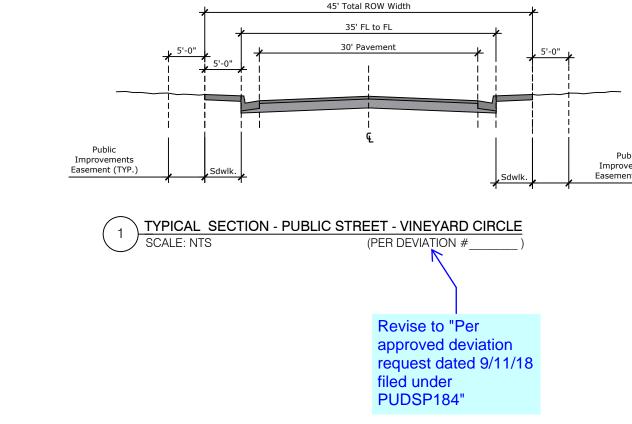

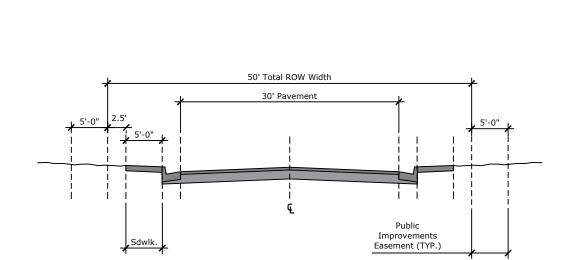

TYPICAL SECTION - PUBLIC STREET - FALLOW LN. & RUNNING DEER WAY

LEGAL DESCRIPTION

BEING LOT 2, MULE DEER BUSINESS PARK FILING NO.1 AND A TRACT OF LAND LOCATED IN THE EAST 1/2 OF SECTION 29, TOWNSHIP 13 SOUTH, RANGE 65 WEST OF THE 6TH PRINCIPAL MERIDIAN, EL PASO COUNTY COLORADO, MORE PARTICULARLY DESCRIBED AS FOLLOWS:

BEGINNING AT THE NORTHEAST CORNER OF AKERS DRIVE (80 FEET WIDE) AS PLATTED IN MULE DEER BUSINESS PARK FILING NO.1, RECORDED WITH RECEPTION NO. 206712353 IN THE RECORDS OF THE EL PASO COUNTY CLERK AND RECORDER, POINT BEING ON THE SOUTHERLY RIGHT-OF-WAY OF NORTH CAREFREE CIRCLE (120 FEET WIDE) AS PLATTED IN PRONGHORN MEADOWS FILING NO.1, RECORDED WITH RECEPTION NO. 202165571 OF SAID RECORDS;

THE FOLLOWING FIVE (5) COURSES ARE ON THE EASTERLY RIGHT-OF-WAY OF SAID AKERS DRIVE;

- 1) THENCE S00°41'40"E A DISTANCE OF 552.98 FEET TO A POINT OF CURVE TO THE LEFT;
- THENCE ON THE ARC OF SAID CURVE, HAVING A RADIUS OF 960.00 FEET, A DELTA ANGLE OF 04°35'19", AN ARC LENGTH OF 76.88 FEET, WHOSE LONG CHORD BEARS S02°59'19"E A DISTANCE OF 76.86 FEET;
- 3) THENCE S05°16'59"E A DISTANCE OF 277.56 FEET TO THE NORTHWEST CORNER OF LOT 2, OF SAID MULE DEER BUSINESS PARK FILING NO.1;
- THENCE S05°16'59"E ON THE WESTERLY LINE OF SAID LOT 2, A DISTANCE OF 142.31 FEET TO A POINT OF CURVE TO THE RIGHT;
- THENCE ON THE ARC OF SAID CURVE AND SAID WESTERLY LINE OF LOT 2, HAVING A RADIUS OF 1040.00 FEET, A DELTA ANGLE OF 03°59'26", AN ARC LENGTH OF 72.43 FEET, WHOSE LONG CHORD BEARS S03°17'16"E A DISTANCE OF 72.42 FEET TO THE SOUTHWEST CORNER OF SAID LOT 2;

THENCE N88°42'27"E ON THE SOUTH LINE OF SAID LOT 2, A DISTANCE OF 413.10 FEET TO THE SOUTHEAST CORNER OF SAID LOT 2;

THENCE N00°02'55"E ON THE EAST LINE OF SAID LOT 2, A DISTANCE OF 209.74 FEET TO THE NORTHEAST CORNER OF SAID LOT 2;

THENCE N00°02'55"E A DISTANCE OF 906.69 FEET TO A POINT ON THE SOUTHERLY RIGHT-OF-WAY OF SAID NORTH CAREFREE CIRCLE;


THENCE S89°18'20"W ON SAID SOUTHERLY RIGHT-OF-WAY, A DISTANCE OF 467.50 FEET TO THE POINT OF BEGINNING.

THE ABOVE TRACT OF LAND CONTAINS 503,669 SQUARE FEET OR 11.563 ACRES, MORE OR LESS.

TRACT TABLE

TRACT	SIZE	USE	OWNERSHIP	MAINTENANCE
А	33,727SF	Open space, public access, public utilities, drainage, landscaping, signage	The Gardens at North Carefree Metropolitan District	The Gardens at North Carefree Metropolitan District
В	6,034 SF	Open space, public access, trail, drainage, landscaping, landscape wall	The Gardens at North Carefree Metropolitan District	The Gardens at North Carefree Metropolitan District
С	3,607 SF	Open space, public access, public utilities, landscaping	The Gardens at North Carefree Metropolitan District	The Gardens at North Carefree Metropolitan District
D	4,194 SF	Open space, public access, public utilities, drainage, landscaping	The Gardens at North Carefree Metropolitan District	The Gardens at North Carefree Metropolitan District
Е	4,000 SF	Open space, public access, public utilities, landscaping	The Gardens at North Carefree Metropolitan District	The Gardens at North Carefree Metropolitan District
F	10,080 SF	Stormwater detention, drainage, landscaping, landscape wall	The Gardens at North Carefree Metropolitan District	The Gardens at North Carefree Metropolitan District
G	8,000 SF	Stormwater detention, drainage, landscaping,	The Gardens at North Carefree Metropolitan District	The Gardens at North Carefree Metropolitan District
Н	5,365 SF	Open space, public access, trail, drainage, landscaping, landscape wall	The Gardens at North Carefree Metropolitan District	The Gardens at North Carefree Metropolitan District
ı	11,115 SF	Private Road/Access, landscaping	To be dedicated to adj. property owner Yellow Jacket LLC	Yellow Jacket LLC


County Certification This rezoning request to PUD has been reviewed and found to be complete and in accordance with the _ (date) approving the PUD resolution or motion #) _ and all applicable El Paso County regulations. President, Board of County Commissioners Director, Planning & Community Development Department date

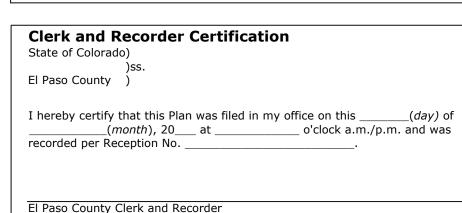



Refer to comment on the drainage report and revise accordingly

VICINITY MAP

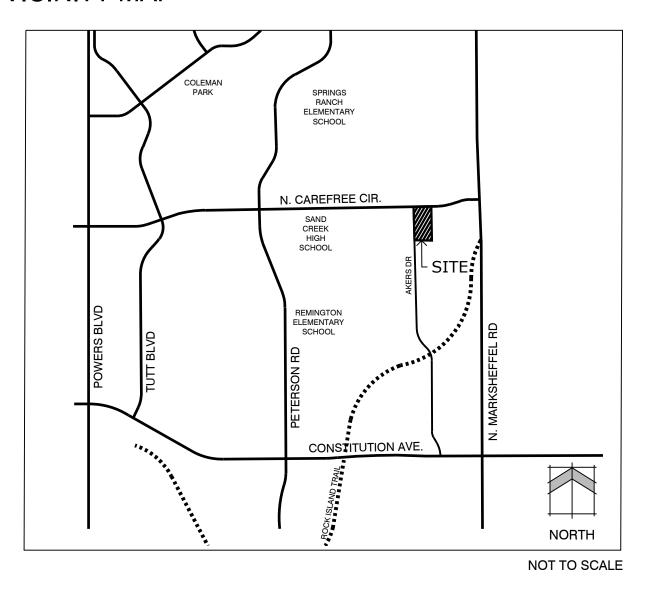

SITE DATA

OWNER/APPLICANT:

Mule Deer Investments LLC 2727 Glen Arbor Dr.

Colorado Springs, CO 80920

Tax ID Number: 5329411002 & 5329400012 11.56 acres

RR-5 & CS Current Zoning: Proposed Zoning: PUD Current Land Use: Vacant

Proposed Land Use: Single Family Detached Residential Number of Units:

6.14 DU/AC Density: **Building Height:**

Landscape Setbacks/Buffers: North Carefree Circle: 25' Landscape Setback

15' Landscape Setback Akers Drive: South Zone District Boundary: 15' Landscape Buffer East Boundary: 15' Landscape Buffer

10' Minimum (20' from back of sidewalk to front of garage) Front:

5' Minimum (15' on corner lots)

10' Minimum Open Space Provided = 56,927 sf (11%) (Tracts A, B, C, D, E, & H)

25% min. usable open space required (25% of 50,355) = 12,588 sf usable open space provided (Tracts B, C, D, & E) = 17,835 sf (31%)

GENERAL NOTES

Lot Building Setback:

- 1. See Final Landscape Plan for proposed buffering and screening from surrounding properties.
- 2. Facilities and common area landscape will be maintained by The Gardens at North Carefree Metropolitan
- 3. This site is not within a designated F.E.M.A. floodplain as determined by the flood insurance rate map,
- community panel number 08041C0276F, effective March 17, 1997. 4. There will be no direct lot access from Akers Drive & North Carefree Circle.
- 5. Geologic Hazards Disclosure Statement: Areas of the proposed subdivision have been found to be impacted by geologic conditions including artificial fill, loose or collapsible soils, and expansive soils. Mitigation can be achieved by proper engineering design and construction or avoidance. A map of the hazard areas and proposed mitigation measures can be found in the Soils, Geology, and Geologic Hazard Study prepared by Entech Engineering Inc., dated October 25, 2017 and revised August 6, 20188, and is held in the PUD Development/Preliminary Plan File (PUDSP-18-004) at the El Paso County Planning and Community Development Department.

PUD MODIFICATIONS

PUD Modification of ECM Figure 2-16: Urban Local Roadway Cross-Section The street section is modified to measure 45 feet from back of sidewalk to back of sidewalk. The modification reduces the ROW width and eliminates the 2.5-foot buffer on either side of the sidewalk and accommodates the site constraints, provides additional open space throughout the project, and provides the 175-foot minimum intersection distance along Running Deer Way.

New Development Stormwater Management E.C.M. Appendix I.7.1.B.

Appendix I Section I.7.1.B, first bullet point, of the El Paso County Engineering Criteria Manual states that all sites of development/redevelopment of one (1) acre or more shall provide water quality capture volume (WQCV) for the total site. We are requesting a deviation, in that Approximately 1.64 acres of 11.89 acres of the area inside the development boundary will not reach a proposed on-site water quality facility. Of the area inside the development boundary that will not reach a facility only 0.19 acres is proposed roadway, 0.64 acres is developed lots, the remaining 0.81 acres will be sloped areas at back of lots along exterior boundary. The reason these areas are not able to reach the WQCV's are due to the topography of the site. The Deviation Request is currently under review.

Civil Engineers:

31 Tejon Street, Suite 500

Colorado Springs, CO 80903

PROJECT CONTACTS

Planner & Landscape Architect: 619 N. Cascade Ave., Suite 200 Colorado Springs, CO 80903

SHEET INDEX

Sheet 9 of 10:

Sheet 10 of 10: Zoning Map

Revise to Preliminary Grading Plan. Remove sheets 4 and 5. **Review 2: Unresolved** Sheet 1 of 10: Development Plan

Sheet 2 of 10: Sheet 3 of 10: Grading Plan Grading & Erosion Control Details Sheet 4 of 10: Grading & Erosion Control Details Sheet 5 of 10: Site Utilities Plan Sheet 6 of 10: Sheet 7 of 10: Landscape Plan Sheet 8 of 10: Landscape Plan

Landscape Details

Land Planning Landscape Architecture **Urban** Design 619 N. Cascade Avenue, Suite 200

Colorado Springs, CO 80903 Tel. 719.471.0073 Fax 719.471.0267 www.nescolorado.com

© 2012. All Rights Reserved.

The Gardens at North Carefree

PUD DEVELOPMENT/ PRELIMINARY PLAN

08/08/2018 PROJECT MGR: A. Barlow PREPARED BY: B. Swenson

DESCRIPTION:

INITIAL SUBMITTAL 08/08/2018 PER COUNTY 10/16/2018 JBS

COVER

of **10**

PUDSP-18-004

Land Planning THE GARDENS AT NORTH CAREFREE Landscape Architecture EL PASO COUNTY, COLORADO Urban Design 619 N. Cascade Avenue, Suite 200 Colorado Springs, CO 80903 CITY OF Tel. 719.471.0073 Fax 719.471.0267 COLORADO SPRINGS RR-5 www.nescolorado.com VACANT © 2012. All Rights Reserved. N00°03'00"E 1116.48' TRACT A 33,727 - END CONCRETE PANEL FENCE BEGIN CHAIN LINK FENCE. 6,848 SF 15' LANDSCAPE BUFFER FROM EXISTING E.O.P. EXISTING 34' ACCESS, UTILITY & DRAINAGE EASEMENT (RECEPTION NO. 206712353) 29 4,156 SF YELLOW JACKET, LLC | 49 | 50 |3,150 SF | 3,150 SF | 8 | 3,150 SF ≈ | 3,150 SF ≈ CS **BUSINESS PARK/** CHARTER SCHOOL The Gardens at North 3,522 SF Carefree 3,261 SF PUD DEVELOPMENT/ -_CEDAR-____ VINEYARD CIRCLE (331'-8" - END VINYL 5' TRAIL (45'-8" (R500'-0" - PUBLIC URBAN LOCAL 45 ROW) FENCE FENCE (TYP.) PRELIMINARY PLAN 5,106 SF FENCE (TYP.) END VINYL FENCE BEGIN CONCRETE PANEL FENCE PROJECT MGR: A. Barlow න 3,954 SF PREPARED BY: B. Swenson - PUBLIC IMPROVEMENT **EASEMENT** 6,270 SF 5,483 SF 4,989 SF 445 LINE-OF-SIGHT - AKERS DRIVE (URBAN COLLECTOR - 80' ROW ASPHALT SURFACE) AKÉŔŚ DRIVE - 5' CONC. - VINYL FENCE (TYP.) SIDEWALK (URBAN COLLECTOR - 80' ROW 🍙 ASPHALT SURFACE) SIDEWALK 5' CONC. 0-4' LANDSCAPE WALL SIDEWALK 0-4' LANDSCAPE WALL INITIAL SUBMITTAL FULL MOVEMENT -VINYL¦FENCE (TYP.) – PER COUNTY INTERSECTION 10/16/2018 JBS **MULE DEER CROSSING** Please add key to sheet for SINGLE FAMILY DEVELOPMENT RESIDENTIAL PLAN

of **10**

PUDSP-18-004

NORTH

SCALE: 1" = 50'

END CONCRETE PANEL FENCE

25' LANDSCAPE SETBACK

4,833 SF

7,918 SF

- - ----- - - - ----- /

PRONGHORN MEADOWS

RS-6000

RESIDEN/TIAL

SUBURBAN

PUBLIC IMPROVEMENT

6' ATTACHED

SIDEWALK (TYP.)

PHASING PLAN

PHASE 1 - Lots 20-41, 50-63 (36 Lots)

Detention Ponds

PHASE 2 - Lots 1-19, 42-49, 64-71 (35 Lots)

Fallow Lane access

Running Deer Way access

Tracts D, E, F, G, and a portion of tracts A and B

sequenced as shown on the Phasing Plan Diagram.

Tracts C, and a portion of tracts A and B

EASEMENT _W

PARCEL BOUNDARY -

END CONCRETE PANEL FENCE

ENTRY SIGN -

NOTE: Phasing is subject to changes in the market/demand. Final Plats may contain more than one phase and may not be

_ - - LOCATION

BEGIN VINYL FENCE