Site Plan Drawing for Project: Norton Extended Family Guest House

Show setbacks from closest structures to property lines.

Show utility lines connecting from meters.

Make the measurement lines dashed so they are different from the structure lines.

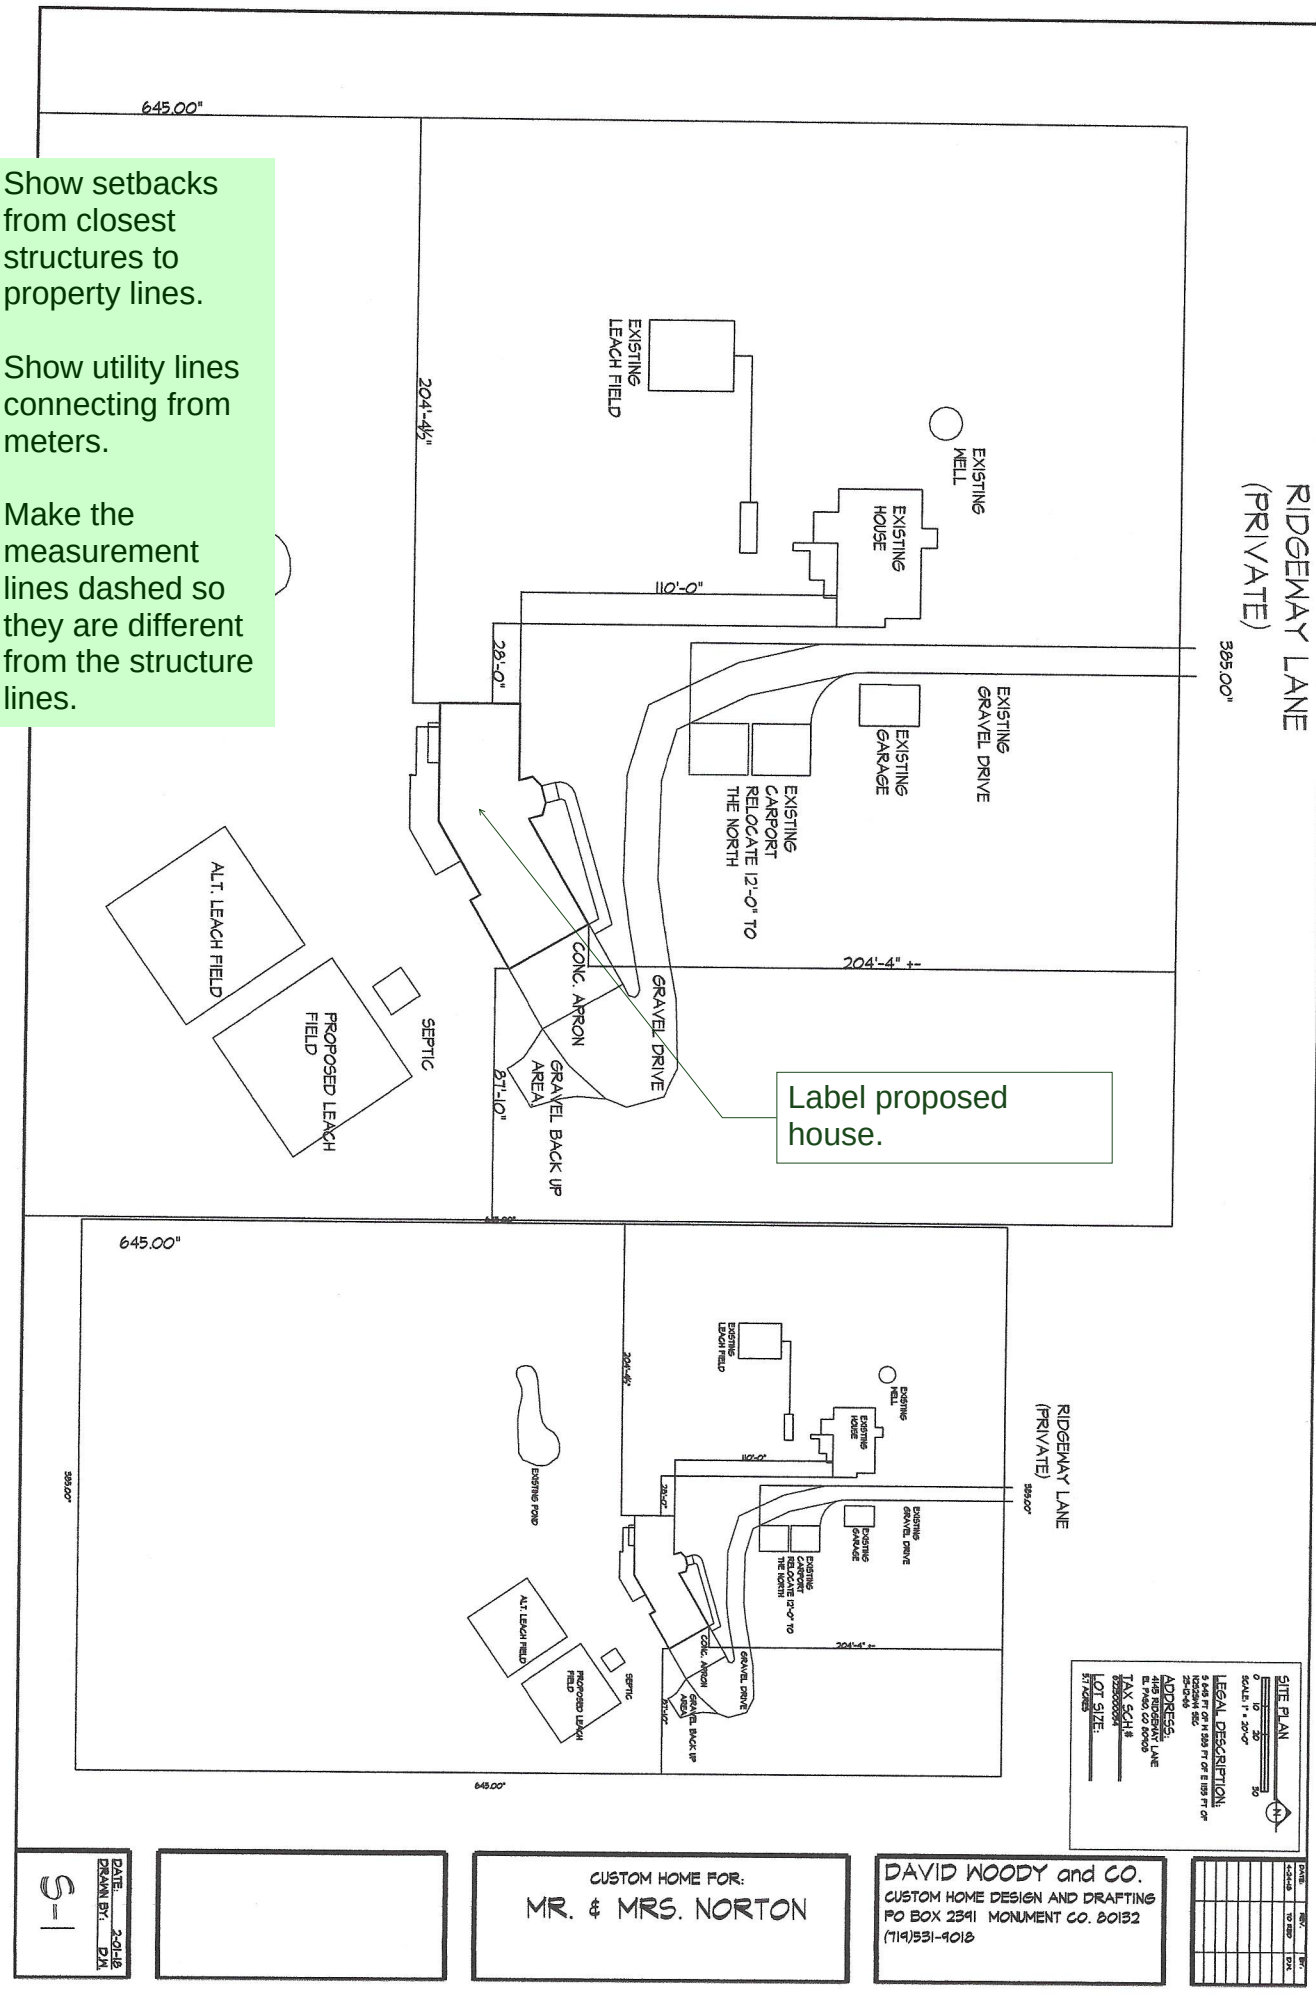

# Markup Summary

dsdkendall (2)

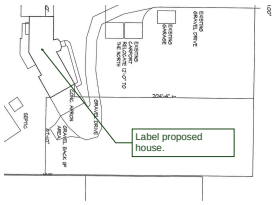


**Subject:** Callout
**Page Label:** 1
**Lock:** Unlocked
**Author:** dsdkendall
**Date:** 12/18/2018 12:10:26 PM
**Color:**

Label proposed house.

---

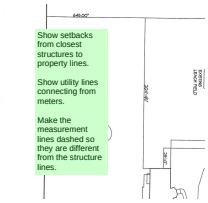


**Subject:** Text Box
**Page Label:** 1
**Lock:** Unlocked
**Author:** dsdkendall
**Date:** 12/18/2018 12:11:47 PM
**Color:**

Show setbacks from closest structures to property lines.

Show utility lines connecting from meters.

Make the measurement lines dashed so they are different from the structure lines.