


Sign Type: With Covers in place

- A
- B
- C
- D
- E
- F
- G

What does "covers in place" mean?

Face

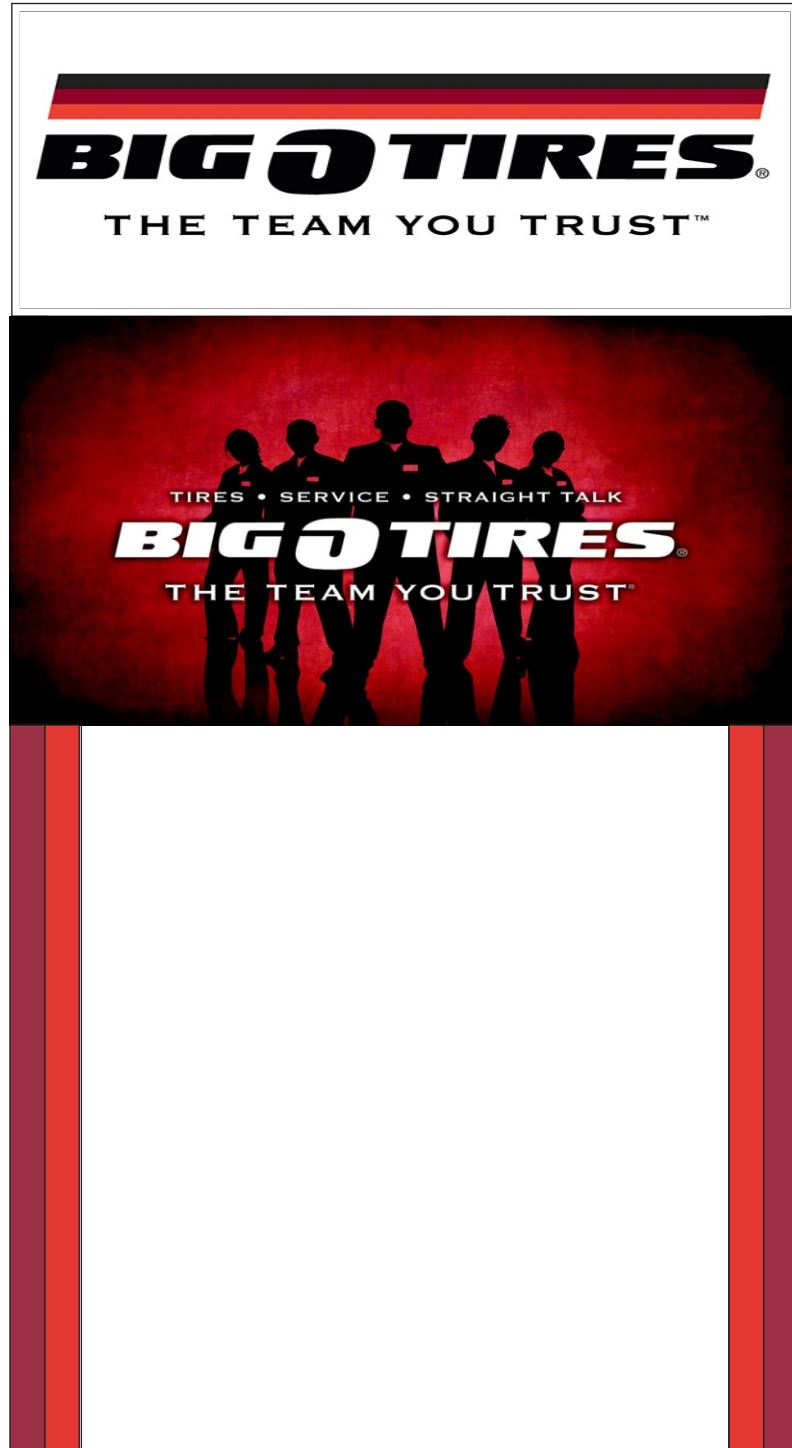

Profile



Top View



Must show illumination specifics and must meet lighting standards of Ch. 6 of the Land Development Code.

Must show foot candles at property boundaries of .1 or less when abutting public right of way..

Show dimensions, show structure elevations with dimensions.

DESCRIPTION

- A
- B
- C
- D
- E
- F
- G


MOUNTING

- 3M® VHB, or very high bond tapes secure interior signs to a variety of surfaces.
- Added to the back or perimeter of a sign, silicone adhesive makes installation permanent.
- Sign Stand Offs protrude signs from wall adding a decorative touch to both fastener and sign.
- Stainless Steel Tamper Proof Screws enhance theft protection.
- Studs are inserted directly into elements for a flush mounted appearance without visible hardware.
- Spacers are added to protrude elements from the wall creating a floating effect.
- Elements are mechanically mounted to a rail system which reduces penetrations into walls.

FEATURES

- These signs are ADA compliant (Grade II Braille, raised text/symbols, visually contrasting non-glare finish).
- Decorative accent bars are featured on these signs.
- Recycled products and Greenguard™ approved materials make these signs eco-friendly.
- Printed inserts are compatible with these signs.

COLORS

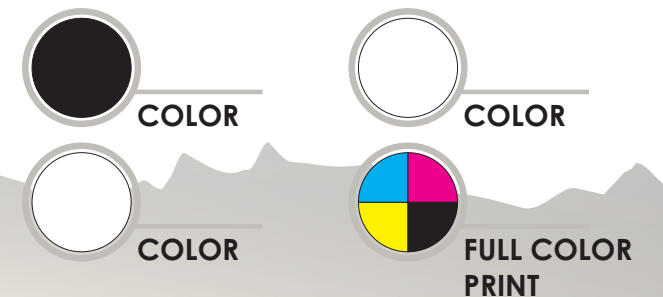

AVALANCHE
SIGN CONTRACTING
786 Hathaway Drive • Colorado Springs, CO 80915
Phone: 719.471.9898 • Fax: 719.632.7781

Project:
Address:
City/State:
Sales Rep: JB
Artist: KF
Date: 01.17.17

Client Approval

Signed: _____

Date: _____


Sign Type: A




Face



Profile

 

Top View

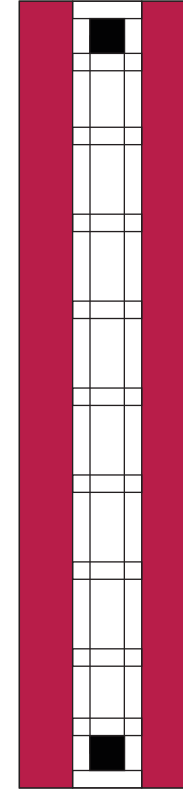

DESCRIPTION




MOUNTING

- 3M® VHB, or very high bond tapes secure interior signs to a variety of surfaces.
- Added to the back or perimeter of a sign, silicone adhesive makes installation permanent.
- Sign Stand Offs protrude signs from wall adding a decorative touch to both fastener and sign.
- Stainless Steel Tamper Proof Screws enhance theft protection.
- Studs are inserted directly into elements for a flush mounted appearance without visible hardware.
- Spacers are added to protrude elements from the wall creating a floating effect.
- Elements are mechanically mounted to a rail system which reduces penetrations into walls.

FEATURES

- These signs are ADA compliant (Grade II Braille, raised text/symbols, visually contrasting non-glare finish).
- Decorative accent bars are featured on these signs.
- Recycled products and Greenguard™ approved materials make these signs eco-friendly.
- Printed inserts are compatible with these signs.

COLORS

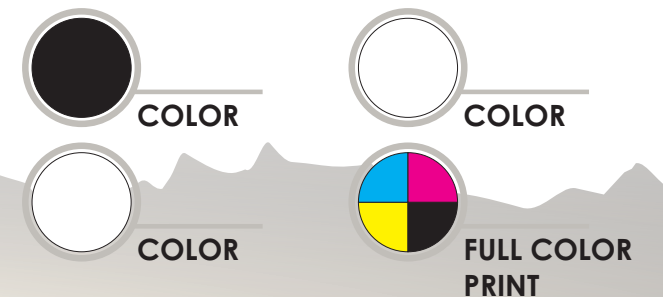

AVALANCHE
SIGN CONTRACTING
786 Hathaway Drive • Colorado Springs, CO 80915
Phone: 719.471.9898 • Fax: 719.632.7781

Project:
Address:
City/State:
Sales Rep: JB
Artist: KF
Date: 01.17.17

Client Approval

Signed: _____

Date: _____

Markup Summary

dsdkendall (4)




Subject: Callout
Page Label: 1
Lock: Locked
Status:
Checkmark: Unchecked
Author: dsdkendall
Date: 4/25/2018 4:01:28 PM
Color: ■
Layer:
Space:

Must show foot candles at property boundaries of .1 or less when abutting public right of way..




Subject: Callout
Page Label: 1
Lock: Locked
Status:
Checkmark: Unchecked
Author: dsdkendall
Date: 4/25/2018 3:57:28 PM
Color: ■
Layer:
Space:

Must show illumination specifics and must meet lighting standards of Ch. 6 of the Land Development Code.

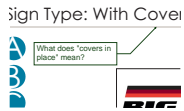

Subject: Callout
Page Label: 1
Lock: Locked
Status:
Checkmark: Unchecked
Author: dsdkendall
Date: 4/25/2018 11:56:02 AM
Color: ■
Layer:
Space:

What does "covers in place" mean?

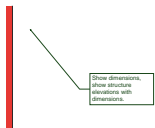

Subject: Callout
Page Label: 1
Lock: Locked
Status:
Checkmark: Unchecked
Author: dsdkendall
Date: 4/25/2018 11:56:03 AM
Color: ■
Layer:
Space:

Show dimensions, show structure elevations with dimensions.