



EL PASO COUNTY PLANNING & COMMUNITY DEVELOPMENT SIGN APPLICATION

DATE: _____

Business

Name: Big O Tires
Address: _____
5820 OMAHA BLVD
Colorado Springs, CO 80915
Zone: _____
Legal Description: _____

Type of Sign

Illuminated: FreeStanding
Non-Illuminated: _____
Valuation: 8,000

Storefront Length &/or
Width: North: 576" South: 576"
East: 1,152" West: 1,152"
Proposed Sign Sq. Ft. 52.16

Existing Sign Sq. Ft. _____

Total Sign Sq. Ft. 52.16


Contractor Information

Name: Avalanche Sign Contracting, LLC
Address: _____
786 Hathaway Drive
Colorado Springs, CO 80915
Phone: 719 471 9898
Type of License: D-5A
Contractor ID# 20294

Vicinity Map

Tax Schedule # _____
Please show major intersections.

Include this.

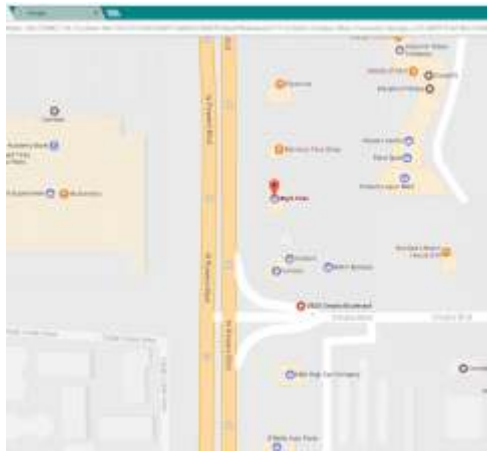

This is not legible.

Elevation Drawing

Indicate storefront length & placement of

Show elevation of
structure with
dimensions.

Sign Plan

(Please indicate dimensions and sign copy)

Face

Profile

Top View



You need to show the
dimensions of the
sign.

A Site plan depicting
where the
freestanding sign will
be located on the site
needs to be shown.


For Planning & Community Development Use Only

Approved Date: _____ Resubmittal? Yes _____ No _____
Denied Date: _____
Comments: _____

Fee of \$262.00 must accompany this Application. Additional signs at time of first Application are \$125.00. Make checks payable to El Paso County.


Markup Summary

dsdkendall (5)

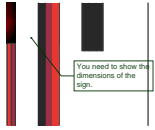


Subject: Callout
Page Label: 1
Lock: Locked
Status:
Checkmark: Unchecked
Author: dsdkendall
Date: 4/25/2018 11:56:07 AM
Color: ■
Layer:
Space:

You need to show the dimensions of the sign.

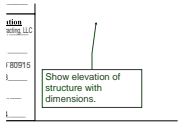


Subject: Callout
Page Label: 1
Lock: Locked
Status:
Checkmark: Unchecked
Author: dsdkendall
Date: 4/25/2018 11:56:07 AM
Color: ■
Layer:
Space:

Show elevation of structure with dimensions.

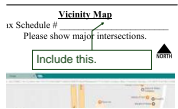

Subject: Callout
Page Label: 1
Lock: Locked
Status:
Checkmark: Unchecked
Author: dsdkendall
Date: 4/25/2018 11:56:09 AM
Color: ■
Layer:
Space:

Include this.

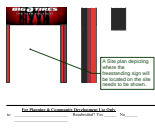

Subject: Callout
Page Label: 1
Lock: Locked
Status:
Checkmark: Unchecked
Author: dsdkendall
Date: 4/25/2018 11:56:08 AM
Color: ■
Layer:
Space:

A Site plan depicting where the freestanding sign will be located on the site needs to be shown.



Subject: Callout
Page Label: 1
Lock: Locked
Status:
Checkmark: Unchecked
Author: dsdkendall
Date: 4/25/2018 11:56:10 AM
Color: ■
Layer:
Space:

This is not legible.