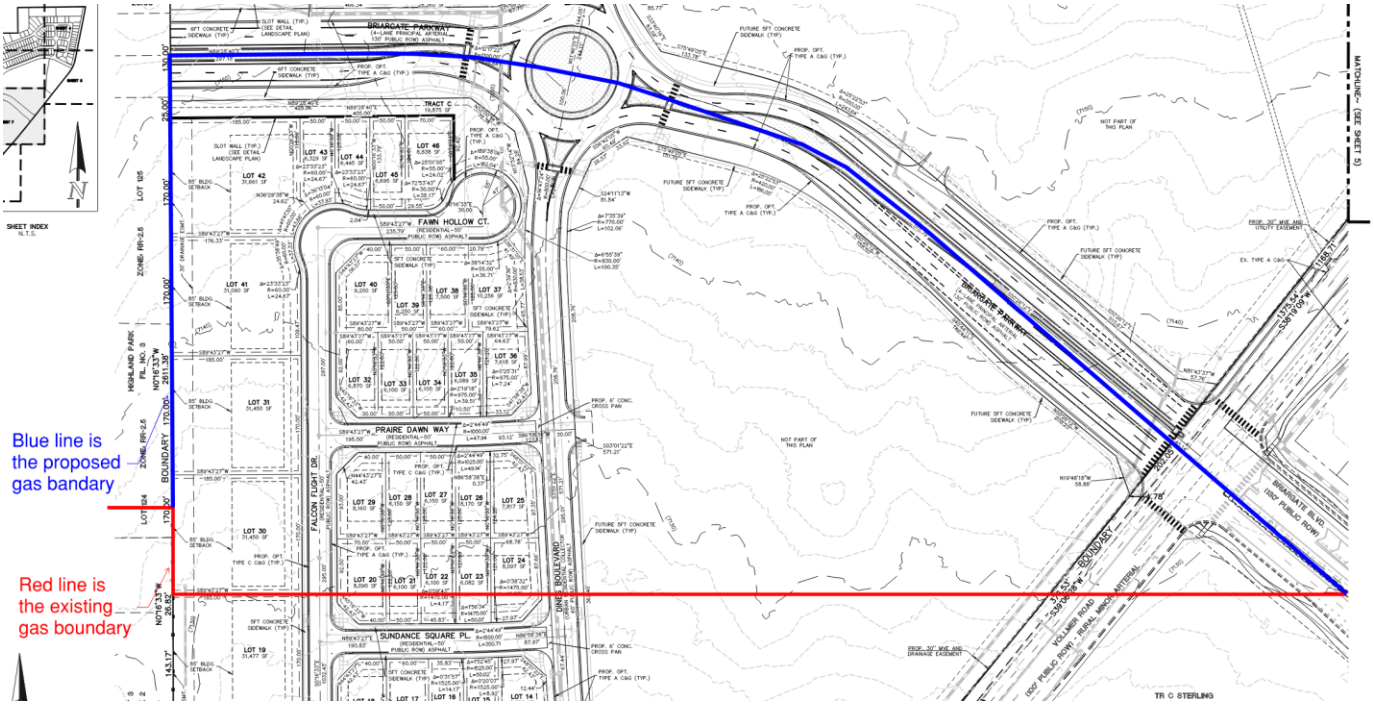
Blue line is the proposed gas bandary
Red line is the existing gas boundary
BRIARGATE PARKWAY
FAWN HOLLOW CT.
PRAIRIE DAWN WAY
SUNDANCE SQUARE PL.
FALCON FLIGHT DR.
DINE BOULEVARD
BRIARGATE BLVD.
VOLLMER ROAD
TR C STERLING
MATCHLINE (SEE SHEET 5)
SHEET INDEX
N.T.S.