


BRANDING IRON AT STERLING RANCH FILING NO. 1

COUNTY OF EL PASO, STATE OF COLORADO

STREET IMPROVEMENT PLANS

NOVEMBER 2017

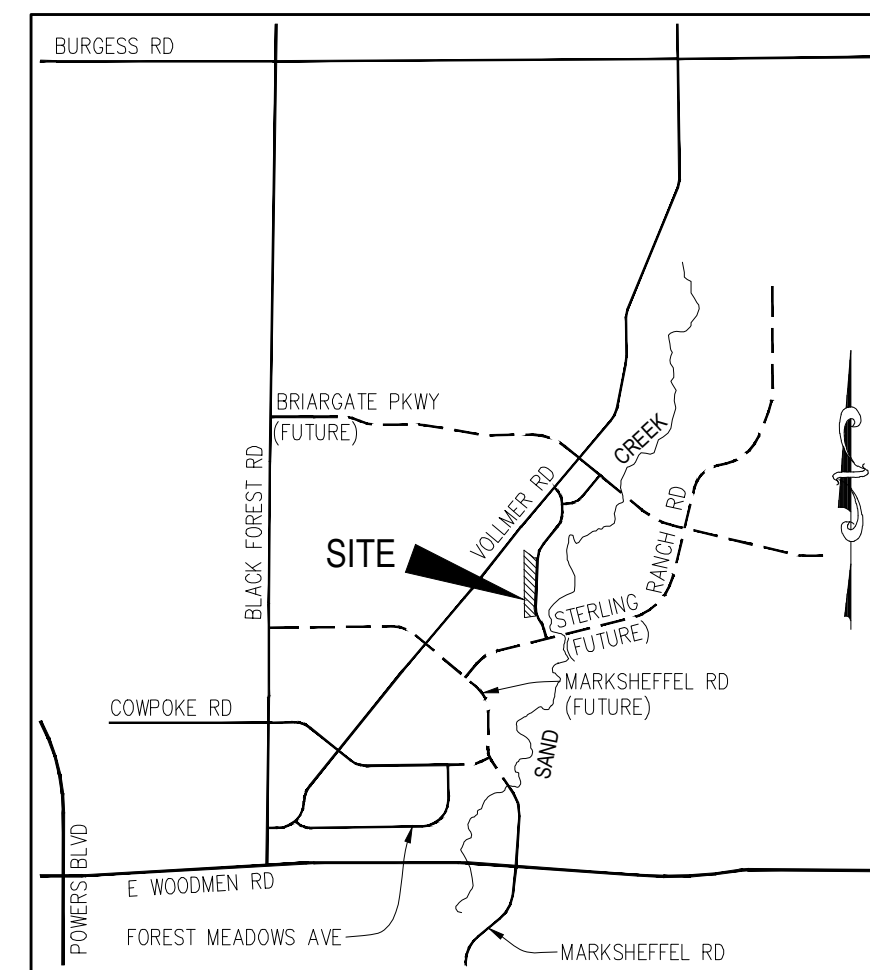

VICINITY MAP
N.T.S.



SITE MAP
N.T.S.

AGENCIES

- OWNER/DEVELOPER:** SR LAND, LLC
20 BOULDER CRESCENT, SUITE 201
COLORADO SPRINGS, CO 80903
JIM MORLEY (719) 471-1742
- CIVIL ENGINEER:** M & S CIVIL CONSULTANTS, INC.
20 BOULDER CRESCENT, SUITE 110
COLORADO SPRINGS, CO 80903
VIRGIL A. SANCHEZ P.E. (719) 955-5485
- COUNTY ENGINEERING:** EL PASO COUNTY DEVELOPMENT SERVICES
2880 INTERNATIONAL CIRCLE, SUITE 110
COLORADO SPRINGS, CO 80910
JEFF RICE, P.E. (719) 520-6300
- TRAFFIC ENGINEERING:** EL PASO COUNTY PUBLIC SERVICES & TRANS. DEPT.
3275 AKERS DRIVE
COLORADO SPRINGS, CO 80922
JENNIFER IRVINE P.E. (719) 520-6460
- WATER RESOURCES:** STERLING RANCH METRO DISTRICT ENGINEERS
JDS-HYDRO CONSULTANTS
545 E. PIKES PEAK AVE., SUITE 300
COLORADO SPRINGS, CO 80903
JOHN MCGINN (719) 668-8769
- FIRE DISTRICT:** BLACK FOREST FIRE PROTECTION DISTRICT
11445 TEACHOUT ROAD
COLORADO SPRINGS, CO 80908
CHIEF BRYAN JACK (719) 495-4300
- GAS DEPARTMENT:** COLORADO SPRINGS UTILITIES
7710 DURANT DR.
COLORADO SPRINGS, CO 80947
TIM WENDT (719) 668-3556
- ELECTRIC DEPARTMENT:** MOUNTAIN VIEW ELECTRIC
11140 E. WOODMEN ROAD
FALCON, CO 80831
(719) 495-2283
- COMMUNICATIONS:** QWEST COMMUNICATIONS
(U.N.C.C. LOCATORS) (800) 922-1987
AT&T (LOCATORS) (719) 635-3674

BENCHMARKS

- THE TOP OF AN ALUMINUM SURVEYORS CAP, STAMPED "9853", AT THE SOUTHEAST BOUNDARY CORNER OF BARBARICK SUBDIVISION
NORTHING = 411416.273
EASTING = 235167.071
ELEVATION = 7023.42
- THE TOP OF A RED PLASTIC SURVEYORS CAP, ILLEGIBLE, AT THE NORTHWEST BOUNDARY CORNER OF PAWNEE RANCHEROS SUBDIVISION
NORTHING = 410095.404
EASTING = 235052.131
ELEVATION = 7000.40
- THE TOP OF A RED PLASTIC SURVEYORS CAP, STAMPED "38141", AT THE SOUTHWEST BOUNDARY CORNER OF BARBARICK SUBDIVISION
NORTHING = 411399.952
EASTING = 233849.817
ELEVATION = 7030.82

APPROVALS:

ENGINEER'S STATEMENT:

DETAILED IMPROVEMENT PLANS AND SPECIFICATIONS ENGINEER'S STATEMENT: THESE DETAILED PLANS AND SPECIFICATIONS WERE PREPARED UNDER MY DIRECTION AND SUPERVISION. SAID DETAILED PLANS AND SPECIFICATIONS HAVE BEEN PREPARED ACCORDING TO THE CRITERIA ESTABLISHED BY THE COUNTY FOR DETAILED DRAINAGE PLANS AND SPECIFICATIONS, AND SAID DETAILED PLANS AND SPECIFICATIONS ARE IN CONFORMITY WITH THE MASTER PLAN OF THE DRAINAGE BASIN. SAID DETAILED DRAINAGE PLANS AND SPECIFICATIONS MEET THE PURPOSES FOR WHICH THE PARTICULAR DRAINAGE FACILITY(S) IS DESIGNED. I ACCEPT RESPONSIBILITY FOR ANY LIABILITY CAUSED BY ANY NEGLIGENT ACTS, ERRORS, OR OMISSIONS ON MY PART IN PREPARATION OF THE DETAILED IMPROVEMENT PLANS AND SPECIFICATIONS.

VIRGIL A SANCHEZ, COLORADO P.E. NO. 37160
FOR AND ON BEHALF OF M&S CIVIL CONSULTANTS, INC. DATE _____

OWNER/DEVELOPER STATEMENT:

THE OWNER WILL COMPLY WITH THE REQUIREMENTS OF THE DRAINAGE REPORT AND PLAN AND THIS SET OF CONSTRUCTION DOCUMENTS. THE OWNER WILL COMPLY WITH THE REQUIREMENTS OF THE GRADING AND EROSION CONTROL PLAN.

CHALLENGER HOMES
DIRECTOR OF PLANNING AND ENGINEERING DATE _____

EL PASO COUNTY:

COUNTY PLAN REVIEW IS PROVIDED ONLY FOR GENERAL CONFORMANCE WITH COUNTY DESIGN CRITERIA. THE COUNTY IS NOT RESPONSIBLE FOR THE ACCURACY AND ADEQUACY OF THE DESIGN, DIMENSIONS, AND/OR ELEVATIONS WHICH SHALL BE CONFIRMED AT THE JOB SITE. THE COUNTY THROUGH APPROVAL OF THIS DOCUMENT ASSUMES NO RESPONSIBILITY FOR COMPLETENESS AND/OR ACCURACY OF THIS DOCUMENT.

FILED IN ACCORDANCE WITH THE REQUIREMENTS OF THE EL PASO COUNTY LAND DEVELOPMENT CODE, DRAINAGE CRITERIA, AND ENGINEERING CRITERIA MANUAL AS AMENDED.

Jennifer Irvine
XXXXX XXXXX, P.E.
COUNTY ENGINEER / ECM ADMINISTRATOR DATE _____

STERLING RANCH METROPOLITAN DISTRICT:

THESE DOCUMENTS HAVE BEEN REVIEWED AND APPROVED FOR STORM DRAIN AND ASSOCIATED UTILITY SERVICE CONSTRUCTION.

FOR AND ON BEHALF OF THE STERLING RANCH METRO. DISTRICT DATE _____


BLACK FOREST FIRE PROTECTION DISTRICT:

ALL FIRE HYDRANTS SHALL BE INSTALLED ACCORDING TO THE BLACK FOREST FIRE PROTECTION DISTRICT SPECIFICATIONS. THE NUMBER OF FIRE HYDRANTS AND HYDRANT LOCATIONS AS SHOWN ON THE WATER INSTALLATION PLAN ARE CORRECT AND ADEQUATE TO SATISFY THE FIRE PROTECTION REQUIREMENTS AS SPECIFIED BY THE BLACK FOREST FIRE PROTECTION DISTRICT.

FOR AND ON BEHALF OF THE BLACK FOREST FIRE PROTECTION DISTRICT DATE _____

SHEET INDEX

- SHEET 1 TITLE SHEET
- SHEET 2 NOTES & DETAILS
- SHEET 3 PLAN & PROFILE - LODGE GRASS WAY
- SHEET 4 PLAN & PROFILE - MOSBY WAY
- SHEET 5 PLAN & PROFILE - WHITEFISH WAY
- SHEET 6 PLAN & PROFILE - SPRAGUE WAY
- SHEET 7 PLAN & PROFILE - KINTLA COURT
- SHEET 8 SIGNAGE & STRIPING PLAN

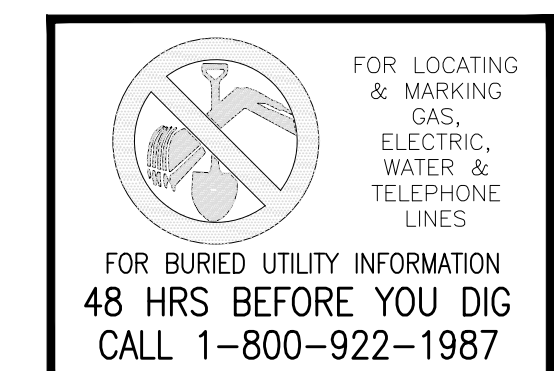

SF-17-024

BRANDING IRON AT STERLING RANCH FILING NO. 1

STREET IMPROVEMENT PLANS

PROJECT NO. 09-006

SCALE: HORIZONTAL: N/A VERTICAL: N/A

DESIGNED BY: VAS

DRAWN BY: ELY

CHECKED BY: GW

DATE: 11/10/2017

SHEET 1 OF 8

S101

20 BOULDER CRESCENT, SUITE 110
COLORADO SPRINGS, CO 80903
PHONE: 719.955.5485

M&S CIVIL CONSULTANTS, INC.

FOR AND ON BEHALF OF M&S CIVIL CONSULTANTS, INC.

VIRGIL A. SANCHEZ, COLORADO P.E. NO. 37160

NO.	DATE	BY	DESCRIPTION	APPROVED BY	DATE

THE ENGINEER PREPARING THESE PLANS WILL NOT BE RESPONSIBLE OR LIABLE FOR UNAUTHORIZED CHANGES TO OR USES OF THESE PLANS. ALL CHANGES TO THE PLANS MUST BE IN WRITING AND MUST BE APPROVED BY THE PREPARER OF THESE PLANS.

CAUTION

File: C:\090066\Sterling Ranch No 3\Map\Const Draw\Street Plans\Residential\S101.dwg Plotstamp: 11/16/2017 1:25 PM

GENERAL CONSTRUCTION NOTES:

- IT SHALL BE THE RESPONSIBILITY OF THE CONTRACTOR TO VERIFY THE EXISTENCE AND LOCATION OF ALL UNDERGROUND UTILITIES ALONG THE ROUTE OF THE WORK. THE OMISSION FROM OR THE INCLUSION OF UTILITY LOCATIONS ON THE PLANS IS NOT TO BE CONSIDERED AS THE NONEXISTENCE OF OR A DEFINITE LOCATION OF EXISTING UNDERGROUND UTILITIES.
- THE CONTRACTOR WILL TAKE THE NECESSARY PRECAUTIONS TO PROTECT EXISTING UTILITIES FROM DAMAGE DUE TO THIS OPERATION. ANY DAMAGE TO THE UTILITIES WILL BE REPAIRED AT THE CONTRACTOR'S EXPENSE, AND ANY SERVICE DISRUPTION WILL BE SETTLED BY THE CONTRACTOR.
- ADDITIONAL EROSION CONTROL STRUCTURES MAY BE REQUIRED AT THE TIME OF CONSTRUCTION.
- ALL BACKFILL, SUB-BASE, AND/OR BASE COURSE (CLASS 6) MATERIAL SHALL BE COMPACTED PER THE SOILS ENGINEER'S RECOMMENDATIONS, AND APPROVED BY EL PASO COUNTY DEVELOPMENT SERVICES ENGINEERING DIVISION.
- ALL STATIONING IS CENTERLINE OF IMPROVEMENTS UNLESS OTHERWISE INDICATED. ALL ELEVATIONS ARE FLOW LINE UNLESS OTHERWISE INDICATED AS TOP BACK OF CURB (TBC), ASPHALT (ASP), OR TOP OF INLET OR BOX (TOB).
- ALL DISTURBED PAVEMENT EDGES SHALL BE CUT TO NEAT LINES. REPAIR SHALL CONFORM TO EPC ECM APPENDIX K - 1.2C.
- ALL INTERSECTION ACCESSSES TO BE CONSTRUCTED WITH A 25 FOOT SIGHT VISIBILITY TRIANGLES IS REQUIRED AND THERE SHALL BE NO OBSTRUCTIONS GREATER THAN 18" VERTICAL IN THIS AREA.
- ALL CULVERTS AND STORM DRAIN PIPES SHALL BE SMOOTH INTERIOR CORRUGATED POLYETHYLENE PIPE (HDPE), REINFORCED CONCRETE PIPE (RCP). ALL CULVERTS SHALL BE PLACED COMPLETE WITH FLARED END SECTIONS. ADEQUACY OF MATERIAL THICKNESS FOR ANY CSP INSTALLED SHALL BE VERIFIED BY OWNER'S GEOTECHNICAL ENGINEER TO SUPPORT MINIMUM 50 YEAR DESIGN LIFE. CULVERTS MUST CONFORM TO EPC ECM SECTION 3.32 - CULVERTS.
- ASPHALT THICKNESS AND BASE COURSE THICKNESS (COMPACTED) FOR ROADS SHALL BE PER DESIGN REPORT BY OWNER'S GEOTECHNICAL ENGINEER. OWNER'S GEOTECHNICAL ENGINEER TO BE ON SITE AT THE TIME OF CONSTRUCTION TO EVALUATE SOIL CONDITIONS AND DETERMINE IF ADDITIONAL MEASURES ARE NECESSARY TO ASSURE STABILITY OF THE NEW ROADS. PAVEMENT DESIGN SHALL BE APPROVED BY EL PASO COUNTY DEVELOPMENT SERVICES ENGINEERING DIVISION PRIOR TO CONSTRUCTION.


SIGNING AND STRIPING NOTES:

- ALL SIGNS AND PAVEMENT MARKINGS SHALL BE IN COMPLIANCE WITH THE CURRENT MANUAL ON UNIFORM TRAFFIC CONTROL DEVICES (MUTCD).
- REMOVAL OF EXISTING PAVEMENT MARKINGS SHALL BE ACCOMPLISHED BY A METHOD THAT DOES NOT MATERIALLY DAMAGE THE PAVEMENT. THE PAVEMENT MARKINGS SHALL BE REMOVED TO THE EXTENT THAT THEY WILL NOT BE VISIBLE UNDER DAY OR NIGHT CONDITIONS. AT NO TIME WILL IT BE ACCEPTABLE TO PAINT OVER EXISTING PAVEMENT MARKINGS.
- ANY DEVIATION FROM THE STRIPING AND SIGNING PLAN SHALL BE APPROVED BY EL PASO COUNTY DEVELOPMENT SERVICES.
- ALL SIGNS SHOWN ON THE SIGNING AND STRIPING PLAN SHALL BE NEW SIGNS. EXISTING SIGNS MAY REMAIN OR BE REUSED IF THEY MEET CURRENT EL PASO COUNTY AND MUTCD STANDARDS.
- STREET NAME AND REGULATORY STOP SIGNS SHALL BE ON THE SAME POST AT INTERSECTIONS.
- ALL REMOVED SIGNS SHALL BE DISPOSED OF IN A PROPER MANNER BY THE CONTRACTOR.
- ALL STREET NAME SIGNS SHALL HAVE "D" SERIES LETTERS, WITH LOCAL ROADWAY SIGNS BEING 4" UPPER-LOWER CASE LETTERING ON 8" BLANK AND NON-LOCAL ROADWAY SIGNS BEING 6" LETTERING, UPPER-LOWER CASE ON 12" BLANK, WITH A WHITE BORDER THAT IS NOT RECESSED. MULTI-LANE ROADWAYS WITH SPEED LIMITS OF 40 MPH OR HIGHER SHALL HAVE 8" UPPER-LOWER CASE LETTERING ON 18" BLANK WITH A WHITE BORDER THAT IS NOT RECESSED. THE WIDTH OF THE NON-RECESSED WHITE BORDERS SHALL MATCH PAGE 255 OF THE 2012 MUTCD "STANDARD HIGHWAY SIGNS".
- ALL TRAFFIC SIGNS SHALL HAVE A MINIMUM HIGH INTENSITY PRISMATIC GRADE SHEETING.
- ALL LOCAL RESIDENTIAL STREET SIGNS SHALL BE MOUNTED ON A 1.75" X 1.75" SQUARE TUBE SIGN POST AND STUB POST BASE. FOR OTHER APPLICATIONS, REFER TO THE CDOT STANDARD S-614-8 REGARDING USE OF THE P2 TUBULAR STEEL POST SUBBASE DESIGN.
- ALL SIGNS SHALL BE SINGLE SHEET ALUMINUM WITH 0.100" MINIMUM THICKNESS.
- ALL LIMIT LINES/STOP LINES, CROSSWALK LINES, PAVEMENT LEGENDS, AND ARROWS SHALL BE A MINIMUM 125 MIL THICKNESS PREFORMED THERMOPLASTIC PAVEMENT MARKINGS WITH TAPERED LEADING EDGES PER CDOT STANDARD S-627-1. WORD AND SYMBOL MARKINGS SHALL BE THE NARROW TYPE. STOP BARS SHALL BE 24" IN WIDTH. CROSSWALKS LINES SHALL BE 12" WIDE AND 8' LONG PER CDOT S-627-1.
- ALL LONGITUDINAL LINES SHALL BE A MINIMUM 15MIL THICKNESS EPOXY PAINT. ALL NON-LOCAL RESIDENTIAL ROADWAYS SHALL INCLUDE BOTH RIGHT AND LEFT EDGE LINE STRIPING AND ANY ADDITIONAL STRIPING AS REQUIRED BY CDOT S-627-1.
- THE CONTRACTOR SHALL NOTIFY EL PASO COUNTY DEVELOPMENT SERVICES (719) 520-6819 PRIOR TO AND UPON COMPLETION OF SIGNING AND STRIPING.
- THE CONTRACTOR SHALL OBTAIN A WORK IN THE RIGHT OF WAY PERMIT FROM THE EL PASO COUNTY PUBLIC SERVICE DEPARTMENT (PSD) PRIOR TO ANY SIGNAGE OR STRIPING WORK WITHIN AN EXISTING EL PASO COUNTY ROADWAY.


STANDARD NOTES FOR EL PASO COUNTY CONSTRUCTION PLANS

- ALL DRAINAGE AND ROADWAY CONSTRUCTION SHALL MEET THE STANDARDS AND SPECIFICATIONS OF THE CITY OF COLORADO SPRINGS/EL PASO COUNTY DRAINAGE CRITERIA MANUAL, VOLUMES 1 AND 2, AND THE EL PASO COUNTY ENGINEERING CRITERIA MANUAL.
- CONTRACTOR SHALL BE RESPONSIBLE FOR THE NOTIFICATION AND FIELD NOTIFICATION OF ALL EXISTING UTILITIES, WHETHER SHOWN ON THE PLANS OR NOT, BEFORE BEGINNING CONSTRUCTION. LOCATION OF EXISTING UTILITIES SHALL BE VERIFIED BY THE CONTRACTOR PRIOR TO CONSTRUCTION. CALL 811 TO CONTACT THE UTILITY NOTIFICATION CENTER OF COLORADO (UNCC).
- CONTRACTOR SHALL KEEP A COPY OF THESE APPROVED PLANS, THE GRADING AND EROSION CONTROL PLAN, THE STORMWATER MANAGEMENT PLAN (SWMP), THE SOILS AND GEOTECHNICAL REPORT, AND THE APPROPRIATE DESIGN AND CONSTRUCTION STANDARDS AND SPECIFICATIONS AT THE JOB SITE AT ALL TIMES, INCLUDING THE FOLLOWING:
 - EL PASO COUNTY ENGINEERING CRITERIA MANUAL (ECM)
 - CITY OF COLORADO SPRINGS/EL PASO COUNTY DRAINAGE CRITERIA MANUAL, VOLUMES 1 AND 2
 - COLORADO DEPARTMENT OF TRANSPORTATION (CDOT) STANDARD SPECIFICATIONS FOR ROAD AND BRIDGE CONSTRUCTION
 - CDOT M & S STANDARDS
- NOTWITHSTANDING ANYTHING DEPICTED IN THESE PLANS IN WORDS OR GRAPHIC REPRESENTATION, ALL DESIGN AND CONSTRUCTION RELATED TO ROADS, STORM DRAINAGE AND EROSION CONTROL SHALL CONFORM TO THE STANDARDS AND REQUIREMENTS OF THE MOST RECENT VERSION OF THE RELEVANT ADOPTED EL PASO COUNTY STANDARDS, INCLUDING THE LAND DEVELOPMENT CODE, THE ENGINEERING CRITERIA MANUAL, THE DRAINAGE CRITERIA MANUAL, AND THE DRAINAGE CRITERIA MANUAL VOLUME 2. ANY DEVIATIONS FROM REGULATIONS AND STANDARDS MUST BE REQUESTED, AND APPROVED, IN WRITING. ANY MODIFICATIONS NECESSARY TO MEET CRITERIA AFTER-THE-FACT WILL BE ENTIRELY THE DEVELOPER'S RESPONSIBILITY TO RECTIFY.
- IT IS THE DESIGN ENGINEER'S RESPONSIBILITY TO ACCURATELY SHOW EXISTING CONDITIONS, BOTH ONSITE AND OFFSITE, ON THE CONSTRUCTION PLANS. ANY MODIFICATIONS NECESSARY DUE TO CONFLICTS, OMISSIONS, OR CHANGED CONDITIONS WILL BE ENTIRELY THE DEVELOPER'S RESPONSIBILITY TO RECTIFY.
- CONTRACTOR SHALL SCHEDULE A PRE-CONSTRUCTION MEETING WITH EL PASO COUNTY DEVELOPMENT SERVICES DEPARTMENT (DSD) - INSPECTIONS, PRIOR TO STARTING CONSTRUCTION.
- IT IS THE CONTRACTOR'S RESPONSIBILITY TO UNDERSTAND THE REQUIREMENTS OF ALL JURISDICTIONAL AGENCIES AND TO OBTAIN ALL REQUIRED PERMITS, INCLUDING BUT NOT LIMITED TO EL PASO COUNTY EROSION AND STORMWATER QUALITY CONTROL PERMIT (ESQCP), REGIONAL BUILDING FLOODPLAIN DEVELOPMENT PERMIT, U.S. ARMY CORPS OF ENGINEERS - ISSUED 401 AND/OR 404 PERMITS, AND COUNTY AND STATE FUGITIVE DUST PERMITS.
- CONTRACTOR SHALL NOT DEVIATE FROM THE PLANS WITHOUT FIRST OBTAINING WRITTEN APPROVAL FROM THE DESIGN ENGINEER AND DSD. CONTRACTOR SHALL NOTIFY THE DESIGN ENGINEER IMMEDIATELY UPON DISCOVERY OF ANY ERRORS OR INCONSISTENCIES.
- ALL STORM DRAIN PIPE SHALL BE CLASS III RCP UNLESS OTHERWISE NOTED AND APPROVED BY DSD.
- CONTRACTOR SHALL COORDINATE GEOTECHNICAL TESTING PER ECM STANDARDS. PAVEMENT DESIGN SHALL BE APPROVED BY EL PASO COUNTY DSD PRIOR TO PLACEMENT OF CURB AND GUTTER AND PAVEMENT.
- ALL CONSTRUCTION TRAFFIC MUST ENTER/EXIT THE SITE AT APPROVED CONSTRUCTION ACCESS POINTS.
- SIGHT VISIBILITY TRIANGLES AS IDENTIFIED IN THE PLANS SHALL BE PROVIDED AT ALL INTERSECTIONS. OBSTRUCTIONS GREATER THAN 18 INCHES ABOVE FLOWLINE ARE NOT ALLOWED WITHIN SIGHT TRIANGLES.
- SIGNING AND STRIPING SHALL COMPLY WITH EL PASO COUNTY DOT AND MUTCD CRITERIA. [IF APPLICABLE, ADDITIONAL SIGNING AND STRIPING NOTES WILL BE PROVIDED.]
- CONTRACTOR SHALL OBTAIN ANY PERMITS REQUIRED BY EL PASO COUNTY DOT, INCLUDING WORK WITHIN THE RIGHT-OF-WAY AND SPECIAL TRANSPORT PERMITS.
- THE LIMITS OF CONSTRUCTION SHALL REMAIN WITHIN THE PROPERTY LINE UNLESS OTHERWISE NOTED. THE OWNER/DEVELOPER SHALL OBTAIN WRITTEN PERMISSION AND EASEMENTS, WHERE REQUIRED, FROM ADJOINING PROPERTY OWNER(S) PRIOR TO ANY OFF-SITE DISTURBANCE, GRADING, OR CONSTRUCTION.


Revise all references to DSD to be PCD and DOT to be DPW

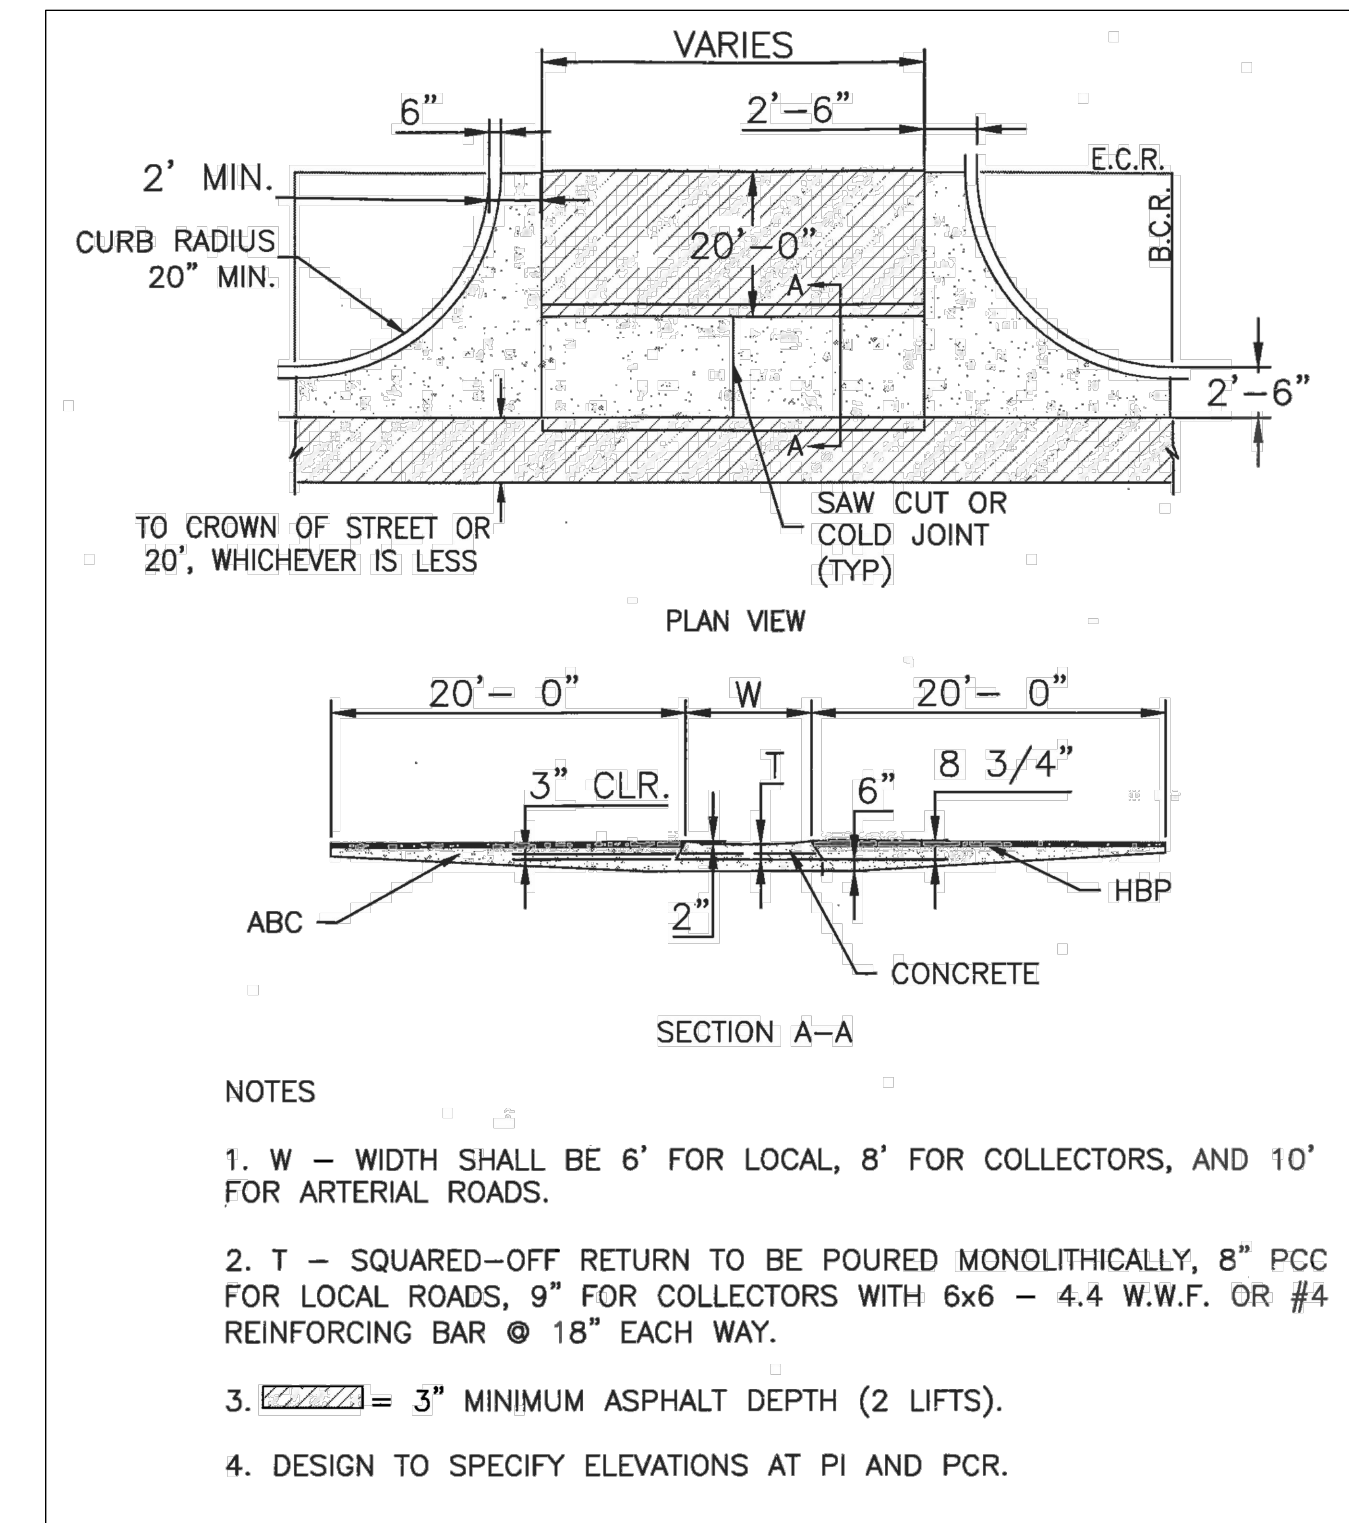


TYPICAL CROSS PAN LAYOUT DETAIL (SD 2-26)
SCALE: NTS

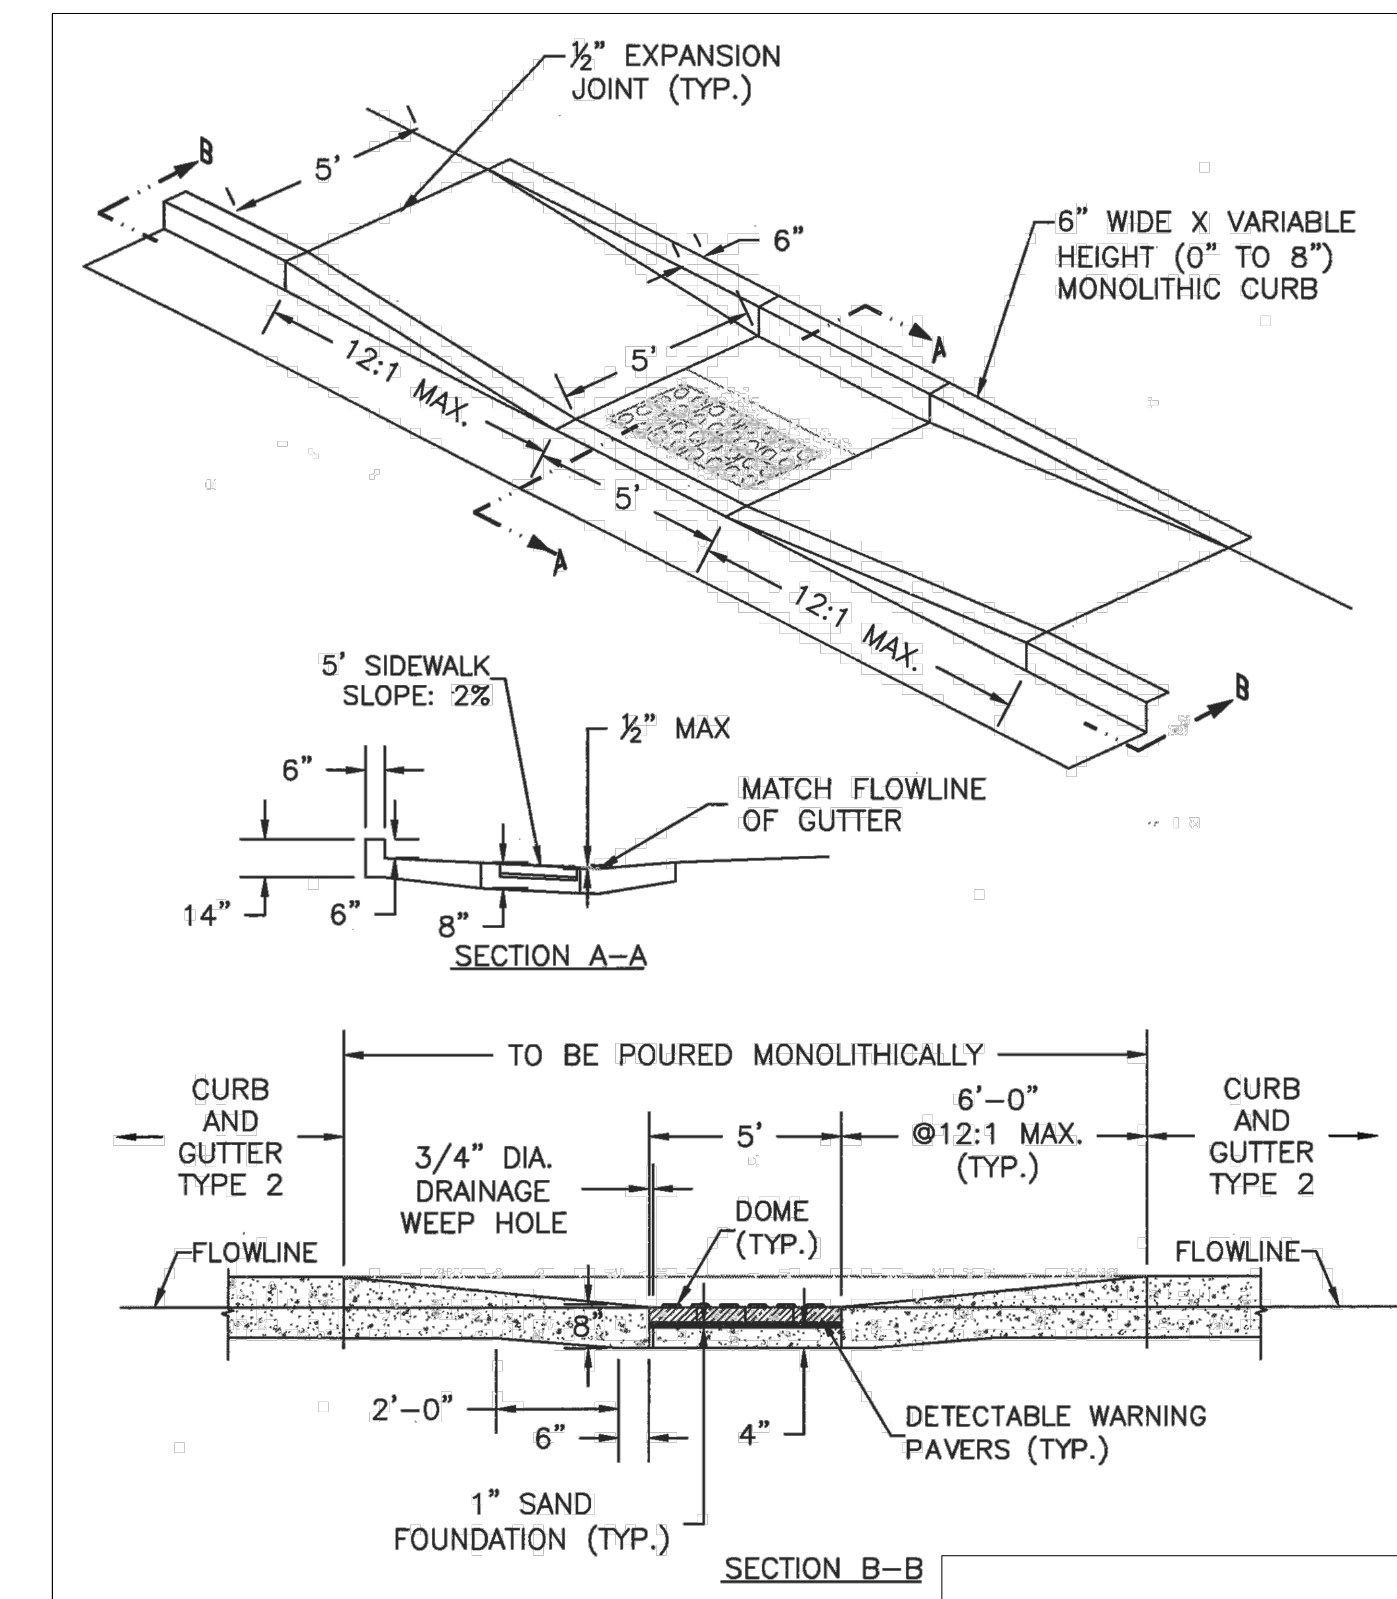

PARALLEL PEDESTRIAN RAMP DETAIL (SD 2-50)
SCALE: NTS

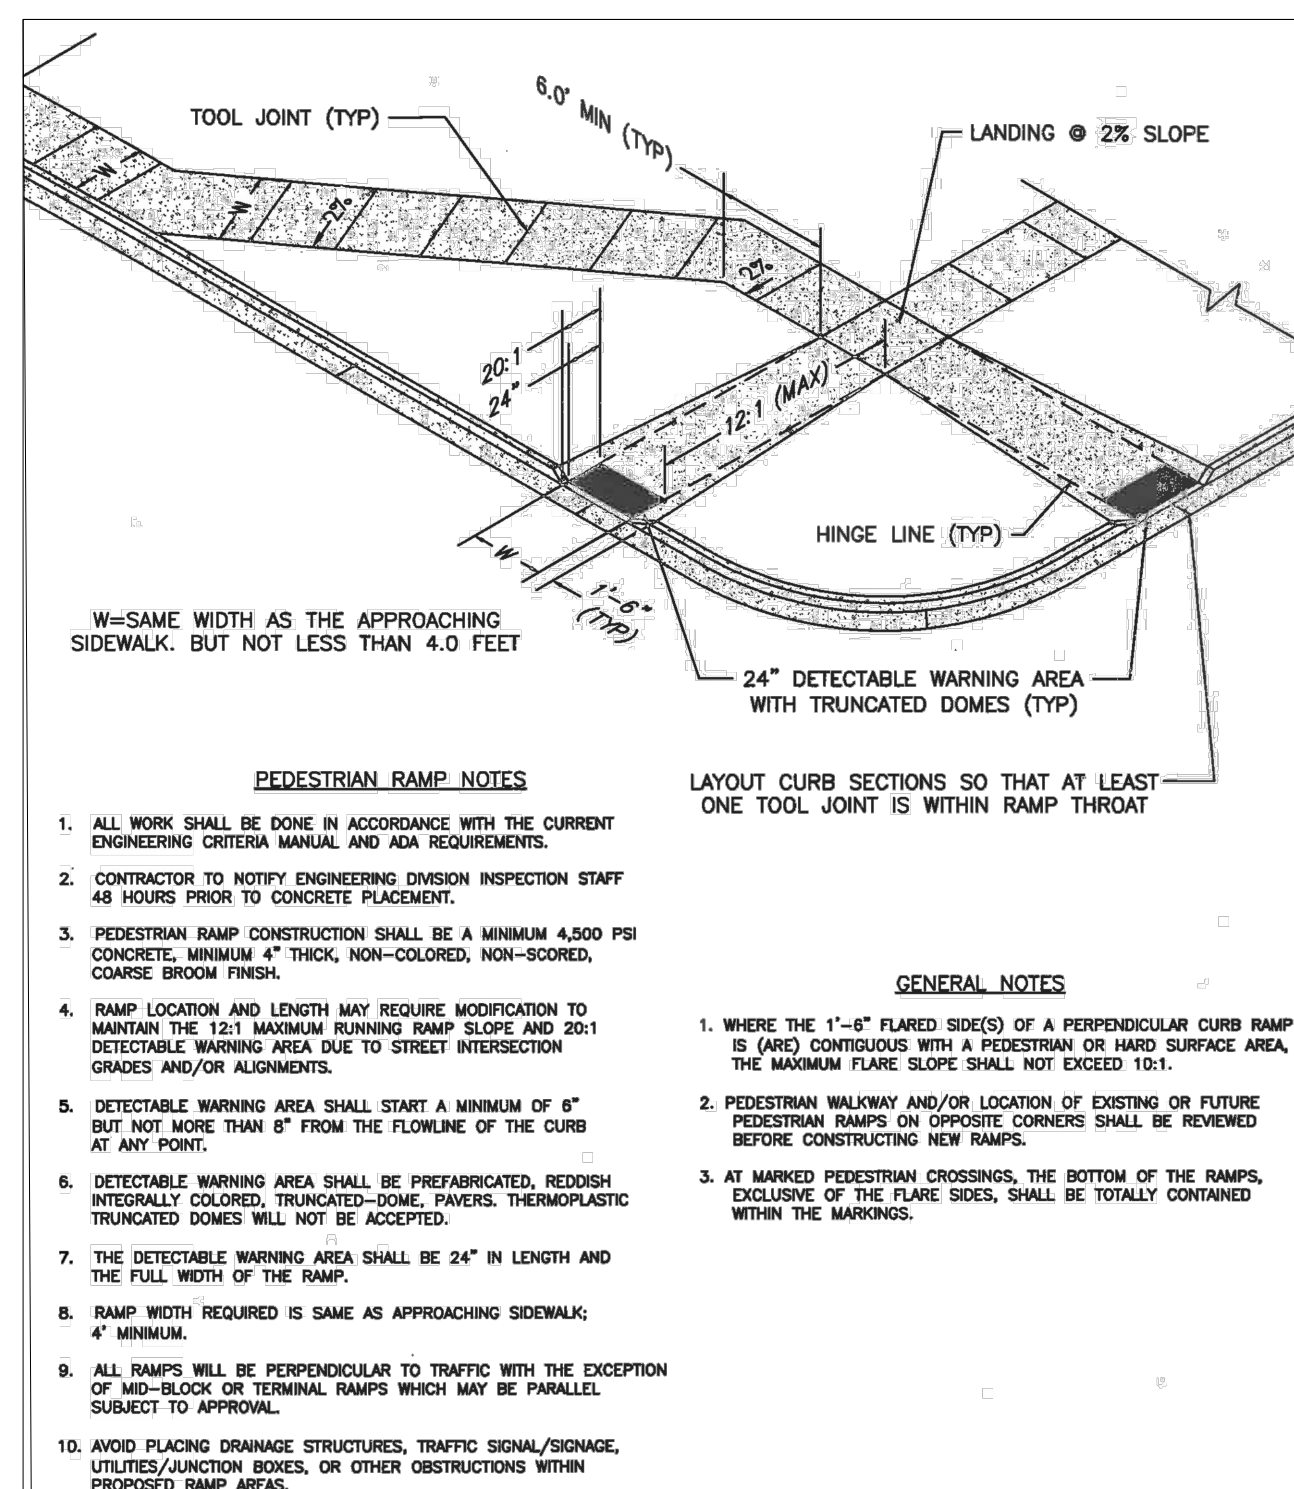

PEDESTRIAN INTERSECTION RAMP (SD 2-41)
SCALE: NTS

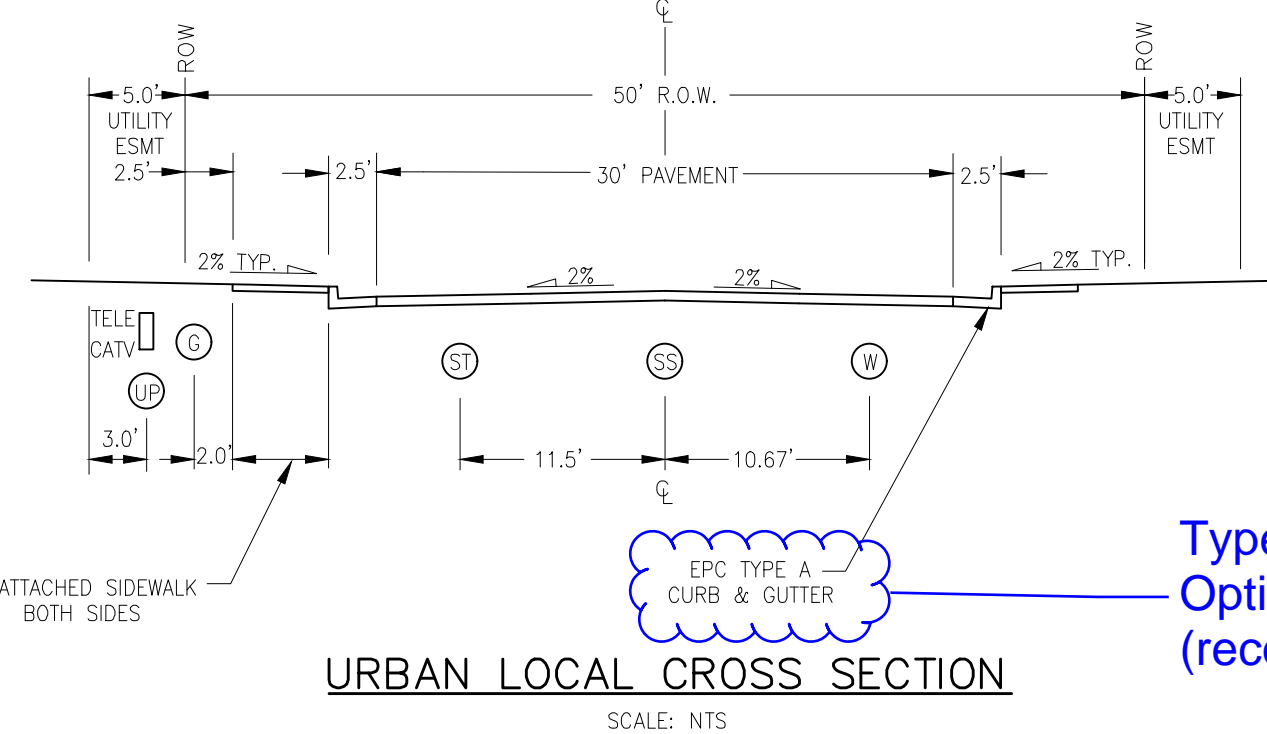

URBAN LOCAL CROSS SECTION
SCALE: NTS

Type C or Optional Type C (recommended)?

BRANDING IRON AT STERLING RANCH FILING NO. 1

NOTE & DETAIL SHEET

PROJECT NO. 09-006 DATE: 11/10/2017

SCALE: HORIZONTAL: N/A VERTICAL: N/A

DESIGNED BY: ELY DRAWN BY: GW CHECKED BY:

20 BOULDER CRESCENT, SUITE 110 COLORADO SPRINGS, CO 80903 PHONE: 719.955.5485

CIVIL CONSULTANTS, INC.

FOR AND ON BEHALF OF M&S CIVIL CONSULTANTS, INC.

MARCEL A. SANCHEZ, COLORADO P.E. NO. 37160

APPROVED BY: DATE:

REVISIONS: NO. DATE: BY: DESCRIPTION:

FOR LOCATING & MARKING GAS, ELECTRIC, WATER & TELEPHONE LINES

FOR BURIED UTILITY INFORMATION 48 HRS BEFORE YOU DIG CALL 1-800-922-1987

CAUTION




CENTERLINE LINE TABLE		
LINE	LENGTH	DIRECTION
CL1	154.53'	S69°40'03"E
CL2	70.81'	S87°35'34"E

CENTERLINE CURVE TABLE			
CURVE	RADIUS	LENGTH	DELTA
CC1	250.00'	78.21'	17°55'31"


CURB FLOWLINE CURVE TABLE			
CURVE	RADIUS	LENGTH	DELTA
CC1	45.83'	37.16'	46°27'28"
CC2	44.17'	210.38'	272°54'56"
CC3	45.83'	37.16'	46°27'28"

Optional Type C?
(Recommended)

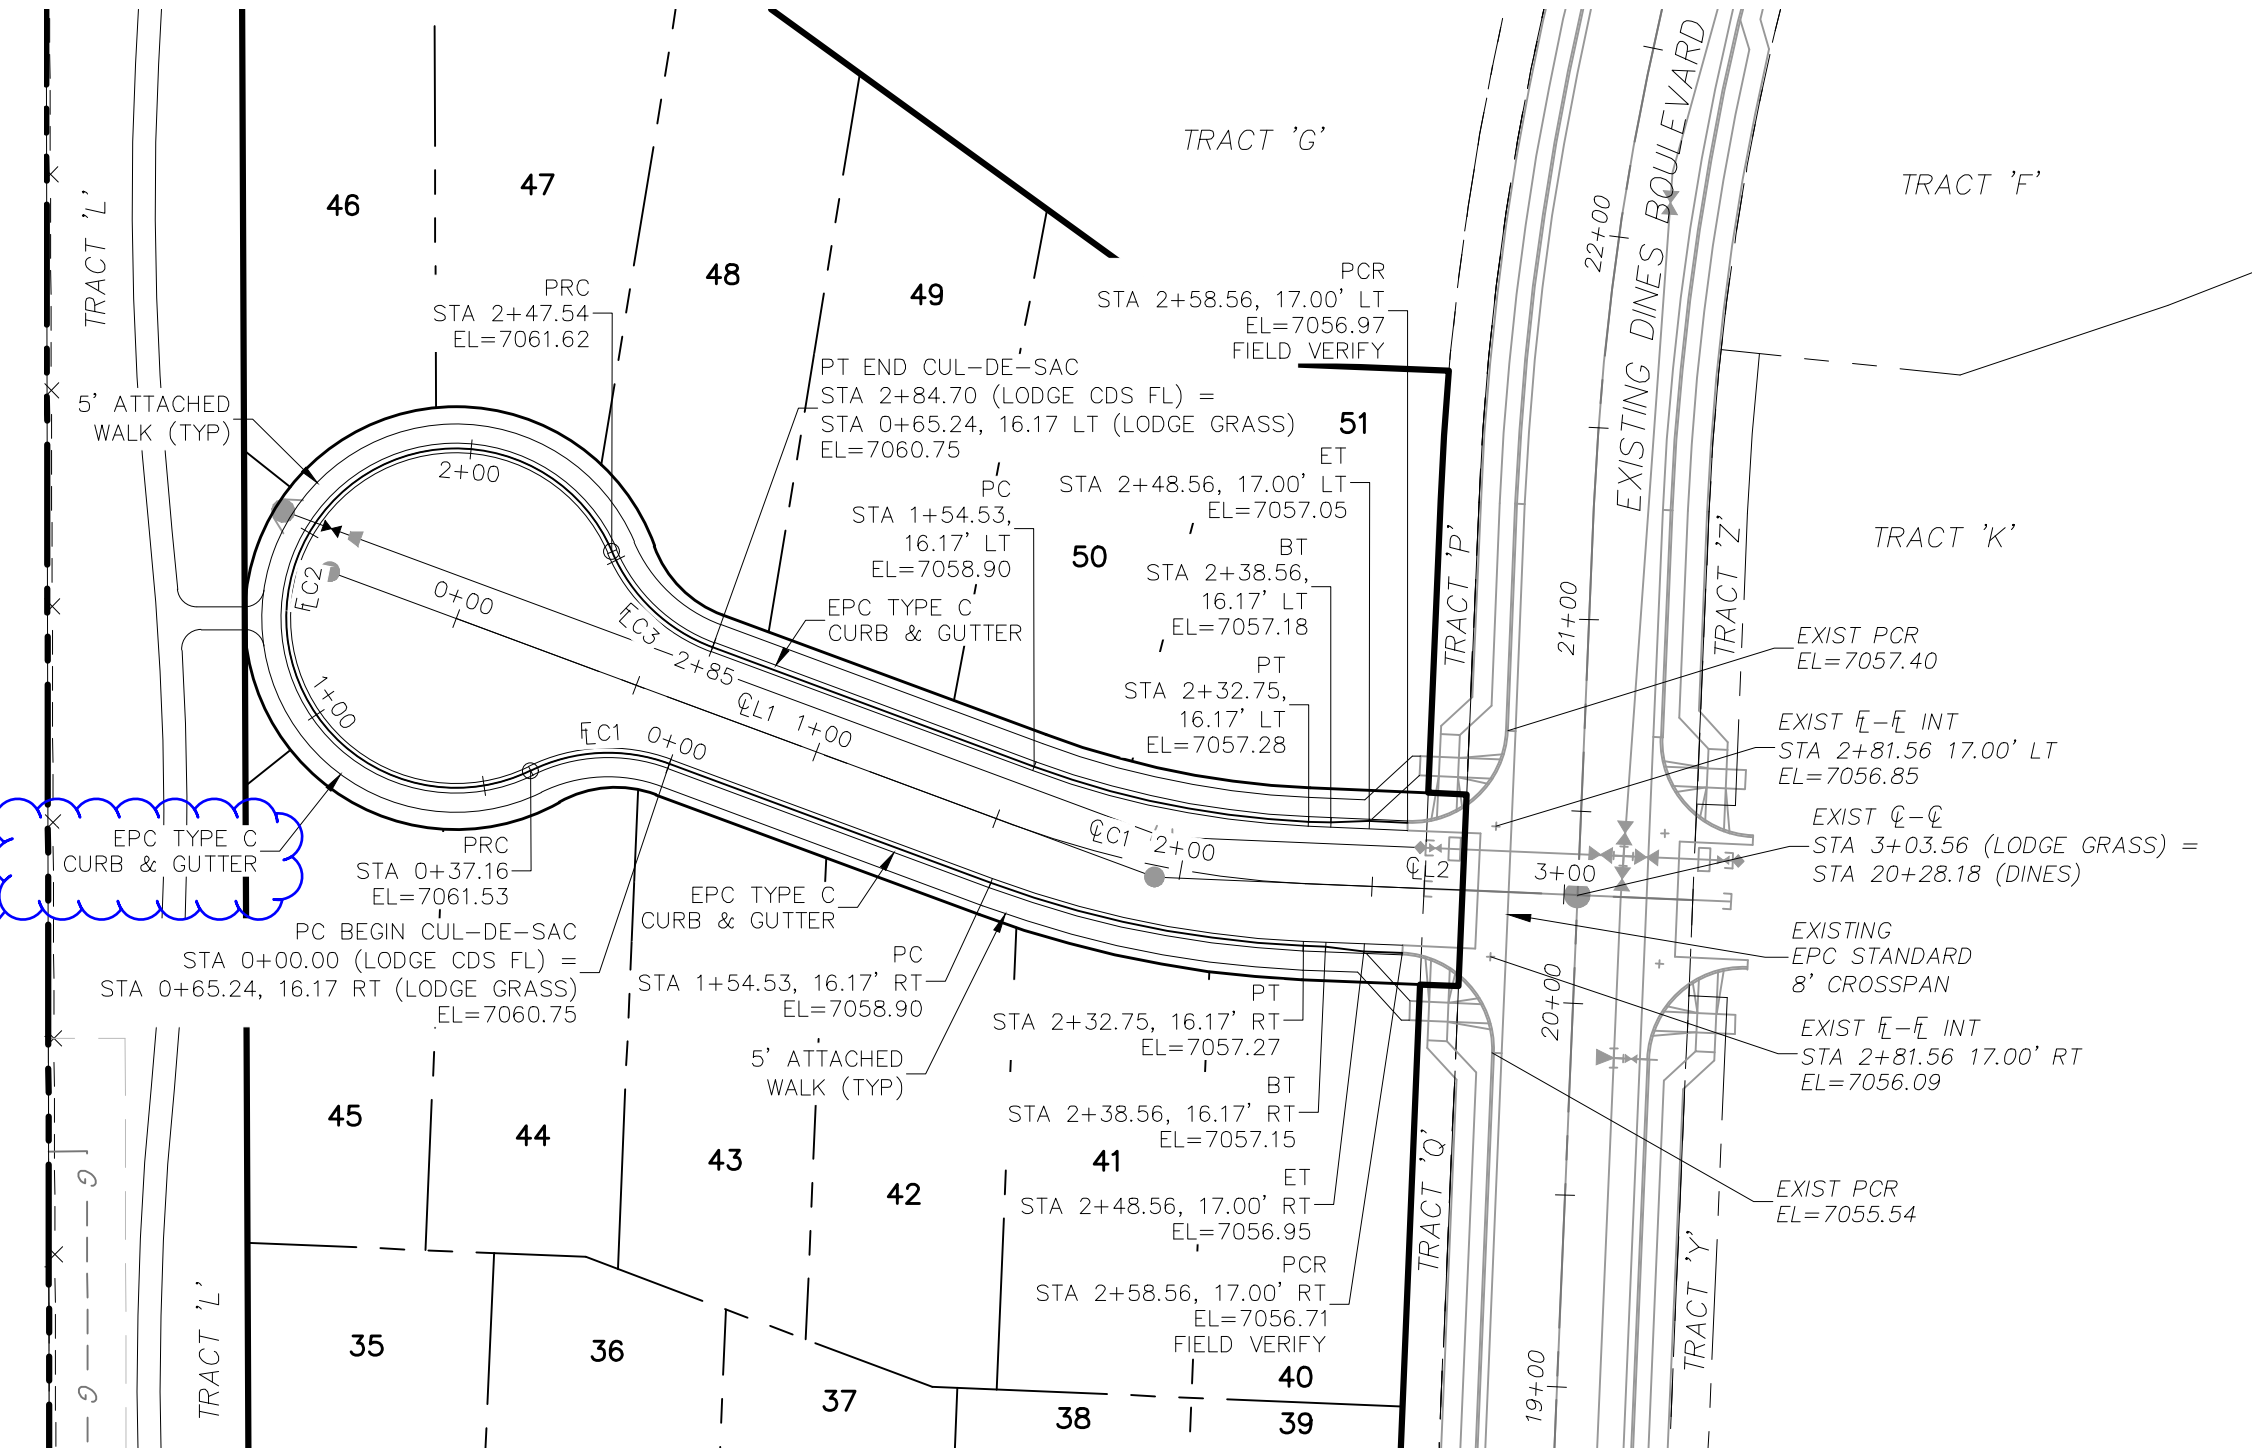

LODGE GRASS WAY
STA 0+00.00 TO STA 2+58.56

- ABBREVIATION LEGEND**
- CL-CL CENTERLINE INTERSECTION
 - FL-FL FLOWLINE INTERSECTION
 - BT BEGIN TRANSITION
 - ET END TRANSITION
 - PC POINT OF CURVE
 - PCC POINT OF COMPOUND CURVE
 - PCR POINT OF CURB RETURN
 - PRC POINT OF REVERSE CURVE
 - PT POINT OF TANGENT
 - EL ELEVATION
 - LT LEFT
 - RT RIGHT
- STREET ABBREVIATIONS**
- KC KINTLA COURT
 - LGW LODGE GRASS WAY
 - MW MOSBY WAY
 - SW SPRAGUE WAY
 - WW WHITEFISH WAY
 - DB DINES BOULEVARD (EX.)
 - CDS CUL-DE-SAC

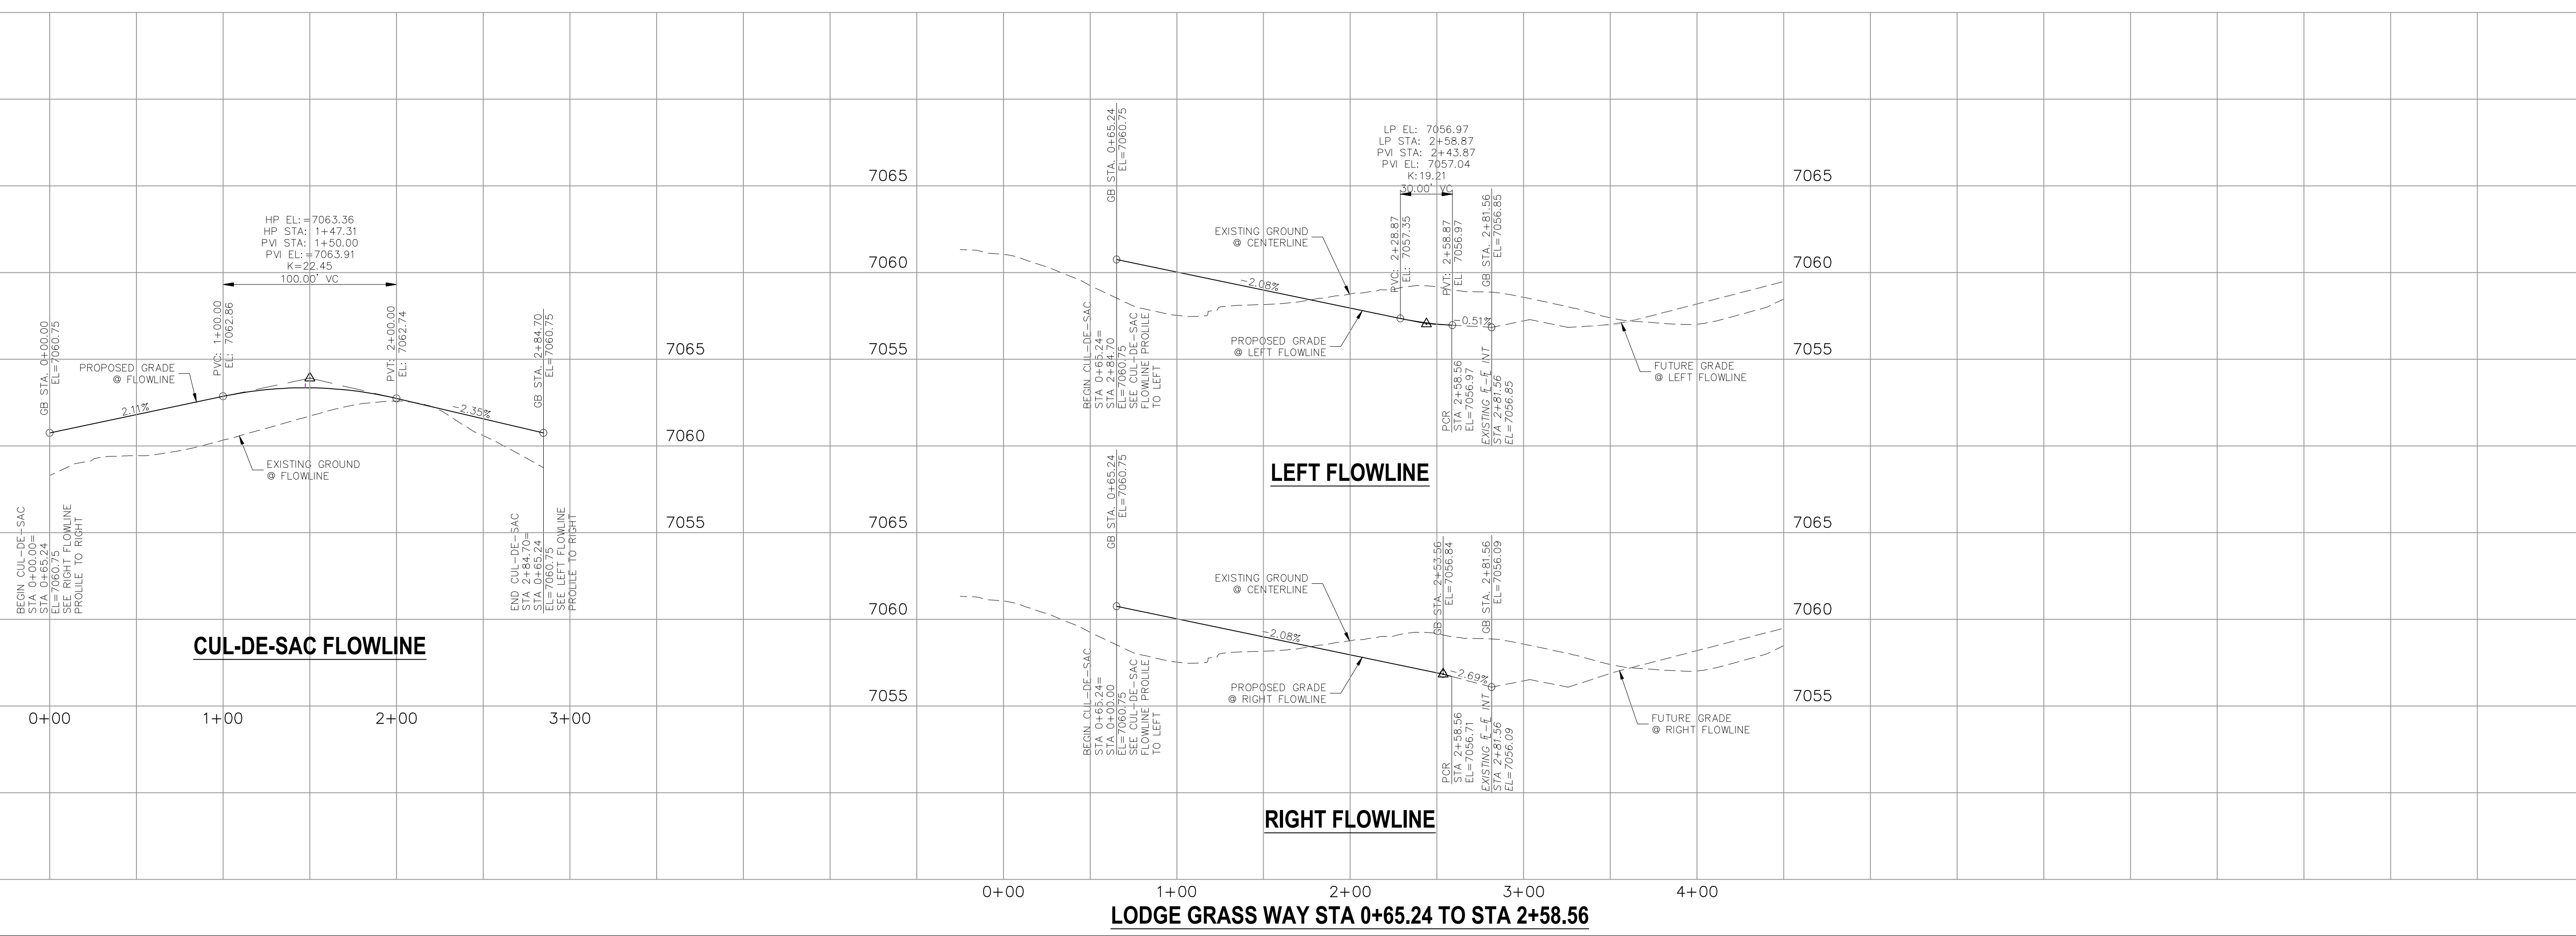


FOR AND ON BEHALF OF M&S CIVIL CONSULTANTS, INC.

MARCIL A. SANCHEZ, COLORADO P.E. NO. 37160


NO.	DATE	BY	DESCRIPTION	APPROV'D BY	DATE

THE ENGINEER PREPARING THESE PLANS WILL NOT BE RESPONSIBLE OR LIABLE FOR UNAUTHORIZED CHANGES TO OR USES OF THESE PLANS. ALL CHANGES TO THE PLANS MUST BE IN WRITING AND MUST BE APPROVED BY THE PREPARER OF THESE PLANS.

CAUTION

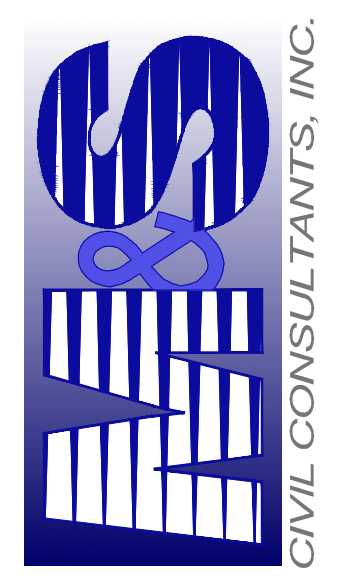

20 BOULDER CRESCENT, SUITE 110
 COLORADO SPRINGS, CO 80903

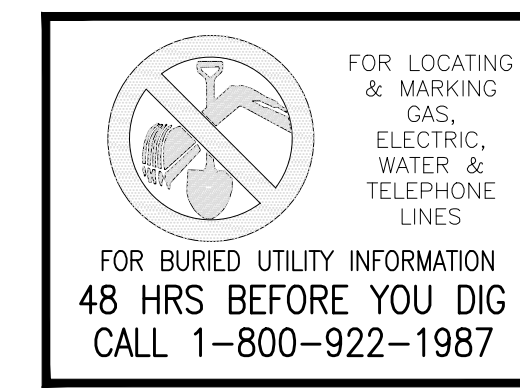

20 BOULDER CRESCENT, SUITE 110
 COLORADO SPRINGS, CO 80903

CIVIL CONSULTANTS, INC.


FOR AND ON BEHALF OF
 M&S CIVIL CONSULTANTS, INC.

REVISIONS:

NO.	DATE	BY	DESCRIPTION	APPROVED BY	DATE

THE ENGINEER PREPARING THESE PLANS WILL NOT BE RESPONSIBLE OR LIABLE FOR UNAUTHORIZED CHANGES TO OR USES OF THESE PLANS. ALL CHANGES TO THE PLANS MUST BE IN WRITING AND MUST BE APPROVED BY THE PREPARER OF THESE PLANS.

CAUTION

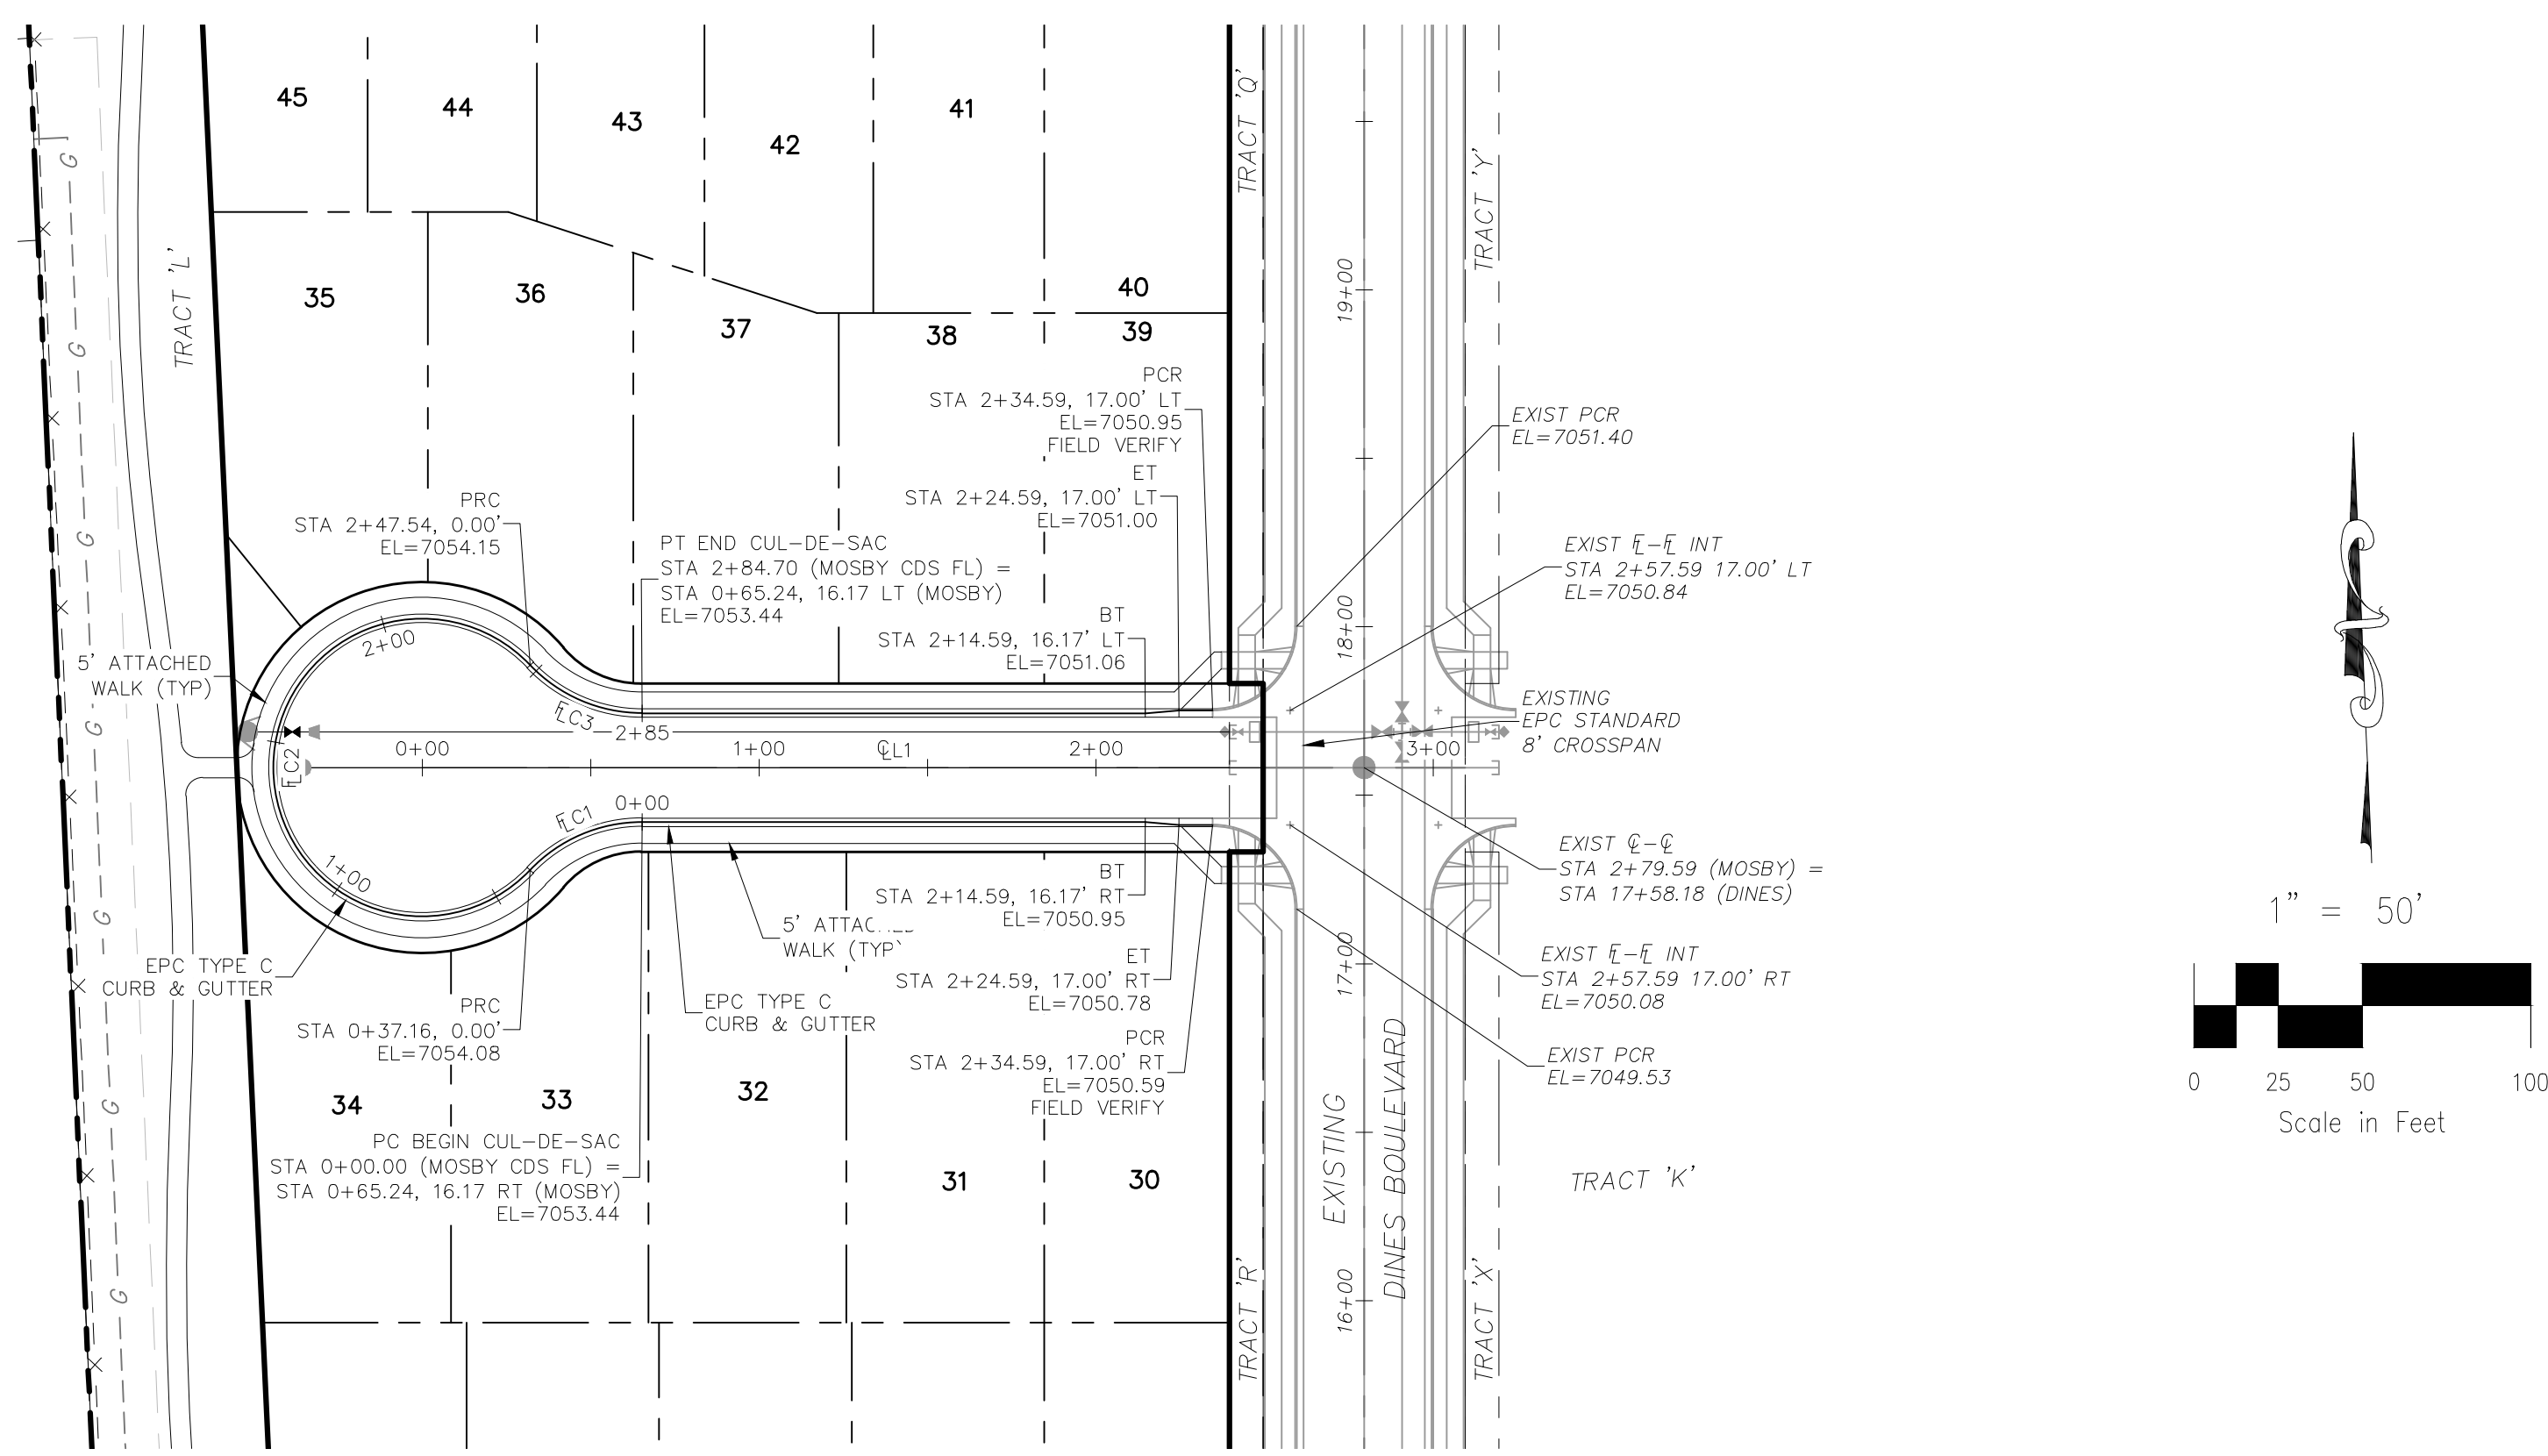


CENTERLINE LINE TABLE

LINE	LENGTH	DIRECTION
CL1	279.59'	S87°35'34"E

CURB FLOWLINE CURVE TABLE


CURVE	RADIUS	LENGTH	DELTA
CL1	45.83'	37.16'	46°27'28"
CL2	44.17'	210.38'	272°54'56"
CL3	45.83'	37.16'	46°27'28"

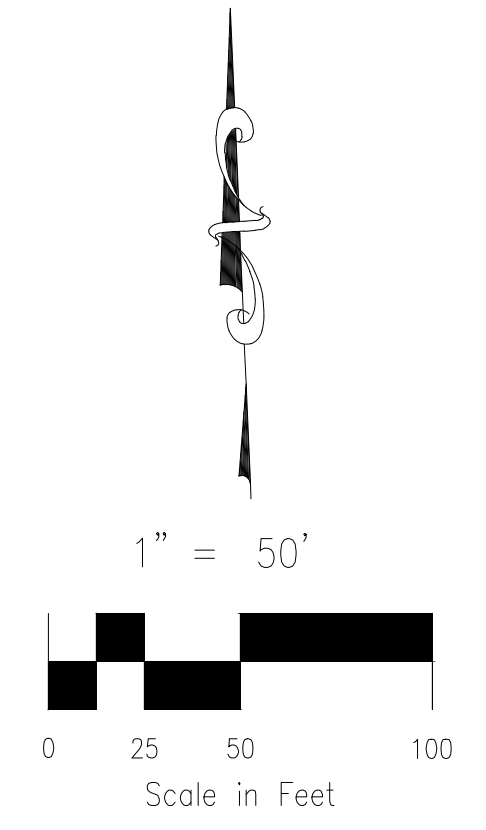


MOSBY WAY
STA 0+00.00 TO STA 2+34.59

- ABBREVIATION LEGEND**
- C-C CENTERLINE INTERSECTION
 - F-F FLOWLINE INTERSECTION
 - BT BEGIN TRANSITION
 - ET END TRANSITION
 - PC POINT OF CURVE
 - PCC POINT OF COMPOUND CURVE
 - PCR POINT OF CURB RETURN
 - PRC POINT OF REVERSE CURVE
 - PT POINT OF TANGENT
 - EL ELEVATION
 - LT LEFT
 - RT RIGHT

- STREET ABBREVIATIONS**
- KC KINTLA COURT
 - LGW LODGE GRASS WAY
 - MW MOSBY WAY
 - SW SPRAGUE WAY
 - WW WHITEFISH WAY
 - DB DINES BOULEVARD (EX.)
 - CDS CUL-DE-SAC

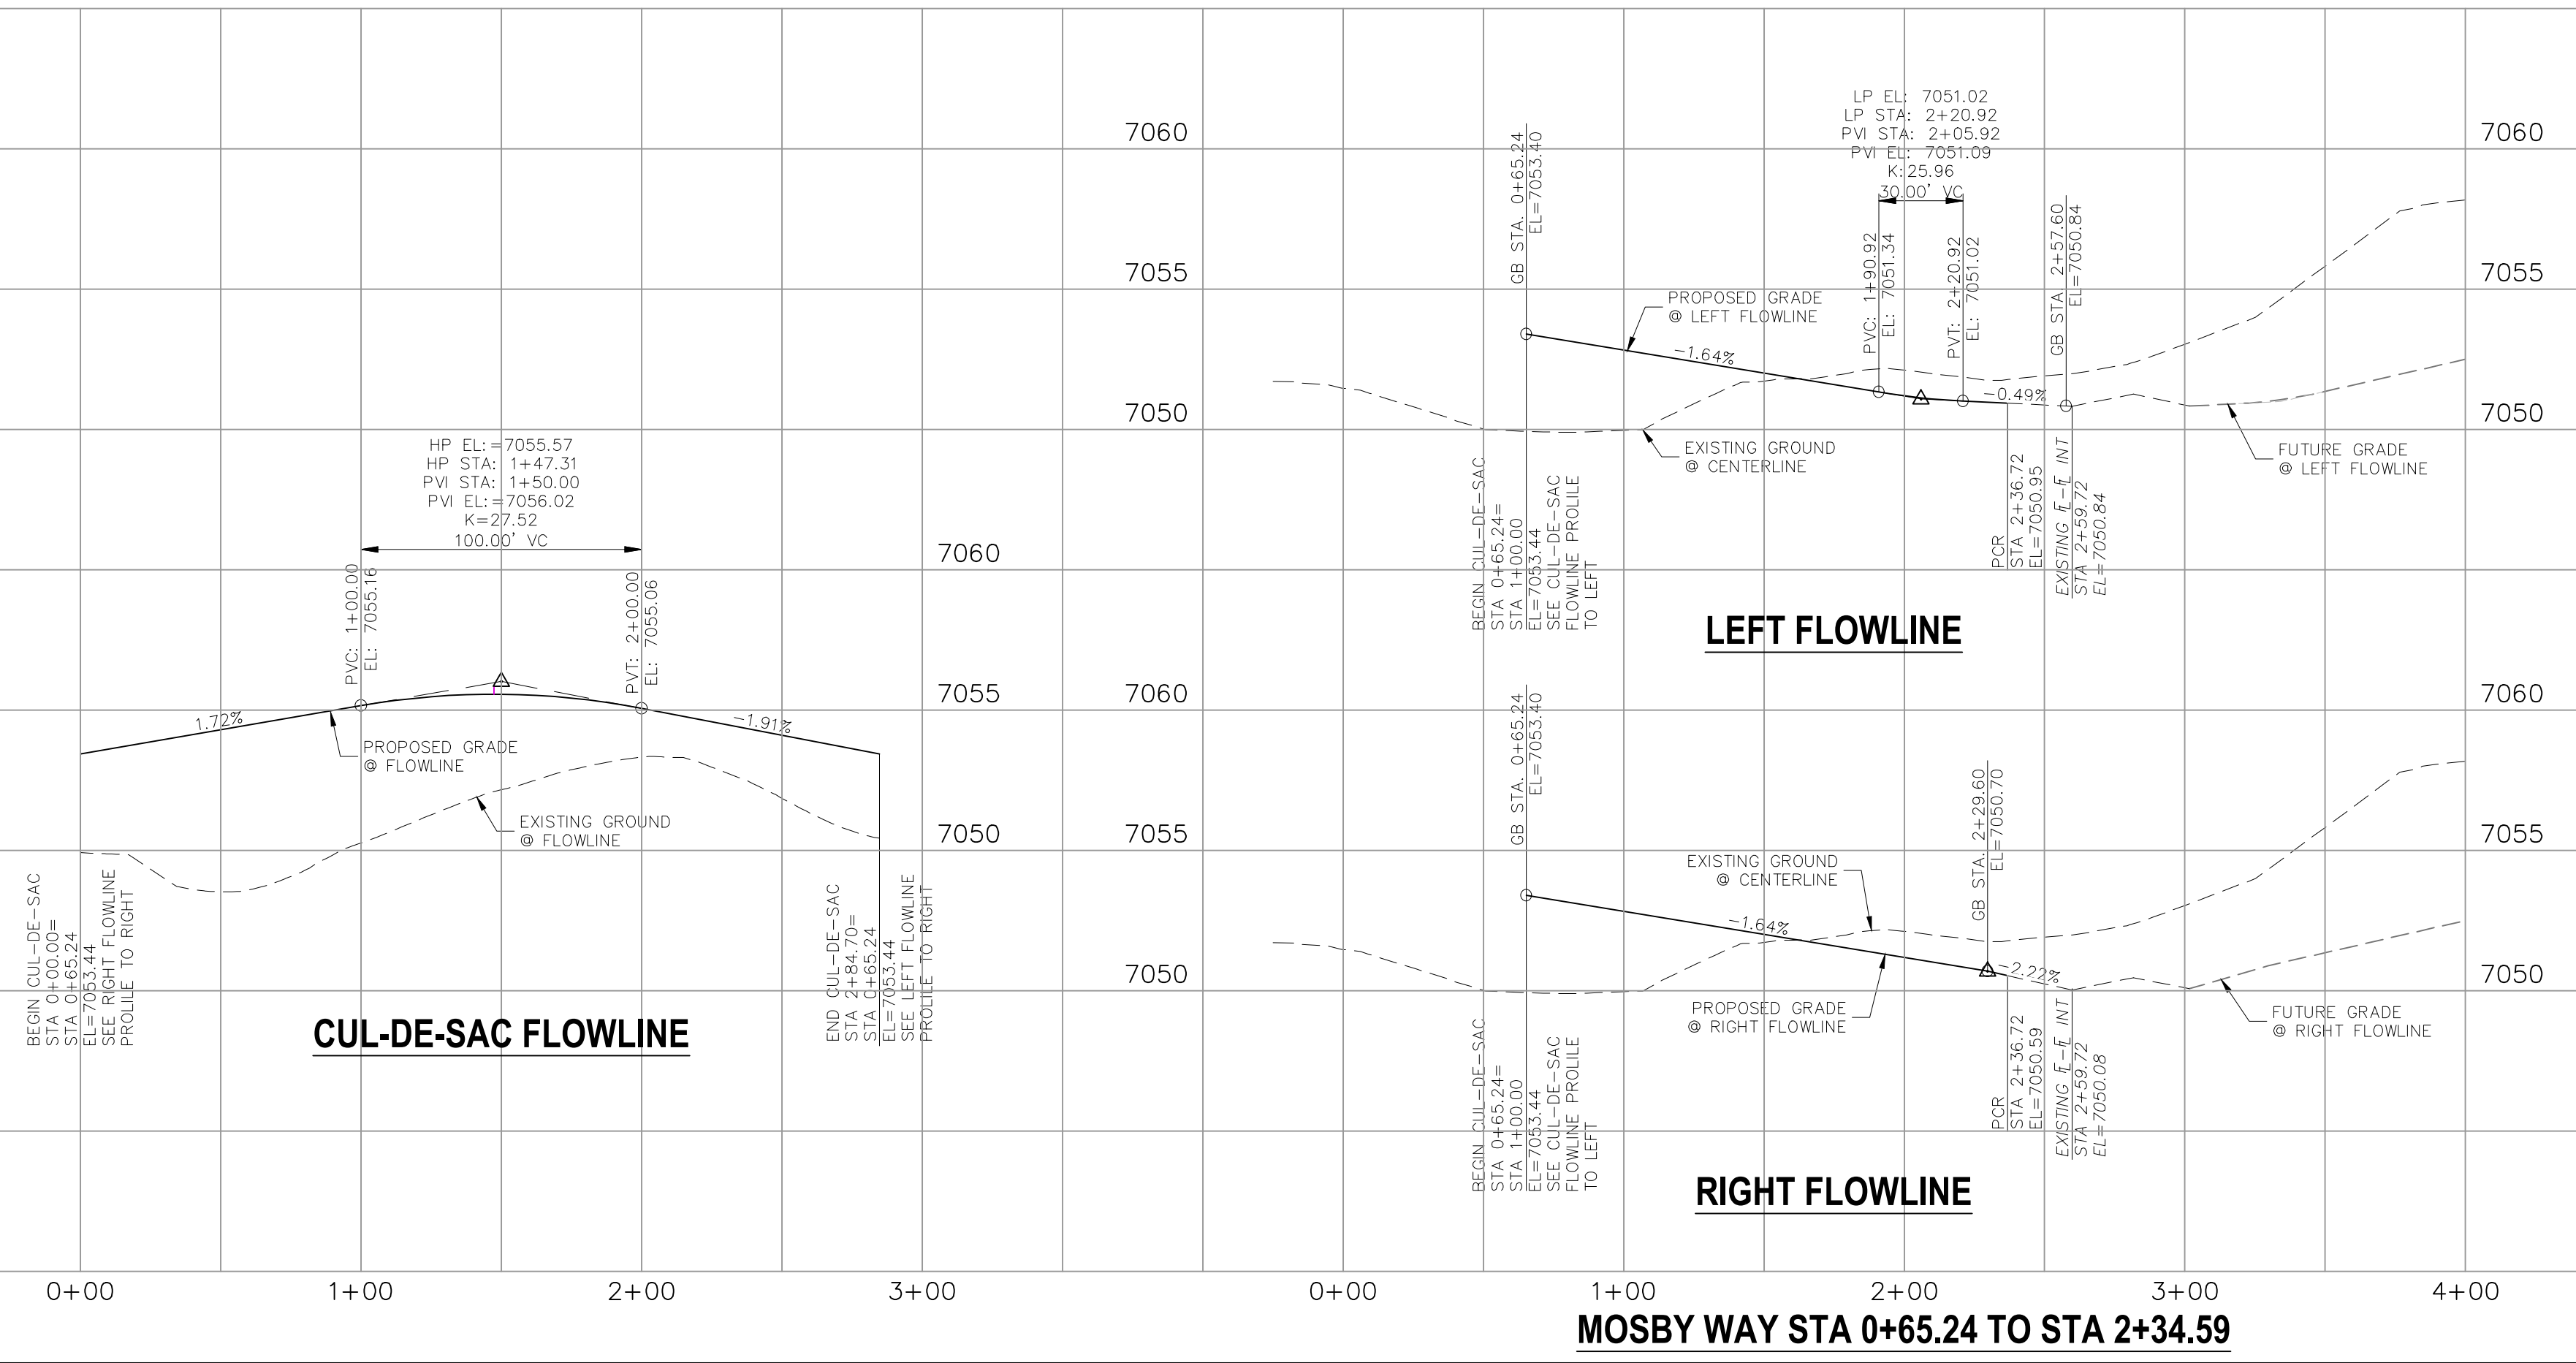

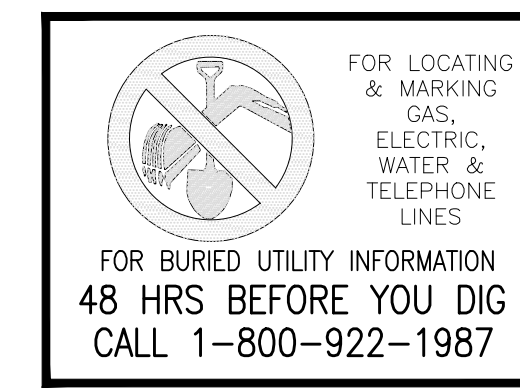

20 BOULDER CRESCENT, SUITE 110
 COLORADO SPRINGS, CO 80903
 PHONE: 719.955.5485

CIVIL CONSULTANTS, INC.


FOR AND ON BEHALF OF
 M&S CIVIL CONSULTANTS, INC.

REVISIONS:

NO.	DATE	BY	DESCRIPTION	APPROV. BY	DATE

THE ENGINEER PREPARING THESE PLANS WILL NOT BE RESPONSIBLE OR LIABLE FOR UNAUTHORIZED CHANGES TO OR USES OF THESE PLANS. ALL CHANGES TO THE PLANS MUST BE IN WRITING AND MUST BE APPROVED BY THE PREPARER OF THESE PLANS.

CAUTION

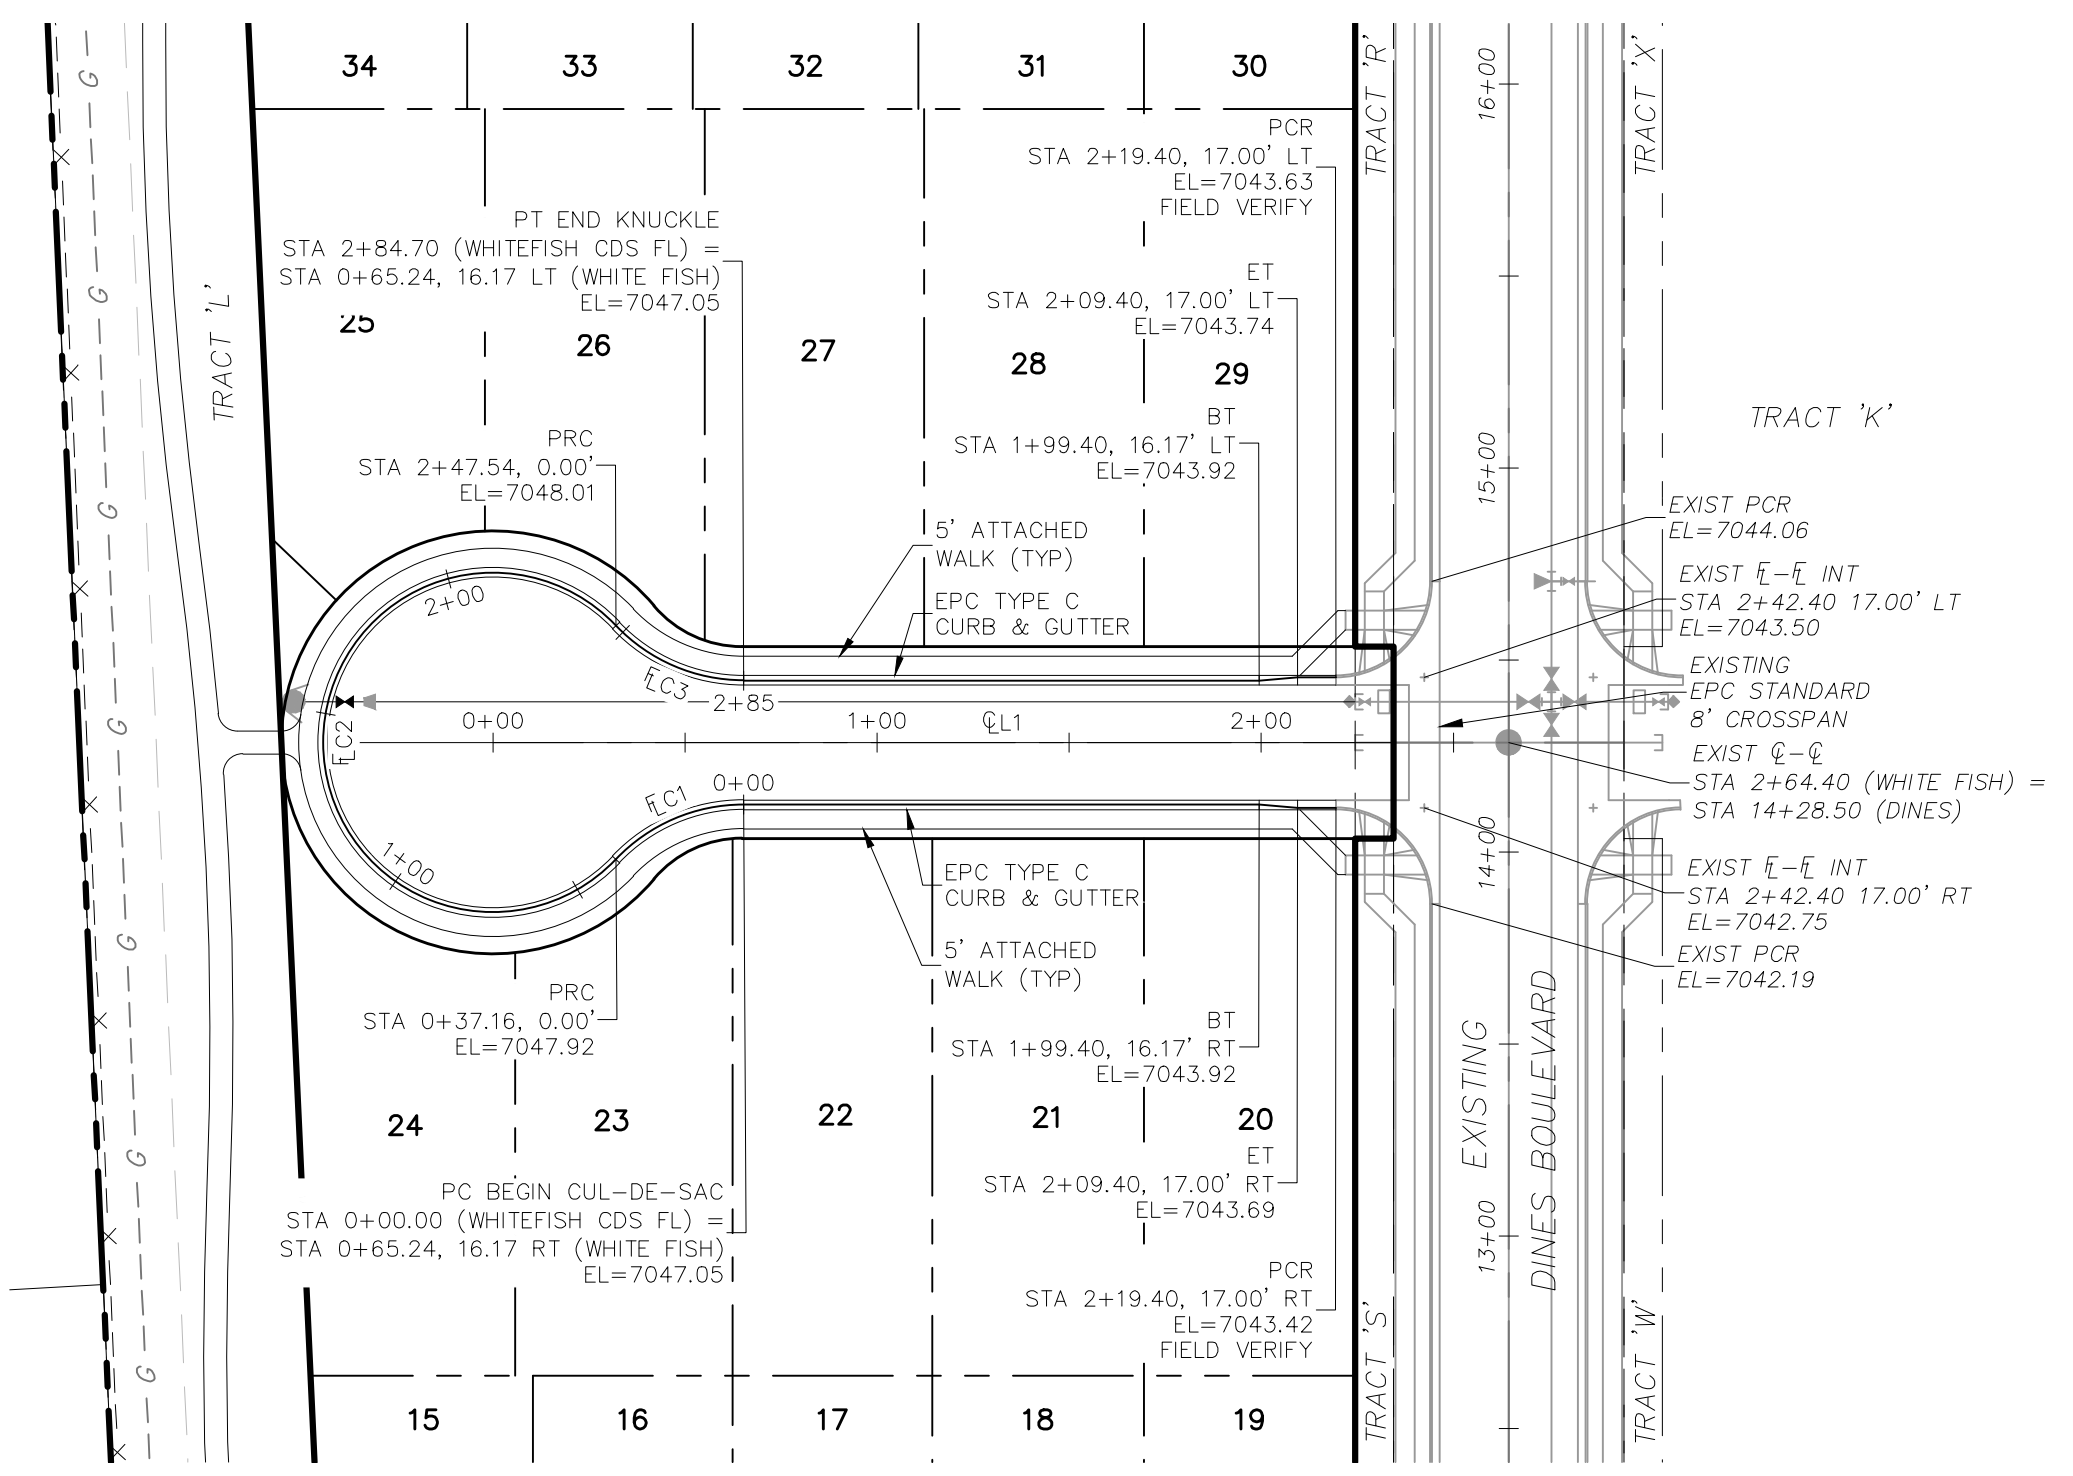


**WHITEFISH WAY
 0+00.00 TO STA 2+19.40**

CENTERLINE LINE TABLE

LINE	LENGTH	DIRECTION
EL1	264.40'	S87°35'34"E


CURB FLOWLINE CURVE TABLE

CURVE	RADIUS	LENGTH	DELTA
ELC1	45.83'	37.16'	46°27'28"
ELC2	44.17'	210.38'	272°54'56"
ELC3	45.83'	37.16'	46°27'28"

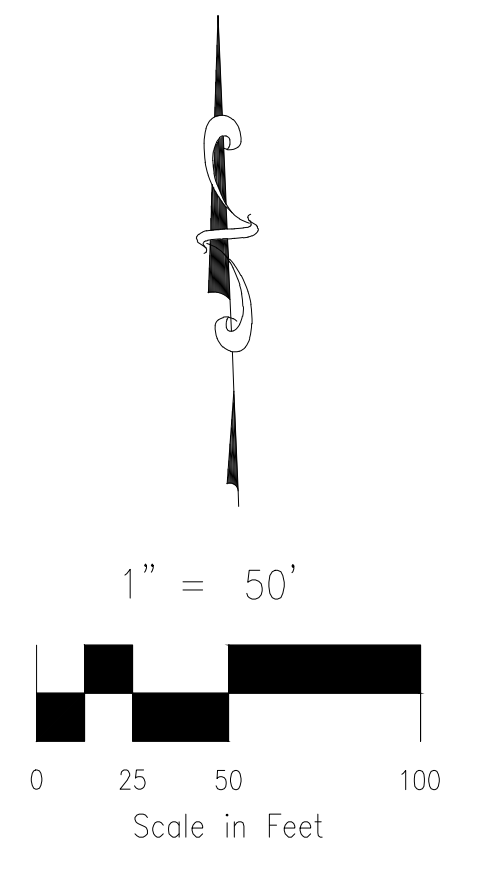


- ABBREVIATION LEGEND**
- C-C CENTERLINE INTERSECTION
 - F-F FLOWLINE INTERSECTION
 - BT BEGIN TRANSITION
 - ET END TRANSITION
 - PC POINT OF CURVE
 - PCC POINT OF COMPOUND CURVE
 - PCR POINT OF CURB RETURN
 - PRC POINT OF REVERSE CURVE
 - PT POINT OF TANGENT
 - EL ELEVATION
 - LT LEFT
 - RT RIGHT

- STREET ABBREVIATIONS**
- KC KINTLA COURT
 - LGW LODGE GRASS WAY
 - MW MOSBY WAY
 - SW SPRAGUE WAY
 - WW WHITEFISH WAY
 - DB DINES BOULEVARD (EX.)
 - CDS CUL-DE-SAC


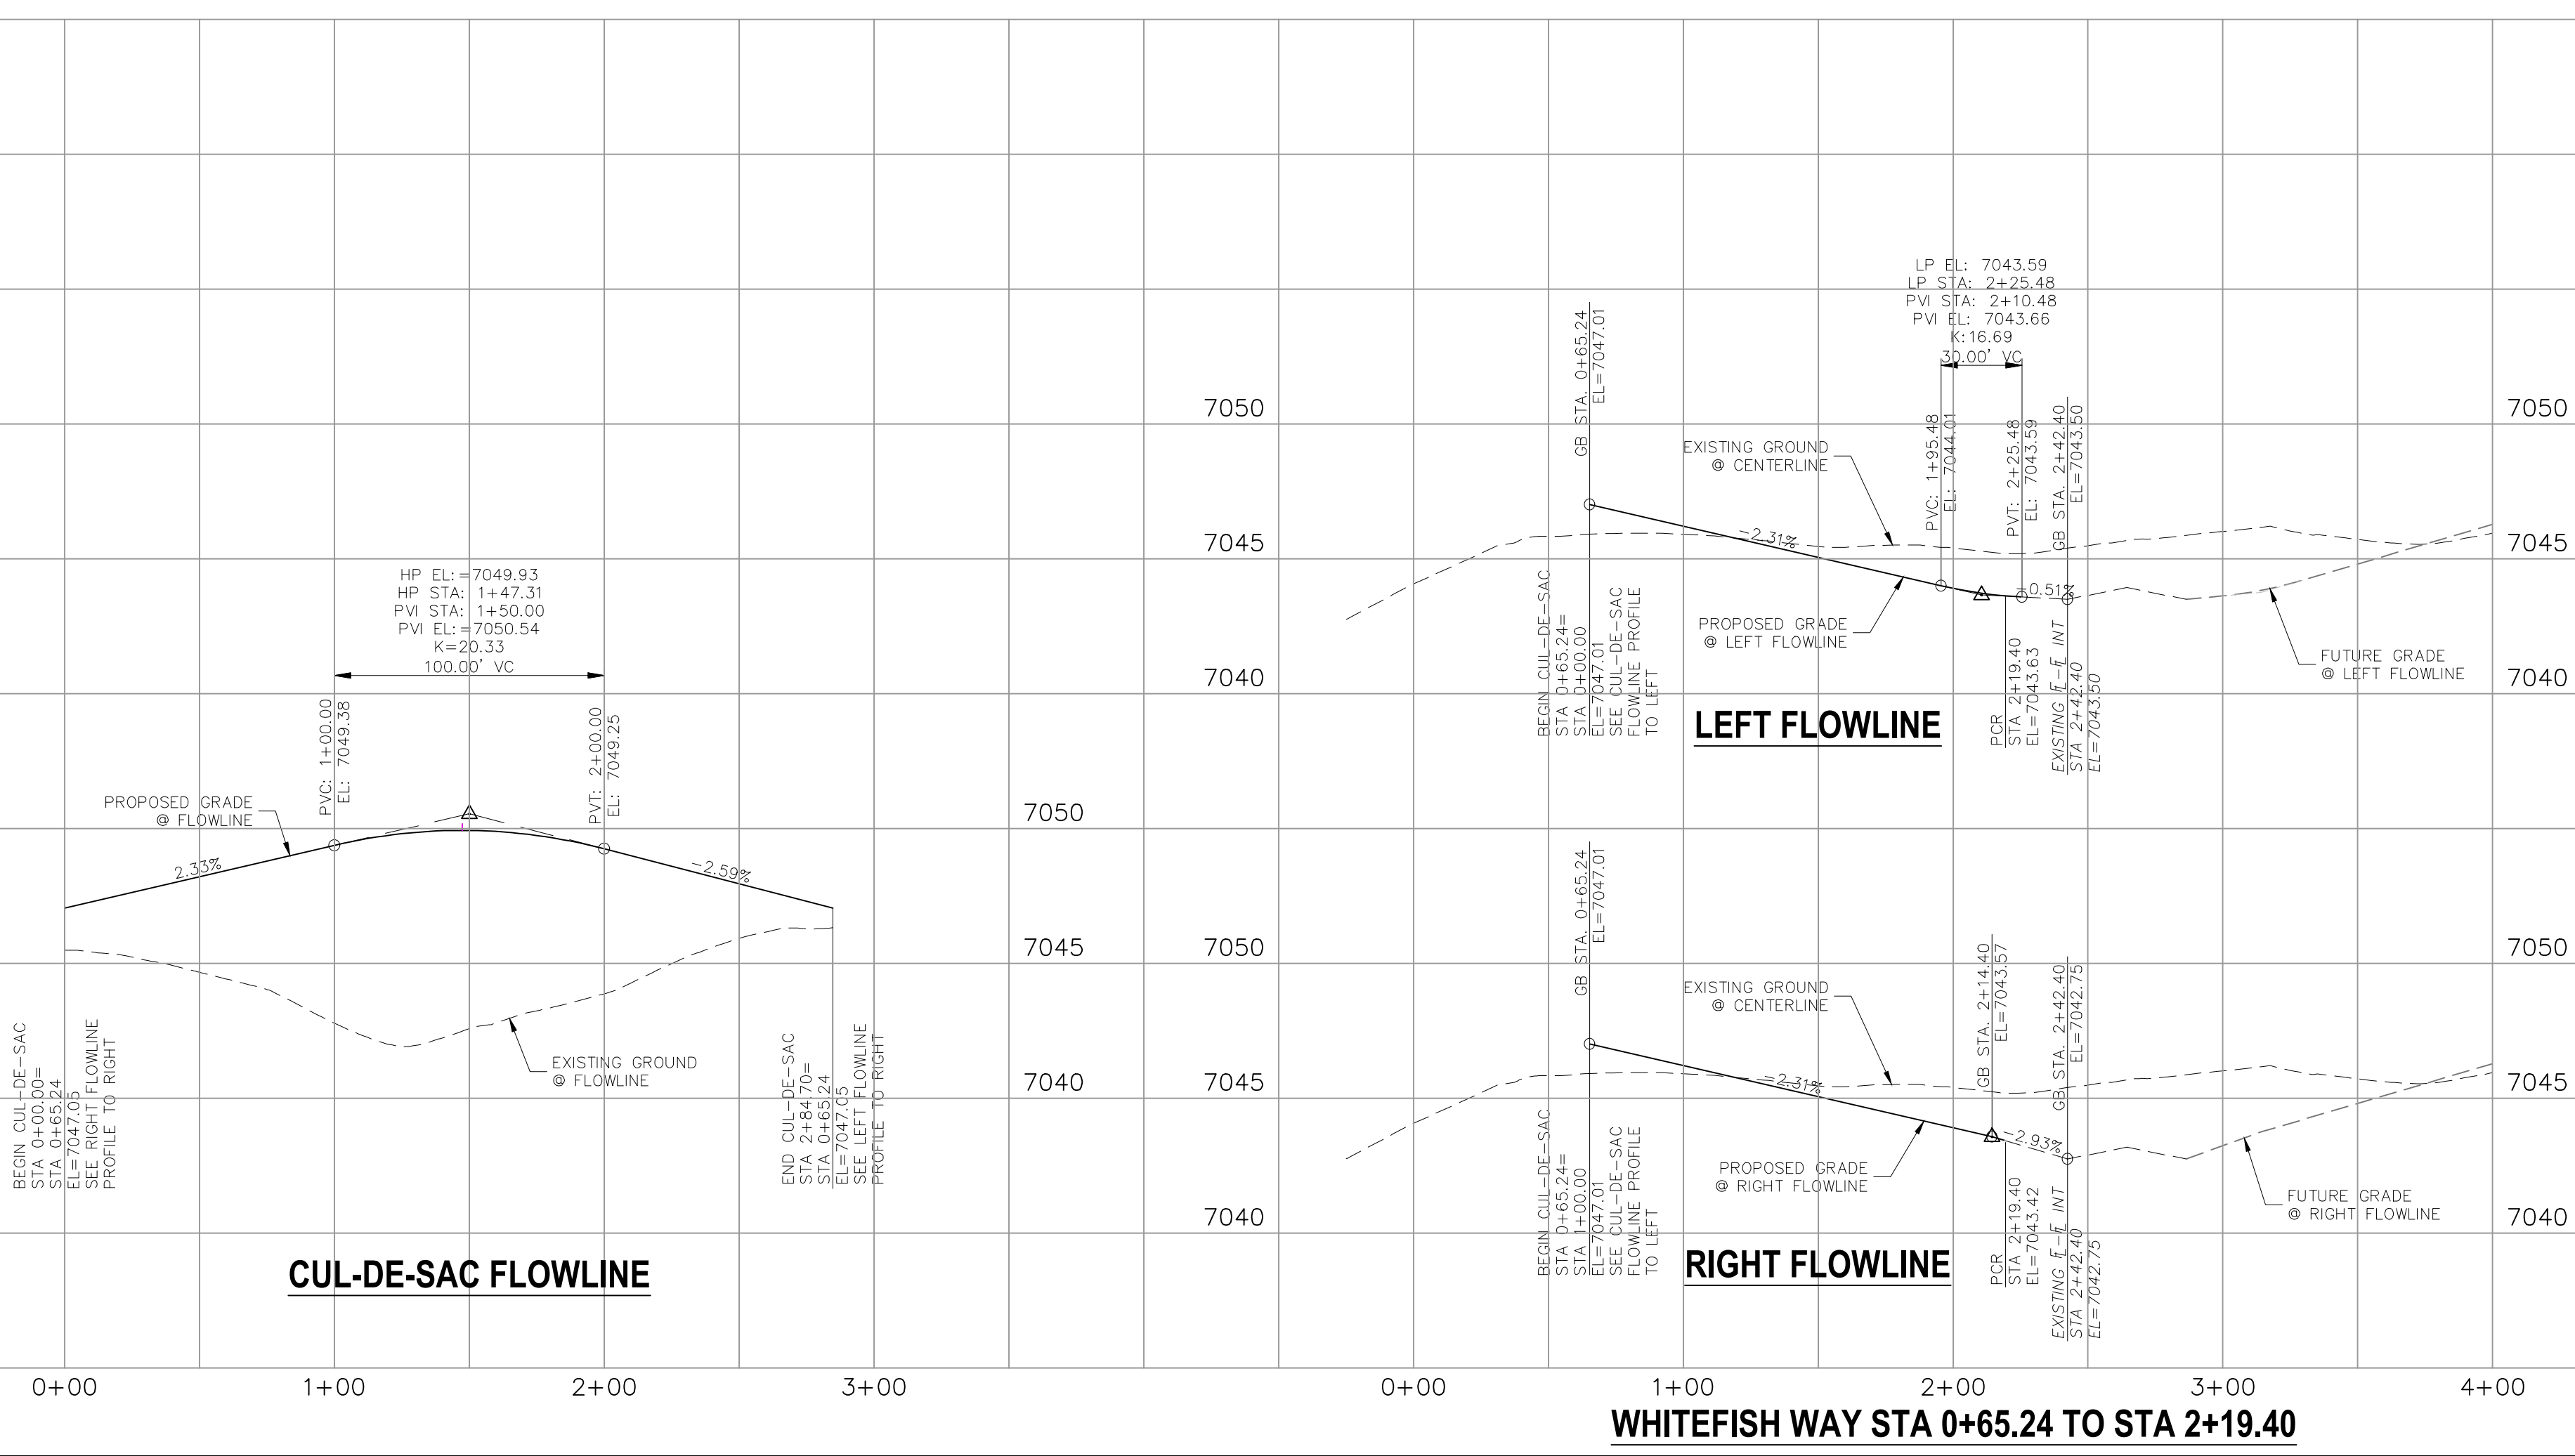


CENTERLINE LINE TABLE		
LINE	LENGTH	DIRECTION
EL1	249.21'	S87°35'34"E

CURB FLOWLINE CURVE TABLE			
CURVE	RADIUS	LENGTH	DELTA
EC1	45.83'	37.16'	46°27'28"
EC2	44.17'	210.38'	272°54'56"
EC3	45.83'	37.16'	46°27'28"

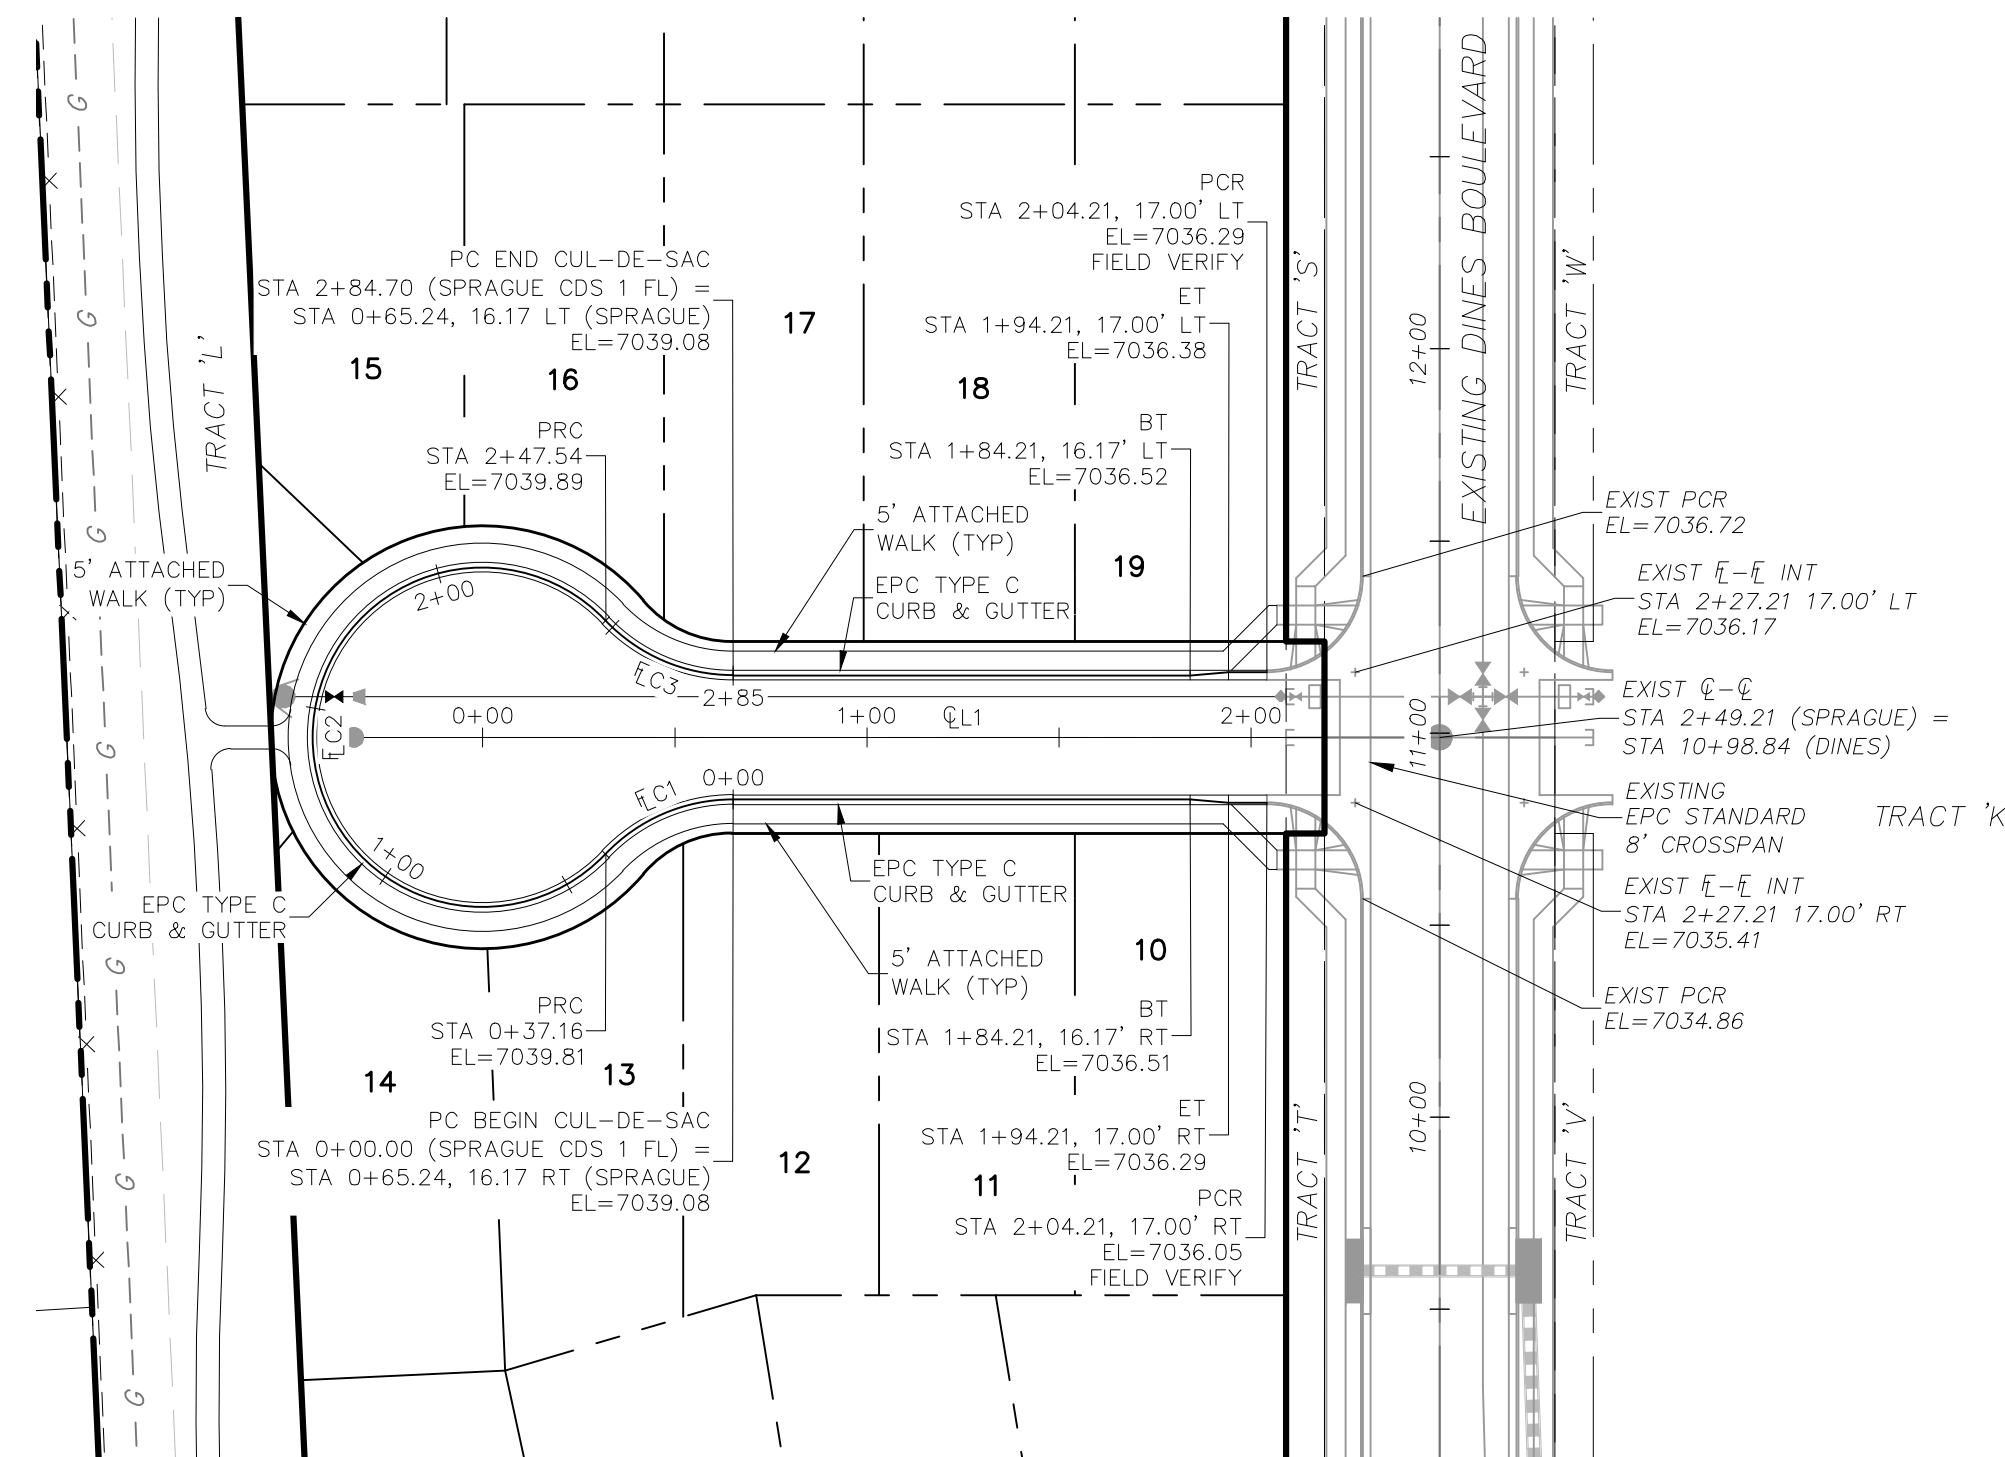

**SPRAGUE WAY
STA 0+00.00 TO STA 2+04.21**

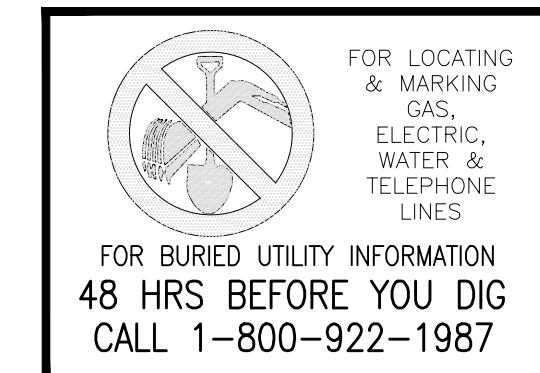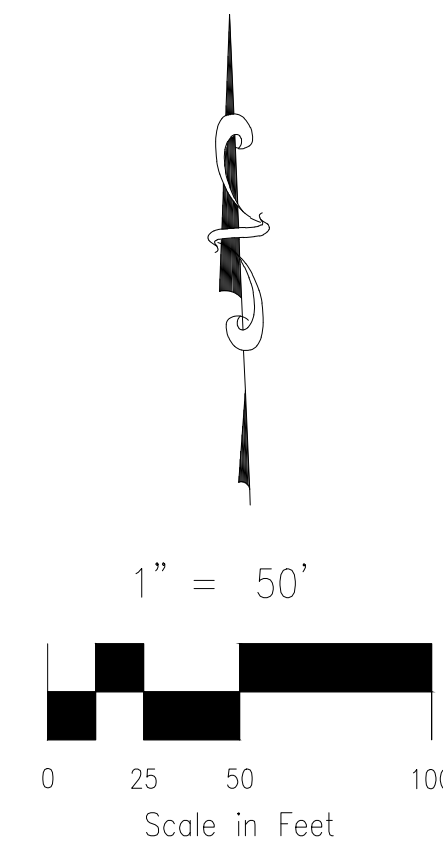


ABBREVIATION LEGEND

- EC-C CENTERLINE INTERSECTION
- FI-E FLOWLINE INTERSECTION
- BT BEGIN TRANSITION
- ET END TRANSITION
- PC POINT OF CURVE
- PCC POINT OF COMPOUND CURVE
- PCR POINT OF CURB RETURN
- PRC POINT OF REVERSE CURVE
- PT POINT OF TANGENT
- LT LEFT
- RT RIGHT

STREET ABBREVIATIONS

- KC KINTLA COURT
- LGW LODGE GRASS WAY
- MW MOSBY WAY
- SW SPRAGUE WAY
- WW WHITEFISH WAY
- DB DINES BOULEVARD (EX.)
- CDS CUL-DE-SAC

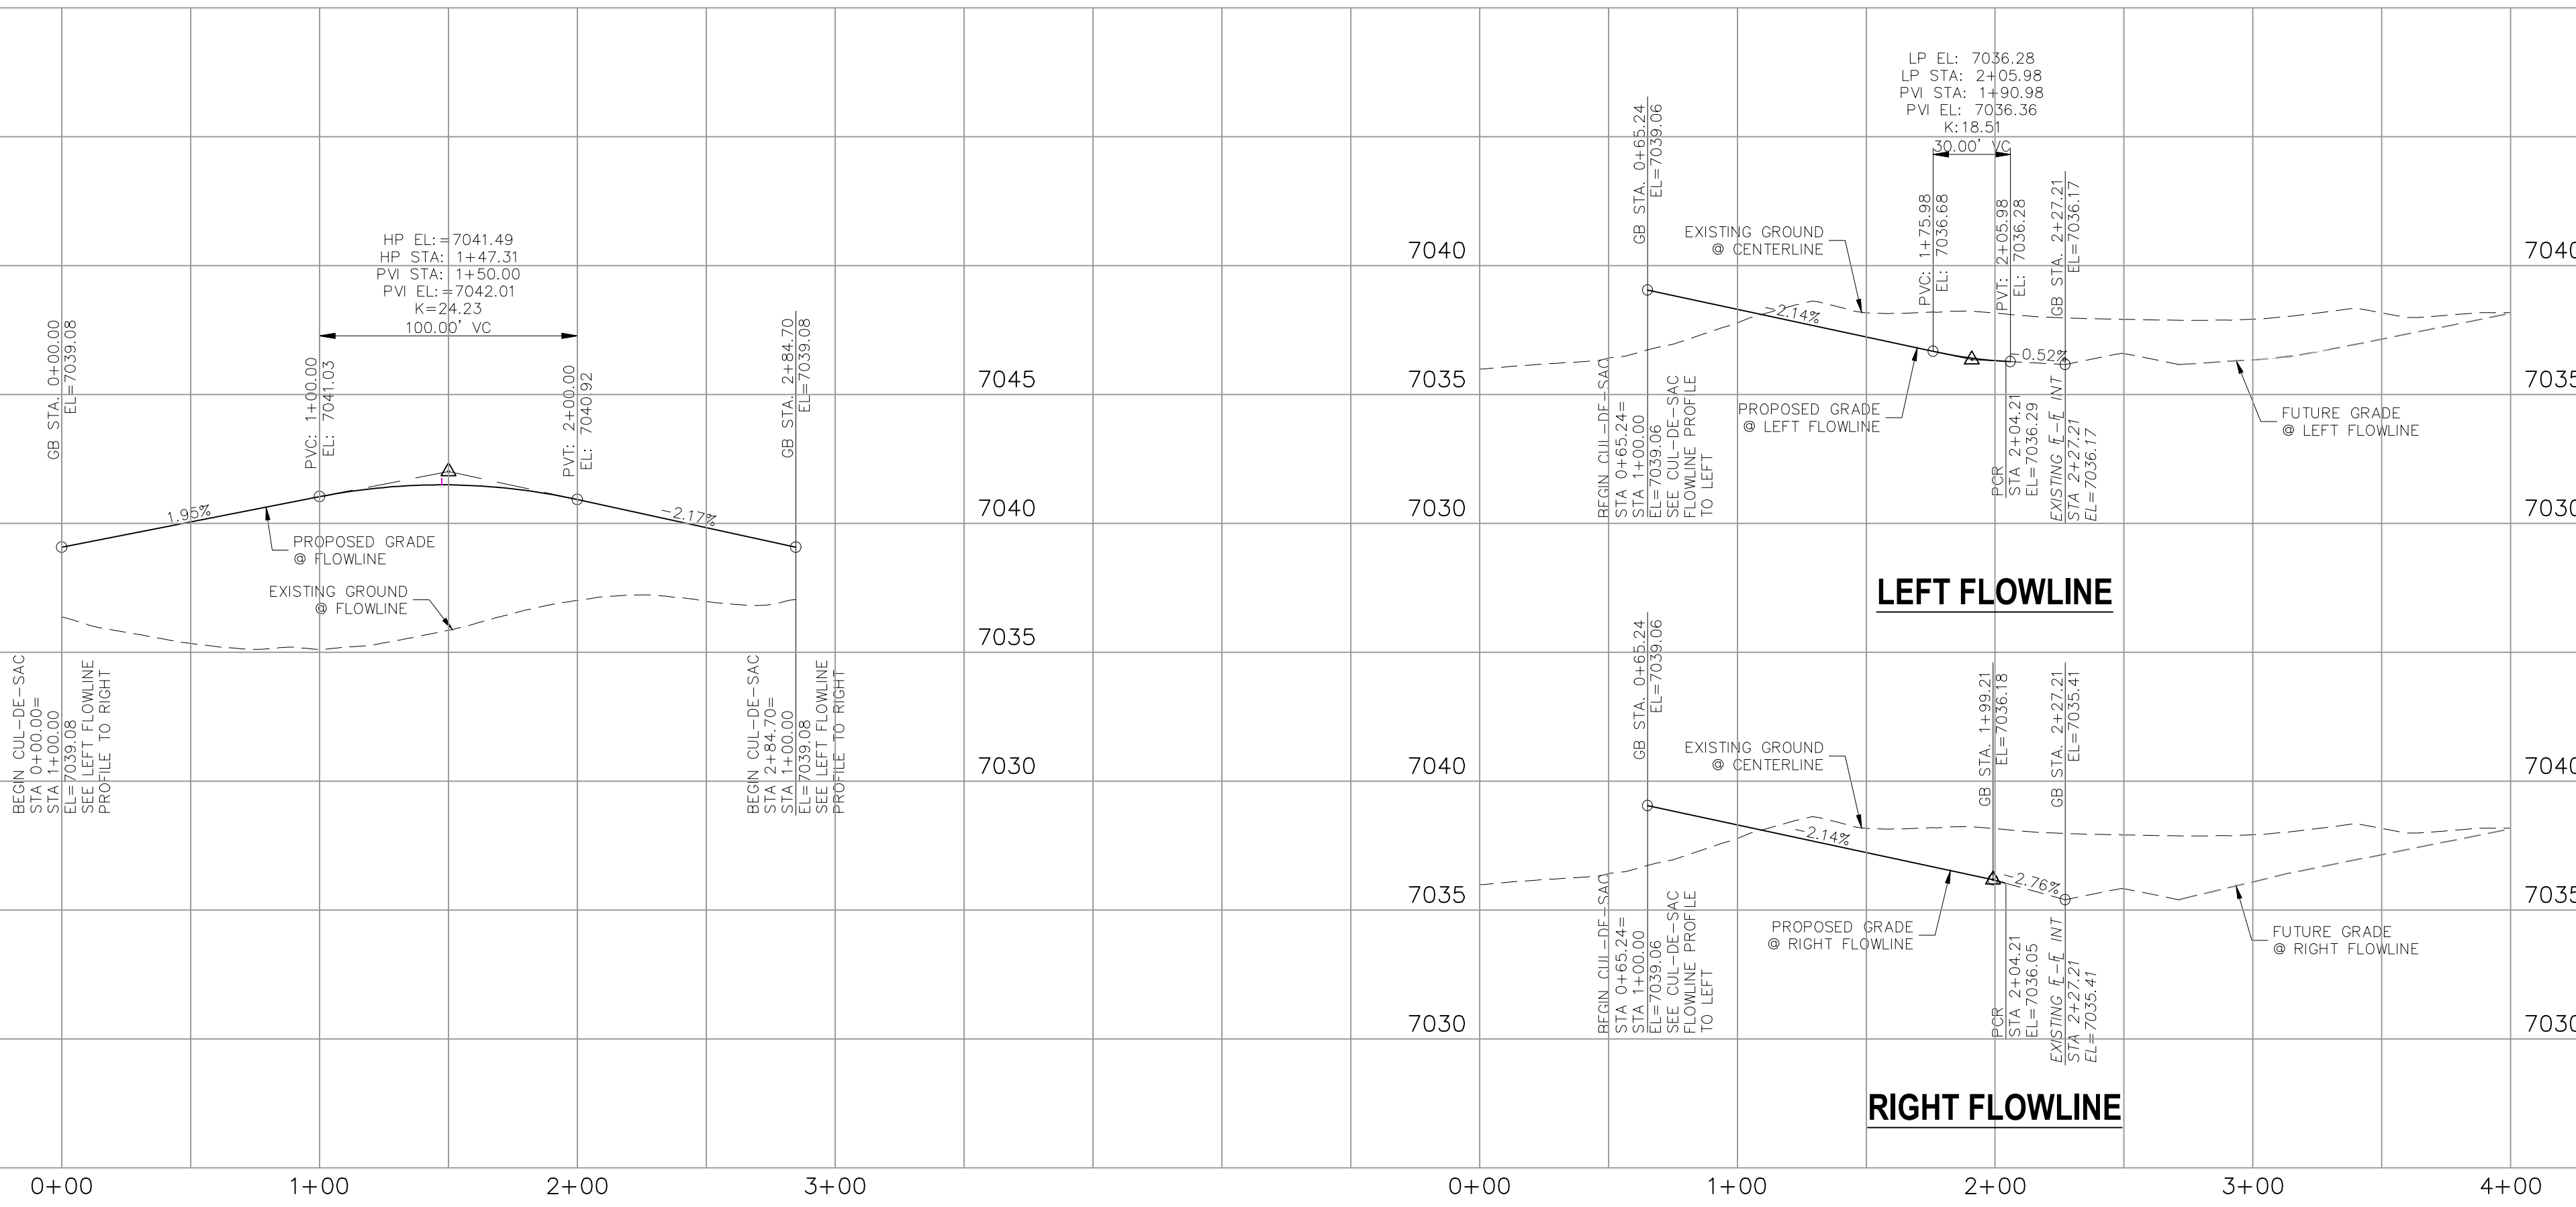

SPRAGUE WAY STA 0+65.24 TO STA 2+04.21

20 BOULDER CRESCENT, SUITE 110
COLORADO SPRINGS, CO 80903
PHONE: 719.555.5485

CIVIL CONSULTANTS, INC.

FOR AND ON BEHALF OF
M&S CIVIL CONSULTANTS, INC.

NO.	DATE	BY	DESCRIPTION	APPROVED BY	DATE


THE ENGINEER PREPARING THESE PLANS WILL NOT BE RESPONSIBLE OR LIABLE FOR UNAUTHORIZED CHANGES TO OR USES OF THESE PLANS. ALL CHANGES TO THE PLANS MUST BE IN WRITING AND MUST BE APPROVED BY THE PREPARER OF THESE PLANS.

CAUTION



CENTERLINE LINE TABLE		
LINE	LENGTH	DIRECTION
CL1	243.47'	N83°26'41"E

CURB FLOWLINE CURVE TABLE			
CURVE	RADIUS	LENGTH	DELTA
CL1	38.83'	31.34'	46°14'48"
CL2	46.17'	224.96'	279°11'37"
CL3	38.83'	35.89'	52°56'49"

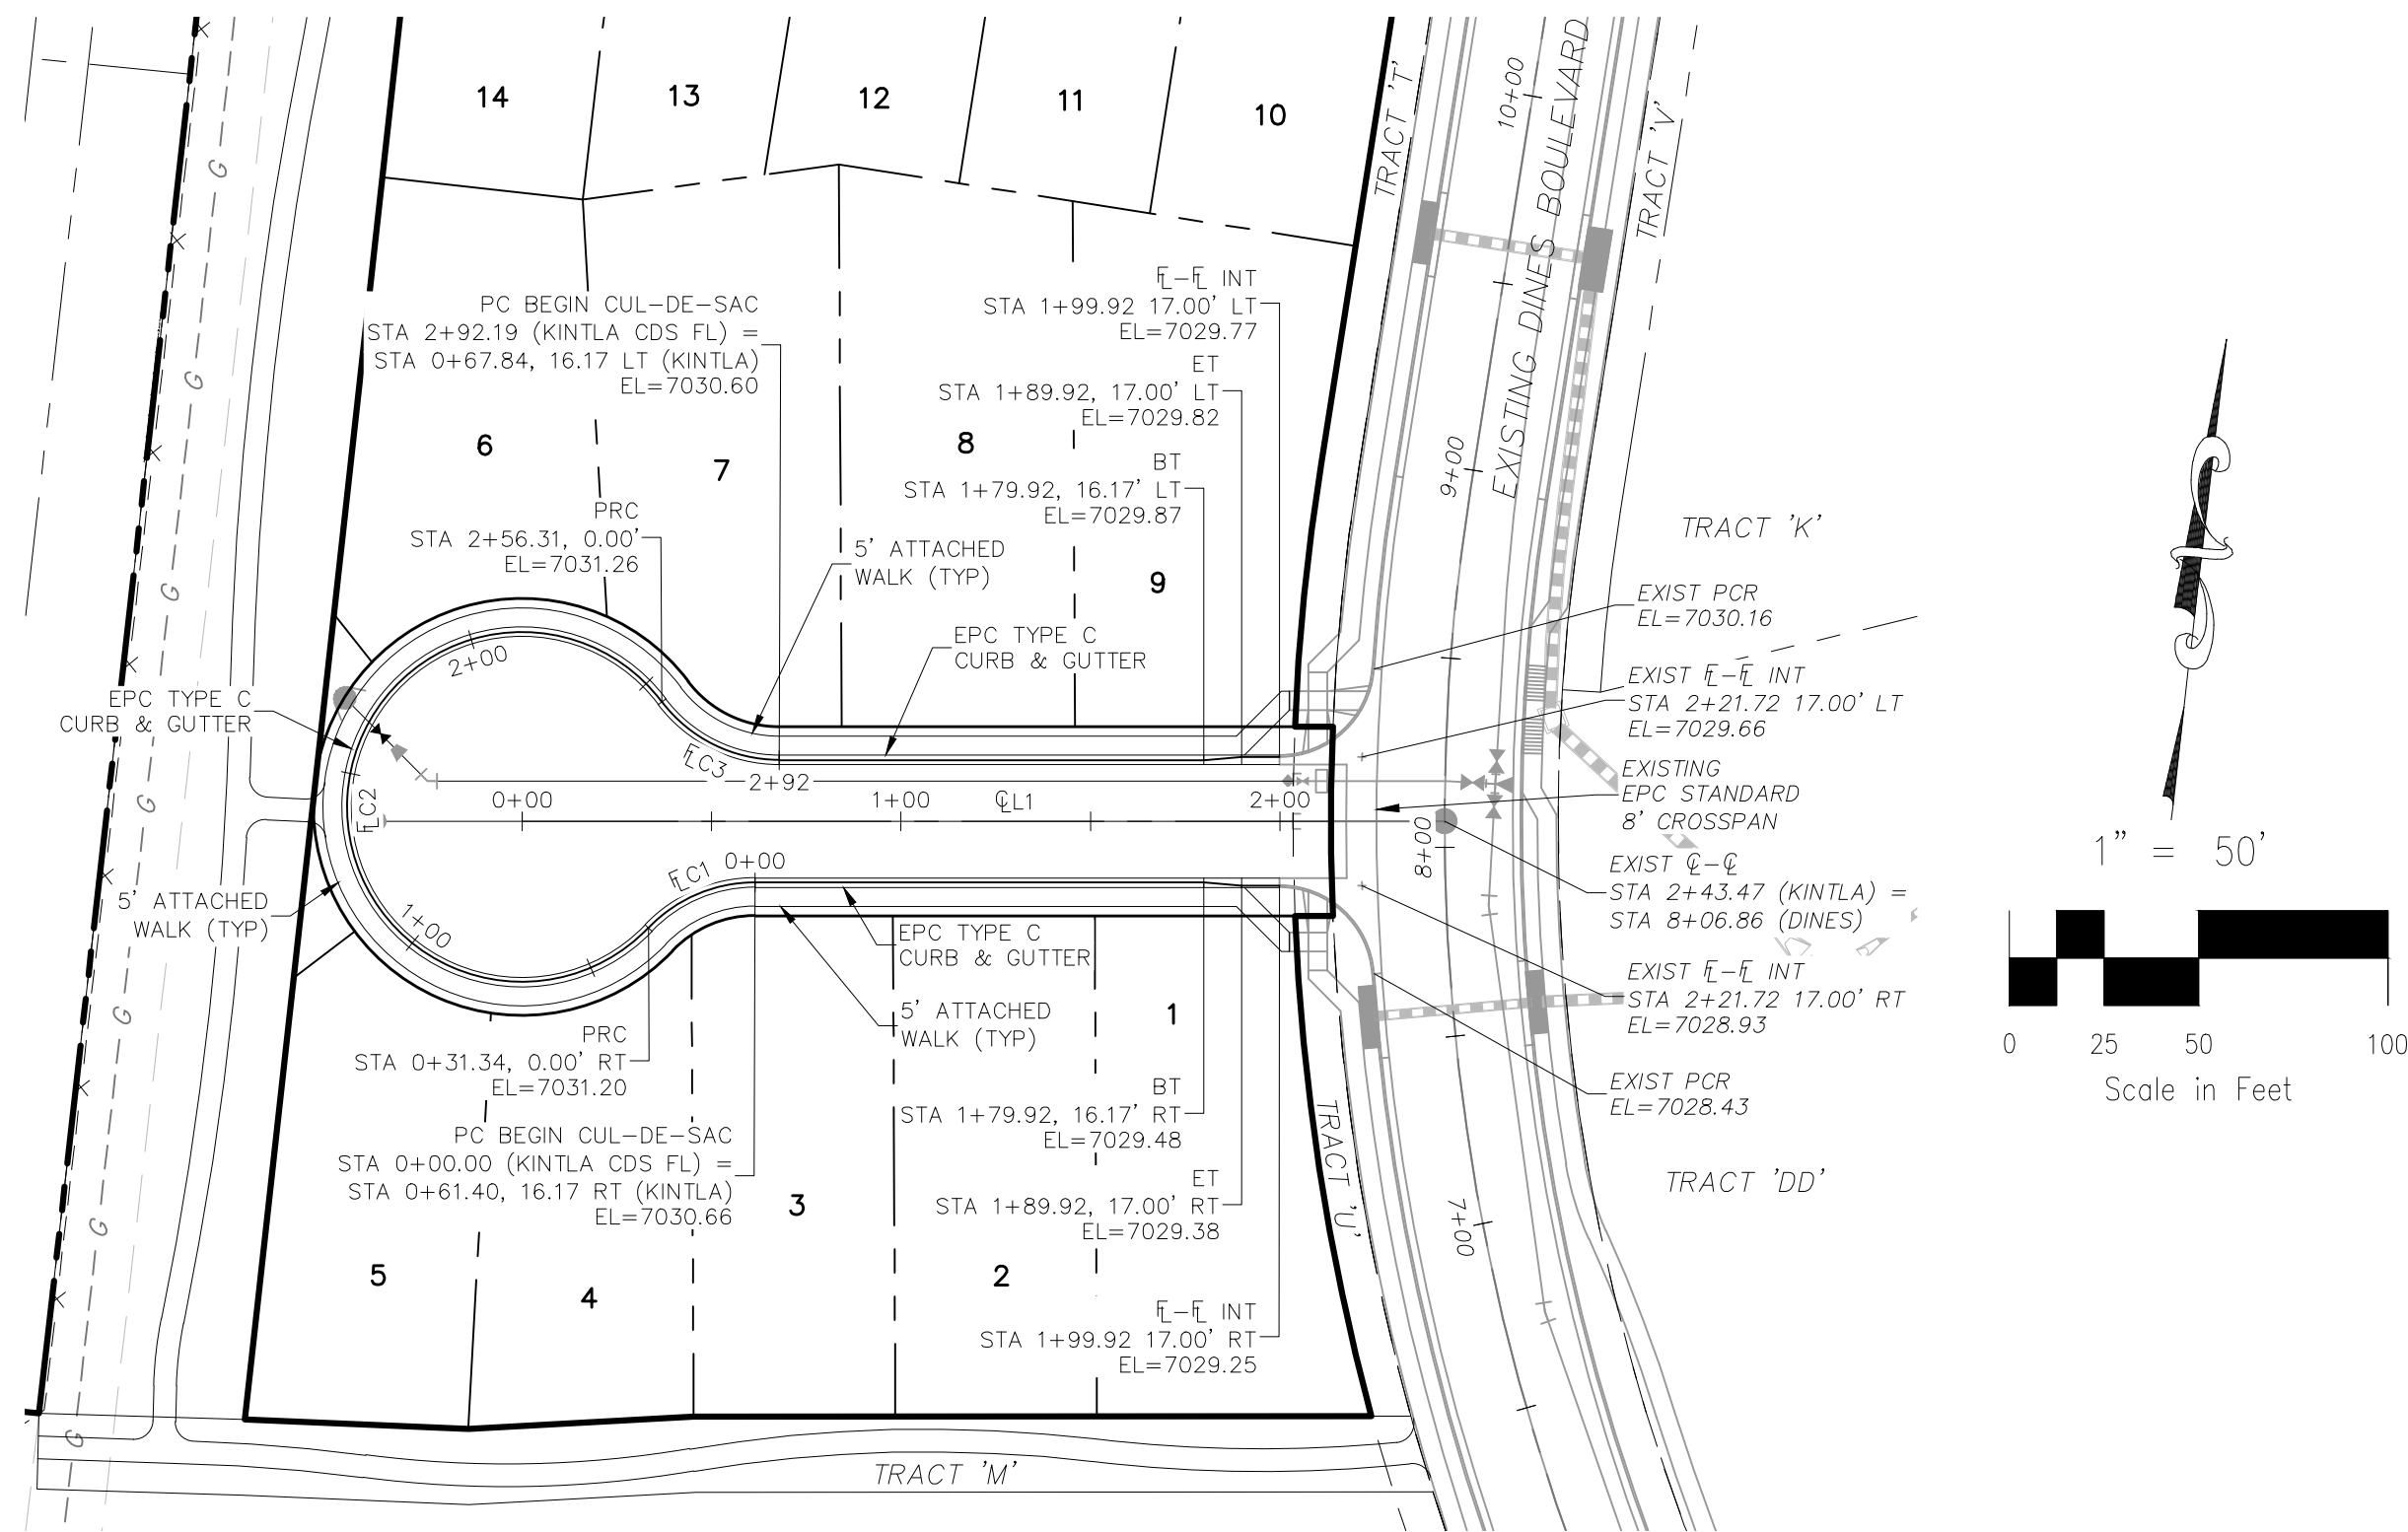

KINTLA COURT
STA 0+00.00 TO STA 1+99.92

- ABBREVIATION LEGEND**
- CL-C CENTERLINE INTERSECTION
 - FL-F FLOWLINE INTERSECTION
 - BT BEGIN TRANSITION
 - ET END TRANSITION
 - PC POINT OF CURVE
 - PCC POINT OF COMPOUND CURVE
 - PCR POINT OF CURB RETURN
 - PRC POINT OF REVERSE CURVE
 - PT POINT OF TANGENT
 - EL ELEVATION
 - LT LEFT
 - RT RIGHT
- STREET ABBREVIATIONS**
- KC KINTLA COURT
 - LGW LODGE GRASS WAY
 - MW MOSBY WAY
 - SW SPRAGUE WAY
 - WW WHITEFISH WAY
 - DB DINES BOULEVARD (EX.)
 - CDS CUL-DE-SAC

20 BOULDER CRESCENT, SUITE 110
 COLORADO SPRINGS, CO 80903
 PHONE: 719.955.5485

CIVIL CONSULTANTS, INC.


FOR AND ON BEHALF OF
 M&S CIVIL CONSULTANTS, INC.

REVISIONS:

NO.	DATE	BY	DESCRIPTION	APPROVED BY	DATE



THE ENGINEER PREPARING THESE PLANS WILL NOT BE RESPONSIBLE OR LIABLE FOR UNAUTHORIZED CHANGES TO OR USES OF THESE PLANS. ALL CHANGES TO THE PLANS MUST BE IN WRITING AND MUST BE APPROVED BY THE PREPARER OF THESE PLANS.

CAUTION

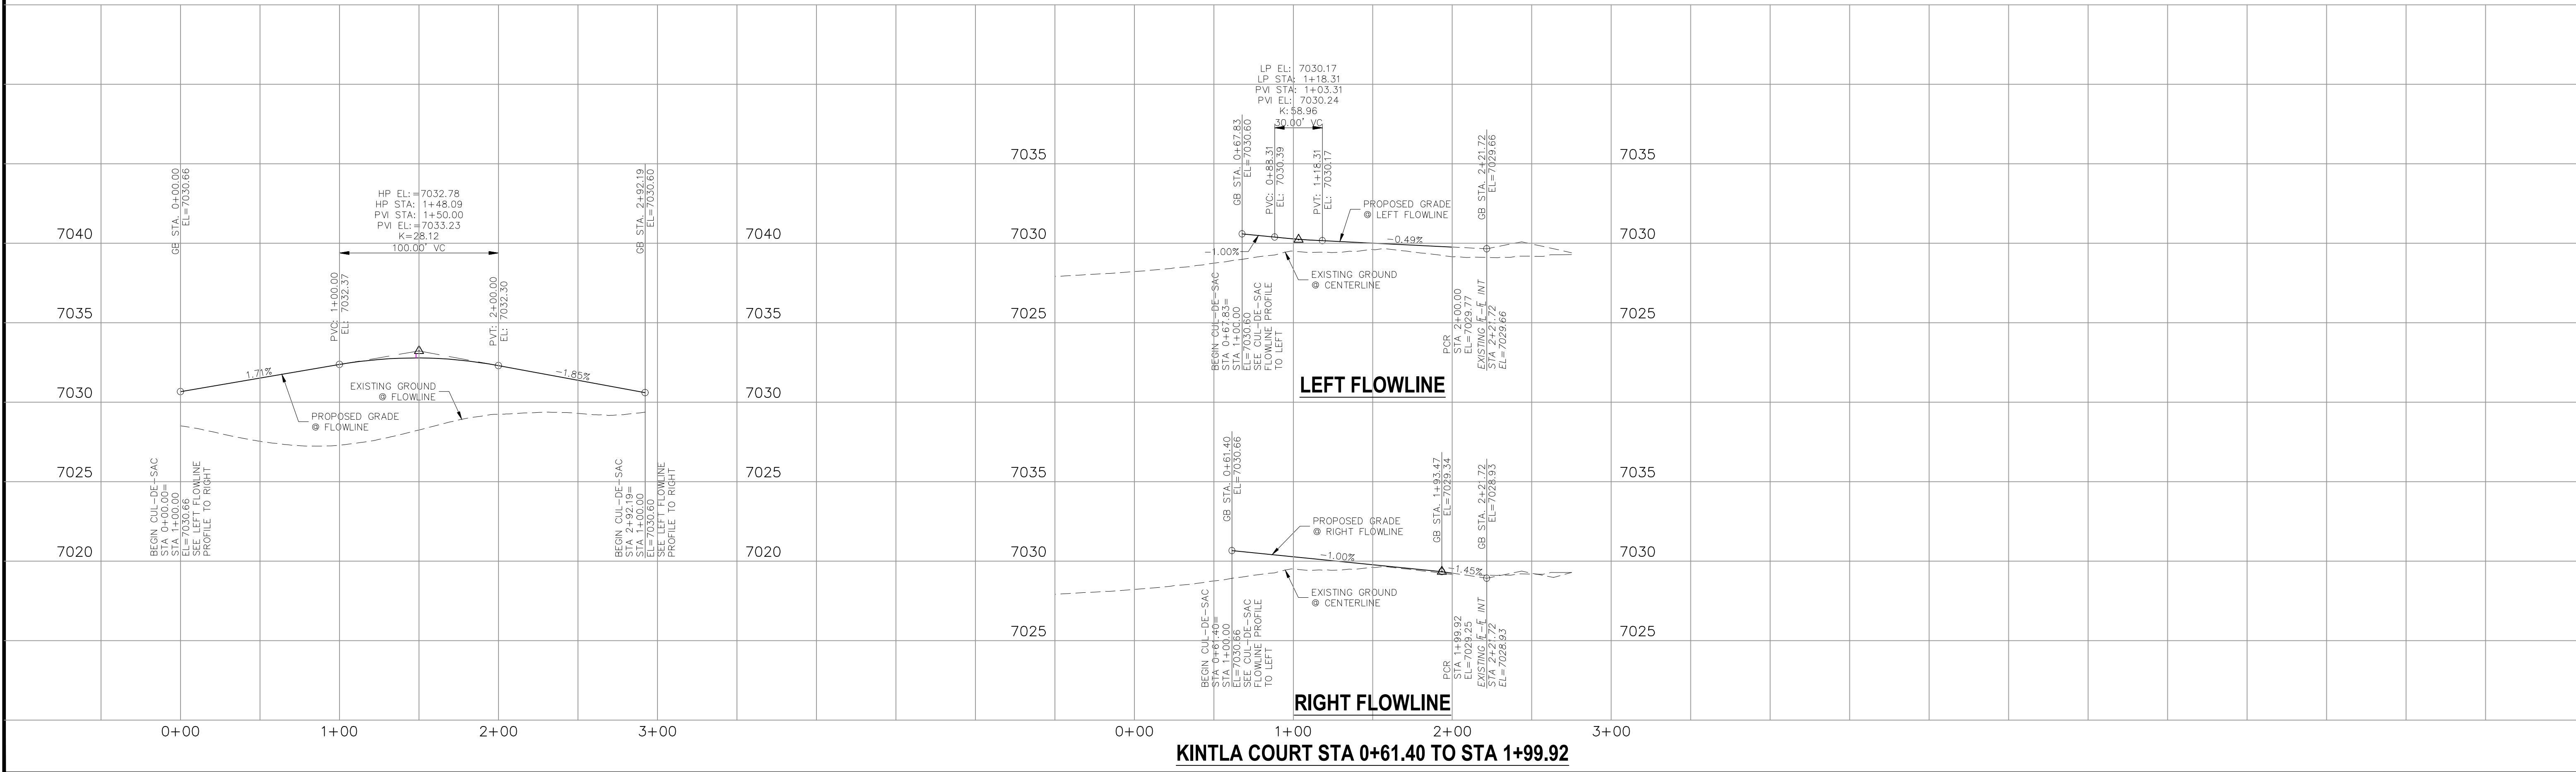



File: 0:\08006A\Sterling Ranch No 3\Map\Const Draw\Street Plans\Residential\S107.dwg Plotstamp: 11/7/2017 10:41 AM

File: 0:\00006A\Sterling Ranch No 3\Map\Const Dwg\Street Plans\Residential\S008.dwg Plotstamp: 11/4/2017 5:32 PM

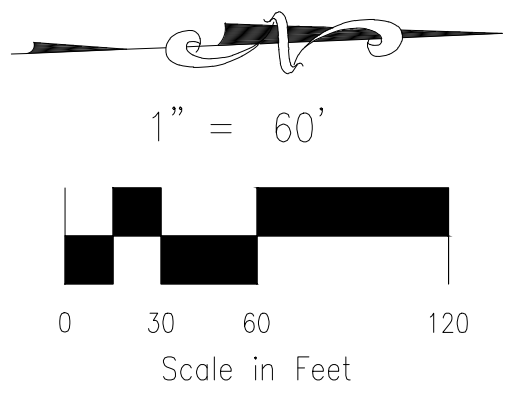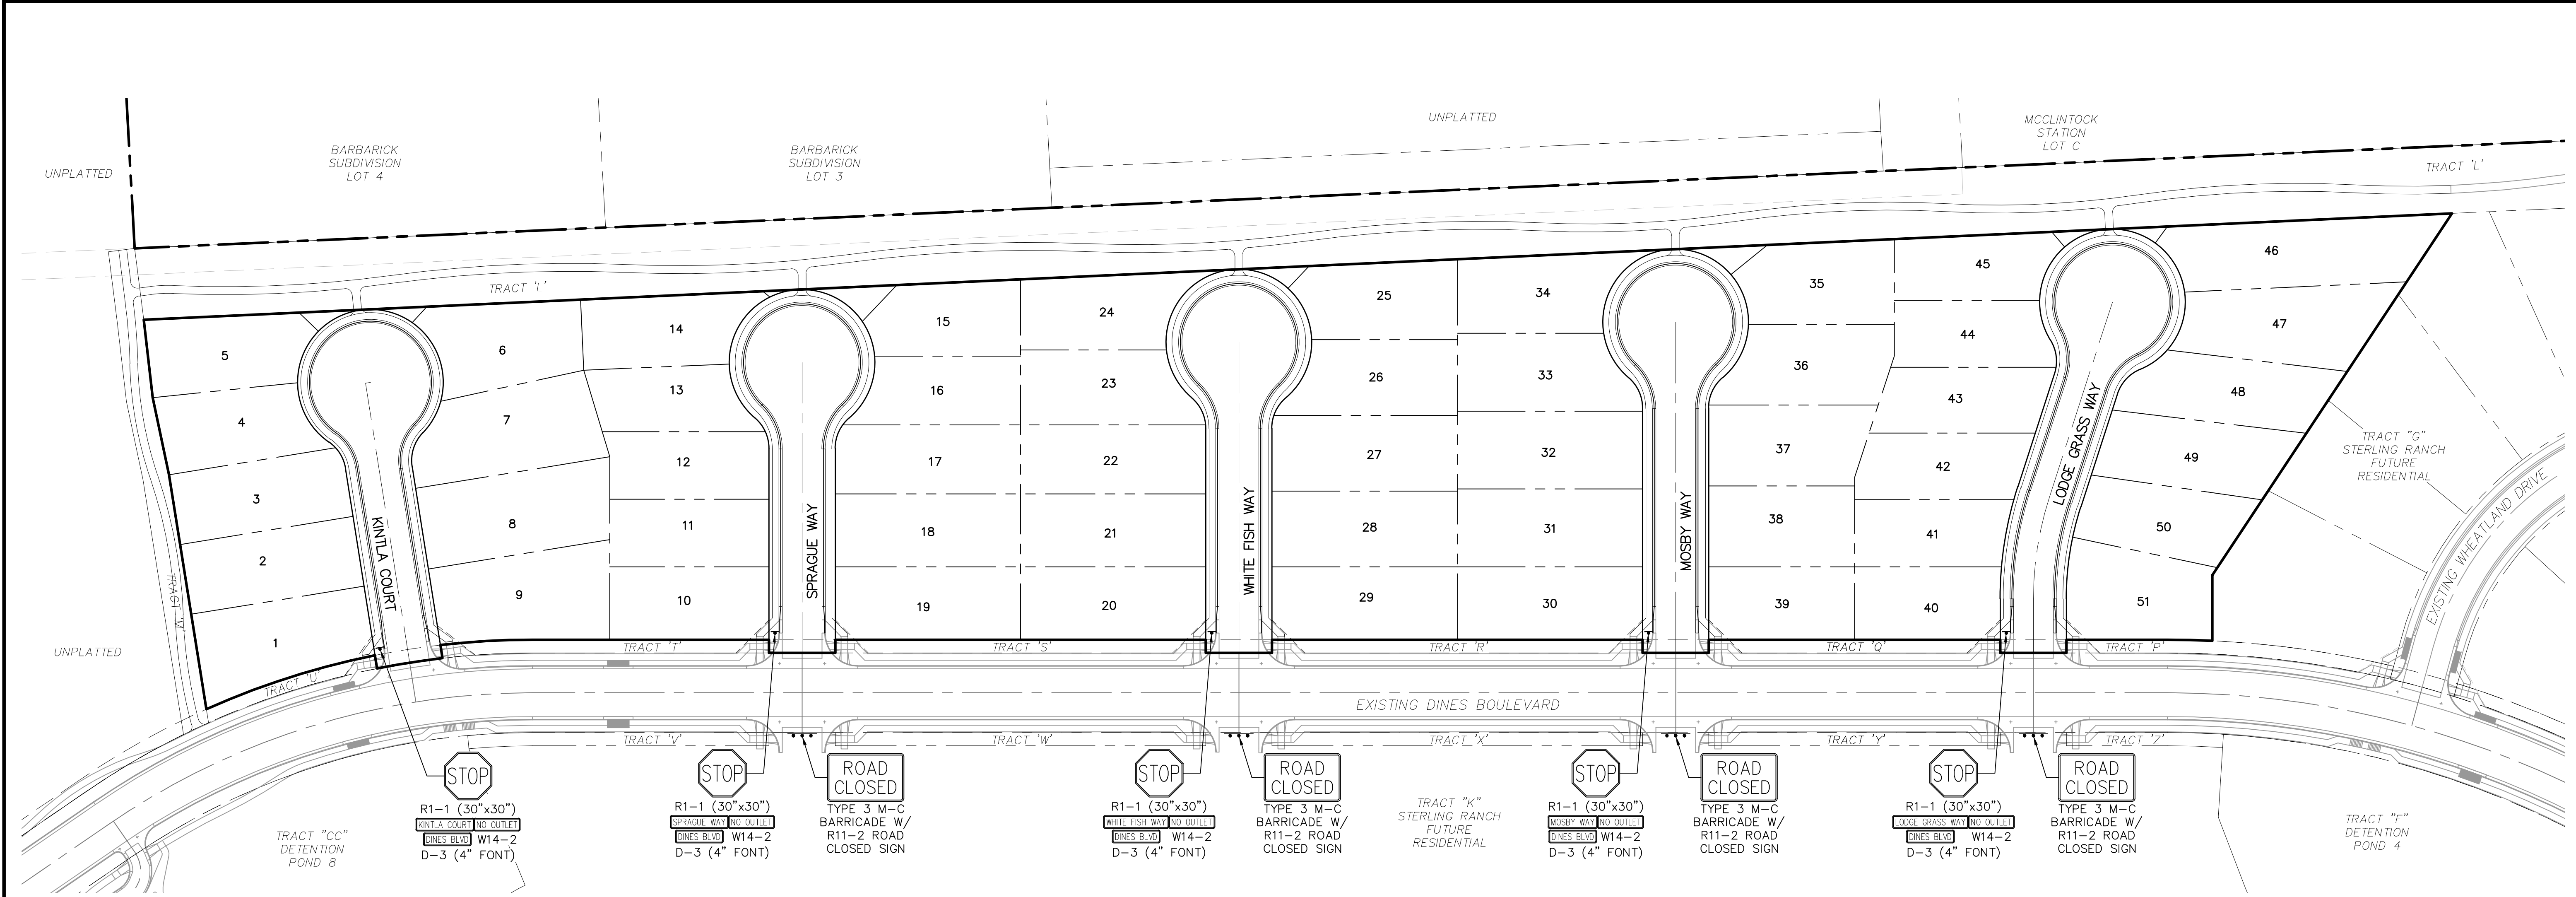


FOR LOCATING & MARKING GAS, ELECTRIC, WATER & TELEPHONE LINES
 FOR BURIED UTILITY INFORMATION
 48 HRS BEFORE YOU DIG
 CALL 1-800-922-1987

BRANDING IRON AT STERLING RANCH FILING NO. 1 SIGNAGE & STRIPING PLAN		PROJECT NO. 09-006 DATE: 11/10/2017
DESIGNED BY: VAS DRAWN BY: ELY CHECKED BY: GW	SCALE: HORIZONTAL: 1"=60' VERTICAL: N/A	SHEET 8 OF 8 S108
20 BOULDER CRESCENT, SUITE 110 COLORADO SPRINGS, CO 80903 PHONE: 719.555.5485		
FOR AND ON BEHALF OF M&S CIVIL CONSULTANTS, INC.		
VIRGIL A. SANCHEZ, COLORADO P.E. NO. 377160		
REVISIONS: NO. DATE BY DESCRIPTION	APPROVED BY: _____ DATE: _____	THE ENGINEER PREPARING THESE PLANS WILL NOT BE RESPONSIBLE OR LIABLE FOR UNAUTHORIZED CHANGES TO OR USES OF THESE PLANS. ALL CHANGES TO THE PLANS MUST BE IN WRITING AND MUST BE APPROVED BY THE PREPARER OF THESE PLANS.
CAUTION		

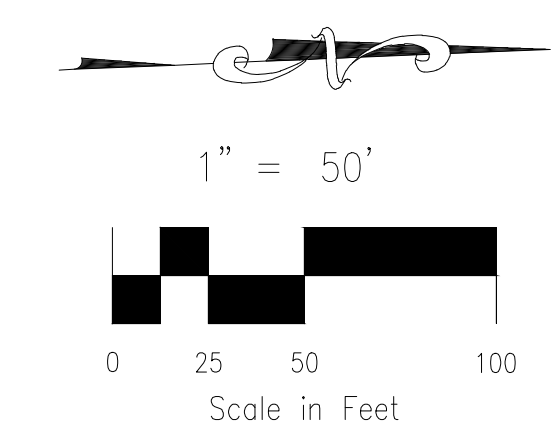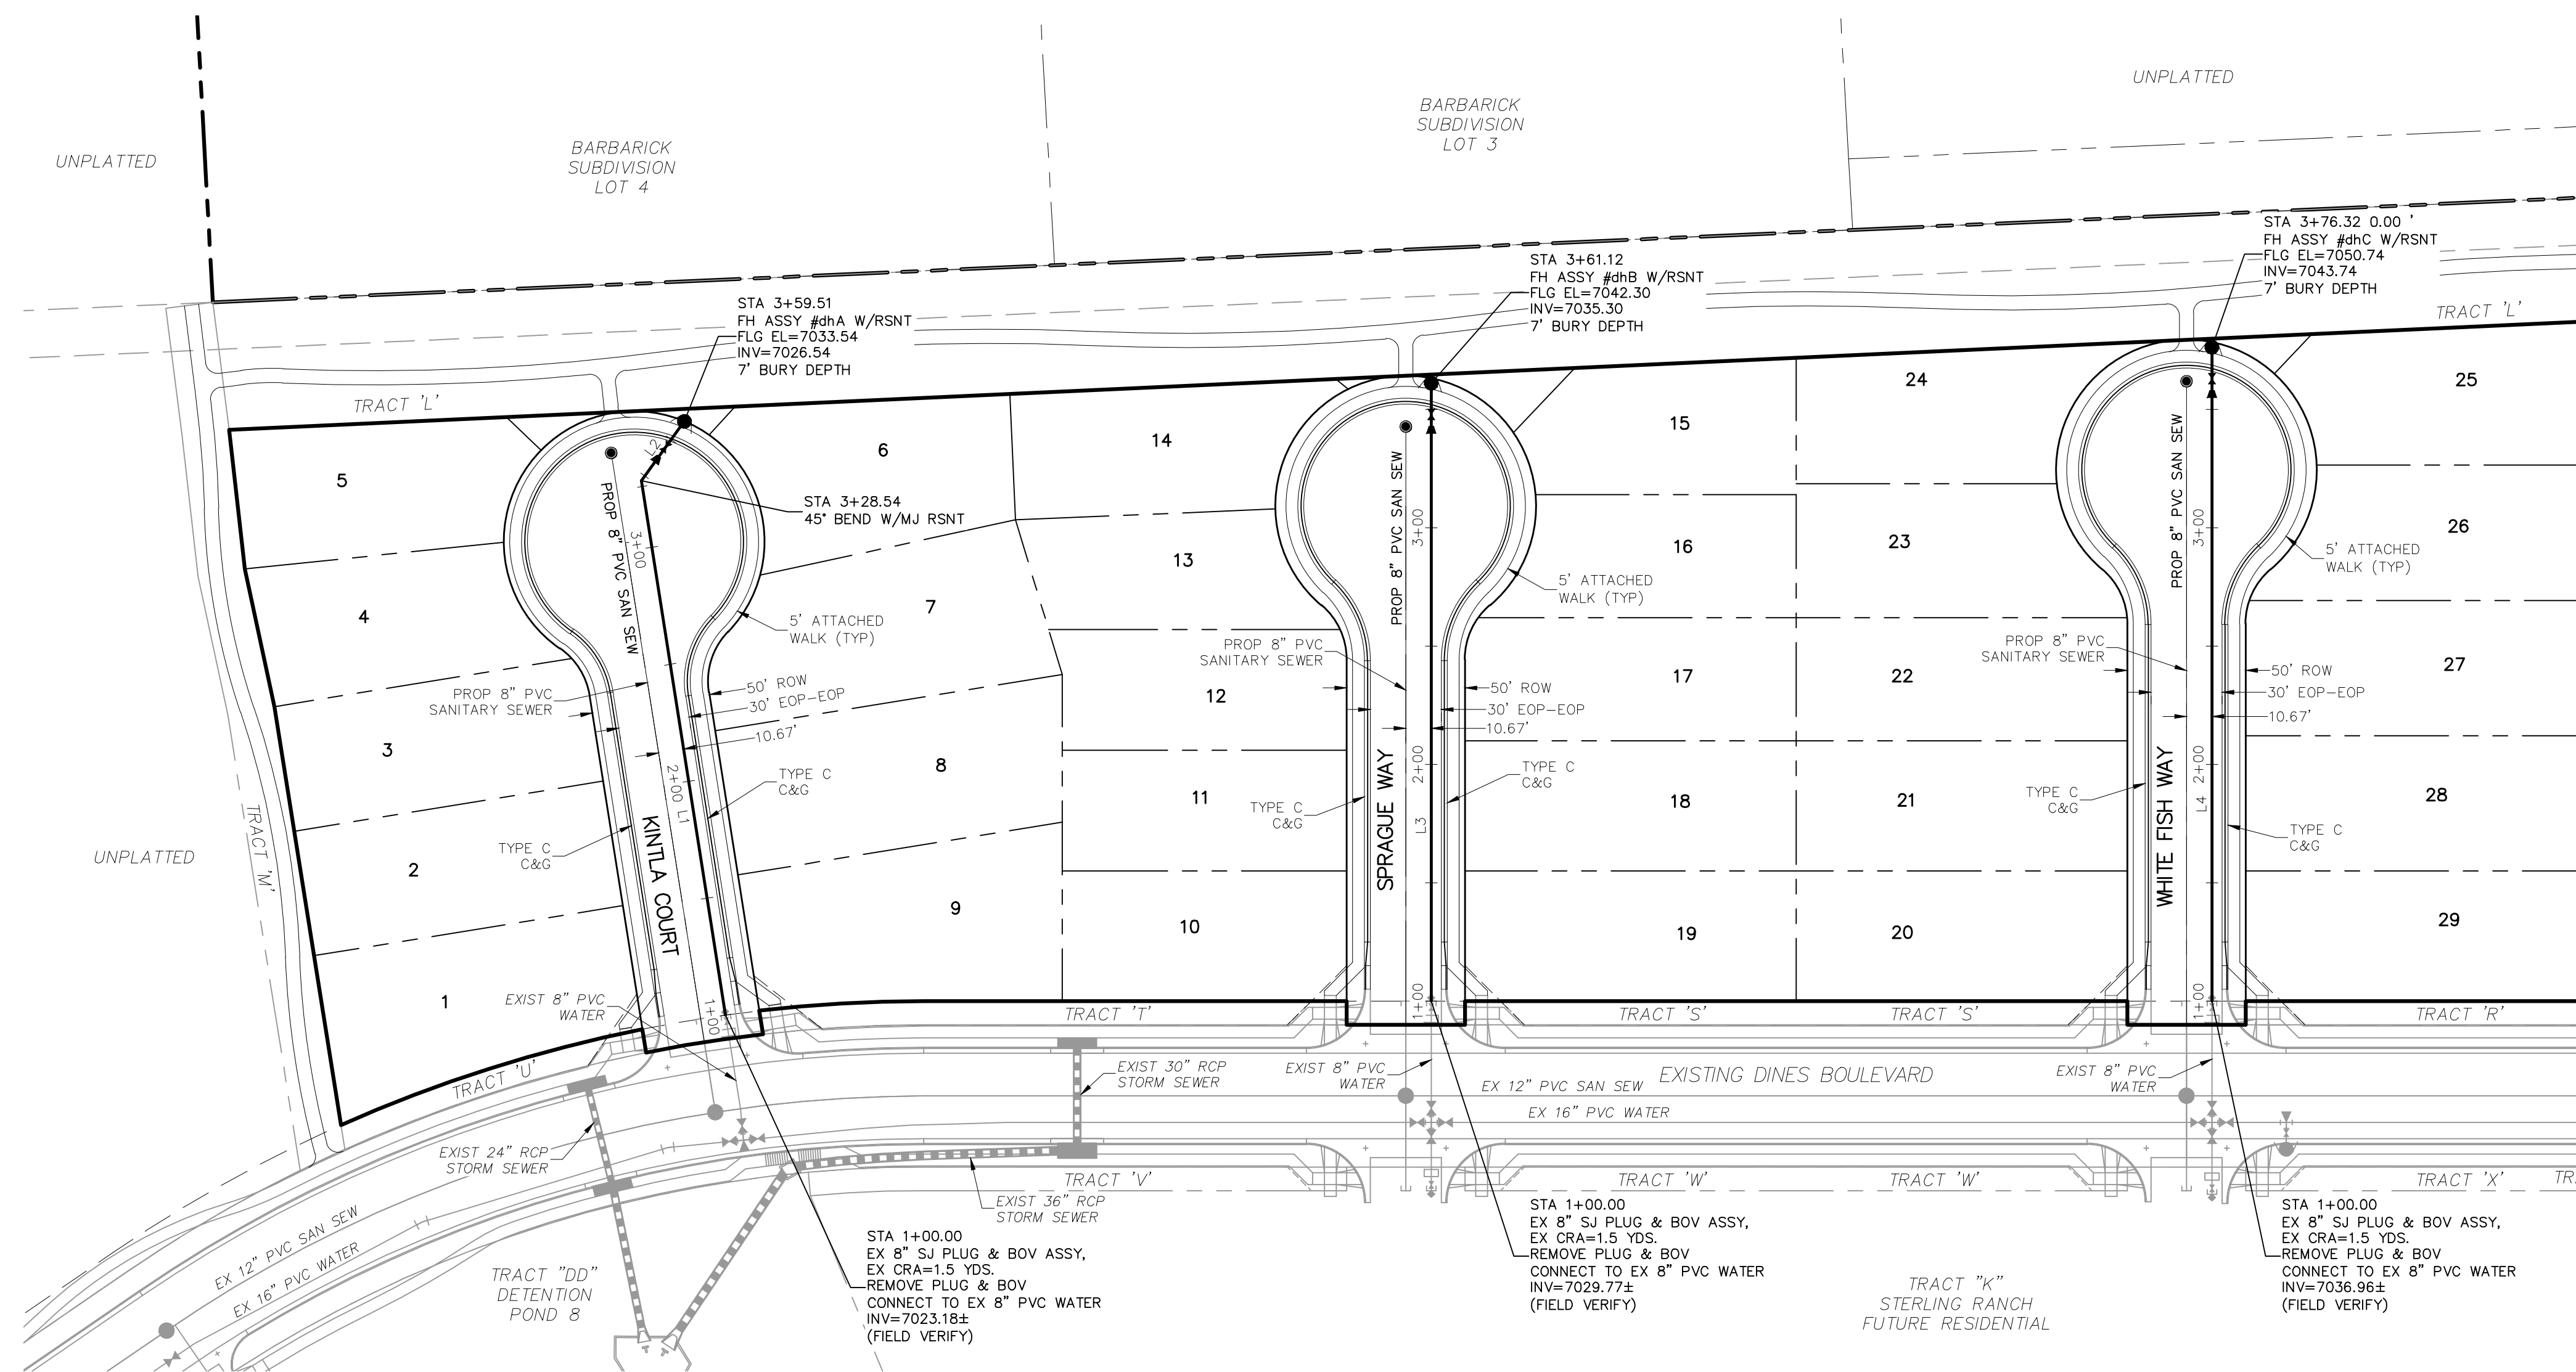

LINE	LENGTH	DIRECTION
L1	228.54'	S83° 26' 41"W
L2	30.97'	N51° 33' 16"W
L3	261.12'	N87° 35' 34"W
L4	301.32'	N87° 35' 34"W
L5	291.51'	N87° 35' 34"W
L6	68.56'	N87° 35' 34"W
L7	244.19'	N69° 40' 03"W

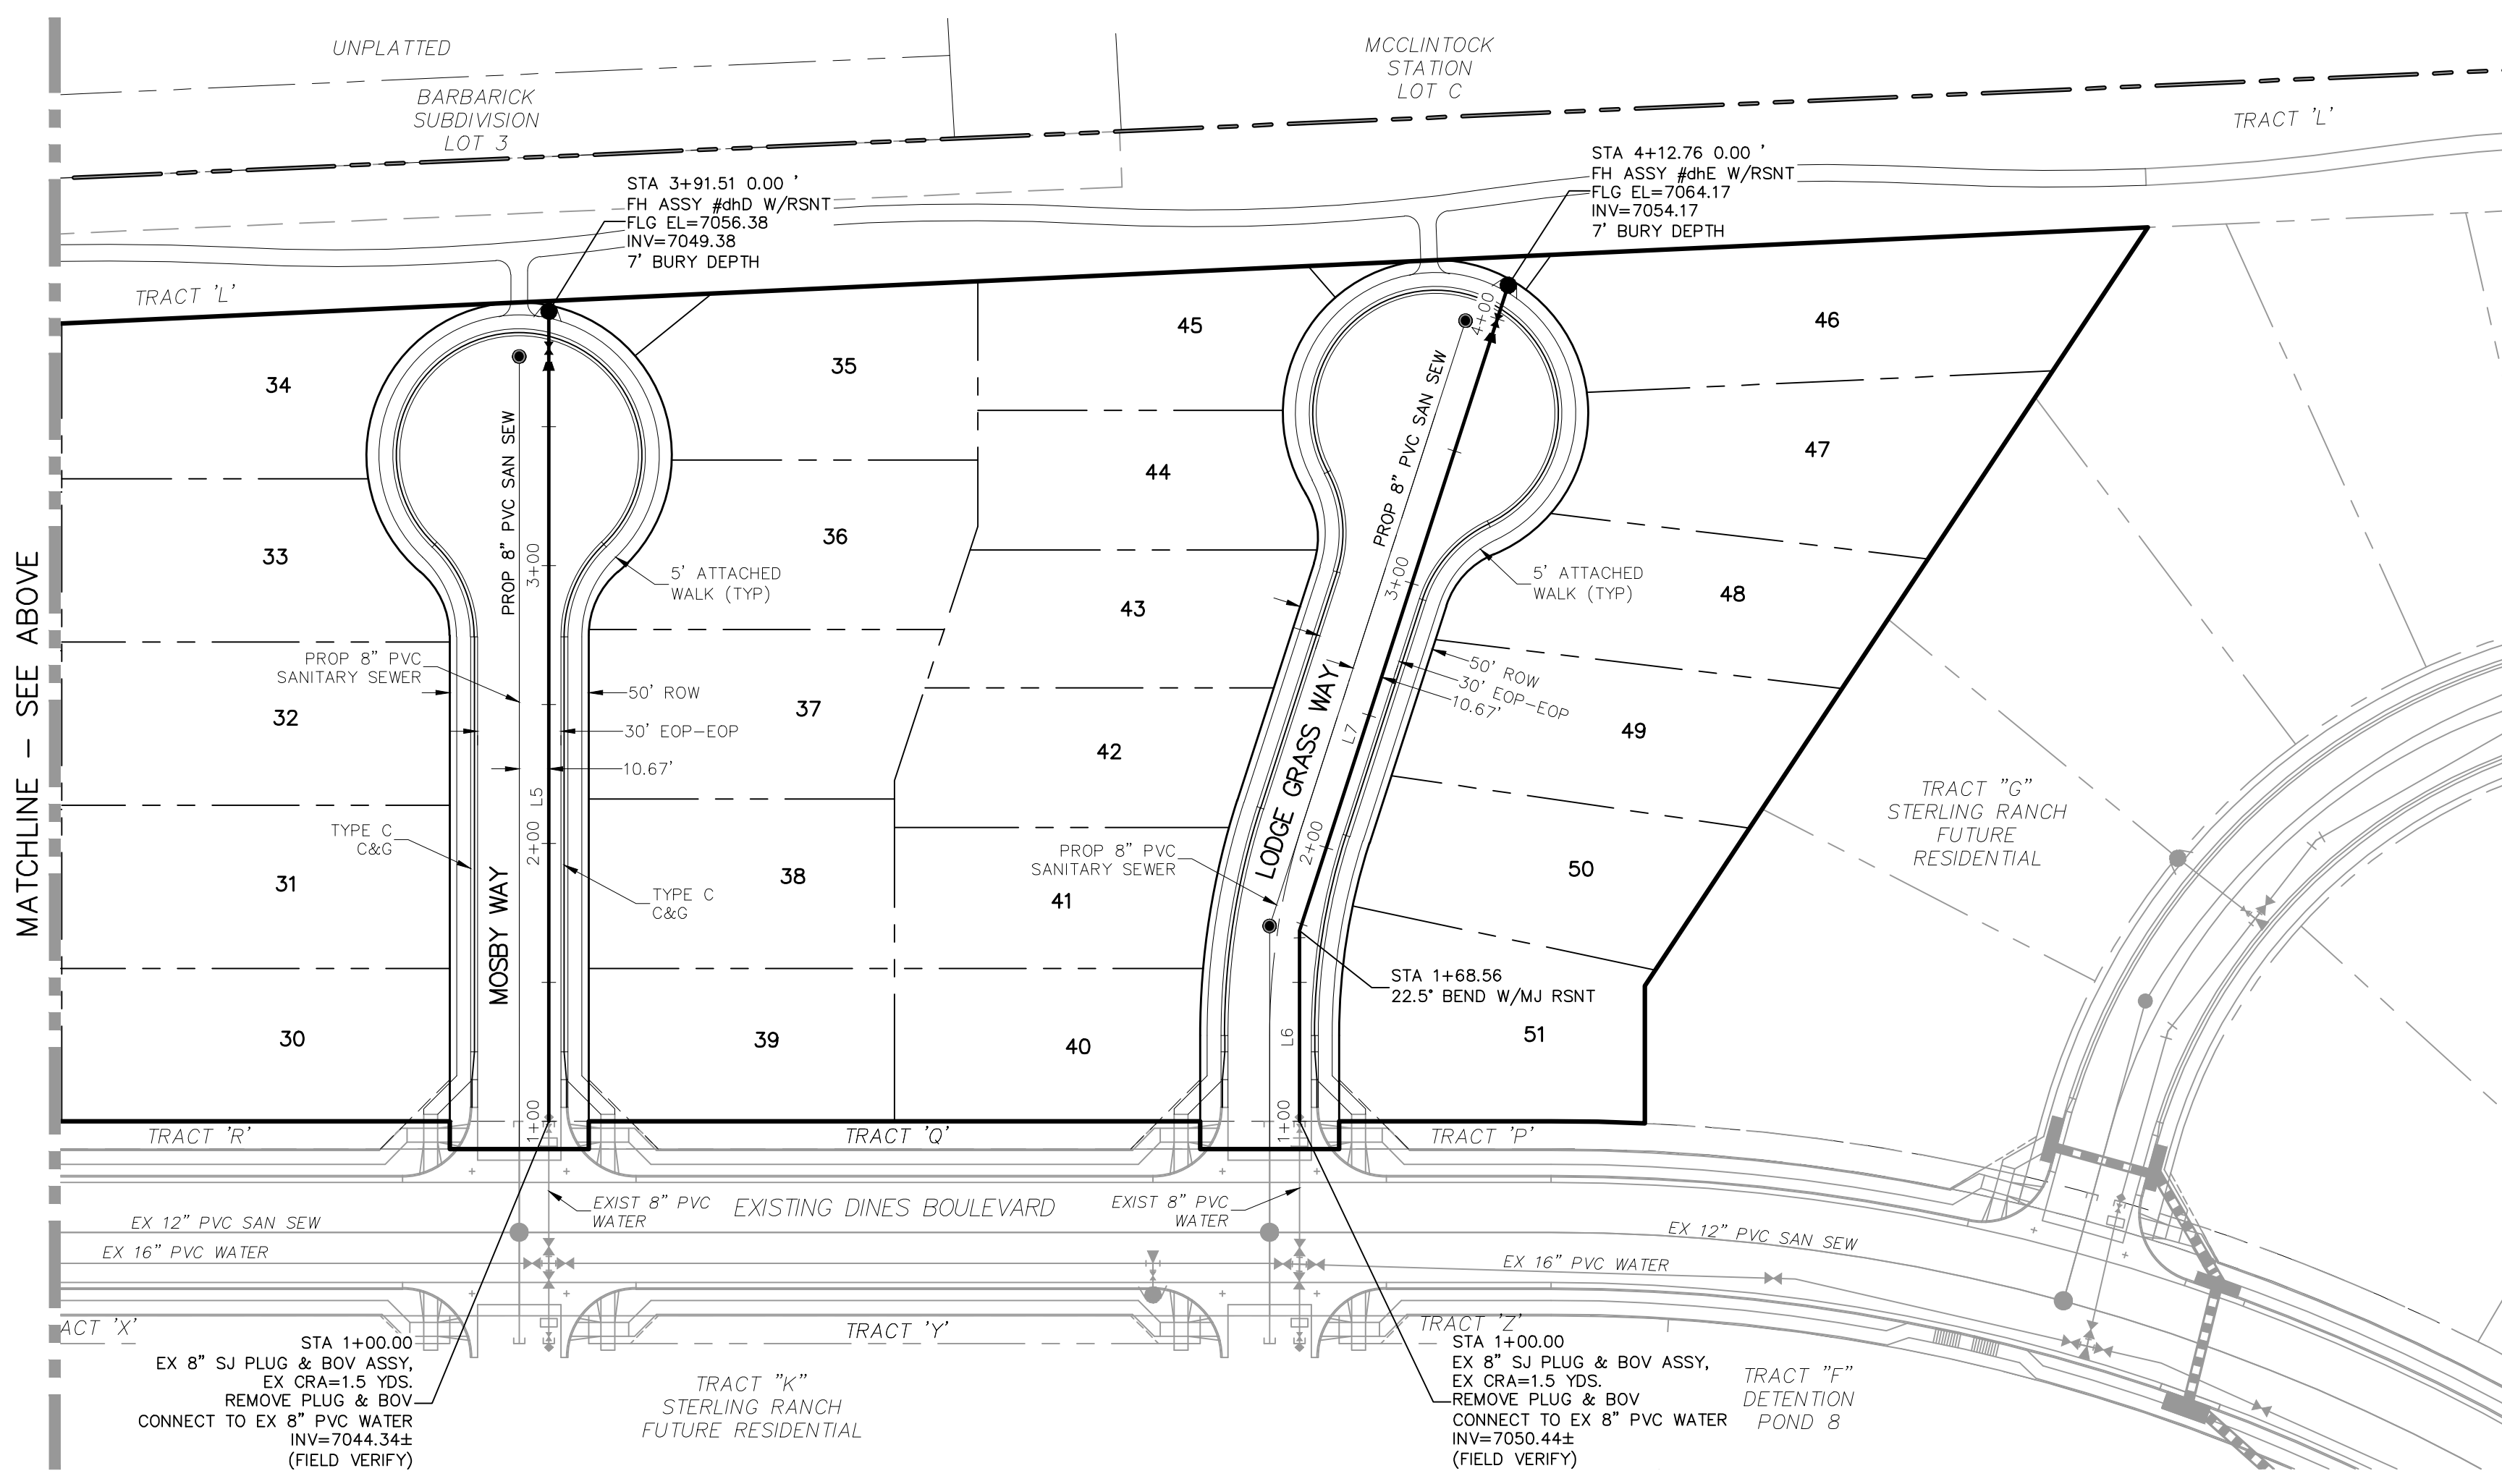

BRANDING IRON AT STERLING RANCH FILING NO. 1	
WATER PLANS	
PROJECT NO. 09-006	DATE: 11/10/2017
DESIGNED BY: VAS	SCALE: HORIZONTAL: 1"=50'
DRAWN BY: ELY	VERTICAL: 1"=5'
CHECKED BY: GW	SHEET 2 OF 3
WT02	

20 BOULDER CRESCENT, SUITE 110
 COLORADO SPRINGS, CO 80903
 PHONE: 719.955.5485

M&S CIVIL CONSULTANTS, INC.



FOR AND ON BEHALF OF M&S CIVIL CONSULTANTS, INC.

REVISIONS:

NO.	DATE	BY	DESCRIPTION


THE ENGINEER PREPARING THESE PLANS WILL NOT BE RESPONSIBLE OR LIABLE FOR UNAUTHORIZED CHANGES TO OR USES OF THESE PLANS. ALL CHANGES TO THE PLANS MUST BE IN WRITING AND MUST BE APPROVED BY THE PREPARER OF THESE PLANS.

CAUTION

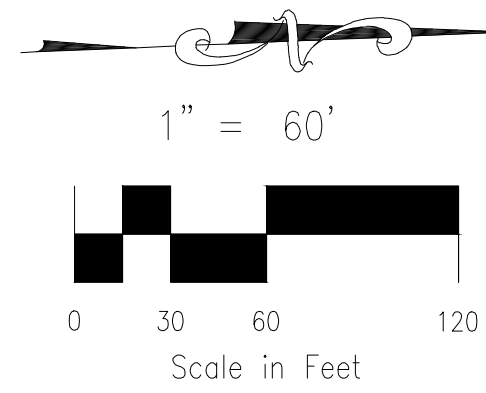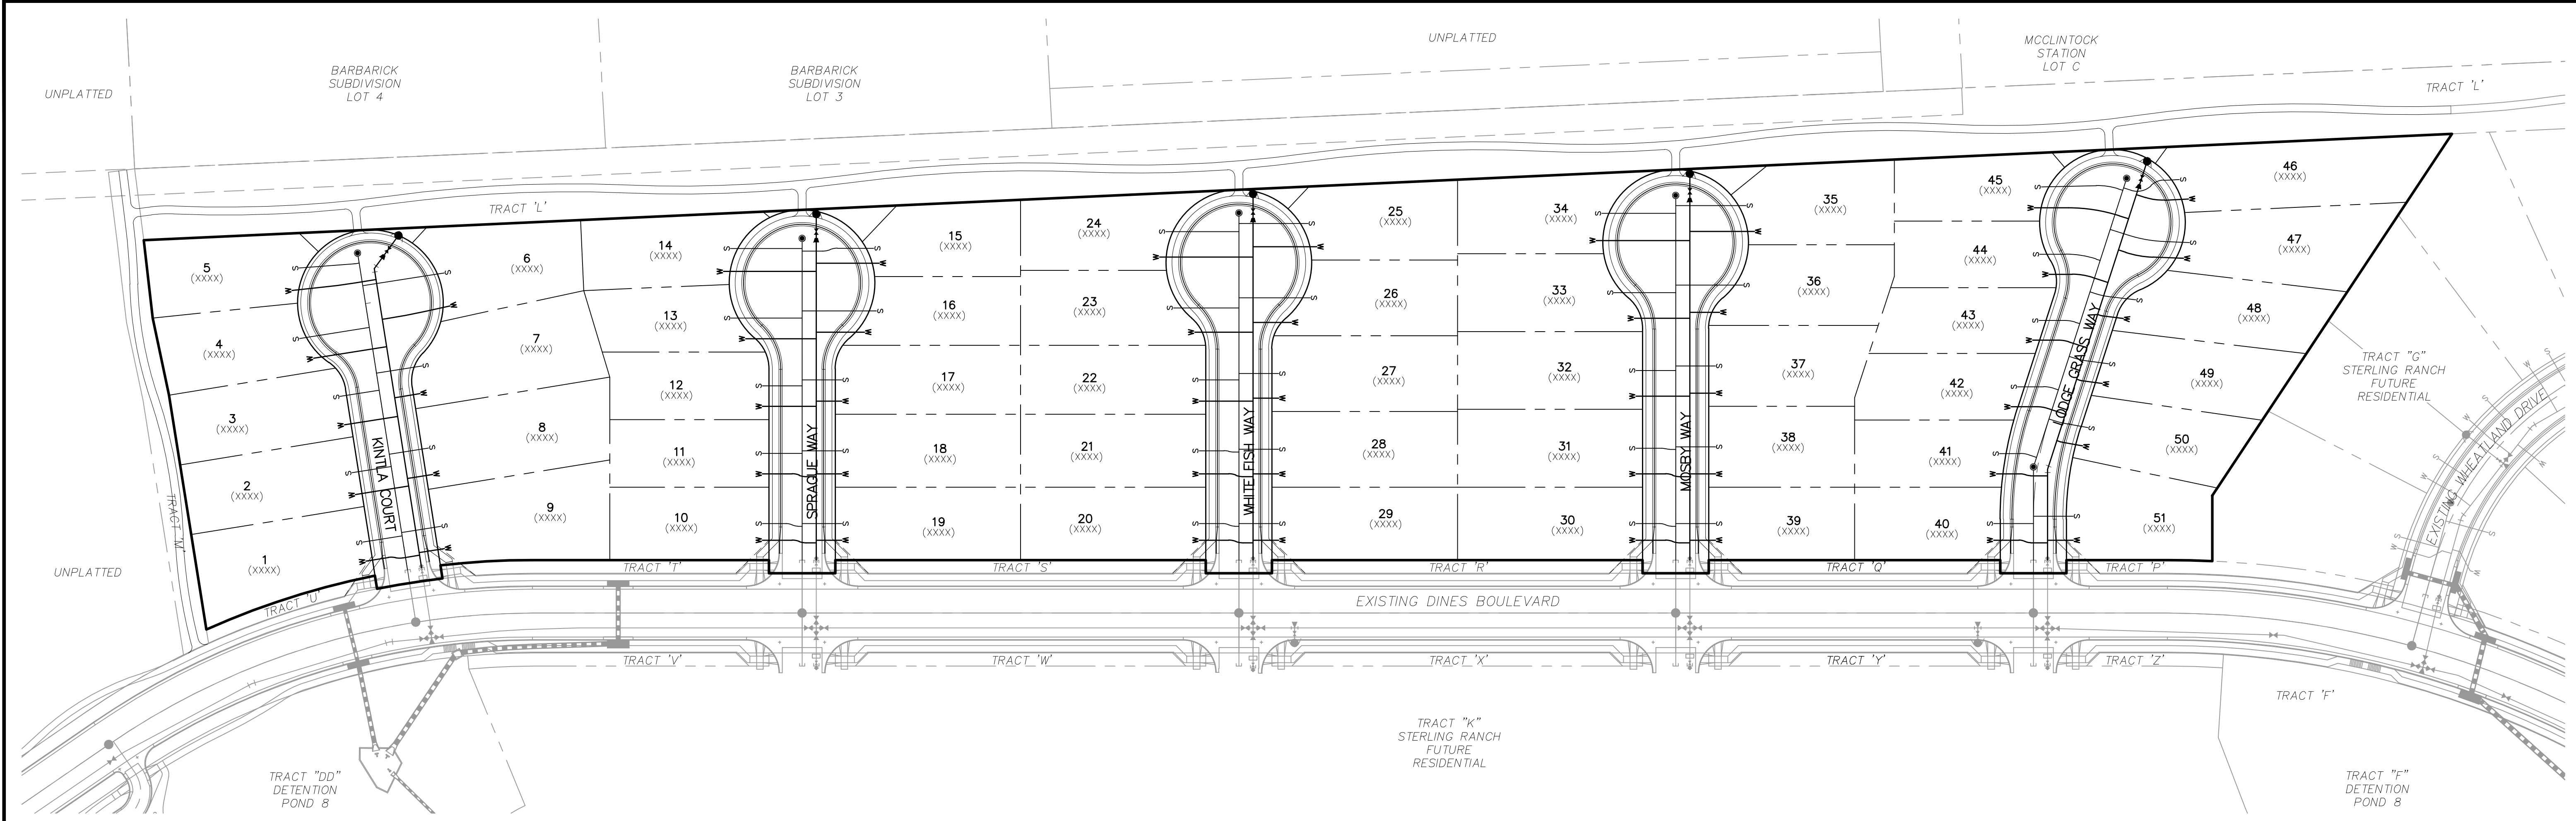

GENERAL NOTES:

1. THE CONTRACTOR IS RESPONSIBLE FOR ANY DAMAGE TO ANY UTILITY FACILITIES AS A RESULT OF HIS ACTIONS. THE CONTRACTOR SHALL MAKE ALL THE REQUIRED REPAIRS IMMEDIATELY TO THE SATISFACTION OF THE STERLING RANCH WATER DISTRICT.

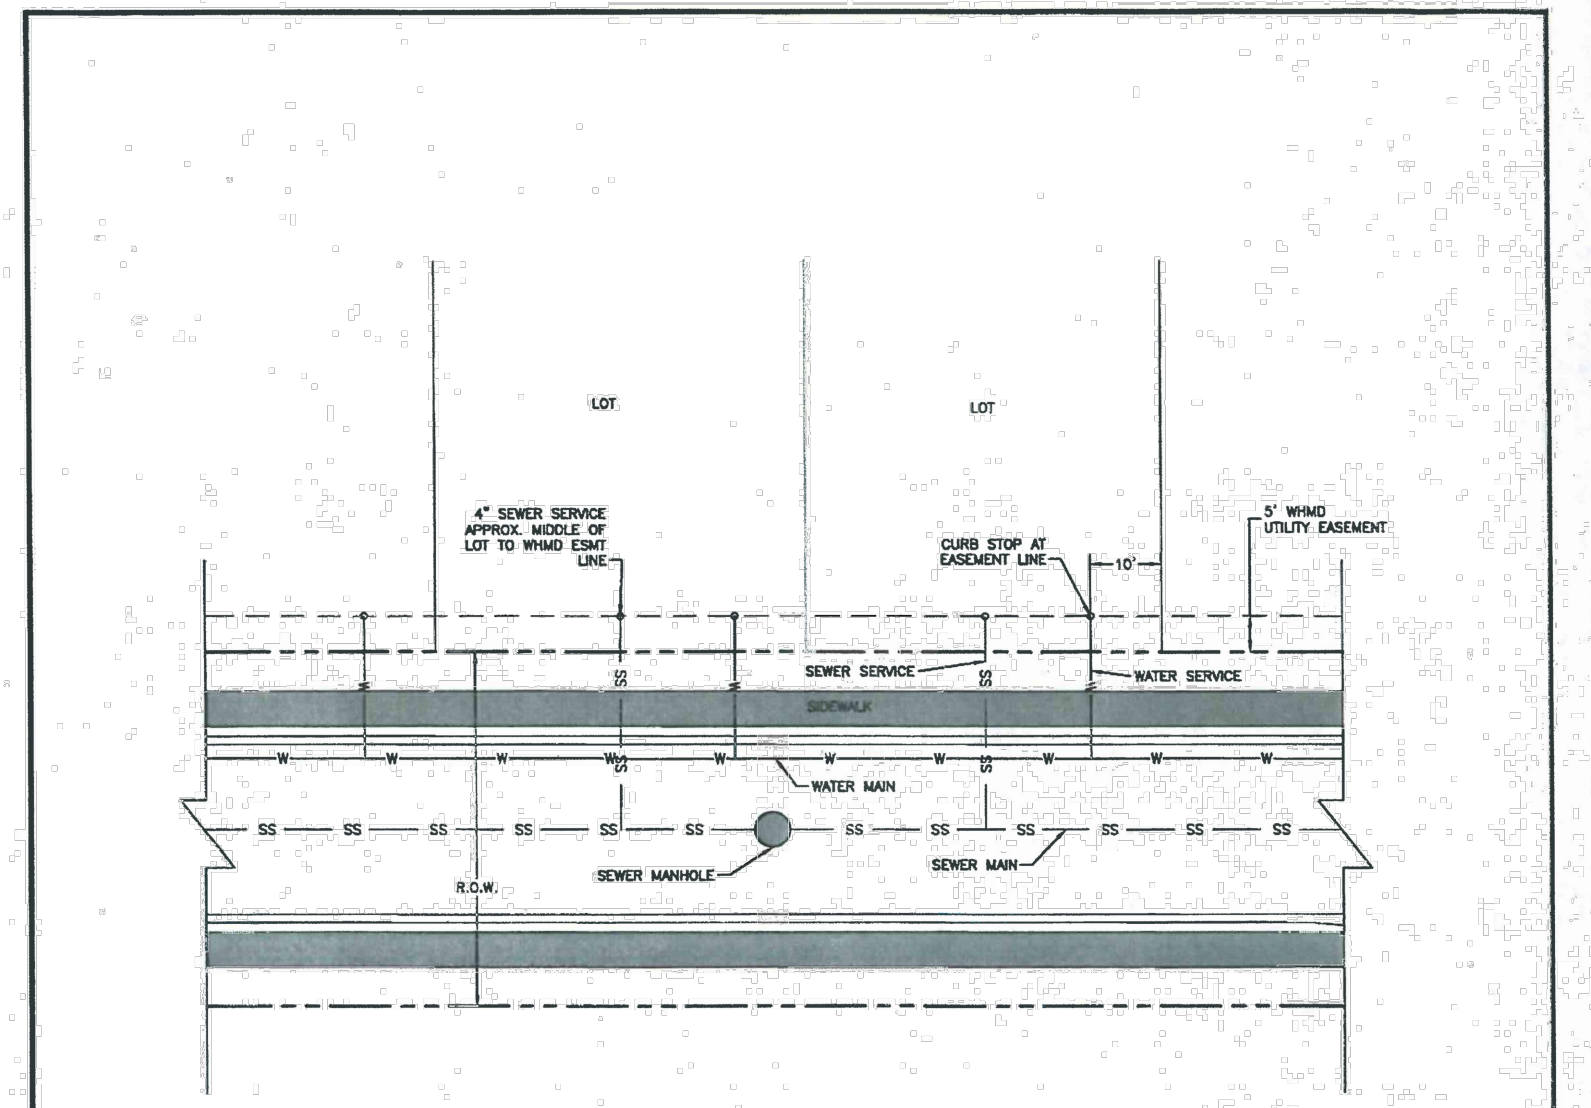

- NOTES:**
1. WATER SERVICE TO BE 10' FROM "DOWNSTREAM" PROPERTY LINE AND EXTENDED TO WHMD UTILITY EASEMENT LINE.
 2. SEWER SERVICE TO BE PLACED APPROXIMATELY IN THE MIDDLE OF THE LOT AND EXTENDED TO WHMD UTILITY EASEMENT LINE.
 3. SERVICES SHALL BE MARKED WITH 2"x4" POST AT TERMINATION POINT FOR LOCATION DURING CONNECTION TO RESIDENCE. POSTS SHALL BE SPRAY-PAINTED BLUE FOR WATER AND GREEN FOR SEWER.

UTILITY SERVICE LOCATIONS

Drawn: GJM	Reviewed:	WOODMEN HILLS	WATER & WASTEWATER SYSTEM	WW-20
Date: JAN 2011	Reviewed:	13200 WOODMEN HILLS BLVD	STANDARD SPECIFICATIONS	
Scale: as s.h.s.	Reviewed:			

FOR LOCATING & MARKING GAS, ELECTRIC, WATER & TELEPHONE LINES

FOR BURIED UTILITY INFORMATION CALL 1-800-922-1987

BRANDING IRON AT STERLING RANCH FILING NO. 1

UTILITY SERVICE PLANS

PROJECT NO. 09-006 DATE: 11/10/2017

SCALE: HORIZONTAL: 1"=60' VERTICAL: N/A

DESIGNED BY: VAS ELV CHECKED BY: ELY GW

SHEET 3 OF 3

UT01

20 BOULDER CRESCENT SUITE 110
 COLORADO SPRINGS, CO 80903
 PHONE: 719.955.5485

CIVIL CONSULTANTS, INC.


FOR AND ON BEHALF OF M&S CIVIL CONSULTANTS, INC.

VIRGIL A. SANCHEZ, COLORADO P.E. NO. 37160


NO.	DATE	BY	DESCRIPTION

THE ENGINEER PREPARING THESE PLANS WILL NOT BE RESPONSIBLE OR LIABLE FOR UNAUTHORIZED CHANGES TO OR USES OF THESE PLANS. ALL CHANGES TO THE PLANS MUST BE IN WRITING AND MUST BE APPROVED BY THE PREPARER OF THESE PLANS.


CAUTION

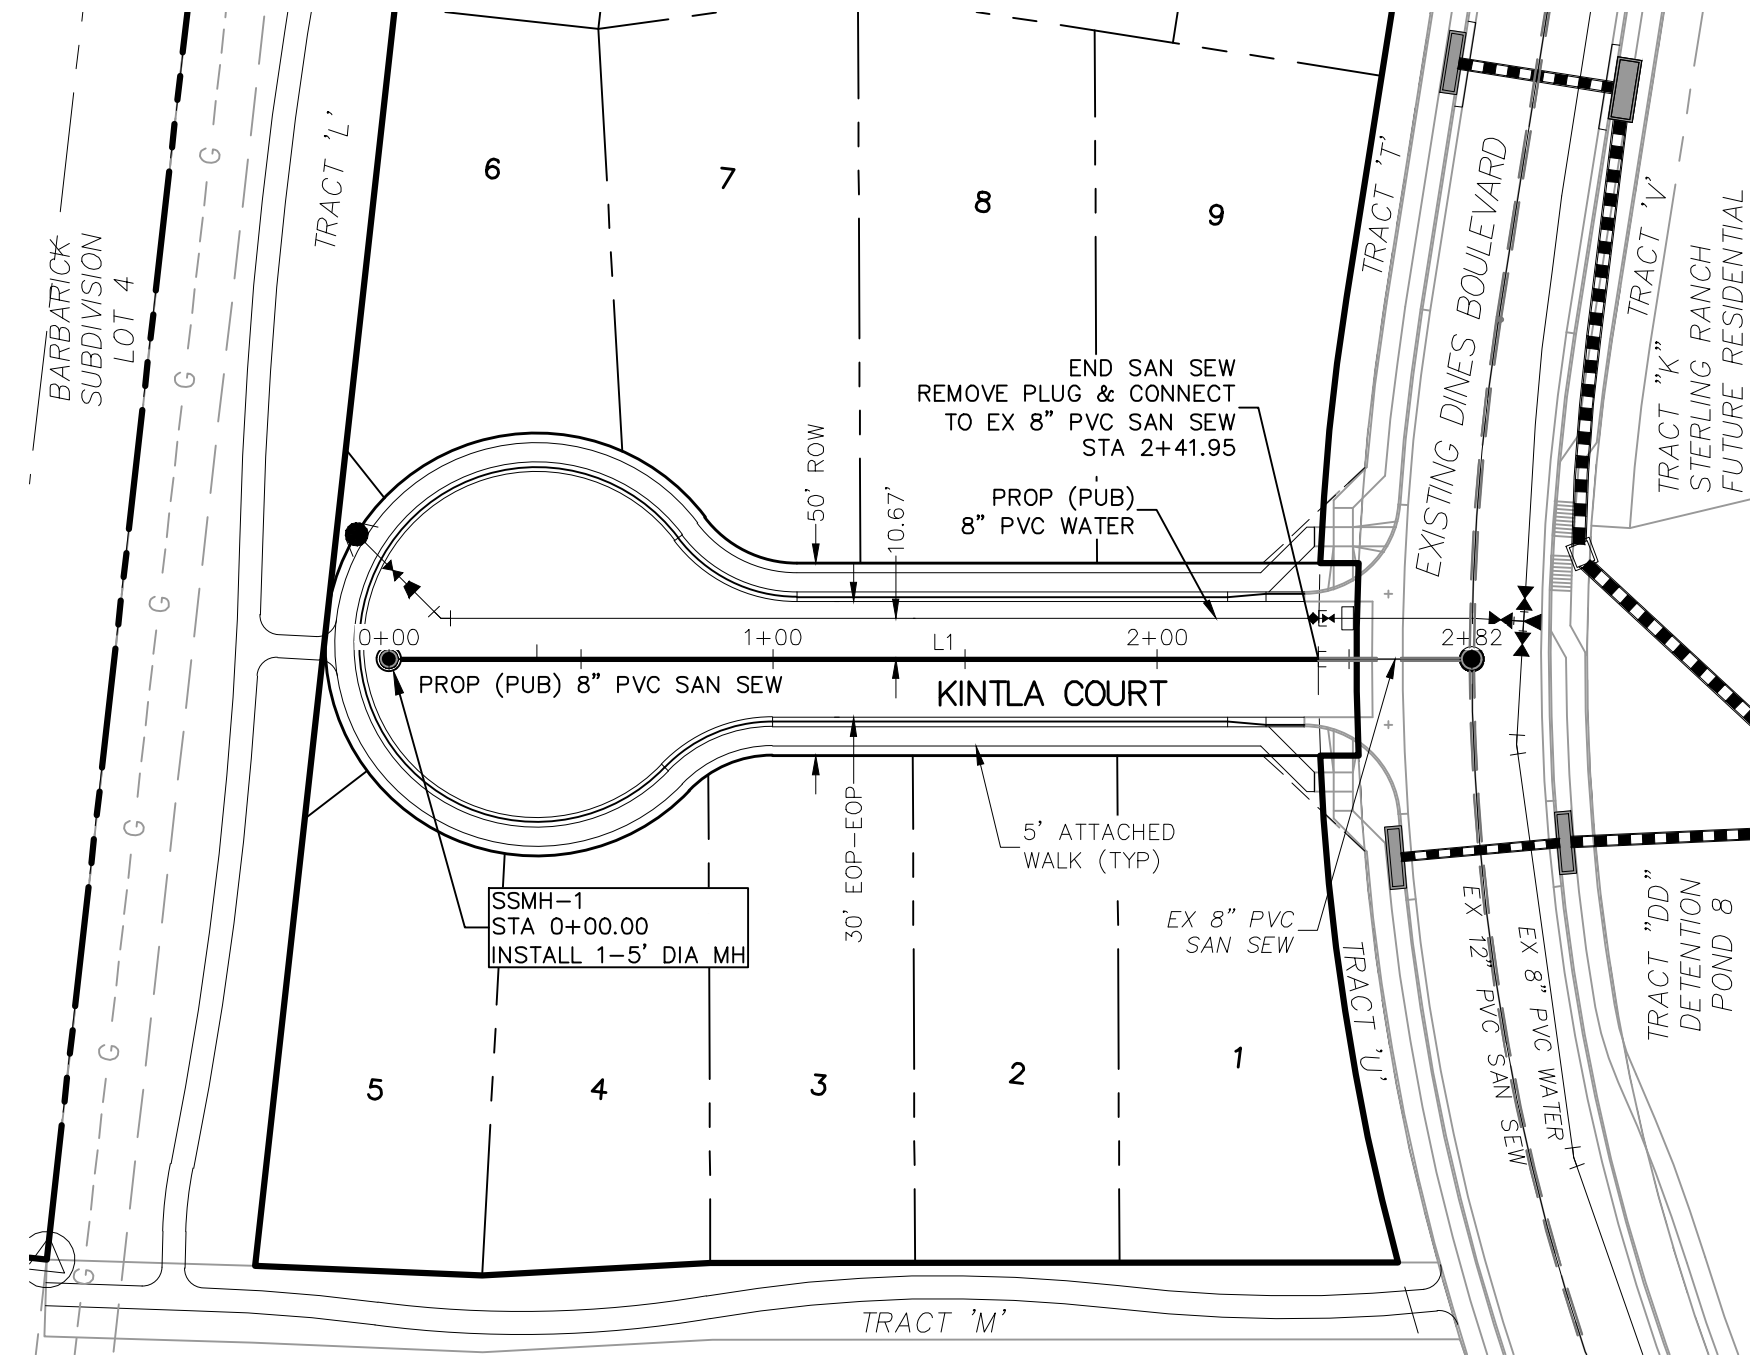

KINTLA COURT
STA 0+00.00 TO STA 2+41.95

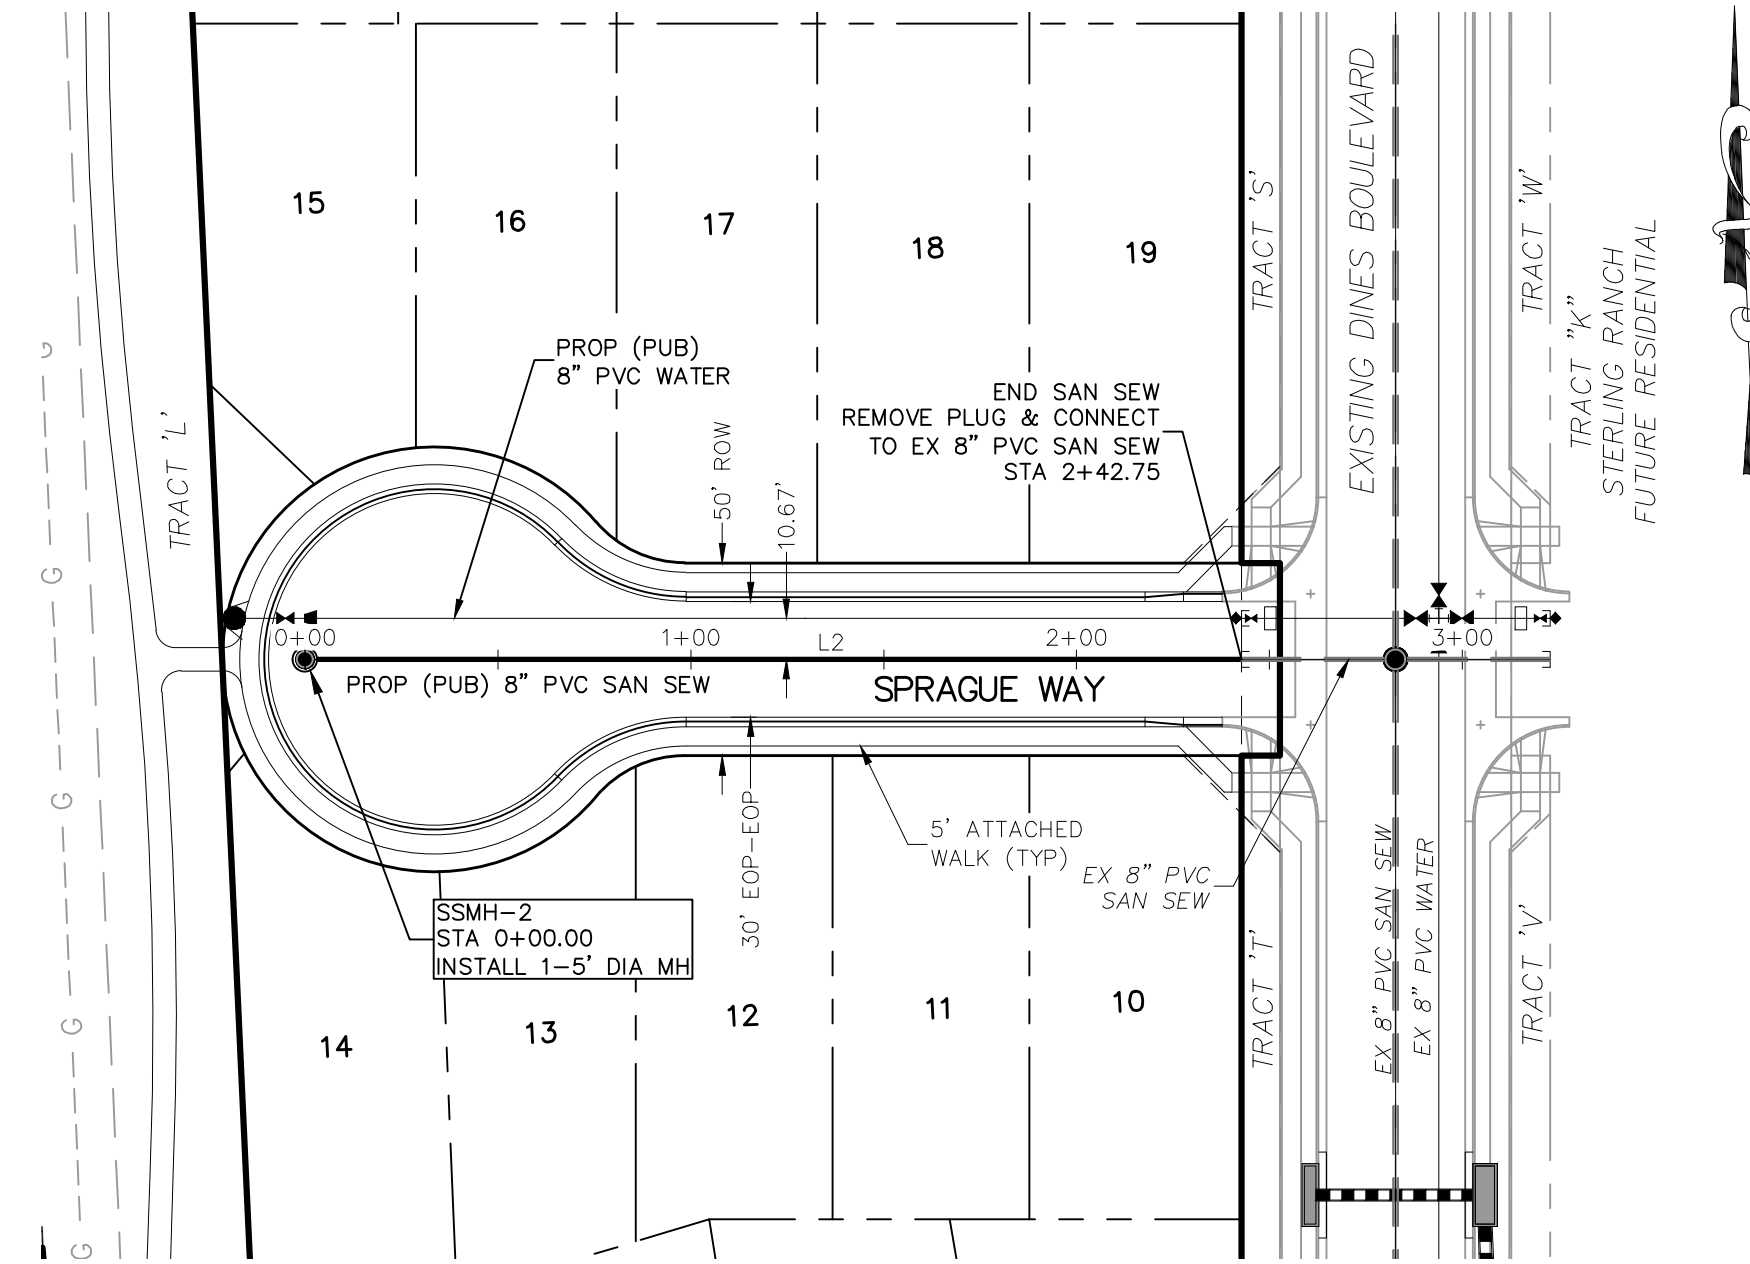


SPRAGUE WAY
STA 0+00.00 TO STA 2+42.75

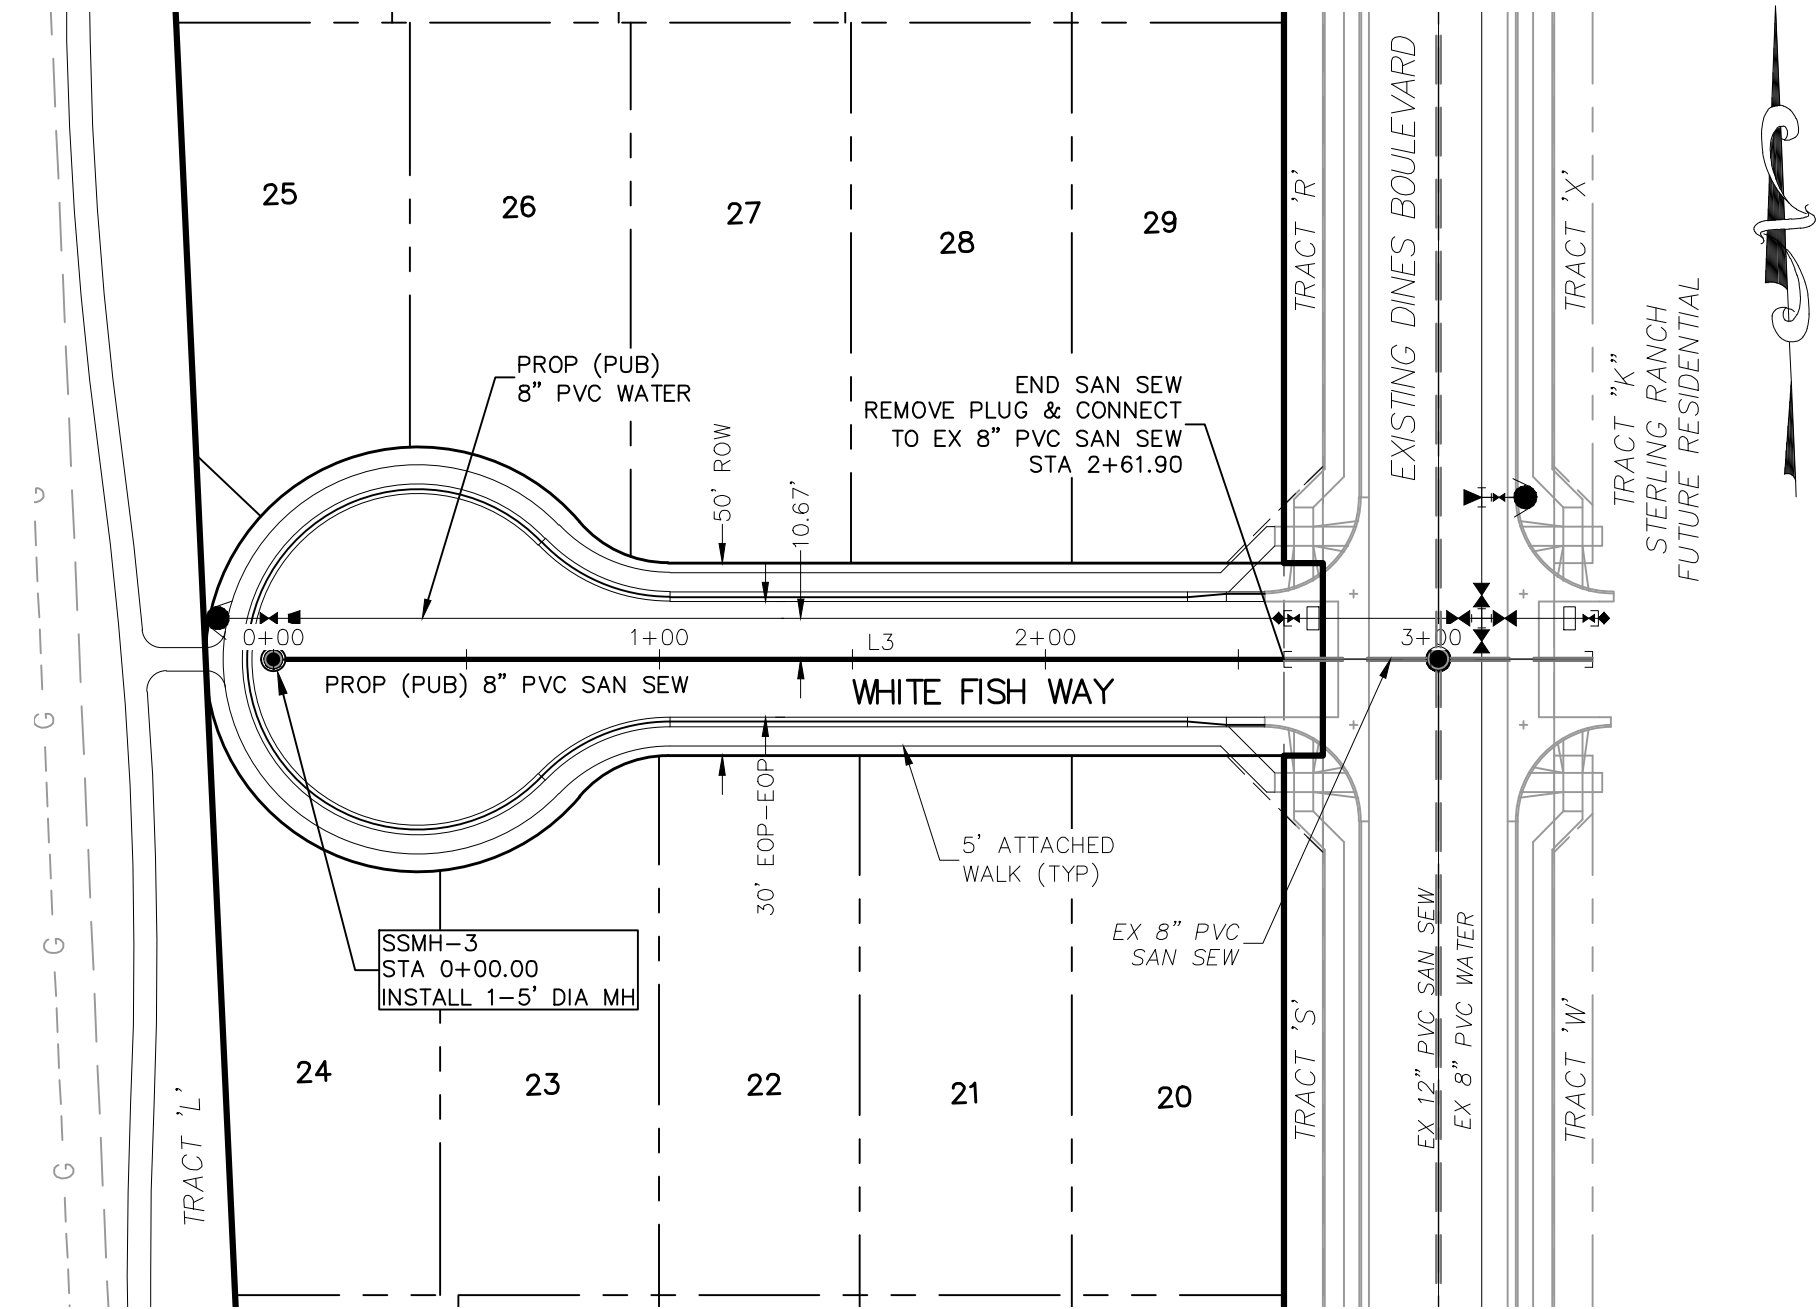


WHITE FISH WAY
STA 0+00.00 TO STA 2+61.90

SANITARY SEWER LINE TABLE

LINE	LENGTH	DIRECTION
L1	241.95'	N83°26'41"E
L2	242.75'	S87°35'34"E
L3	261.90'	S87°35'34"E

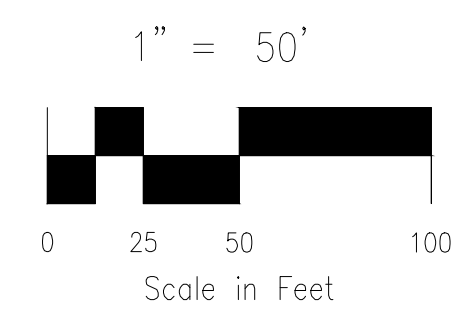

FOR LOCATING & MARKING GAS, ELECTRIC, WATER & TELEPHONE LINES
FOR BURIED UTILITY INFORMATION
48 HRS BEFORE YOU DIG
CALL 1-800-922-1987

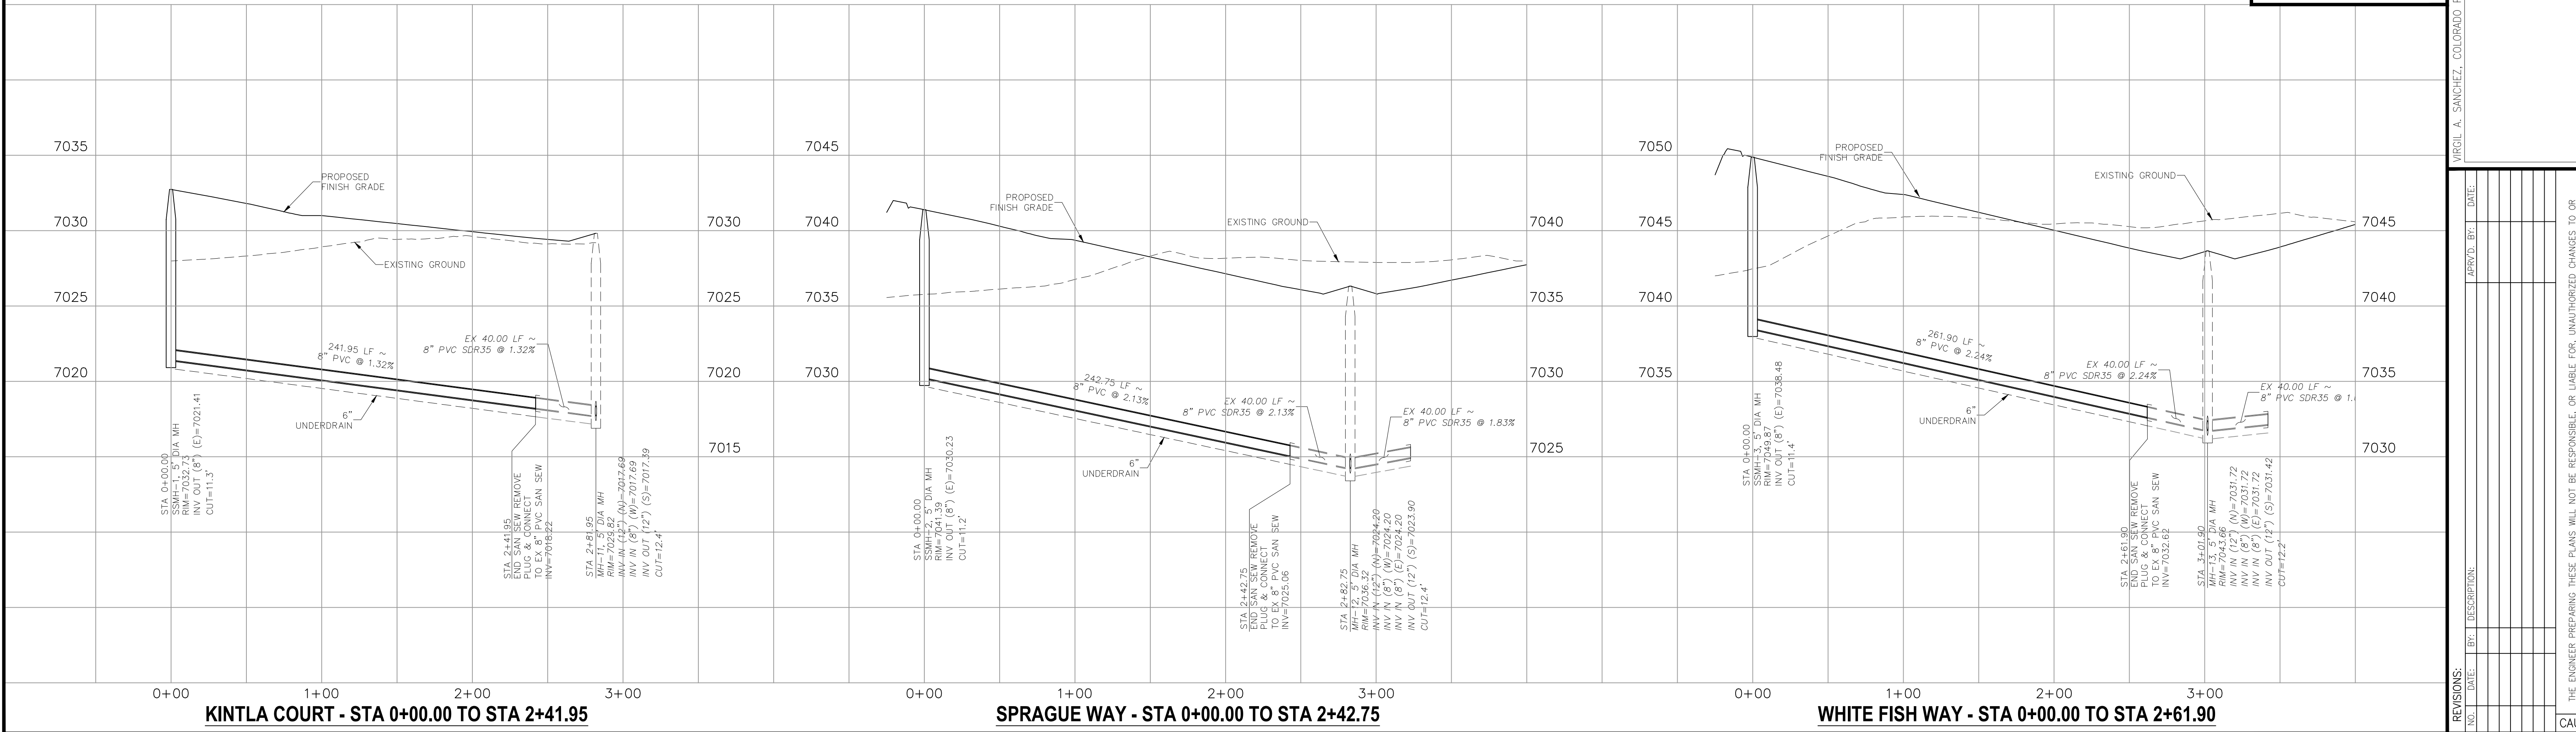

KINTLA COURT - STA 0+00.00 TO STA 2+41.95

SPRAGUE WAY - STA 0+00.00 TO STA 2+42.75

WHITE FISH WAY - STA 0+00.00 TO STA 2+61.90

BRANDING IRON AT STERLING RANCH FILING NO. 1
SANITARY SEWER PLANS
PROJECT NO. 09-006
DATE: 11/10/2017
DESIGNED BY: VLS
DRAWN BY: GW
CHECKED BY: VLS
SCALE: HORIZONTAL: 1"=50'
VERTICAL: 1"=5'
SHEET 2 OF 4
SS02

20 BOULDER CRESCENT, SUITE 110
COLORADO SPRINGS, CO 80903
PHONE: 719.955.5485

CIVIL CONSULTANTS, INC.

FOR AND ON BEHALF OF
M&S CIVIL CONSULTANTS, INC.


MARCIL A. SANCHEZ, COLORADO P.E. NO. 37160

NO.	DATE	BY	DESCRIPTION	APPROVED BY	DATE


THE ENGINEER PREPARING THESE PLANS WILL NOT BE RESPONSIBLE OR LIABLE FOR UNAUTHORIZED CHANGES TO OR USES OF THESE PLANS. ALL CHANGES TO THE PLANS MUST BE IN WRITING AND MUST BE APPROVED BY THE PREPARER OF THESE PLANS.

CAUTION

File: 0:\09006A\Sterling Ranch No 3\Map\Const Draw\Sanitary Sewer Plans\SS02.dwg PlotStamp: 11/16/2017 6:37 PM

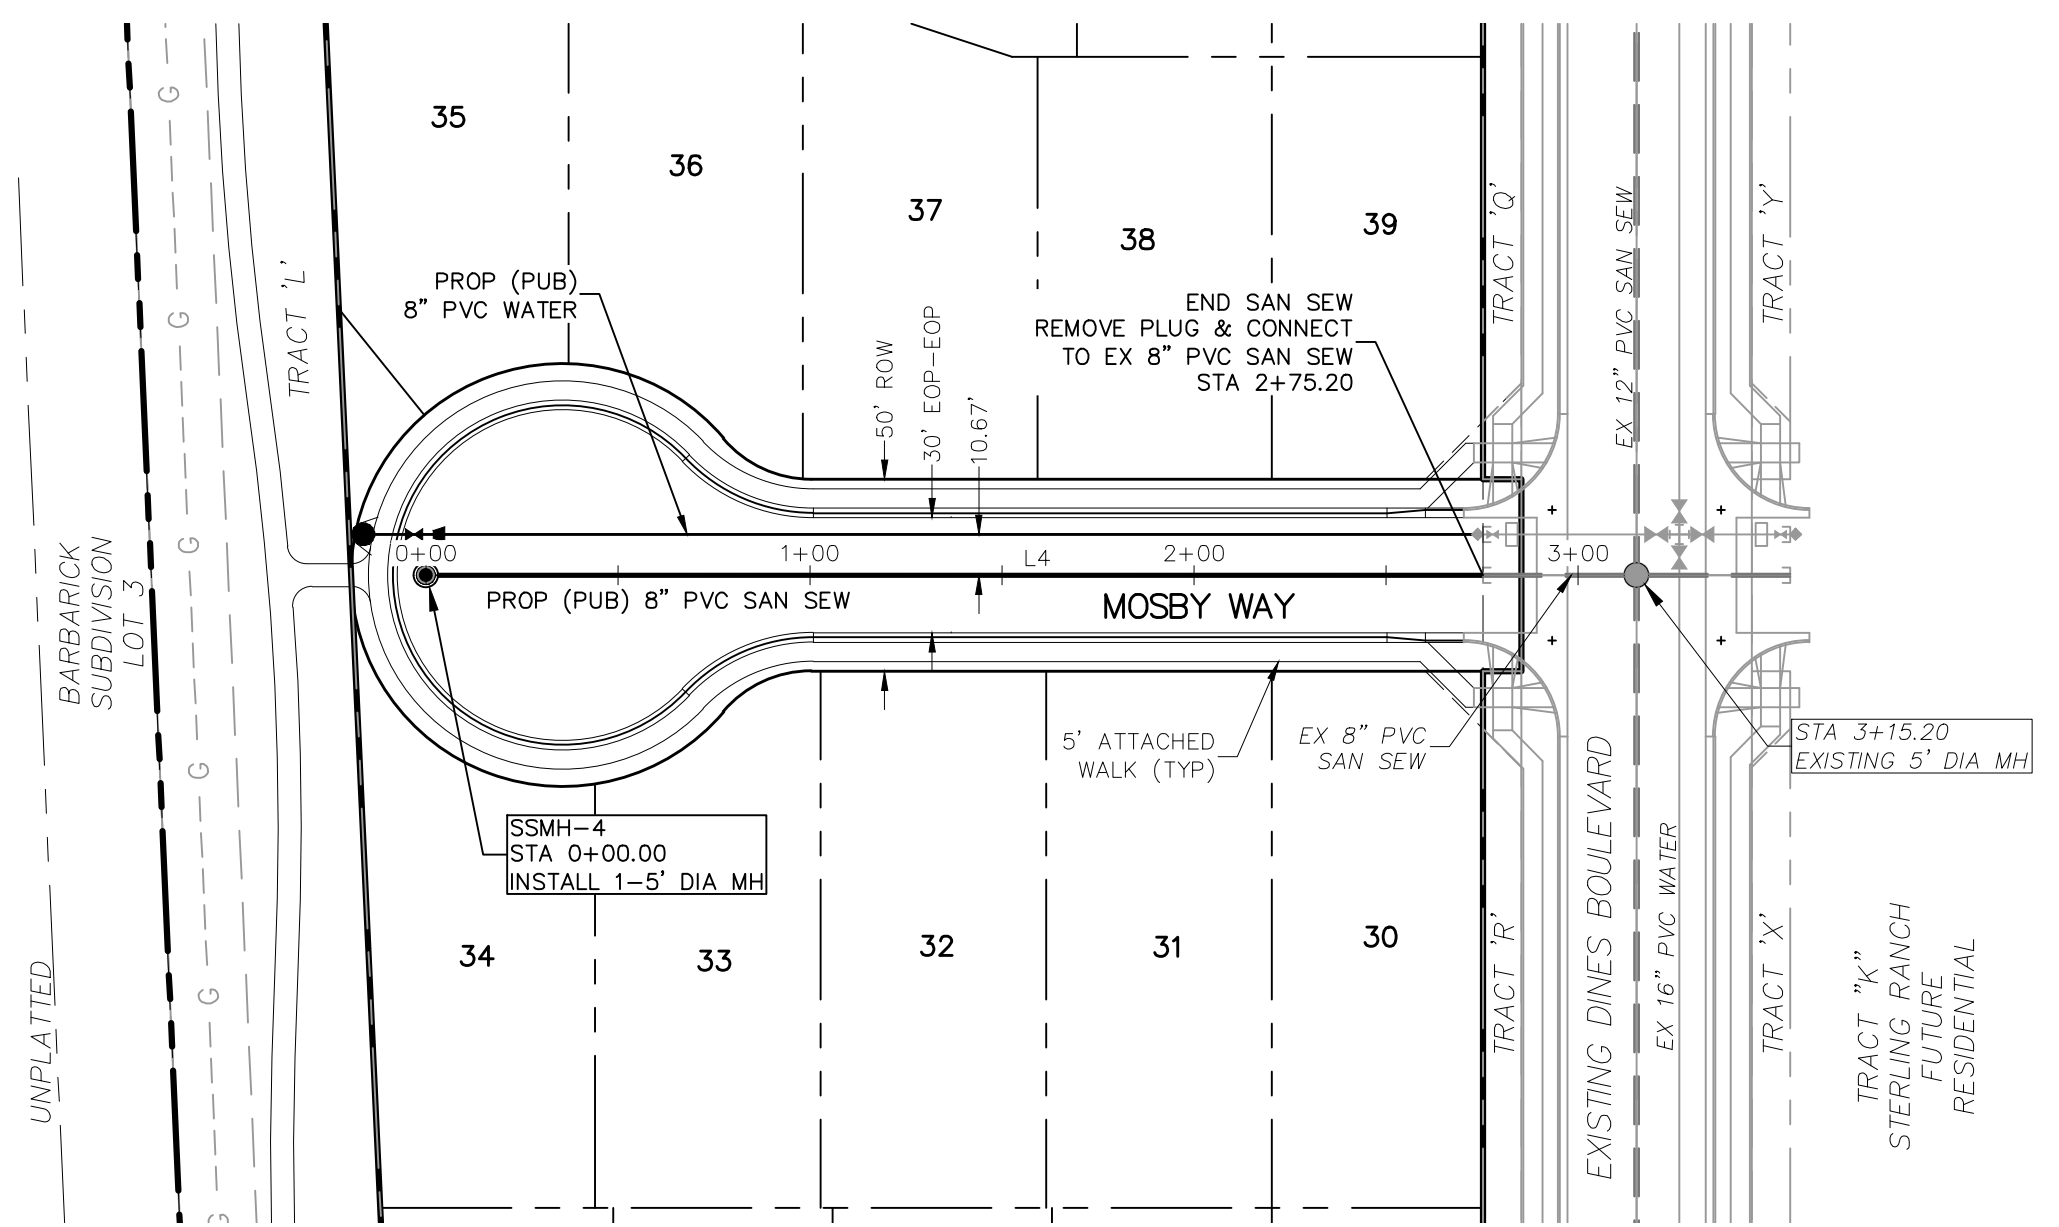


MOSBY WAY
STA 0+00.00 TO STA 2+75.20

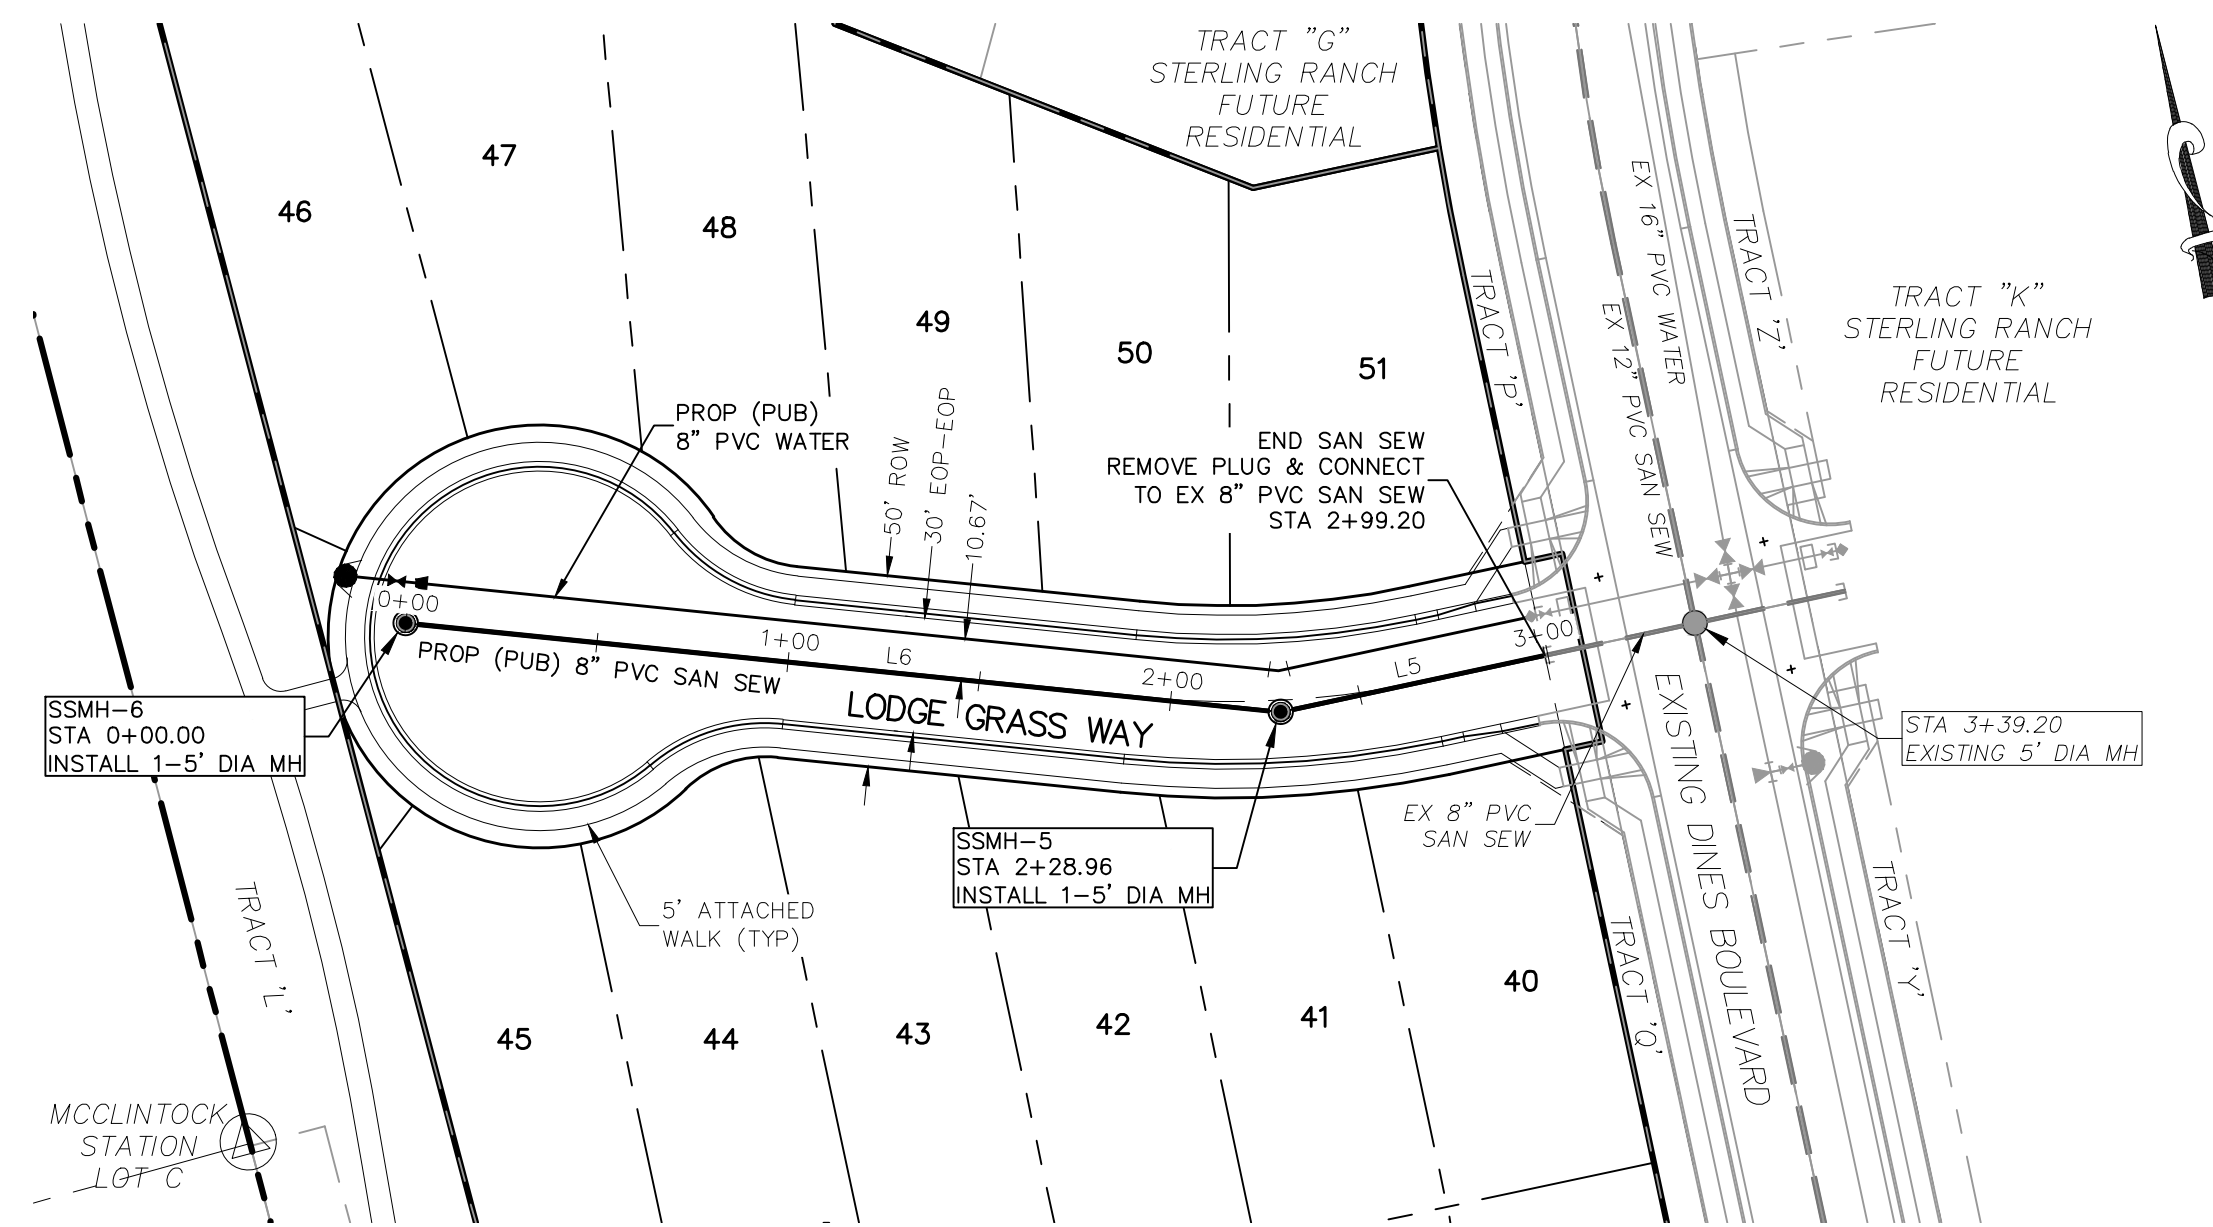


LODGE GRASS WAY
STA 0+00.00 TO STA 2+99.20


SANITARY SEWER LINE TABLE		
LINE	LENGTH	DIRECTION
L4	300.20'	S87°35'34"E
L5	70.24'	S87°35'34"E
L6	253.96'	S69°40'03"E

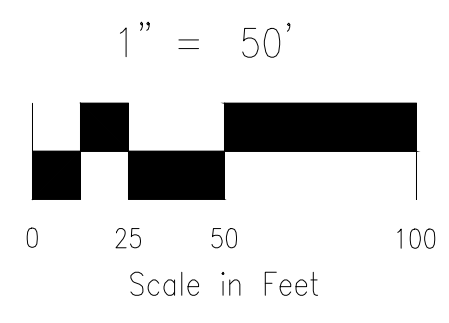

FOR LOCATING & MARKING GAS, ELECTRIC, WATER & TELEPHONE LINES
FOR BURIED UTILITY INFORMATION
48 HRS BEFORE YOU DIG
CALL 1-800-922-1987

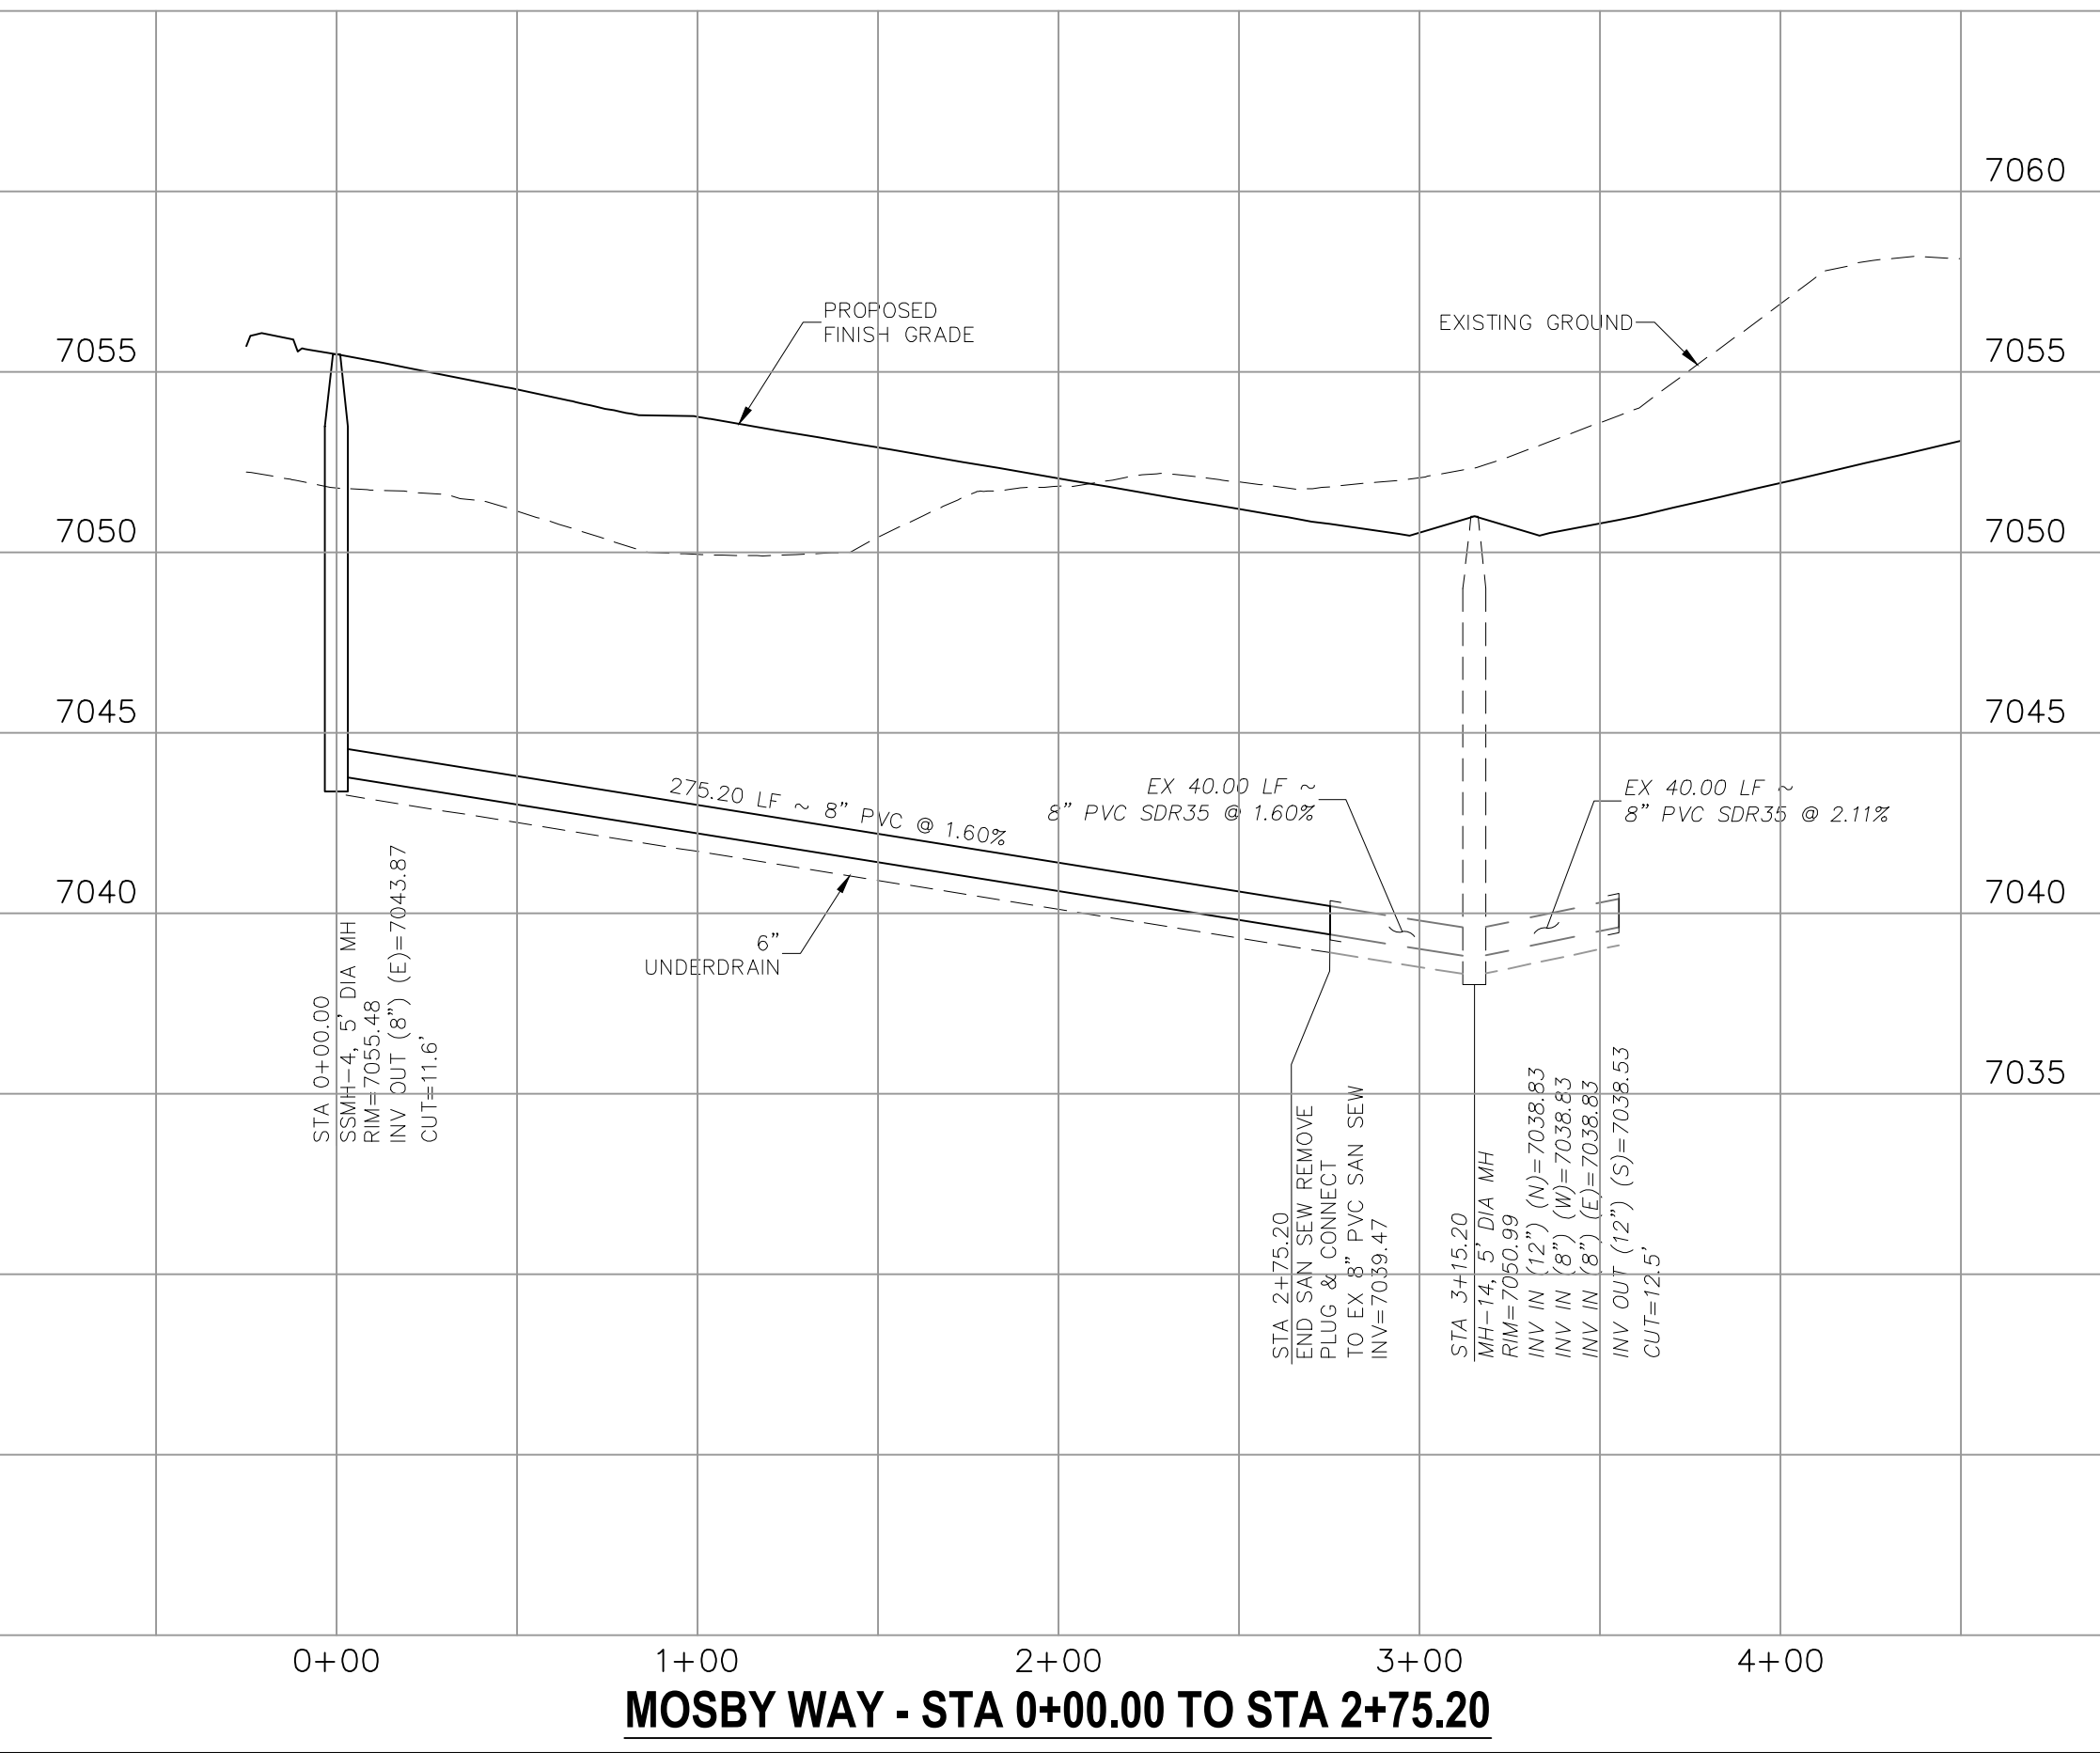

MOSBY WAY - STA 0+00.00 TO STA 2+75.20

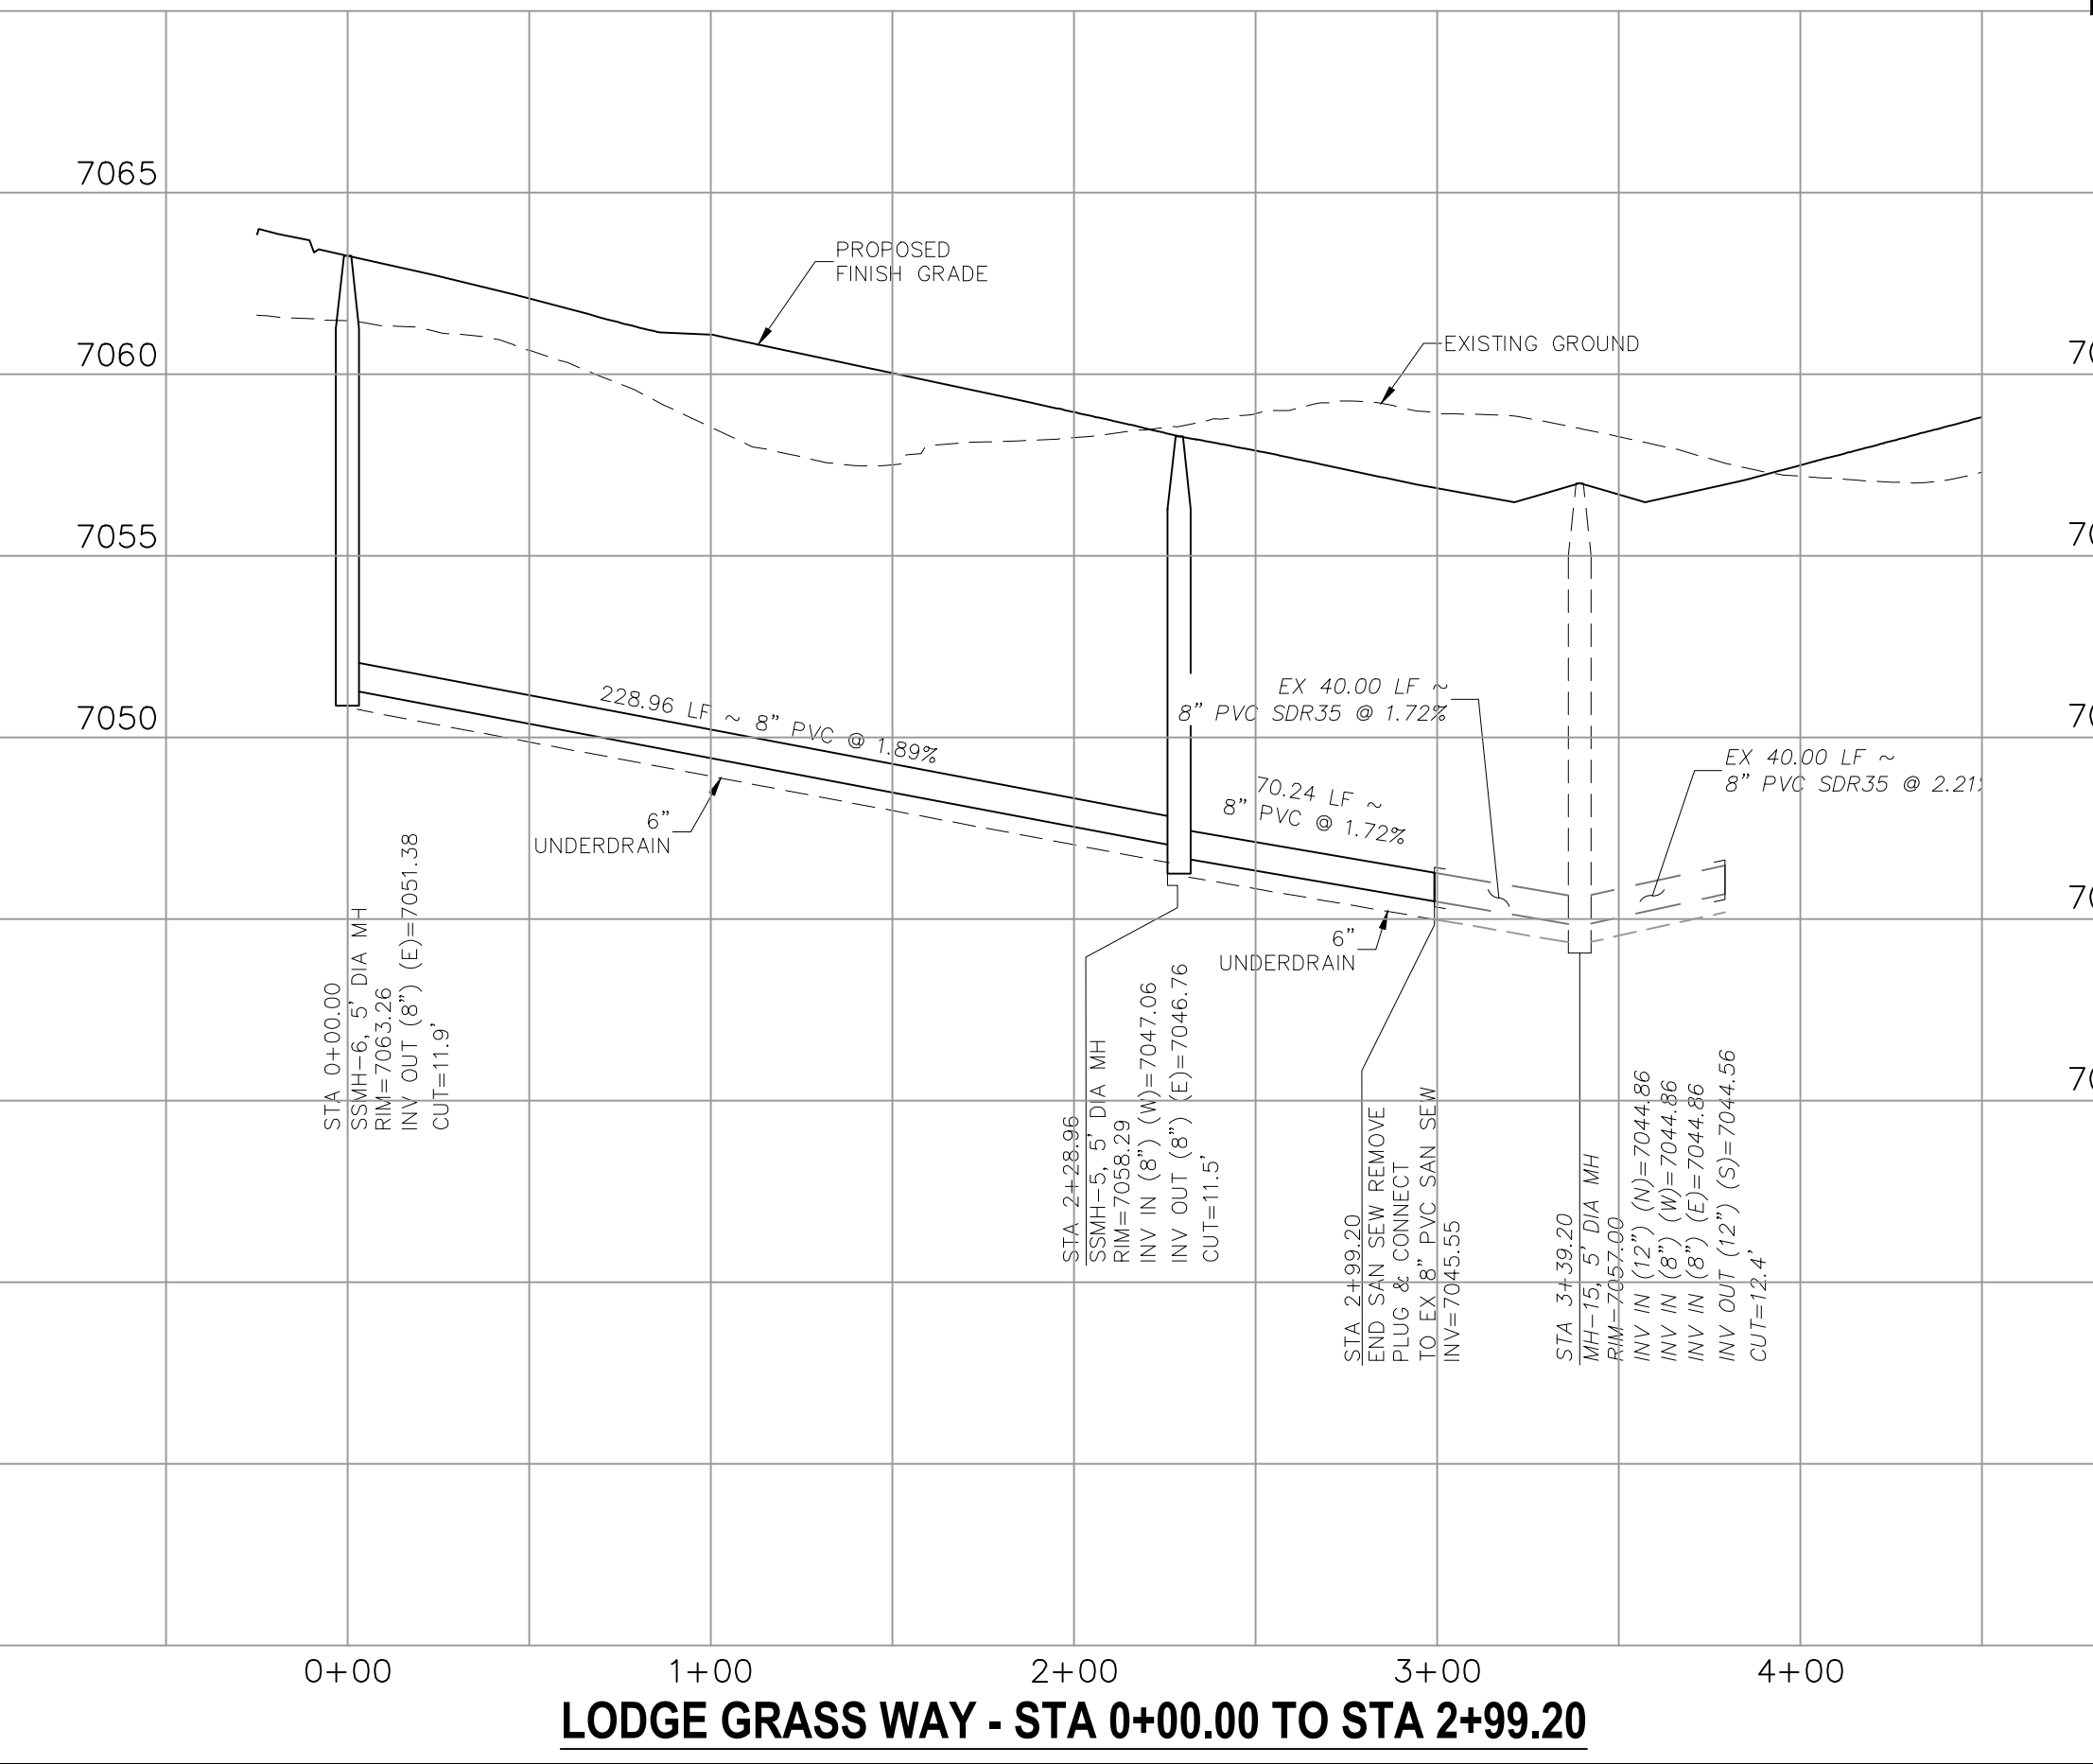

LODGE GRASS WAY - STA 0+00.00 TO STA 2+99.20

20 BOULDER CRESCENT, SUITE 110
COLORADO SPRINGS, CO 80903
PHONE: 719.955.5485

M&S CIVIL CONSULTANTS, INC.

FOR AND ON BEHALF OF M&S CIVIL CONSULTANTS, INC.



MARCIL A. SANCHEZ, COLORADO P.E. NO. 37760

NO.	DATE	BY	DESCRIPTION

THE ENGINEER PREPARING THESE PLANS WILL NOT BE RESPONSIBLE OR LIABLE FOR UNAUTHORIZED CHANGES TO OR USES OF THESE PLANS. ALL CHANGES TO THE PLANS MUST BE IN WRITING AND MUST BE APPROVED BY THE PREPARER OF THESE PLANS.


CAUTION

File: 0:\09006A\Sterling Ranch No 3\Map\Const Draw\Sewer Plans\SS03.dwg PlotStamp: 11/16/2017 8:49 PM

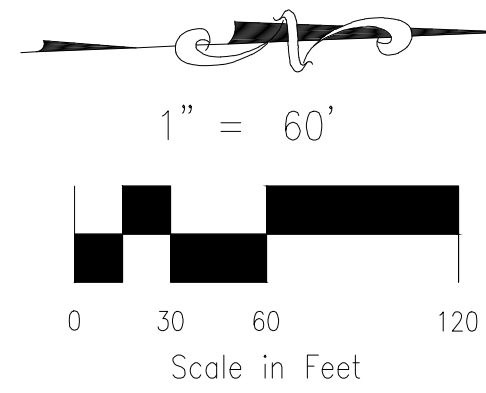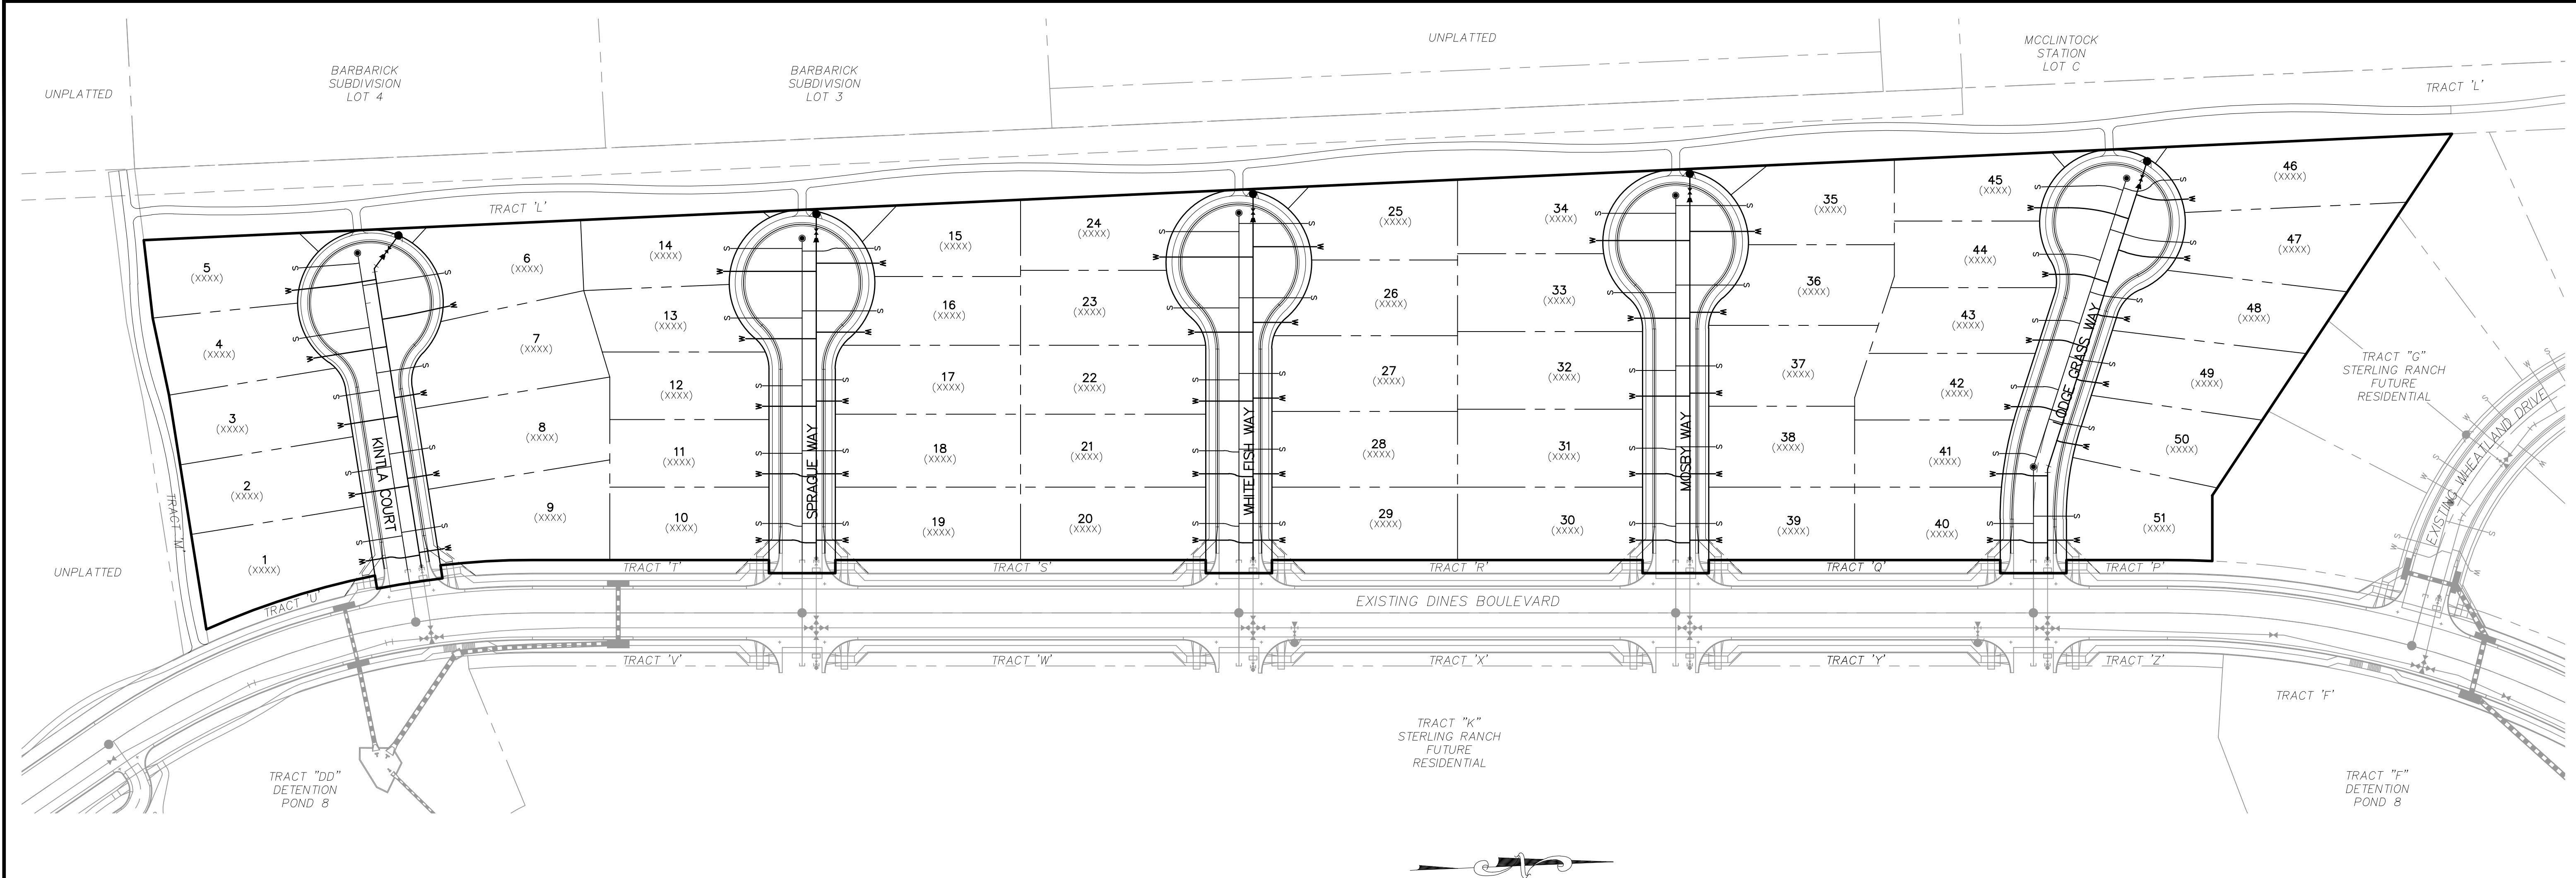

GENERAL NOTES:

1. THE CONTRACTOR IS RESPONSIBLE FOR ANY DAMAGE TO ANY UTILITY FACILITIES AS A RESULT OF HIS ACTIONS. THE CONTRACTOR SHALL MAKE ALL THE REQUIRED REPAIRS IMMEDIATELY TO THE SATISFACTION OF THE STERLING RANCH SANITARY DISTRICT.

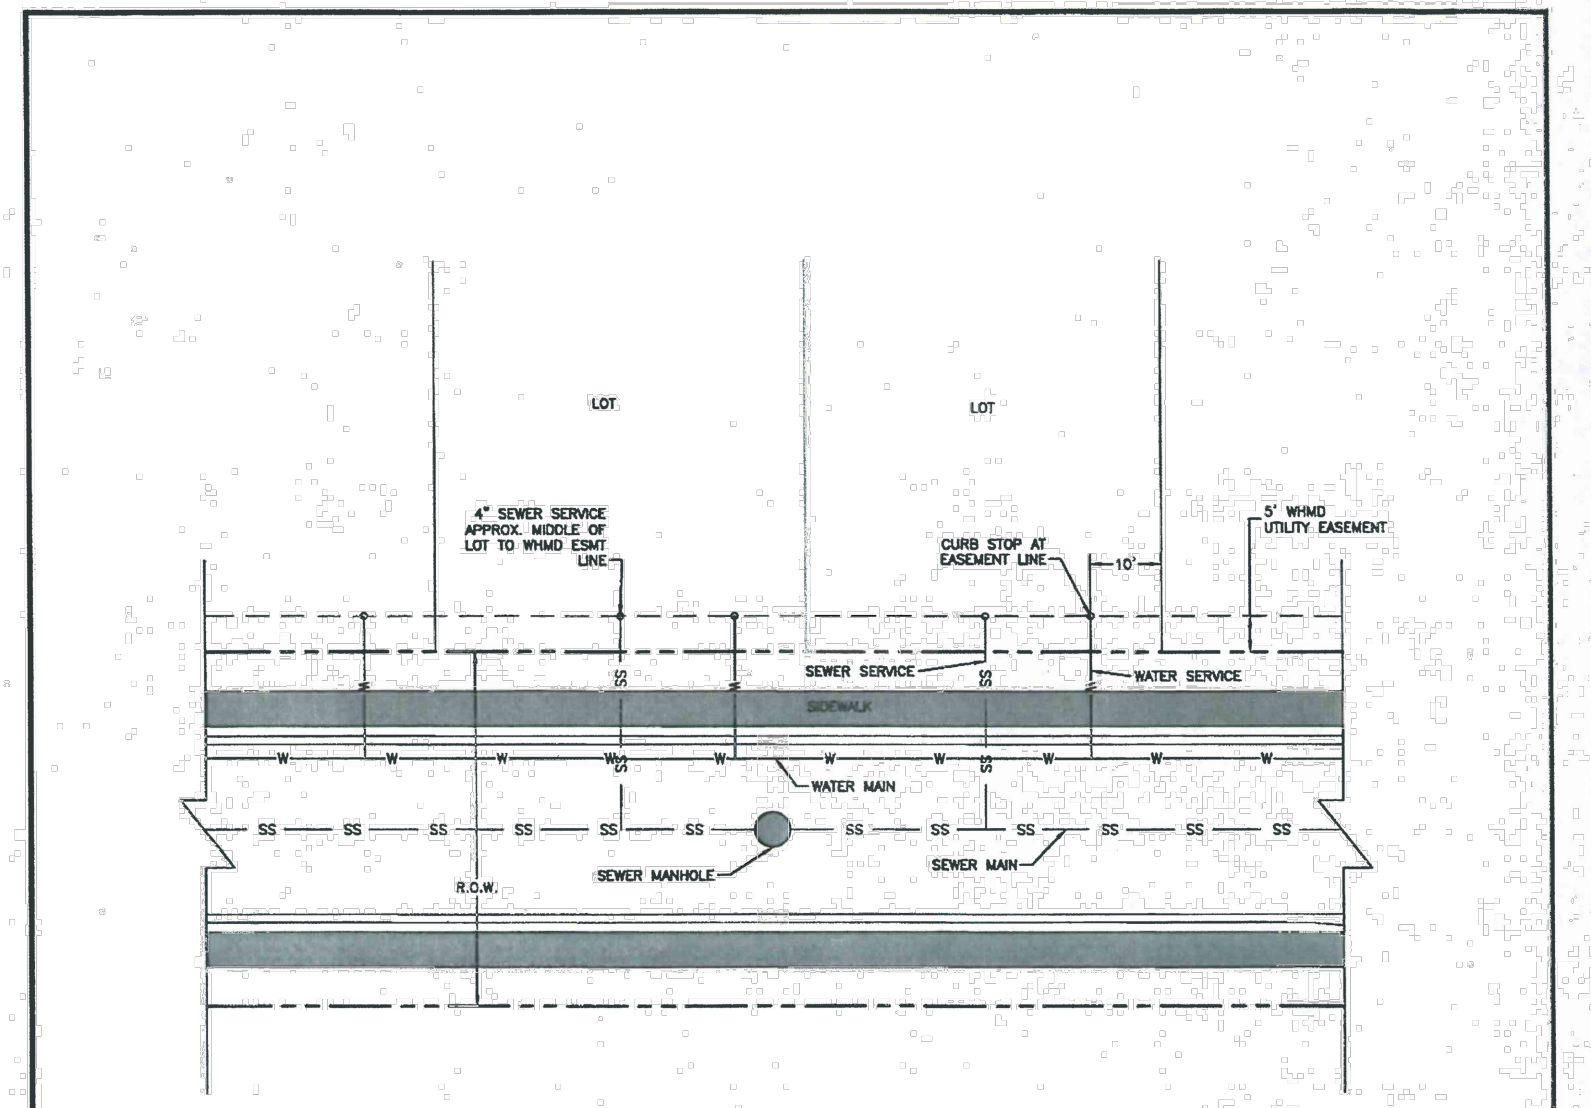

- NOTES:**
1. WATER SERVICE TO BE 10' FROM "DOWNSTREAM" PROPERTY LINE AND EXTENDED TO WHMD UTILITY EASEMENT LINE.
 2. SEWER SERVICE TO BE PLACED APPROXIMATELY IN THE MIDDLE OF THE LOT AND EXTENDED TO WHMD UTILITY EASEMENT LINE.
 3. SERVICES SHALL BE MARKED WITH 2"x4" POST AT TERMINATION POINT FOR LOCATION DURING CONNECTION TO RESIDENCE. POSTS SHALL BE SPRAY-PAINTED BLUE FOR WATER AND GREEN FOR SEWER.

UTILITY SERVICE LOCATIONS

Drawn: GJM	Reviewed:	WOODMEN HILLS	WATER & WASTEWATER SYSTEM	WW-20
Date: JAN 2011	Reviewed:	15200 WOODMEN HILLS BLVD	STANDARD SPECIFICATIONS	
Scale: as s.h.s.	Reviewed:			

FOR LOCATING & MARKING GAS, ELECTRIC, WATER & TELEPHONE LINES

FOR BURIED UTILITY INFORMATION CALL 1-800-922-1987

BRANDING IRON AT STERLING RANCH FILING NO. 1

UTILITY SERVICE PLANS

PROJECT NO. 09-006 DATE: 11/10/2017

SCALE: HORIZONTAL: 1"=60' VERTICAL: N/A

DESIGNED BY: VAS ELV CHECKED BY: ELY GW

SHEET 4 OF 4 **UT01**

20 BOULDER CRESCENT SUITE 110
 COLORADO SPRINGS, CO 80903
 PHONE: 719.955.5485

CIVIL CONSULTANTS, INC.

FOR AND ON BEHALF OF M&S CIVIL CONSULTANTS, INC.

VIRGIL A. SANCHEZ, COLORADO P.E. NO. 37160

NO.	DATE	BY	DESCRIPTION

THE ENGINEER PREPARING THESE PLANS WILL NOT BE RESPONSIBLE OR LIABLE FOR UNAUTHORIZED CHANGES TO OR USES OF THESE PLANS. ALL CHANGES TO THE PLANS MUST BE IN WRITING AND MUST BE APPROVED BY THE PREPARER OF THESE PLANS.

CAUTION

Markup Summary

dsdrice (5)



Subject: Cloud+
Page Label: 1
Lock: Unlocked
Status:
Checkmark: Unchecked
Author: dsdrice
Date: 3/2/2018 11:08:37 AM
Color:

Jennifer Irvine

SF-17-024


Subject: Text Box
Page Label: 1
Lock: Unlocked
Status:
Checkmark: Unchecked
Author: dsdrice
Date: 3/2/2018 10:50:54 AM
Color:

SF-17-024




Subject: Cloud+
Page Label: 2
Lock: Unlocked
Status:
Checkmark: Unchecked
Author: dsdrice
Date: 3/2/2018 11:08:05 AM
Color:

Revise all references to DSD to be PCD and DOT to be DPW

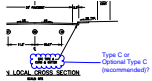

Subject: Cloud+
Page Label: 2
Lock: Unlocked
Status:
Checkmark: Unchecked
Author: dsdrice
Date: 3/2/2018 12:24:33 PM
Color:


Type C or Optional Type C (recommended)?

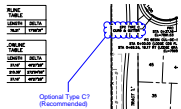

Subject: Cloud+
Page Label: 3
Lock: Unlocked
Status:
Checkmark: Unchecked
Author: dsdrice
Date: 3/2/2018 12:25:53 PM
Color:

Optional Type C? (Recommended)

AutoCAD SHX Text (1205)

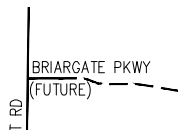

Subject:
Page Label: 1
Lock: Unlocked
Status:
Checkmark: Unchecked
Author: AutoCAD SHX Text
Date:
Color:

BRIARGATE PKWY

SCALE:
HORIZONTAL:
N/A
VERTICAL:
N/A

Subject:
Page Label: 1
Lock: Unlocked
Status:
Checkmark: Unchecked
Author: AutoCAD SHX Text
Date:
Color:

VERTICAL:

ERTICA
N/A

Subject:
Page Label: 1
Lock: Unlocked
Status:
Checkmark: Unchecked
Author: AutoCAD SHX Text
Date:
Color:

N/A

3/1/00
FOR AND ON
BEHALF OF
M&S CIVIL
CONSULTANTS,
INC.

Subject:
Page Label: 1
Lock: Unlocked
Status:
Checkmark: Unchecked
Author: AutoCAD SHX Text
Date:
Color:

FOR AND ON BEHALF OF M&S CIVIL
CONSULTANTS, INC.

STERLING
(FUTURE)
RAI

Subject:
Page Label: 1
Lock: Unlocked
Status:
Checkmark: Unchecked
Author: AutoCAD SHX Text
Date:
Color:

STERLING

BENCHMARKS
1. THE TOP OF AN ALUMINUM SURVEYORS CAP, STAMPED "9853", AT THE TOP OF AN ALUMINUM SURVEYORS CAP, STAMPED "9853", AT THE SOUTHEAST BOUNDARY CORNER OF BARBARICK SUBDIVISION NORTHING = 411416.273 = 411416.273 EASTING = 235167.071 = 235167.071 ELEVATION = 7023.42 = 7023.42
2. THE TOP OF A RED PLASTIC SURVEYORS CAP, ILLEGIBLE, AT THE THE TOP OF A RED PLASTIC SURVEYORS CAP, ILLEGIBLE, AT THE NORTHWEST BOUNDARY CORNER OF PAWNEE RANCHEROS SUBDIVISION NORTHING = 410095.404 = 410095.404 EASTING = 235052.131 = 235052.131 ELEVATION = 7000.40 = 7000.40
3. THE TOP OF A RED PLASTIC SURVEYORS CAP, STAMPED "38141", AT THE TOP OF A RED PLASTIC SURVEYORS CAP, STAMPED "38141", AT THE SOUTHWEST BOUNDARY CORNER OF BARBARICK SUBDISION NORTHING = 411399.962 = 411399.962 EASTING = 233849.817 = 233849.817 ELEVATION = 7030.82 = 7030.82

Subject:
Page Label: 1
Lock: Unlocked
Status:
Checkmark: Unchecked
Author: AutoCAD SHX Text
Date:
Color:

BENCHMARKS 1. THE TOP OF AN ALUMINUM SURVEYORS CAP, STAMPED "9853", AT THE TOP OF AN ALUMINUM SURVEYORS CAP, STAMPED "9853", AT THE SOUTHEAST BOUNDARY CORNER OF BARBARICK SUBDIVISION NORTHING = 411416.273 = 411416.273 EASTING = 235167.071 = 235167.071 ELEVATION = 7023.42 = 7023.42
2. THE TOP OF A RED PLASTIC SURVEYORS CAP, ILLEGIBLE, AT THE THE TOP OF A RED PLASTIC SURVEYORS CAP, ILLEGIBLE, AT THE NORTHWEST BOUNDARY CORNER OF PAWNEE RANCHEROS SUBDIVISION NORTHING = 410095.404 = 410095.404 EASTING = 235052.131 = 235052.131 ELEVATION = 7000.40 = 7000.40
3. THE TOP OF A RED PLASTIC SURVEYORS CAP, STAMPED "38141", AT THE TOP OF A RED PLASTIC SURVEYORS CAP, STAMPED "38141", AT THE SOUTHWEST BOUNDARY CORNER OF BARBARICK SUBDISION NORTHING = 411399.962 = 411399.962 EASTING = 233849.817 = 233849.817 ELEVATION = 7030.82 = 7030.82




Subject:
Page Label: 1
Lock: Unlocked
Status:
Checkmark: Unchecked
Author: AutoCAD SHX Text
Date:
Color:

NO.




Subject:
Page Label: 1
Lock: Unlocked
Status:
Checkmark: Unchecked
Author: AutoCAD SHX Text
Date:
Color:

FOR BURIED UTILITY INFORMATION

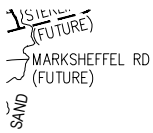

Subject:
Page Label: 1
Lock: Unlocked
Status:
Checkmark: Unchecked
Author: AutoCAD SHX Text
Date:
Color:

MARKSHEFFEL RD (FUTURE)

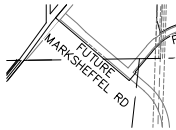


Subject:
Page Label: 1
Lock: Unlocked
Status:
Checkmark: Unchecked
Author: AutoCAD SHX Text
Date:
Color:

FUTURE MARKSHEFFEL RD



Subject:
Page Label: 1
Lock: Unlocked
Status:
Checkmark: Unchecked
Author: AutoCAD SHX Text
Date:
Color:

VOLLMER RD

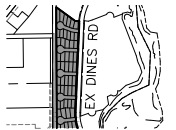

Subject:
Page Label: 1
Lock: Unlocked
Status:
Checkmark: Unchecked
Author: AutoCAD SHX Text
Date:
Color:

EX DINES RD



Subject:
Page Label: 1
Lock: Unlocked
Status:
Checkmark: Unchecked
Author: AutoCAD SHX Text
Date:
Color:

POWERS BLVD

SHEET INDEX

SHEET 1	TITLE SHEET
SHEET 2	NOTES & DETAILS
SHEET 3	PLAN & PROFILE - LODGE GRASS WAY
SHEET 4	PLAN & PROFILE - MOSBY WAY
SHEET 5	PLAN & PROFILE - MOSBY WAY
SHEET 6	PLAN & PROFILE - SPRAGUE WAY
SHEET 7	PLAN & PROFILE - SPRAGUE WAY
SHEET 8	SIGNAGE & STRIPING PLAN

Subject:
Page Label: 1
Lock: Unlocked
Status:
Checkmark: Unchecked
Author: AutoCAD SHX Text
Date:
Color:

SHEET INDEX SHEET 1 TITLE SHEET TITLE
 SHEET SHEET 2 NOTES & DETAILS NOTES &
 DETAILS SHEET 3 PLAN & PROFILE - LODGE
 GRASS WAY PLAN & PROFILE - LODGE GRASS
 WAY - LODGE GRASS WAY SHEET 4 PLAN &
 PROFILE - MOSBY WAY PLAN & PROFILE -
 MOSBY WAY - MOSBY WAY SHEET 5 PLAN &
 PROFILE - VWHITEFISH WAY PLAN &
 PROFILE - VWHITEFISH WAY - VWHITEFISH
 WAY SHEET 6 PLAN & PROFILE - SPRAGUE
 WAY PLAN & PROFILE - SPRAGUE WAY -
 SPRAGUE WAY SHEET 7 PLAN & PROFILE -
 KINTLA COURT PLAN & PROFILE - KINTLA
 COURT - KINTLA COURT SHEET 8 SIGNAGE &
 STRIPING PLANSIGNAGE & STRIPING PLAN

REVISIONS:	
NO.	DATE:

Subject:
Page Label: 1
Lock: Unlocked
Status:
Checkmark: Unchecked
Author: AutoCAD SHX Text
Date:
Color:

REVISIONS:

RANCH FILLIN	ENT PLANS	11/10/2017	SHEET 1 OF 8
--------------	-----------	------------	--------------


Subject:
Page Label: 1
Lock: Unlocked
Status:
Checkmark: Unchecked
Author: AutoCAD SHX Text
Date:
Color:

11/10/2017




Subject:
Page Label: 1
Lock: Unlocked
Status:
Checkmark: Unchecked
Author: AutoCAD SHX Text
Date:
Color:

E WOODMEN RD

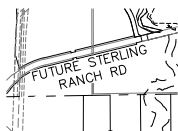


Subject:
Page Label: 1
Lock: Unlocked
Status:
Checkmark: Unchecked
Author: AutoCAD SHX Text
Date:
Color:

FUTURE STERLING RANCH RD

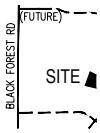

Subject:
Page Label: 1
Lock: Unlocked
Status:
Checkmark: Unchecked
Author: AutoCAD SHX Text
Date:
Color:

BLACK FOREST RD

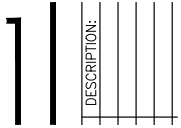

Subject:
Page Label: 1
Lock: Unlocked
Status:
Checkmark: Unchecked
Author: AutoCAD SHX Text
Date:
Color:

DESCRIPTION:



Subject:
Page Label: 1
Lock: Unlocked
Status:
Checkmark: Unchecked
Author: AutoCAD SHX Text
Date:
Color:

09-006




Subject:
Page Label: 1
Lock: Unlocked
Status:
Checkmark: Unchecked
Author: AutoCAD SHX Text
Date:
Color:

CALL 1-800-922-1987




Subject:
Page Label: 1
Lock: Unlocked
Status:
Checkmark: Unchecked
Author: AutoCAD SHX Text
Date:
Color:

HORIZONTAL:

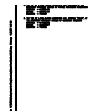

Subject:
Page Label: 1
Lock: Unlocked
Status:
Checkmark: Unchecked
Author: AutoCAD SHX Text
Date:
Color:


File: O:\09006A\Sterling Ranch No 3\dwg\Const
 Dwg\Street Plans\Residential\SI01.dwg
 Plotstamp: 11/6/2017 1:25 PM

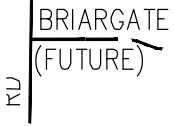


Subject: (FUTURE)
Page Label: 1
Lock: Unlocked
Status:
Checkmark: Unchecked
Author: AutoCAD SHX Text
Date:
Color:




Subject: BURGESS RD
Page Label: 1
Lock: Unlocked
Status:
Checkmark: Unchecked
Author: AutoCAD SHX Text
Date:
Color:

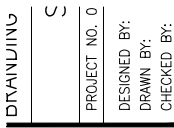


Subject: PROJECT NO.
Page Label: 1
Lock: Unlocked
Status:
Checkmark: Unchecked
Author: AutoCAD SHX Text
Date:
Color:

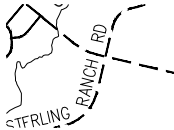

Subject: RANCH RD
Page Label: 1
Lock: Unlocked
Status:
Checkmark: Unchecked
Author: AutoCAD SHX Text
Date:
Color:

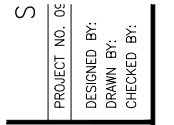

Subject: DESIGNED BY:
Page Label: 1
Lock: Unlocked
Status:
Checkmark: Unchecked
Author: AutoCAD SHX Text
Date:
Color:

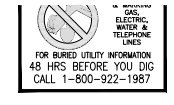


Subject: 48 HRS BEFORE YOU DIG
Page Label: 1
Lock: Unlocked
Status:
Checkmark: Unchecked
Author: AutoCAD SHX Text
Date:
Color:

DATE:


Subject:
Page Label: 1
Lock: Unlocked
Status:
Checkmark: Unchecked
Author: AutoCAD SHX Text
Date:
Color:

DATE:

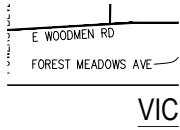

Subject:
Page Label: 1
Lock: Unlocked
Status:
Checkmark: Unchecked
Author: AutoCAD SHX Text
Date:
Color:

FOREST MEADOWS AVE

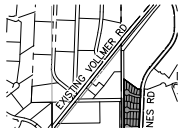

Subject:
Page Label: 1
Lock: Unlocked
Status:
Checkmark: Unchecked
Author: AutoCAD SHX Text
Date:
Color:

EXISTING VOLLMER RD

PROJECT NO.:
DESIGNED BY:
DRAWN BY:
CHECKED BY:

Subject:
Page Label: 1
Lock: Unlocked
Status:
Checkmark: Unchecked
Author: AutoCAD SHX Text
Date:
Color:

DRAWN BY:



MAP

Subject:
Page Label: 1
Lock: Unlocked
Status:
Checkmark: Unchecked
Author: AutoCAD SHX Text
Date:
Color:

MARKSHEFFEL RD



Subject:
Page Label: 1
Lock: Unlocked
Status:
Checkmark: Unchecked
Author: AutoCAD SHX Text
Date:
Color:

APPROVALS: ENGINEER'S STATEMENT:
DETAILED IMPROVEMENT PLANS AND
SPECIFICATIONS ENGINEER'S STATEMENT:
THESE DETAILED PLANS AND
SPECIFICATIONS WERE PREPARED UNDER
MY DIRECTION AND SUPERVISION. SAID
DETAILED PLANS AND SPECIFICATIONS HAVE
BEEN PREPARED ACCORDING TO THE
CRITERIA ESTABLISHED BY THE COUNTY FOR
DETAILED DRAINAGE PLANS AND
SPECIFICATIONS, AND SAID DETAILED PLANS
AND SPECIFICATIONS ARE IN CONFORMITY
WITH THE MASTER PLAN OF THE DRAINAGE
BASIN. SAID DETAILED DRAINAGE PLANS AND
SPECIFICATIONS MEET THE PURPOSES FOR
WHICH THE PARTICULAR DRAINAGE
FACILITY(S) IS DESIGNED. I ACCEPT
RESPONSIBILITY FOR ANY LIABILITY CAUSED
BY ANY NEGLIGENT ACTS, ERRORS, OR
OMISSIONS ON MY PART IN PREPARATION OF
THE DETAILED IMPROVEMENT PLANS AND
SPECIFICATIONS. VIRGIL A SANCHEZ,
COLORADO P.E. NO. 37160 DATE DATE
FOR AND ON BEHALF OF M&S CIVIL
CONSULTANTS, INC. OWNER/DEVELOPER
STATEMENT: THE OWNER WILL COMPLY
WITH THE REQUIREMENTS OF THE DRAINAGE
REPORT AND PLAN AND THIS SET OF
CONSTRUCTION DOCUMENTS. THE OWNER
WILL COMPLY WITH THE REQUIREMENTS OF
THE GRADING AND EROSION CONTROL PLAN.
CHALLENGER HOMES DATE DATE
DIRECTOR OF PLANNING AND ENGINEERING
EL PASO COUNTY: COUNTY PLAN REVIEW IS
PROVIDED ONLY FOR GENERAL
CONFORMANCE WITH COUNTY DESIGN
CRITERIA. THE COUNTY IS NOT
RESPONSIBLE FOR THE ACCURACY AND
ADEQUACY OF THE DESIGN, DIMENSIONS,
AND/OR ELEVATIONS WHICH SHALL BE
CONFIRMED AT THE JOB SITE. THE COUNTY
THROUGH APPROVAL OF THIS DOCUMENT
ASSUMES NO RESPONSIBILITY FOR
COMPLETENESS AND/OR ACCURACY OF THIS
DOCUMENT. FILED IN ACCORDANCE WITH
THE REQUIREMENTS OF THE EL PASO
COUNTY LAND DEVELOPMENT CODE,
DRAINAGE CRITERIA, AND ENGINEERING
CRITERIA MANUAL AS AMENDED. XXXXX
XXXXX, P.E. DATE DATE COUNTY
ENGINEER / ECM ADMINISTRATOR STERLING
RANCH METROPOLITAN DISTRICT: THESE
DOCUMENTS HAVE BEEN REVIEWED AND
APPROVED FOR STORM DRAIN AND
ASSOCIATED UTILITY SERVICE
CONSTRUCTION. FOR AND ON BEHALF OF
THE STERLING RANCH METRO.
DISTRICT DATE DATE BLACK FOREST FIRE
PROTECTION DISTRICT: ALL FIRE HYDRANTS
SHALL BE INSTALLED ACCORDING TO THE
BLACK FOREST FIRE PROTECTION DISTRICT
SPECIFICATIONS. THE NUMBER OF FIRE
HYDRANTS AND HYDRANT LOCATIONS AS
SHOWN ON THE WATER INSTALLATION PLAN
ARE CORRECT AND ADEQUATE TO SATISFY
THE FIRE PROTECTION REQUIREMENTS AS
SPECIFIED BY THE BLACK FOREST FIRE
PROTECTION DISTRICT. FOR AND ON BEHALF
OF THE BLACK FOREST FIRE PROTECTION
DISTRICT DATEDATE

BY:

Subject:
Page Label: 1
Lock: Unlocked
Status:
Checkmark: Unchecked
Author: AutoCAD SHX Text
Date:
Color:

BY:



Subject:
Page Label: 1
Lock: Unlocked
Status:
Checkmark: Unchecked
Author: AutoCAD SHX Text
Date:
Color:

BRANDING IRON AT STERLING RANCH FILING NO. 1

PROJECT NO. 01
DESIGNED BY:
DRAWN BY:
CHECKED BY:


Subject:
Page Label: 1
Lock: Unlocked
Status:
Checkmark: Unchecked
Author: AutoCAD SHX Text
Date:
Color:

CHECKED BY:

DATE:


Subject:
Page Label: 1
Lock: Unlocked
Status:
Checkmark: Unchecked
Author: AutoCAD SHX Text
Date:
Color:

DATE:

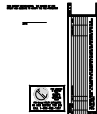

Subject:
Page Label: 1
Lock: Unlocked
Status:
Checkmark: Unchecked
Author: AutoCAD SHX Text
Date:
Color:

THE ENGINEER PREPARING THESE PLANS WILL NOT BE RESPONSIBLE, OR LIABLE FOR, UNAUTHORIZED CHANGES TO OR USES OF THESE PLANS. ALL CHANGES TO THE PLANS MUST BE IN WRITING AND MUST BE APPROVED BY THE PREPARER OF THESE PLANS.

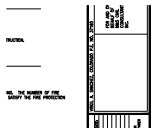


Subject:
Page Label: 1
Lock: Unlocked
Status:
Checkmark: Unchecked
Author: AutoCAD SHX Text
Date:
Color:

VIRGIL A. SANCHEZ, COLORADO P.E. NO. 37160



Subject:
Page Label: 1
Lock: Unlocked
Status:
Checkmark: Unchecked
Author: AutoCAD SHX Text
Date:
Color:

AGENCIES OWNER/DEVELOPER: SR LAND, LLC SR LAND, LLC 20 BOULDER CRESCENT, SUITE 201 COLORADO SPRINGS, CO 80903 JIM MORLEY (719) 471-1742 CIVIL ENGINEER: M & S CIVIL CONSULTANTS, INC. M & S CIVIL CONSULTANTS, INC. 20 BOULDER CRESCENT, SUITE 110 COLORADO SPRINGS, CO 80903 VIRGIL A. SANCHEZ P.E. (719) 955-5485 COUNTY ENGINEERING: EL PASO COUNTY DEVELOPMENT SERVICES EL PASO COUNTY DEVELOPMENT SERVICES 2880 INTERNATIONAL CIRCLE, SUITE 110 COLORADO SPRINGS, CO 80910 JEFF RICE, P.E. (719) 520-6300 TRAFFIC ENGINEERING: EL PASO COUNTY PUBLIC SERVICES & TRANS. DEPT. EL PASO COUNTY PUBLIC SERVICES & TRANS. DEPT. 3275 AKERS DRIVE COLORADO SPRINGS, CO 80922 JENNIFER IRVINE P.E. (719) 520-6460 WATER RESOURCES: STERLING RANCH METRO DISTRICT ENGINEERS STERLING RANCH METRO DISTRICT ENGINEERS JDS-HYDRO CONSULTANTS 545 E. PIKES PEAK AVE., SUITE 300 COLORADO SPRINGS, CO 80903 JOHN MCGINN (719) 668-8769 FIRE DISTRICT: BLACK FOREST FIRE PROTECTION DISTRICT BLACK FOREST FIRE PROTECTION DISTRICT 11445 TEACHOUT ROAD COLORADO SPRINGS, CO 80908 CHIEF BRYAN JACK (719) 495-4300 GAS DEPARTMENT: COLORADO SPRINGS UTILITIES COLORADO SPRINGS UTILITIES 7710 DURANT DR. COLORADO SPRINGS, CO 80947 TIM WENDT (719) 668-3556 ELECTRIC DEPARTMENT: MOUNTAIN VIEW ELECTRIC MOUNTAIN VIEW ELECTRIC 11140 E. WOODMEN ROAD FALCON, CO 80831 (719) 495-2283 COMMUNICATIONS: QWEST COMMUNICATIONS QWEST COMMUNICATIONS (U.N.C.C. LOCATORS) (800) 922-1987 AT&T (LOCATORS) (719) 635-3674

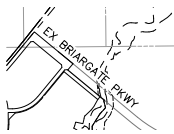

Subject:
Page Label: 1
Lock: Unlocked
Status:
Checkmark: Unchecked
Author: AutoCAD SHX Text
Date:
Color:

EX BRIARGATE PKWY

ELI
 GW


Subject:
Page Label: 1
Lock: Unlocked
Status:
Checkmark: Unchecked
Author: AutoCAD SHX Text
Date:
Color:

GW



Subject:
Page Label: 1
Lock: Unlocked
Status:
Checkmark: Unchecked
Author: AutoCAD SHX Text
Date:
Color:

CAUTION

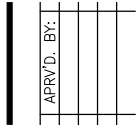

Subject:
Page Label: 1
Lock: Unlocked
Status:
Checkmark: Unchecked
Author: AutoCAD SHX Text
Date:
Color:

APRV'D. BY:



Subject:
Page Label: 1
Lock: Unlocked
Status:
Checkmark: Unchecked
Author: AutoCAD SHX Text
Date:
Color:

STREET IMPROVEMENT PLANS



Subject:
Page Label: 1
Lock: Unlocked
Status:
Checkmark: Unchecked
Author: AutoCAD SHX Text
Date:
Color:

SHEET 1 OF 8



Subject:
Page Label: 1
Lock: Unlocked
Status:
Checkmark: Unchecked
Author: AutoCAD SHX Text
Date:
Color:

SCALE:



Subject:
Page Label: 1
Lock: Unlocked
Status:
Checkmark: Unchecked
Author: AutoCAD SHX Text
Date:
Color:

N/A

COWPOKE RD

Subject:
Page Label: 1
Lock: Unlocked
Status:
Checkmark: Unchecked
Author: AutoCAD SHX Text
Date:
Color:

COWPOKE RD



Subject:
Page Label: 1
Lock: Unlocked
Status:
Checkmark: Unchecked
Author: AutoCAD SHX Text
Date:
Color:

FOR LOCATING & MARKING GAS, ELECTRIC,
WATER & TELEPHONE LINES

VAS
ELY

Subject:
Page Label: 1
Lock: Unlocked
Status:
Checkmark: Unchecked
Author: AutoCAD SHX Text
Date:
Color:

VAS

SI01

Subject:
Page Label: 1
Lock: Unlocked
Status:
Checkmark: Unchecked
Author: AutoCAD SHX Text
Date:
Color:

SI01

SIONS:
DATE:

Subject:
Page Label: 1
Lock: Unlocked
Status:
Checkmark: Unchecked
Author: AutoCAD SHX Text
Date:
Color:

DATE:

VAS
ELY
GW

Subject:
Page Label: 1
Lock: Unlocked
Status:
Checkmark: Unchecked
Author: AutoCAD SHX Text
Date:
Color:

ELY

STERLING
(FUTURE)
→ MARKSHFFF

Subject: (FUTURE)
Page Label: 1
Lock: Unlocked
Status:
Checkmark: Unchecked
Author: AutoCAD SHX Text
Date:
Color:

G

Subject: G
Page Label: 2
Lock: Unlocked
Status:
Checkmark: Unchecked
Author: AutoCAD SHX Text
Date:
Color:

2%

Subject: 2%
Page Label: 2
Lock: Unlocked
Status:
Checkmark: Unchecked
Author: AutoCAD SHX Text
Date:
Color:

NC
09-006
VAS
E V

Subject: 09-006
Page Label: 2
Lock: Unlocked
Status:
Checkmark: Unchecked
Author: AutoCAD SHX Text
Date:
Color:

3.0'

Subject: 3.0'
Page Label: 2
Lock: Unlocked
Status:
Checkmark: Unchecked
Author: AutoCAD SHX Text
Date:
Color:



Subject: FOR BURIED UTILITY INFORMATION
Page Label: 2
Lock: Unlocked
Status:
Checkmark: Unchecked
Author: AutoCAD SHX Text
Date:
Color:

PROJECT NO. 05
DESIGNED BY:
DRAWN BY:
CHECKED BY:

Subject:
Page Label: 2
Lock: Unlocked
Status:
Checkmark: Unchecked
Author: AutoCAD SHX Text
Date:
Color:

DESIGNED BY:

ROW

Subject:
Page Label: 2
Lock: Unlocked
Status:
Checkmark: Unchecked
Author: AutoCAD SHX Text
Date:
Color:

ROW

2.5' →

Subject:
Page Label: 2
Lock: Unlocked
Status:
Checkmark: Unchecked
Author: AutoCAD SHX Text
Date:
Color:

2.5'

REVISIONS:	
NO.	DATE:

Subject:
Page Label: 2
Lock: Unlocked
Status:
Checkmark: Unchecked
Author: AutoCAD SHX Text
Date:
Color:

REVISIONS:

REVISIONS:	
DATE:	

Subject:
Page Label: 2
Lock: Unlocked
Status:
Checkmark: Unchecked
Author: AutoCAD SHX Text
Date:
Color:

DATE:

UP

Subject:
Page Label: 2
Lock: Unlocked
Status:
Checkmark: Unchecked
Author: AutoCAD SHX Text
Date:
Color:

UP

BY:

Subject:
Page Label: 2
Lock: Unlocked
Status:
Checkmark: Unchecked
Author: AutoCAD SHX Text
Date:
Color:

BY:

5.0'

Subject:
Page Label: 2
Lock: Unlocked
Status:
Checkmark: Unchecked
Author: AutoCAD SHX Text
Date:
Color:

5.0'

SCALE:
HORIZONTAL:
N/A
VERTICAL:
N/A

Subject:
Page Label: 2
Lock: Unlocked
Status:
Checkmark: Unchecked
Author: AutoCAD SHX Text
Date:
Color:

VERTICAL:

2% TYP.

Subject:
Page Label: 2
Lock: Unlocked
Status:
Checkmark: Unchecked
Author: AutoCAD SHX Text
Date:
Color:

2% TYP.

RIZONT
N/A
ERTICA

Subject:
Page Label: 2
Lock: Unlocked
Status:
Checkmark: Unchecked
Author: AutoCAD SHX Text
Date:
Color:

N/A



Subject:
Page Label: 2
Lock: Unlocked
Status:
Checkmark: Unchecked
Author: AutoCAD SHX Text
Date:
Color:

CALL 1-800-922-1987

REF	NO.
-----	-----


Subject:
Page Label: 2
Lock: Unlocked
Status:
Checkmark: Unchecked
Author: AutoCAD SHX Text
Date:
Color:

NO.

3.0
UTILITY ESMT


Subject:
Page Label: 2
Lock: Unlocked
Status:
Checkmark: Unchecked
Author: AutoCAD SHX Text
Date:
Color:

UTILITY ESMT

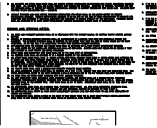


Subject:
Page Label: 2
Lock: Unlocked
Status:
Checkmark: Unchecked
Author: AutoCAD SHX Text
Date:
Color:

SIGNING AND STRIPING NOTES: : 1. ALL SIGNS AND PAVEMENT MARKINGS SHALL BE IN COMPLIANCE WITH THE CURRENT MANUAL ON UNIFORM TRAFFIC CONTROL DEVICES ALL SIGNS AND PAVEMENT MARKINGS SHALL BE IN COMPLIANCE WITH THE CURRENT MANUAL ON UNIFORM TRAFFIC CONTROL DEVICES (MUTCD). 2. REMOVAL OF EXISTING PAVEMENT MARKINGS SHALL BE ACCOMPLISHED BY A METHOD THAT DOES NOT MATERIALLY DAMAGE THE REMOVAL OF EXISTING PAVEMENT MARKINGS SHALL BE ACCOMPLISHED BY A METHOD THAT DOES NOT MATERIALLY DAMAGE THE PAVEMENT. THE PAVEMENT MARKINGS SHALL BE REMOVED TO THE EXTENT THAT THEY WILL NOT BE VISIBLE UNDER DAY OR NIGHT CONDITIONS. AT NO TIME WILL IT BE ACCEPTABLE TO PAINT OVER EXISTING PAVEMENT MARKINGS. 3. ANY DEVIATION FROM THE STRIPING AND SIGNING PLAN SHALL BE APPROVED BY EL PASO COUNTY DEVELOPMENT SERVICES. ANY DEVIATION FROM THE STRIPING AND SIGNING PLAN SHALL BE APPROVED BY EL PASO COUNTY DEVELOPMENT SERVICES. 4. ALL SIGNS SHOWN ON THE SIGNING AND STRIPING PLAN SHALL BE NEW SIGNS. EXISTING SIGNS MAY REMAIN OR BE REUSED IF THEY ALL SIGNS SHOWN ON THE SIGNING AND STRIPING PLAN SHALL BE NEW SIGNS. EXISTING SIGNS MAY REMAIN OR BE REUSED IF THEY MEET CURRENT EL PASO COUNTY AND MUTCD STANDARDS. 5. STREET NAME AND REGULATORY STOP SIGNS SHALL BE ON THE SAME POST AT INTERSECTIONS. STREET NAME AND REGULATORY STOP SIGNS SHALL BE ON THE SAME POST AT INTERSECTIONS. 6. ALL REMOVED SIGNS SHALL BE DISPOSED OF IN A PROPER MANNER BY THE CONTRACTOR. ALL REMOVED SIGNS SHALL BE DISPOSED OF IN A PROPER MANNER BY THE CONTRACTOR. 7. ALL STREET NAME SIGNS SHALL HAVE "D" SERIES LETTERS, WITH LOCAL ROADWAY SIGNS BEING 4" UPPER-LOWER CASE LETTERING ON ALL STREET NAME SIGNS SHALL HAVE "D" SERIES LETTERS, WITH LOCAL ROADWAY SIGNS BEING 4" UPPER-LOWER CASE LETTERING ON D" SERIES LETTERS, WITH LOCAL ROADWAY SIGNS BEING 4" UPPER-LOWER CASE LETTERING ON SERIES LETTERS, WITH LOCAL ROADWAY SIGNS BEING 4" UPPER-LOWER CASE LETTERING ON 8" BLANK AND NON-LOCAL ROADWAY SIGNS BEING 6" LETTERING, UPPER-LOWER CASE ON 12" BLANK, WITH A WHITE BORDER THAT IS BLANK AND NON-LOCAL ROADWAY SIGNS BEING 6" LETTERING, UPPER-LOWER CASE ON 12" BLANK, WITH A WHITE BORDER THAT IS LETTERING, UPPER-LOWER CASE ON 12" BLANK, WITH A WHITE BORDER THAT IS BLANK, WITH A WHITE BORDER THAT IS NOT RECESSED. MULTI-LANE ROADWAYS WITH SPEED LIMITS OF 40 MPH OR HIGHER SHALL HAVE 8" UPPER-LOWER CASE LETTERING ON UPPER-LOWER CASE LETTERING ON 18" BLANK WITH A WHITE BORDER THAT IS NOT RECESSED. THE WIDTH OF THE NON-RECESSED WHITE BORDERS SHALL

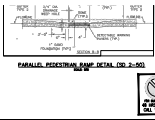

Subject:
Page Label: 2
Lock: Unlocked
Status:
Checkmark: Unchecked
Author: AutoCAD SHX Text
Date:
Color:

PARALLEL PEDESTRIAN RAMP DETAIL (SD 2-50) SCALE: NTS

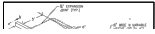

Subject:
Page Label: 2
Lock: Unlocked
Status:
Checkmark: Unchecked
Author: AutoCAD SHX Text
Date:
Color:

TYPICAL CROSS PAN LAYOUT DETAIL (SD 2-26) SCALE: NTS




Subject:
Page Label: 2
Lock: Unlocked
Status:
Checkmark: Unchecked
Author: AutoCAD SHX Text
Date:
Color:

SHEET 2 OF 8



Subject:
Page Label: 2
Lock: Unlocked
Status:
Checkmark: Unchecked
Author: AutoCAD SHX Text
Date:
Color:

CHECKED BY:

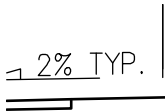


Subject:
Page Label: 2
Lock: Unlocked
Status:
Checkmark: Unchecked
Author: AutoCAD SHX Text
Date:
Color:

2% TYP.



Subject:
Page Label: 2
Lock: Unlocked
Status:
Checkmark: Unchecked
Author: AutoCAD SHX Text
Date:
Color:

HORIZONTAL:

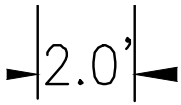

Subject: 2.0'
Page Label: 2
Lock: Unlocked
Status:
Checkmark: Unchecked
Author: AutoCAD SHX Text
Date:
Color:



Subject: THE ENGINEER PREPARING THESE PLANS
Page Label: 2 WILL NOT BE RESPONSIBLE, OR LIABLE FOR,
Lock: Unlocked UNAUTHORIZED CHANGES TO OR USES OF
Status: THESE PLANS. ALL CHANGES TO THE PLANS
Checkmark: Unchecked MUST BE IN WRITING AND MUST BE
Author: AutoCAD SHX Text APPROVED BY THE PREPARER OF THESE
Date: PLANS.
Color:



Subject: ST
Page Label: 2
Lock: Unlocked
Status:
Checkmark: Unchecked
Author: AutoCAD SHX Text
Date:
Color:




Subject: CAUTION
Page Label: 2
Lock: Unlocked
Status:
Checkmark: Unchecked
Author: AutoCAD SHX Text
Date:
Color:



Subject: W
Page Label: 2
Lock: Unlocked
Status:
Checkmark: Unchecked
Author: AutoCAD SHX Text
Date:
Color:



Subject: CATV
Page Label: 2
Lock: Unlocked
Status:
Checkmark: Unchecked
Author: AutoCAD SHX Text
Date:
Color:

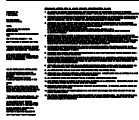

Subject:
Page Label: 2
Lock: Unlocked
Status:
Checkmark: Unchecked
Author: AutoCAD SHX Text
Date:
Color:

STANDARD NOTES FOR EL PASO COUNTY CONSTRUCTION PLANS 1. ALL DRAINAGE AND ROADWAY CONSTRUCTION SHALL MEET THE STANDARDS AND SPECIFICATIONS OF THE CITY OF COLORADO ALL DRAINAGE AND ROADWAY CONSTRUCTION SHALL MEET THE STANDARDS AND SPECIFICATIONS OF THE CITY OF COLORADO SPRINGS/EL PASO COUNTY DRAINAGE CRITERIA MANUAL, VOLUMES 1 AND 2, AND THE EL PASO COUNTY ENGINEERING CRITERIA MANUAL. 2. CONTRACTOR SHALL BE RESPONSIBLE FOR THE NOTIFICATION AND FIELD NOTIFICATION OF ALL EXISTING UTILITIES, WHETHER SHOWN ON CONTRACTOR SHALL BE RESPONSIBLE FOR THE NOTIFICATION AND FIELD NOTIFICATION OF ALL EXISTING UTILITIES, WHETHER SHOWN ON THE PLANS OR NOT, BEFORE BEGINNING CONSTRUCTION. LOCATION OF EXISTING UTILITIES SHALL BE VERIFIED BY THE CONTRACTOR PRIOR TO CONSTRUCTION. CALL 811 TO CONTACT THE UTILITY NOTIFICATION CENTER OF COLORADO (UNCC). 3. CONTRACTOR SHALL KEEP A COPY OF THESE APPROVED PLANS, THE GRADING AND EROSION CONTROL PLAN, THE STORMWATER CONTRACTOR SHALL KEEP A COPY OF THESE APPROVED PLANS, THE GRADING AND EROSION CONTROL PLAN, THE STORMWATER MANAGEMENT PLAN (SWMP), THE SOILS AND GEOTECHNICAL REPORT, AND THE APPROPRIATE DESIGN AND CONSTRUCTION STANDARDS AND SPECIFICATIONS AT THE JOB SITE AT ALL TIMES, INCLUDING THE FOLLOWING: a. EL PASO COUNTY ENGINEERING CRITERIA MANUAL (ECM) EL PASO COUNTY ENGINEERING CRITERIA MANUAL (ECM) b. CITY OF COLORADO SPRINGS/EL PASO COUNTY DRAINAGE CRITERIA MANUAL, VOLUMES 1 AND 2 CITY OF COLORADO SPRINGS/EL PASO COUNTY DRAINAGE CRITERIA MANUAL, VOLUMES 1 AND 2 c. COLORADO DEPARTMENT OF TRANSPORTATION (CDOT) STANDARD SPECIFICATIONS FOR ROAD AND BRIDGE CONSTRUCTION COLORADO DEPARTMENT OF TRANSPORTATION (CDOT) STANDARD SPECIFICATIONS FOR ROAD AND BRIDGE CONSTRUCTION d. CDOT M & S STANDARDS CDOT M & S STANDARDS 4. NOTWITHSTANDING ANYTHING DEPICTED IN THESE PLANS IN WORDS OR GRAPHIC REPRESENTATION, ALL DESIGN AND CONSTRUCTION NOTWITHSTANDING ANYTHING DEPICTED IN THESE PLANS IN WORDS OR GRAPHIC REPRESENTATION, ALL DESIGN AND CONSTRUCTION RELATED TO ROADS, STORM DRAINAGE AND EROSION CONTROL SHALL CONFORM TO THE STANDARDS AND REQUIREMENTS OF THE MOST RECENT VERSION OF THE RELEVANT ADOPTED EL PASO COUNTY STANDARDS, INCLUDING THE LAND DEVELOPMENT CODE, THE ENGINEERING CRITERIA MANUAL, THE DRAINAGE CRITERIA MANUAL, AND THE DRAINAGE CRITERIA MANUAL VOLUME 2. ANY DEVIATIONS FROM REGULATIONS AND STANDARDS MUST BE REQUESTED, AND APPROVED. IN WRITING. ANY

E & L
SCALE:
HORIZONTAL
N/A

Subject:
Page Label: 2
Lock: Unlocked
Status:
Checkmark: Unchecked
Author: AutoCAD SHX Text
Date:
Color:

SCALE:

ERTICA
N/A

Subject:
Page Label: 2
Lock: Unlocked
Status:
Checkmark: Unchecked
Author: AutoCAD SHX Text
Date:
Color:

N/A

—
—

Subject:
Page Label: 2
Lock: Unlocked
Status:
Checkmark: Unchecked
Author: AutoCAD SHX Text
Date:
Color:

L

—10.67'—

Subject:
Page Label: 2
Lock: Unlocked
Status:
Checkmark: Unchecked
Author: AutoCAD SHX Text
Date:
Color:

10.67'

←5.0'→
IT II IT V

Subject:
Page Label: 2
Lock: Unlocked
Status:
Checkmark: Unchecked
Author: AutoCAD SHX Text
Date:
Color:

5.0'

—
—


Subject:
Page Label: 2
Lock: Unlocked
Status:
Checkmark: Unchecked
Author: AutoCAD SHX Text
Date:
Color:

L

FOR AND ON
BEHALF OF
M&S CIVIL
CONSULTANTS,
INC.

Subject:
Page Label: 2
Lock: Unlocked
Status:
Checkmark: Unchecked
Author: AutoCAD SHX Text
Date:
Color:

FOR AND ON BEHALF OF M&S CIVIL
CONSULTANTS, INC.

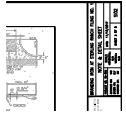


Subject:
Page Label: 2
Lock: Unlocked
Status:
Checkmark: Unchecked
Author: AutoCAD SHX Text
Date:
Color:

BRANDING IRON AT STERLING RANCH FILING
NO. 1

APRV'D. BY:	

Subject:
Page Label: 2
Lock: Unlocked
Status:
Checkmark: Unchecked
Author: AutoCAD SHX Text
Date:
Color:

APRV'D. BY:

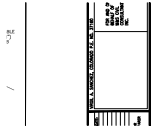

Subject:
Page Label: 2
Lock: Unlocked
Status:
Checkmark: Unchecked
Author: AutoCAD SHX Text
Date:
Color:

VIRGIL A. SANCHEZ, COLORADO P.E. NO.
37160

DATE:	

Subject:
Page Label: 2
Lock: Unlocked
Status:
Checkmark: Unchecked
Author: AutoCAD SHX Text
Date:
Color:

DATE:

DESCRIPTION:	

Subject:
Page Label: 2
Lock: Unlocked
Status:
Checkmark: Unchecked
Author: AutoCAD SHX Text
Date:
Color:

DESCRIPTION:

ELI
GW

Subject: GW
Page Label: 2
Lock: Unlocked
Status:
Checkmark: Unchecked
Author: AutoCAD SHX Text
Date:
Color:

TELE
CATV

Subject: TELE
Page Label: 2
Lock: Unlocked
Status:
Checkmark: Unchecked
Author: AutoCAD SHX Text
Date:
Color:

C

Subject: C
Page Label: 2
Lock: Unlocked
Status:
Checkmark: Unchecked
Author: AutoCAD SHX Text
Date:
Color:

2.5'

Subject: 2.5'
Page Label: 2
Lock: Unlocked
Status:
Checkmark: Unchecked
Author: AutoCAD SHX Text
Date:
Color:

PROJECT NO.
DESIGNED BY:
DRAWN BY:
CHECKED BY:

Subject: DRAWN BY:
Page Label: 2
Lock: Unlocked
Status:
Checkmark: Unchecked
Author: AutoCAD SHX Text
Date:
Color:

VAS
ELY

Subject: VAS
Page Label: 2
Lock: Unlocked
Status:
Checkmark: Unchecked
Author: AutoCAD SHX Text
Date:
Color:

AL CRO:

SCALE: NTS

Subject:
Page Label: 2
Lock: Unlocked
Status:
Checkmark: Unchecked
Author: AutoCAD SHX Text
Date:
Color:

SCALE: NTS

S102

Subject:
Page Label: 2
Lock: Unlocked
Status:
Checkmark: Unchecked
Author: AutoCAD SHX Text
Date:
Color:

S102




Subject:
Page Label: 2
Lock: Unlocked
Status:
Checkmark: Unchecked
Author: AutoCAD SHX Text
Date:
Color:

GENERAL CONSTRUCTION NOTES: 1. IT SHALL BE THE RESPONSIBILITY OF THE CONTRACTOR TO VERIFY THE EXISTENCE AND LOCATION OF ALL IT SHALL BE THE RESPONSIBILITY OF THE CONTRACTOR TO VERIFY THE EXISTENCE AND LOCATION OF ALL UNDERGROUND UTILITIES ALONG THE ROUTE OF THE WORK. THE OMISSION FROM OR THE INCLUSION OF UTILITY LOCATIONS ON THE PLANS IS NOT TO BE CONSIDERED AS THE NONEXISTENCE OF OR A DEFINITE LOCATION OF EXISTING UNDERGROUND UTILITIES. 2. THE CONTRACTOR WILL TAKE THE NECESSARY PRECAUTIONS TO PROTECT EXISTING UTILITIES FROM DAMAGE THE CONTRACTOR WILL TAKE THE NECESSARY PRECAUTIONS TO PROTECT EXISTING UTILITIES FROM DAMAGE DUE TO THIS OPERATION. ANY DAMAGE TO THE UTILITIES WILL BE REPAIRED AT THE CONTRACTOR'S EXPENSE, AND ANY SERVICE DISRUPTION WILL BE SETTLED BY THE CONTRACTOR. 3. ADDITIONAL EROSION CONTROL STRUCTURES MAY BE REQUIRED AT THE TIME OF CONSTRUCTION. ADDITIONAL EROSION CONTROL STRUCTURES MAY BE REQUIRED AT THE TIME OF CONSTRUCTION. 4. ALL BACKFILL, SUB-BASE, AND/OR BASE COURSE (CLASS 6) MATERIAL SHALL BE COMPACTED PER THE SOILS ENGINEER'S ALL BACKFILL, SUB-BASE, AND/OR BASE COURSE (CLASS 6) MATERIAL SHALL BE COMPACTED PER THE SOILS ENGINEER'S RECOMMENDATIONS, AND APPROVED BY EL PASO COUNTY DEVELOPMENT SERVICES ENGINEERING DIVISION. 5. ALL STATIONING IS CENTERLINE OF IMPROVEMENTS UNLESS OTHERWISE INDICATED. ALL ELEVATIONS ARE FLOW LINE UNLESS OTHERWISE ALL STATIONING IS CENTERLINE OF IMPROVEMENTS UNLESS OTHERWISE INDICATED. ALL ELEVATIONS ARE FLOW LINE UNLESS OTHERWISE INDICATED AS TOP BACK OF CURB (TBC), ASPHALT (ASP), OR TOP OF INLET OR BOX (TOB). 6. ALL DISTURBED PAVEMENT EDGES SHALL BE CUT TO NEAT LINES. REPAIR SHALL CONFORM TO EPC ECM APPENDIX K - 1.2C. ALL DISTURBED PAVEMENT EDGES SHALL BE CUT TO NEAT LINES. REPAIR SHALL CONFORM TO EPC ECM APPENDIX K - 1.2C. 7. ALL INTERSECTION ACCESSES TO BE CONSTRUCTED WITH A 25 FOOT SIGHT VISIBILITY TRIANGLES IS REQUIRED AND THERE ALL INTERSECTION ACCESSES TO BE CONSTRUCTED WITH A 25 FOOT SIGHT VISIBILITY TRIANGLES IS REQUIRED AND THERE SHALL BE NO OBSTRUCTIONS GREATER THAN 18" VERTICAL IN THIS AREA. . 8. ALL CULVERTS AND STORM DRAIN PIPES SHALL BE SMOOTH INTERIOR CORRUGATED POLYETHYLENE PIPE (HDPE), REINFORCED CONCRETE ALL CULVERTS AND STORM DRAIN PIPES SHALL BE SMOOTH INTERIOR CORRUGATED POLYETHYLENE PIPE (HDPE), REINFORCED CONCRETE PIPE (RCP). ALL CULVERTS SHALL BE PLACED COMPLETE WITH FLARED END SECTIONS. ADEQUACY OF MATERIAL THICKNESS FOR ANY CSP INSTALLED SHALL BE VERIFIED BY OWNER'S GEOTECHNICAL ENGINEER TO SUPPORT



Subject:
Page Label: 2
Lock: Unlocked
Status:
Checkmark: Unchecked
Author: AutoCAD SHX Text
Date:
Color:

File: O:\09006A\Sterling Ranch No 3\dwg\Const
 Dwg\Street Plans\Residential\SI02.dwg
 Plotstamp: 11/6/2017 1:27 PM

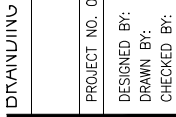

Subject:
Page Label: 2
Lock: Unlocked
Status:
Checkmark: Unchecked
Author: AutoCAD SHX Text
Date:
Color:

PROJECT NO.



Subject:
Page Label: 2
Lock: Unlocked
Status:
Checkmark: Unchecked
Author: AutoCAD SHX Text
Date:
Color:

UTILITY ESMT



Subject:
Page Label: 2
Lock: Unlocked
Status:
Checkmark: Unchecked
Author: AutoCAD SHX Text
Date:
Color:

PEDESTRIAN INTERSECTION RAMP (SD 2-41)
 SCALE: NTS



Subject:
Page Label: 2
Lock: Unlocked
Status:
Checkmark: Unchecked
Author: AutoCAD SHX Text
Date:
Color:

URBAN LOCAL CROSS SECTION



Subject:
Page Label: 2
Lock: Unlocked
Status:
Checkmark: Unchecked
Author: AutoCAD SHX Text
Date:
Color:

FOR LOCATING & MARKING GAS, ELECTRIC,
 WATER & TELEPHONE LINES

30' PAVEMENT

Subject: 30' PAVEMENT
Page Label: 2
Lock: Unlocked
Status:
Checkmark: Unchecked
Author: AutoCAD SHX Text
Date:
Color:

ROW

Subject: ROW
Page Label: 2
Lock: Unlocked
Status:
Checkmark: Unchecked
Author: AutoCAD SHX Text
Date:
Color:

EPC TYPE A CURB & GUTTER

Subject: EPC TYPE A CURB & GUTTER
Page Label: 2
Lock: Unlocked
Status:
Checkmark: Unchecked
Author: AutoCAD SHX Text
Date:
Color:

Subject: NOTE & DETAIL SHEET
Page Label: 2
Lock: Unlocked
Status:
Checkmark: Unchecked
Author: AutoCAD SHX Text
Date:
Color:

VAS
ELY
GW

Subject: ELY
Page Label: 2
Lock: Unlocked
Status:
Checkmark: Unchecked
Author: AutoCAD SHX Text
Date:
Color:

2%

Subject: 2%
Page Label: 2
Lock: Unlocked
Status:
Checkmark: Unchecked
Author: AutoCAD SHX Text
Date:
Color:

5' ATTACHED SIDEWALK
BOTH SIDES

Subject:
Page Label: 2
Lock: Unlocked
Status:
Checkmark: Unchecked
Author: AutoCAD SHX Text
Date:
Color:

5' ATTACHED SIDEWALK BOTH SIDES




Subject:
Page Label: 2
Lock: Unlocked
Status:
Checkmark: Unchecked
Author: AutoCAD SHX Text
Date:
Color:

SS

KRANCH FILIN
SHEET
11/10/2017
1 OF 8


Subject:
Page Label: 2
Lock: Unlocked
Status:
Checkmark: Unchecked
Author: AutoCAD SHX Text
Date:
Color:

11/10/2017

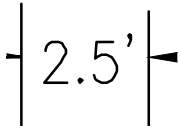

Subject:
Page Label: 2
Lock: Unlocked
Status:
Checkmark: Unchecked
Author: AutoCAD SHX Text
Date:
Color:

2.5'

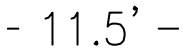

Subject:
Page Label: 2
Lock: Unlocked
Status:
Checkmark: Unchecked
Author: AutoCAD SHX Text
Date:
Color:

11.5'



Subject:
Page Label: 2
Lock: Unlocked
Status:
Checkmark: Unchecked
Author: AutoCAD SHX Text
Date:
Color:

C



Subject:
Page Label: 2
Lock: Unlocked
Status:
Checkmark: Unchecked
Author: AutoCAD SHX Text
Date:
Color:

48 HRS BEFORE YOU DIG

50' R.O.W.

Subject:
Page Label: 2
Lock: Unlocked
Status:
Checkmark: Unchecked
Author: AutoCAD SHX Text
Date:
Color:

50' R.O.W.

DATE:

Subject:
Page Label: 2
Lock: Unlocked
Status:
Checkmark: Unchecked
Author: AutoCAD SHX Text
Date:
Color:

DATE:

FOR AND ON BEHALF OF M&S CIVIL CONSULTANTS, INC.

Subject:
Page Label: 3
Lock: Unlocked
Status:
Checkmark: Unchecked
Author: AutoCAD SHX Text
Date:
Color:

FOR AND ON BEHALF OF M&S CIVIL CONSULTANTS, INC.

3+00

Subject:
Page Label: 3
Lock: Unlocked
Status:
Checkmark: Unchecked
Author: AutoCAD SHX Text
Date:
Color:

3+00

7065

Subject:
Page Label: 3
Lock: Unlocked
Status:
Checkmark: Unchecked
Author: AutoCAD SHX Text
Date:
Color:

7065

51

Subject:
Page Label: 3
Lock: Unlocked
Status:
Checkmark: Unchecked
Author: AutoCAD SHX Text
Date:
Color:

51

5	ET	RT	35	CR	RT	TRACT 'Q'
---	----	----	----	----	----	-----------

Subject:
Page Label: 3
Lock: Unlocked
Status:
Checkmark: Unchecked
Author: AutoCAD SHX Text
Date:
Color:

TRACT 'Q'

TRACT 'G'

Subject:
Page Label: 3
Lock: Unlocked
Status:
Checkmark: Unchecked
Author: AutoCAD SHX Text
Date:
Color:

TRACT 'G'

46

Subject:
Page Label: 3
Lock: Unlocked
Status:
Checkmark: Unchecked
Author: AutoCAD SHX Text
Date:
Color:

46

REVISIONS:	NO.	DATE:			
------------	-----	-------	--	--	--


Subject:
Page Label: 3
Lock: Unlocked
Status:
Checkmark: Unchecked
Author: AutoCAD SHX Text
Date:
Color:

REVISIONS:

TRACT 'K'

Subject:
Page Label: 3
Lock: Unlocked
Status:
Checkmark: Unchecked
Author: AutoCAD SHX Text
Date:
Color:

TRACT 'K'

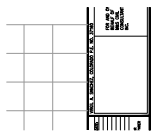

Subject:
Page Label: 3
Lock: Unlocked
Status:
Checkmark: Unchecked
Author: AutoCAD SHX Text
Date:
Color:

VIRGIL A. SANCHEZ, COLORADO P.E. NO.
37160

1" =

Subject:
Page Label: 3
Lock: Unlocked
Status:
Checkmark: Unchecked
Author: AutoCAD SHX Text
Date:
Color:

1" =

35

Subject:
Page Label: 3
Lock: Unlocked
Status:
Checkmark: Unchecked
Author: AutoCAD SHX Text
Date:
Color:

35

2011

Subject:
Page Label: 3
Lock: Unlocked
Status:
Checkmark: Unchecked
Author: AutoCAD SHX Text
Date:
Color:

U

50

Subject:
Page Label: 3
Lock: Unlocked
Status:
Checkmark: Unchecked
Author: AutoCAD SHX Text
Date:
Color:

50

5/11

Subject:
Page Label: 3
Lock: Unlocked
Status:
Checkmark: Unchecked
Author: AutoCAD SHX Text
Date:
Color:

T

T/A

Subject:
Page Label: 3
Lock: Unlocked
Status:
Checkmark: Unchecked
Author: AutoCAD SHX Text
Date:
Color:

I

39

Subject:
Page Label: 3
Lock: Unlocked
Status:
Checkmark: Unchecked
Author: AutoCAD SHX Text
Date:
Color:

39

42

Subject:
Page Label: 3
Lock: Unlocked
Status:
Checkmark: Unchecked
Author: AutoCAD SHX Text
Date:
Color:

42

D/A

Subject:
Page Label: 3
Lock: Unlocked
Status:
Checkmark: Unchecked
Author: AutoCAD SHX Text
Date:
Color:

I

EXI

Subject:
Page Label: 3
Lock: Unlocked
Status:
Checkmark: Unchecked
Author: AutoCAD SHX Text
Date:
Color:

X

ABBREVIATION LEGEND
I-I CENTERLINE INTERSECTION
F-F FLOWLINE INTERSECTION
B-T BEGIN TRANSITION
BT BEGIN TRANSITION
ET END TRANSITION
PC POINT OF CURVE
PCC POINT OF COMPOUND CURVE
PCR POINT OF CURB RETURB
PRC POINT OF REVERSE CURVE
PT POINT OF TANGENT
EL ELEVATION
LT LEFT
RT RIGHT


Subject:
Page Label: 3
Lock: Unlocked
Status:
Checkmark: Unchecked
Author: AutoCAD SHX Text
Date:
Color:

ABBREVIATION LEGEND - CENTERLINE INTERSECTION CENTERLINE INTERSECTION - FLOWLINE INTERSECTION - FLOWLINE INTERSECTION FLOWLINE INTERSECTION FLOWLINE INTERSECTION BT BEGIN TRANSITION BEGIN TRANSITION ET END TRANSITION END TRANSITION PC POINT OF CURVE POINT OF CURVE PCC POINT OF COMPOUND CURVE POINT OF COMPOUND CURVE PCR POINT OF CURB RETURB POINT OF CURB RETURB PRC POINT OF REVERSE CURVE POINT OF REVERSE CURVE PT POINT OF TANGENT POINT OF TANGENT EL ELEVATION ELEVATION LT LEFT LEFT RT RIGHTRIGHT

7060

Subject:
Page Label: 3
Lock: Unlocked
Status:
Checkmark: Unchecked
Author: AutoCAD SHX Text
Date:
Color:

7060

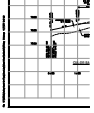


Subject:
Page Label: 3
Lock: Unlocked
Status:
Checkmark: Unchecked
Author: AutoCAD SHX Text
Date:
Color:

File: O:\09006A\Sterling Ranch No 3\dwg\Const
Dwg\Street Plans\Residential\SI03.dwg
Plotstamp: 11/7/2017 9:43 AM

DATE:

Subject:
Page Label: 3
Lock: Unlocked
Status:
Checkmark: Unchecked
Author: AutoCAD SHX Text
Date:
Color:

DATE:

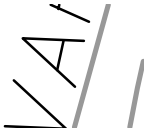

Subject:
Page Label: 3
Lock: Unlocked
Status:
Checkmark: Unchecked
Author: AutoCAD SHX Text
Date:
Color:

A

PROJECT NO. 0:
DESIGNED BY:
DRAWN BY:
CHECKED BY:


Subject:
Page Label: 3
Lock: Unlocked
Status:
Checkmark: Unchecked
Author: AutoCAD SHX Text
Date:
Color:

CHECKED BY:

7055

Subject:
Page Label: 3
Lock: Unlocked
Status:
Checkmark: Unchecked
Author: AutoCAD SHX Text
Date:
Color:

7055

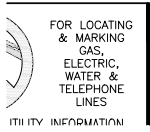

Subject:
Page Label: 3
Lock: Unlocked
Status:
Checkmark: Unchecked
Author: AutoCAD SHX Text
Date:
Color:

FOR LOCATING & MARKING GAS, ELECTRIC,
WATER & TELEPHONE LINES

49


Subject:
Page Label: 3
Lock: Unlocked
Status:
Checkmark: Unchecked
Author: AutoCAD SHX Text
Date:
Color:

49

7065

Subject:
Page Label: 3
Lock: Unlocked
Status:
Checkmark: Unchecked
Author: AutoCAD SHX Text
Date:
Color:

7065

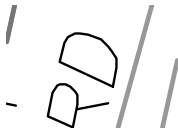


Subject:
Page Label: 3
Lock: Unlocked
Status:
Checkmark: Unchecked
Author: AutoCAD SHX Text
Date:
Color:

D

7055


Subject:
Page Label: 3
Lock: Unlocked
Status:
Checkmark: Unchecked
Author: AutoCAD SHX Text
Date:
Color:

7055

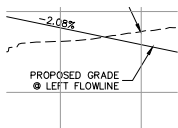

Subject:
Page Label: 3
Lock: Unlocked
Status:
Checkmark: Unchecked
Author: AutoCAD SHX Text
Date:
Color:

PROPOSED GRADE @ LEFT FLOWLINE

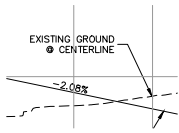

Subject:
Page Label: 3
Lock: Unlocked
Status:
Checkmark: Unchecked
Author: AutoCAD SHX Text
Date:
Color:

EXISTING GROUND @ CENTERLINE



Subject:
Page Label: 3
Lock: Unlocked
Status:
Checkmark: Unchecked
Author: AutoCAD SHX Text
Date:
Color:

CALL 1-800-922-1987

40

Subject:
Page Label: 3
Lock: Unlocked
Status:
Checkmark: Unchecked
Author: AutoCAD SHX Text
Date:
Color:

40

47

Subject:
Page Label: 3
Lock: Unlocked
Status:
Checkmark: Unchecked
Author: AutoCAD SHX Text
Date:
Color:

47

7060

Subject:
Page Label: 3
Lock: Unlocked
Status:
Checkmark: Unchecked
Author: AutoCAD SHX Text
Date:
Color:

7060

ARL

Subject:
Page Label: 3
Lock: Unlocked
Status:
Checkmark: Unchecked
Author: AutoCAD SHX Text
Date:
Color:

R

VAS
ELY
GW


Subject:
Page Label: 3
Lock: Unlocked
Status:
Checkmark: Unchecked
Author: AutoCAD SHX Text
Date:
Color:

ELY

VEMENT PLAN
DATE: 11/10/201
SHEET 3 OF 8

Subject:
Page Label: 3
Lock: Unlocked
Status:
Checkmark: Unchecked
Author: AutoCAD SHX Text
Date:
Color:

SHEET 3 OF 8

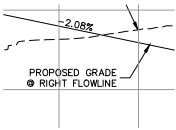


Subject:
Page Label: 3
Lock: Unlocked
Status:
Checkmark: Unchecked
Author: AutoCAD SHX Text
Date:
Color:

PROPOSED GRADE @ RIGHT FLOWLINE

7065

Subject:
Page Label: 3
Lock: Unlocked
Status:
Checkmark: Unchecked
Author: AutoCAD SHX Text
Date:
Color:

7065

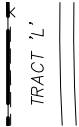

Subject:
Page Label: 3
Lock: Unlocked
Status:
Checkmark: Unchecked
Author: AutoCAD SHX Text
Date:
Color:

TRACT 'L'

SCALE:
HORIZONTAL:
1"=50'
VERTICAL:
1"=5'

Subject:
Page Label: 3
Lock: Unlocked
Status:
Checkmark: Unchecked
Author: AutoCAD SHX Text
Date:
Color:

VERTICAL:

0+00

Subject: 0+00
Page Label: 3
Lock: Unlocked
Status:
Checkmark: Unchecked
Author: AutoCAD SHX Text
Date:
Color:

38

Subject: 38
Page Label: 3
Lock: Unlocked
Status:
Checkmark: Unchecked
Author: AutoCAD SHX Text
Date:
Color:

DYANJING
PROJECT NO. 0
DESIGNED BY:
DRAWN BY:
CHECKED BY:

Subject: PROJECT NO.
Page Label: 3
Lock: Unlocked
Status:
Checkmark: Unchecked
Author: AutoCAD SHX Text
Date:
Color:

0+00


Subject: 0+00
Page Label: 3
Lock: Unlocked
Status:
Checkmark: Unchecked
Author: AutoCAD SHX Text
Date:
Color:

FUTURE GRADE @ RIGHT FLOWLINE

Subject: FUTURE GRADE @ RIGHT FLOWLINE
Page Label: 3
Lock: Unlocked
Status:
Checkmark: Unchecked
Author: AutoCAD SHX Text
Date:
Color:

V

Subject: V
Page Label: 3
Lock: Unlocked
Status:
Checkmark: Unchecked
Author: AutoCAD SHX Text
Date:
Color:

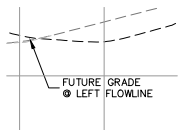

Subject:
Page Label: 3
Lock: Unlocked
Status:
Checkmark: Unchecked
Author: AutoCAD SHX Text
Date:
Color:

FUTURE GRADE @ LEFT FLOWLINE

STREET
09-006
VAS
E1 V


Subject:
Page Label: 3
Lock: Unlocked
Status:
Checkmark: Unchecked
Author: AutoCAD SHX Text
Date:
Color:

09-006



Subject:
Page Label: 3
Lock: Unlocked
Status:
Checkmark: Unchecked
Author: AutoCAD SHX Text
Date:
Color:

S

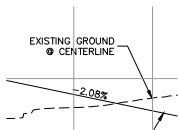

Subject:
Page Label: 3
Lock: Unlocked
Status:
Checkmark: Unchecked
Author: AutoCAD SHX Text
Date:
Color:

EXISTING GROUND @ CENTERLINE

50


Subject:
Page Label: 3
Lock: Unlocked
Status:
Checkmark: Unchecked
Author: AutoCAD SHX Text
Date:
Color:

50

7065

Subject:
Page Label: 3
Lock: Unlocked
Status:
Checkmark: Unchecked
Author: AutoCAD SHX Text
Date:
Color:

7065

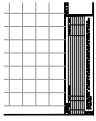

Subject:
Page Label: 3
Lock: Unlocked
Status:
Checkmark: Unchecked
Author: AutoCAD SHX Text
Date:
Color:

THE ENGINEER PREPARING THESE PLANS
 WILL NOT BE RESPONSIBLE, OR LIABLE FOR,
 UNAUTHORIZED CHANGES TO OR USES OF
 THESE PLANS. ALL CHANGES TO THE PLANS
 MUST BE IN WRITING AND MUST BE
 APPROVED BY THE PREPARER OF THESE
 PLANS.




Subject:
Page Label: 3
Lock: Unlocked
Status:
Checkmark: Unchecked
Author: AutoCAD SHX Text
Date:
Color:

N



Subject:
Page Label: 3
Lock: Unlocked
Status:
Checkmark: Unchecked
Author: AutoCAD SHX Text
Date:
Color:

SCALE:

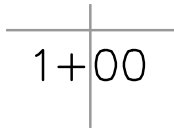

Subject:
Page Label: 3
Lock: Unlocked
Status:
Checkmark: Unchecked
Author: AutoCAD SHX Text
Date:
Color:

1+00

25

Subject:
Page Label: 3
Lock: Unlocked
Status:
Checkmark: Unchecked
Author: AutoCAD SHX Text
Date:
Color:

25




Subject:
Page Label: 3
Lock: Unlocked
Status:
Checkmark: Unchecked
Author: AutoCAD SHX Text
Date:
Color:

STREET IMPROVEMENT PLANS



Subject:
Page Label: 3
Lock: Unlocked
Status:
Checkmark: Unchecked
Author: AutoCAD SHX Text
Date:
Color:

48 HRS BEFORE YOU DIG

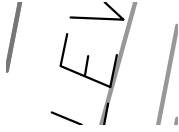


Subject:
Page Label: 3
Lock: Unlocked
Status:
Checkmark: Unchecked
Author: AutoCAD SHX Text
Date:
Color:

E



Subject:
Page Label: 3
Lock: Unlocked
Status:
Checkmark: Unchecked
Author: AutoCAD SHX Text
Date:
Color:

DATE:

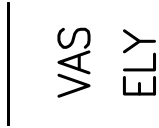

Subject:
Page Label: 3
Lock: Unlocked
Status:
Checkmark: Unchecked
Author: AutoCAD SHX Text
Date:
Color:

VAS



Subject:
Page Label: 3
Lock: Unlocked
Status:
Checkmark: Unchecked
Author: AutoCAD SHX Text
Date:
Color:

44

SCALE:
 HORIZONTAL
 1"=50'
 VERTICAL:
 1"=5'

Subject:
Page Label: 3
Lock: Unlocked
Status:
Checkmark: Unchecked
Author: AutoCAD SHX Text
Date:
Color:

1"=50'

VG

Subject:
Page Label: 3
Lock: Unlocked
Status:
Checkmark: Unchecked
Author: AutoCAD SHX Text
Date:
Color:

G

RANCH FILIN
ENT PLANS
11/10/2017
SET 3 OF 8

Subject:
Page Label: 3
Lock: Unlocked
Status:
Checkmark: Unchecked
Author: AutoCAD SHX Text
Date:
Color:

11/10/2017

VECS

Subject:
Page Label: 3
Lock: Unlocked
Status:
Checkmark: Unchecked
Author: AutoCAD SHX Text
Date:
Color:

E

05
TRACT 'P'
21+00

Subject:
Page Label: 3
Lock: Unlocked
Status:
Checkmark: Unchecked
Author: AutoCAD SHX Text
Date:
Color:

TRACT 'P'

TRACT 'F'

Subject:
Page Label: 3
Lock: Unlocked
Status:
Checkmark: Unchecked
Author: AutoCAD SHX Text
Date:
Color:

TRACT 'F'

REI
NO.

Subject:
Page Label: 3
Lock: Unlocked
Status:
Checkmark: Unchecked
Author: AutoCAD SHX Text
Date:
Color:

NO.

25 50
Scale in Feet

Subject:
Page Label: 3
Lock: Unlocked
Status:
Checkmark: Unchecked
Author: AutoCAD SHX Text
Date:
Color:

Scale in Feet

41

Subject:
Page Label: 3
Lock: Unlocked
Status:
Checkmark: Unchecked
Author: AutoCAD SHX Text
Date:
Color:

41

D/

Subject:
Page Label: 3
Lock: Unlocked
Status:
Checkmark: Unchecked
Author: AutoCAD SHX Text
Date:
Color:

D

B

Subject:
Page Label: 3
Lock: Unlocked
Status:
Checkmark: Unchecked
Author: AutoCAD SHX Text
Date:
Color:

B

7055

Subject:
Page Label: 3
Lock: Unlocked
Status:
Checkmark: Unchecked
Author: AutoCAD SHX Text
Date:
Color:

7055

7065

Subject:
Page Label: 3
Lock: Unlocked
Status:
Checkmark: Unchecked
Author: AutoCAD SHX Text
Date:
Color:

7065

7060

Subject:
Page Label: 3
Lock: Unlocked
Status:
Checkmark: Unchecked
Author: AutoCAD SHX Text
Date:
Color:

7060

S
PROJECT NO.: 02
DESIGNED BY:
DRAWN BY:
CHECKED BY:

Subject:
Page Label: 3
Lock: Unlocked
Status:
Checkmark: Unchecked
Author: AutoCAD SHX Text
Date:
Color:

DESIGNED BY:

2+00

Subject:
Page Label: 3
Lock: Unlocked
Status:
Checkmark: Unchecked
Author: AutoCAD SHX Text
Date:
Color:

2+00

7055

Subject:
Page Label: 3
Lock: Unlocked
Status:
Checkmark: Unchecked
Author: AutoCAD SHX Text
Date:
Color:

7055

ET IMPROV
SCALE:
HORIZONTAL:
1"=50'
VERTICAL:
1"=5'

Subject:
Page Label: 3
Lock: Unlocked
Status:
Checkmark: Unchecked
Author: AutoCAD SHX Text
Date:
Color:

HORIZONTAL:

|||
D/INE
|||

Subject:
Page Label: 3
Lock: Unlocked
Status:
Checkmark: Unchecked
Author: AutoCAD SHX Text
Date:
Color:

N

CAUTION

Subject: CAUTION
Page Label: 3
Lock: Unlocked
Status:
Checkmark: Unchecked
Author: AutoCAD SHX Text
Date:
Color:

BY:

Subject: BY:
Page Label: 3
Lock: Unlocked
Status:
Checkmark: Unchecked
Author: AutoCAD SHX Text
Date:
Color:

7060

Subject: 7060
Page Label: 3
Lock: Unlocked
Status:
Checkmark: Unchecked
Author: AutoCAD SHX Text
Date:
Color:

VERTICAL
1"=5'

Subject: 1"=5'
Page Label: 3
Lock: Unlocked
Status:
Checkmark: Unchecked
Author: AutoCAD SHX Text
Date:
Color:

1+00

Subject: 1+00
Page Label: 3
Lock: Unlocked
Status:
Checkmark: Unchecked
Author: AutoCAD SHX Text
Date:
Color:

0

Subject: 0
Page Label: 3
Lock: Unlocked
Status:
Checkmark: Unchecked
Author: AutoCAD SHX Text
Date:
Color:

4+00

Subject: 4+00
Page Label: 3
Lock: Unlocked
Status:
Checkmark: Unchecked
Author: AutoCAD SHX Text
Date:
Color:

SI03

Subject: SI03
Page Label: 3
Lock: Unlocked
Status:
Checkmark: Unchecked
Author: AutoCAD SHX Text
Date:
Color:

43

Subject: 43
Page Label: 3
Lock: Unlocked
Status:
Checkmark: Unchecked
Author: AutoCAD SHX Text
Date:
Color:

2+00
STA 01

Subject: 2+00
Page Label: 3
Lock: Unlocked
Status:
Checkmark: Unchecked
Author: AutoCAD SHX Text
Date:
Color:

SI

Subject: S
Page Label: 3
Lock: Unlocked
Status:
Checkmark: Unchecked
Author: AutoCAD SHX Text
Date:
Color:

EL=70
TRACT 'Y'


Subject: TRACT 'Y'
Page Label: 3
Lock: Unlocked
Status:
Checkmark: Unchecked
Author: AutoCAD SHX Text
Date:
Color:

100

Subject: 100
Page Label: 3
Lock: Unlocked
Status:
Checkmark: Unchecked
Author: AutoCAD SHX Text
Date:
Color:



Subject: FOR BURIED UTILITY INFORMATION
Page Label: 3
Lock: Unlocked
Status:
Checkmark: Unchecked
Author: AutoCAD SHX Text
Date:
Color:

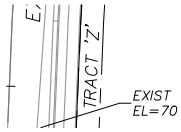


Subject: TRACT 'Z'
Page Label: 3
Lock: Unlocked
Status:
Checkmark: Unchecked
Author: AutoCAD SHX Text
Date:
Color:

45

Subject: 45
Page Label: 3
Lock: Unlocked
Status:
Checkmark: Unchecked
Author: AutoCAD SHX Text
Date:
Color:

ELL
GW

Subject: GW
Page Label: 3
Lock: Unlocked
Status:
Checkmark: Unchecked
Author: AutoCAD SHX Text
Date:
Color:

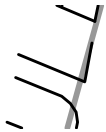

Subject: L
Page Label: 3
Lock: Unlocked
Status:
Checkmark: Unchecked
Author: AutoCAD SHX Text
Date:
Color:

48


Subject:
Page Label: 3
Lock: Unlocked
Status:
Checkmark: Unchecked
Author: AutoCAD SHX Text
Date:
Color:

48

7060

Subject:
Page Label: 3
Lock: Unlocked
Status:
Checkmark: Unchecked
Author: AutoCAD SHX Text
Date:
Color:

7060

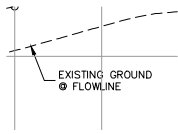

Subject:
Page Label: 3
Lock: Unlocked
Status:
Checkmark: Unchecked
Author: AutoCAD SHX Text
Date:
Color:

EXISTING GROUND @ FLOWLINE



Subject:
Page Label: 3
Lock: Unlocked
Status:
Checkmark: Unchecked
Author: AutoCAD SHX Text
Date:
Color:

0

7055


Subject:
Page Label: 3
Lock: Unlocked
Status:
Checkmark: Unchecked
Author: AutoCAD SHX Text
Date:
Color:

7055

RT RIGHT
STREET ABBREVIATIONS
KC KINTLA COURT
LGW LODGE GRASS WAY
MW MOSBY WAY
SW SPRAGUE WAY
WW WHITEFISH WAY
DB DINES BOULEVARD (EX.)
CDS CUL-DE-SAC

Subject:
Page Label: 3
Lock: Unlocked
Status:
Checkmark: Unchecked
Author: AutoCAD SHX Text
Date:
Color:

STREET ABBREVIATIONS KC KINTLA COURT
KINTLA COURT LGW LODGE GRASS WAY
LODGE GRASS WAY MW MOSBY WAY MOSBY
WAY SW SPRAGUE WAY SPRAGUE WAY
WW WHITEFISH WAY WHITEFISH WAY
DB DINES BOULEVARD (EX.) DINES
BOULEVARD (EX.)
CDS CUL-DE-SACCUL-DE-SAC

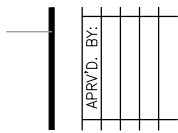


Subject:
Page Label: 3
Lock: Unlocked
Status:
Checkmark: Unchecked
Author: AutoCAD SHX Text
Date:
Color:

APRV'D. BY:



Subject:
Page Label: 3
Lock: Unlocked
Status:
Checkmark: Unchecked
Author: AutoCAD SHX Text
Date:
Color:

DATE:

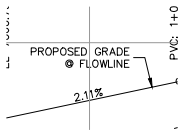

Subject:
Page Label: 3
Lock: Unlocked
Status:
Checkmark: Unchecked
Author: AutoCAD SHX Text
Date:
Color:

PROPOSED GRADE @ FLOWLINE



Subject:
Page Label: 3
Lock: Unlocked
Status:
Checkmark: Unchecked
Author: AutoCAD SHX Text
Date:
Color:

I



Subject:
Page Label: 3
Lock: Unlocked
Status:
Checkmark: Unchecked
Author: AutoCAD SHX Text
Date:
Color:

E



Subject:
Page Label: 3
Lock: Unlocked
Status:
Checkmark: Unchecked
Author: AutoCAD SHX Text
Date:
Color:

BRANDING IRON AT STERLING RANCH FILING NO. 1

7055

Subject: 7055
Page Label: 3
Lock: Unlocked
Status:
Checkmark: Unchecked
Author: AutoCAD SHX Text
Date:
Color:

37

Subject: 37
Page Label: 3
Lock: Unlocked
Status:
Checkmark: Unchecked
Author: AutoCAD SHX Text
Date:
Color:

50'

Subject: 50'
Page Label: 3
Lock: Unlocked
Status:
Checkmark: Unchecked
Author: AutoCAD SHX Text
Date:
Color:

7060

Subject: 7060
Page Label: 3
Lock: Unlocked
Status:
Checkmark: Unchecked
Author: AutoCAD SHX Text
Date:
Color:

3+00

Subject: 3+00
Page Label: 3
Lock: Unlocked
Status:
Checkmark: Unchecked
Author: AutoCAD SHX Text
Date:
Color:

36

Subject: 36
Page Label: 3
Lock: Unlocked
Status:
Checkmark: Unchecked
Author: AutoCAD SHX Text
Date:
Color:

DESCRIPTION:

Subject:
Page Label: 3
Lock: Unlocked
Status:
Checkmark: Unchecked
Author: AutoCAD SHX Text
Date:
Color:

DESCRIPTION:

PROJECT NO.
DESIGNED BY
DRAWN BY:
CHECKED BY:

Subject:
Page Label: 3
Lock: Unlocked
Status:
Checkmark: Unchecked
Author: AutoCAD SHX Text
Date:
Color:

DRAWN BY:

TRACT 'L'

Subject:
Page Label: 3
Lock: Unlocked
Status:
Checkmark: Unchecked
Author: AutoCAD SHX Text
Date:
Color:

TRACT 'L'

7065

Subject:
Page Label: 3
Lock: Unlocked
Status:
Checkmark: Unchecked
Author: AutoCAD SHX Text
Date:
Color:

7065

30

Subject:
Page Label: 4
Lock: Unlocked
Status:
Checkmark: Unchecked
Author: AutoCAD SHX Text
Date:
Color:

30

44

Subject:
Page Label: 4
Lock: Unlocked
Status:
Checkmark: Unchecked
Author: AutoCAD SHX Text
Date:
Color:

44

31


Subject:
Page Label: 4
Lock: Unlocked
Status:
Checkmark: Unchecked
Author: AutoCAD SHX Text
Date:
Color:

31

7055

Subject:
Page Label: 4
Lock: Unlocked
Status:
Checkmark: Unchecked
Author: AutoCAD SHX Text
Date:
Color:

7055

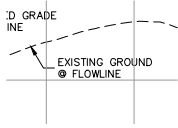


Subject:
Page Label: 4
Lock: Unlocked
Status:
Checkmark: Unchecked
Author: AutoCAD SHX Text
Date:
Color:

EXISTING GROUND @ FLOWLINE

IMPR'
SCALE:
HORIZONTAL
1" = 50'

Subject:
Page Label: 4
Lock: Unlocked
Status:
Checkmark: Unchecked
Author: AutoCAD SHX Text
Date:
Color:

SCALE:

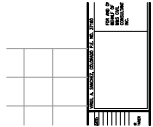

Subject:
Page Label: 4
Lock: Unlocked
Status:
Checkmark: Unchecked
Author: AutoCAD SHX Text
Date:
Color:

VIRGIL A. SANCHEZ, COLORADO P.E. NO. 37160

PROJECT NO.
DESIGNED BY
DRAWN BY:
CHECKED BY:

Subject:
Page Label: 4
Lock: Unlocked
Status:
Checkmark: Unchecked
Author: AutoCAD SHX Text
Date:
Color:

DRAWN BY:

45

Subject: 45
Page Label: 4
Lock: Unlocked
Status:
Checkmark: Unchecked
Author: AutoCAD SHX Text
Date:
Color:

7050

Subject: 7050
Page Label: 4
Lock: Unlocked
Status:
Checkmark: Unchecked
Author: AutoCAD SHX Text
Date:
Color:

7060

Subject: 7060
Page Label: 4
Lock: Unlocked
Status:
Checkmark: Unchecked
Author: AutoCAD SHX Text
Date:
Color:

REVISIONS:	NO.	DATE:

Subject: REVISIONS:
Page Label: 4
Lock: Unlocked
Status:
Checkmark: Unchecked
Author: AutoCAD SHX Text
Date:
Color:

7050

Subject: 7050
Page Label: 4
Lock: Unlocked
Status:
Checkmark: Unchecked
Author: AutoCAD SHX Text
Date:
Color:

APRV'D. BY:		

Subject: APRV'D. BY:
Page Label: 4
Lock: Unlocked
Status:
Checkmark: Unchecked
Author: AutoCAD SHX Text
Date:
Color:

ABBREVIATION LEGEND
 I-I CENTERLINE INTERSECTION
 F-I FLOWLINE INTERSECTION
 BT BEGIN TRANSITION
 ET END TRANSITION
 PC POINT OF CURVE
 PCC POINT OF COMPOUND CURVE
 PCR POINT OF CURB RETURN
 PRC POINT OF REVERSE CURVE
 PT POINT OF TANGENT
 EL ELEVATION
 LT LEFT
 RT RIGHT

Subject:
Page Label: 4
Lock: Unlocked
Status:
Checkmark: Unchecked
Author: AutoCAD SHX Text
Date:
Color:

ABBREVIATION LEGEND - CENTERLINE INTERSECTION CENTERLINE INTERSECTION - FLOWLINE INTERSECTION - FLOWLINE INTERSECTION FLOWLINE INTERSECTION BT BEGIN TRANSITION BEGIN TRANSITION ET END TRANSITION END TRANSITION PC POINT OF CURVE POINT OF CURVE PCC POINT OF COMPOUND CURVE POINT OF COMPOUND CURVE PCR POINT OF CURB RETURN POINT OF CURB RETURN PRC POINT OF REVERSE CURVE POINT OF REVERSE CURVE PT POINT OF TANGENT POINT OF TANGENT EL ELEVATION ELEVATION LT LEFT LEFT RT RIGHTRIGHT

0

Subject:
Page Label: 4
Lock: Unlocked
Status:
Checkmark: Unchecked
Author: AutoCAD SHX Text
Date:
Color:

0

S104

Subject:
Page Label: 4
Lock: Unlocked
Status:
Checkmark: Unchecked
Author: AutoCAD SHX Text
Date:
Color:

S104

2+00

0+65 2

Subject:
Page Label: 4
Lock: Unlocked
Status:
Checkmark: Unchecked
Author: AutoCAD SHX Text
Date:
Color:

2+00

7060

Subject:
Page Label: 4
Lock: Unlocked
Status:
Checkmark: Unchecked
Author: AutoCAD SHX Text
Date:
Color:

7060

7055

Subject:
Page Label: 4
Lock: Unlocked
Status:
Checkmark: Unchecked
Author: AutoCAD SHX Text
Date:
Color:

7055

RT RIGHT

STREET ABBREVIATIONS

KC KINTLA COURT
LGW LODGE GRASS WAY
MW MOSBY WAY
SW SPRAGUE WAY
WW WHITEFISH WAY
DB DINES BOULEVARD (EX.)
CDS CUL-DE-SAC

Subject:
Page Label: 4
Lock: Unlocked
Status:
Checkmark: Unchecked
Author: AutoCAD SHX Text
Date:
Color:

STREET ABBREVIATIONS KC KINTLA COURT
KINTLA COURT LGW LODGE GRASS WAY
LODGE GRASS WAY MW MOSBY WAY MOSBY
WAY SW SPRAGUE WAY SPRAGUE WAY
WW WHITEFISH WAY WHITEFISH WAY
DB DINES BOULEVARD (EX.) DINES
BOULEVARD (EX.)
CDS CUL-DE-SACCUL-DE-SAC

7055

Subject:
Page Label: 4
Lock: Unlocked
Status:
Checkmark: Unchecked
Author: AutoCAD SHX Text
Date:
Color:

7055

7050

Subject:
Page Label: 4
Lock: Unlocked
Status:
Checkmark: Unchecked
Author: AutoCAD SHX Text
Date:
Color:

7050

7060

Subject:
Page Label: 4
Lock: Unlocked
Status:
Checkmark: Unchecked
Author: AutoCAD SHX Text
Date:
Color:

7060

1" =


Subject:
Page Label: 4
Lock: Unlocked
Status:
Checkmark: Unchecked
Author: AutoCAD SHX Text
Date:
Color:

1" =


7050

Subject:
Page Label: 4
Lock: Unlocked
Status:
Checkmark: Unchecked
Author: AutoCAD SHX Text
Date:
Color:

7050

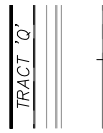

Subject: TRACT 'Q'
Page Label: 4
Lock: Unlocked
Status:
Checkmark: Unchecked
Author: AutoCAD SHX Text
Date:
Color:

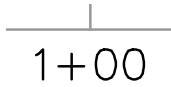

Subject: 1+00
Page Label: 4
Lock: Unlocked
Status:
Checkmark: Unchecked
Author: AutoCAD SHX Text
Date:
Color:




Subject: 48 HRS BEFORE YOU DIG
Page Label: 4
Lock: Unlocked
Status:
Checkmark: Unchecked
Author: AutoCAD SHX Text
Date:
Color:



Subject: TRACT 'Y'
Page Label: 4
Lock: Unlocked
Status:
Checkmark: Unchecked
Author: AutoCAD SHX Text
Date:
Color:



Subject: BY:
Page Label: 4
Lock: Unlocked
Status:
Checkmark: Unchecked
Author: AutoCAD SHX Text
Date:
Color:

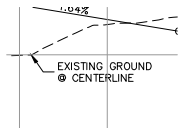

Subject: EXISTING GROUND @ CENTERLINE
Page Label: 4
Lock: Unlocked
Status:
Checkmark: Unchecked
Author: AutoCAD SHX Text
Date:
Color:

IT IMPROV

SCALE:
HORIZONTAL: 1"=50'
VERTICAL: 1"=5'

Subject: HORIZONTAL:
Page Label: 4
Lock: Unlocked
Status:
Checkmark: Unchecked
Author: AutoCAD SHX Text
Date:
Color:

7055


Subject: 7055
Page Label: 4
Lock: Unlocked
Status:
Checkmark: Unchecked
Author: AutoCAD SHX Text
Date:
Color:

4+00

Subject: 4+00
Page Label: 4
Lock: Unlocked
Status:
Checkmark: Unchecked
Author: AutoCAD SHX Text
Date:
Color:



Subject: FOR BURIED UTILITY INFORMATION
Page Label: 4
Lock: Unlocked
Status:
Checkmark: Unchecked
Author: AutoCAD SHX Text
Date:
Color:

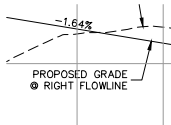

Subject: PROPOSED GRADE @ RIGHT FLOWLINE
Page Label: 4
Lock: Unlocked
Status:
Checkmark: Unchecked
Author: AutoCAD SHX Text
Date:
Color:

S

PROJECT NO. 0E
DESIGNED BY:
DRAWN BY:
CHECKED BY:

Subject: DESIGNED BY:
Page Label: 4
Lock: Unlocked
Status:
Checkmark: Unchecked
Author: AutoCAD SHX Text
Date:
Color:

36


Subject: 36
Page Label: 4
Lock: Unlocked
Status:
Checkmark: Unchecked
Author: AutoCAD SHX Text
Date:
Color:

50'

Subject: 50'
Page Label: 4
Lock: Unlocked
Status:
Checkmark: Unchecked
Author: AutoCAD SHX Text
Date:
Color:

38

Subject: 38
Page Label: 4
Lock: Unlocked
Status:
Checkmark: Unchecked
Author: AutoCAD SHX Text
Date:
Color:

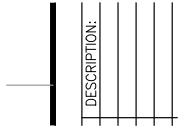

Subject: DESCRIPTION:
Page Label: 4
Lock: Unlocked
Status:
Checkmark: Unchecked
Author: AutoCAD SHX Text
Date:
Color:



Subject: STREET IMPROVEMENT PLANS
Page Label: 4
Lock: Unlocked
Status:
Checkmark: Unchecked
Author: AutoCAD SHX Text
Date:
Color:


0+00

Subject: 0+00
Page Label: 4
Lock: Unlocked
Status:
Checkmark: Unchecked
Author: AutoCAD SHX Text
Date:
Color:

3+00

Subject:
Page Label: 4
Lock: Unlocked
Status:
Checkmark: Unchecked
Author: AutoCAD SHX Text
Date:
Color:

3+00

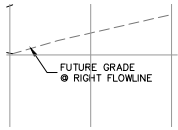

Subject:
Page Label: 4
Lock: Unlocked
Status:
Checkmark: Unchecked
Author: AutoCAD SHX Text
Date:
Color:

FUTURE GRADE @ RIGHT FLOWLINE




Subject:
Page Label: 4
Lock: Unlocked
Status:
Checkmark: Unchecked
Author: AutoCAD SHX Text
Date:
Color:

TRACT 'X'



Subject:
Page Label: 4
Lock: Unlocked
Status:
Checkmark: Unchecked
Author: AutoCAD SHX Text
Date:
Color:

FOR LOCATING & MARKING GAS, ELECTRIC,
WATER & TELEPHONE LINES

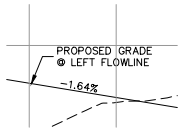

Subject:
Page Label: 4
Lock: Unlocked
Status:
Checkmark: Unchecked
Author: AutoCAD SHX Text
Date:
Color:

PROPOSED GRADE @ LEFT FLOWLINE

7050

Subject:
Page Label: 4
Lock: Unlocked
Status:
Checkmark: Unchecked
Author: AutoCAD SHX Text
Date:
Color:

7050

DATE:

Subject:
Page Label: 4
Lock: Unlocked
Status:
Checkmark: Unchecked
Author: AutoCAD SHX Text
Date:
Color:

DATE:

STREI

. 09-006

γ: VAS
E1 V

Subject:
Page Label: 4
Lock: Unlocked
Status:
Checkmark: Unchecked
Author: AutoCAD SHX Text
Date:
Color:

09-006

ELI

GW

Subject:
Page Label: 4
Lock: Unlocked
Status:
Checkmark: Unchecked
Author: AutoCAD SHX Text
Date:
Color:

GW

7055

Subject:
Page Label: 4
Lock: Unlocked
Status:
Checkmark: Unchecked
Author: AutoCAD SHX Text
Date:
Color:

7055

33

Subject:
Page Label: 4
Lock: Unlocked
Status:
Checkmark: Unchecked
Author: AutoCAD SHX Text
Date:
Color:

33

41

Subject:
Page Label: 4
Lock: Unlocked
Status:
Checkmark: Unchecked
Author: AutoCAD SHX Text
Date:
Color:

41

37

Subject:
Page Label: 4
Lock: Unlocked
Status:
Checkmark: Unchecked
Author: AutoCAD SHX Text
Date:
Color:

37

32

Subject:
Page Label: 4
Lock: Unlocked
Status:
Checkmark: Unchecked
Author: AutoCAD SHX Text
Date:
Color:

32

DATE:

Subject:
Page Label: 4
Lock: Unlocked
Status:
Checkmark: Unchecked
Author: AutoCAD SHX Text
Date:
Color:

DATE:



Subject:
Page Label: 4
Lock: Unlocked
Status:
Checkmark: Unchecked
Author: AutoCAD SHX Text
Date:
Color:

BRANDING IRON AT STERLING RANCH FILING NO. 1

34

Subject:
Page Label: 4
Lock: Unlocked
Status:
Checkmark: Unchecked
Author: AutoCAD SHX Text
Date:
Color:

34

50

Subject:
Page Label: 4
Lock: Unlocked
Status:
Checkmark: Unchecked
Author: AutoCAD SHX Text
Date:
Color:


50

40

Subject: 40
Page Label: 4
Lock: Unlocked
Status:
Checkmark: Unchecked
Author: AutoCAD SHX Text
Date:
Color:

35


Subject: 35
Page Label: 4
Lock: Unlocked
Status:
Checkmark: Unchecked
Author: AutoCAD SHX Text
Date:
Color:

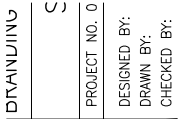


Subject: PROJECT NO.
Page Label: 4
Lock: Unlocked
Status:
Checkmark: Unchecked
Author: AutoCAD SHX Text
Date:
Color:



Subject: EXISTING
Page Label: 4
Lock: Unlocked
Status:
Checkmark: Unchecked
Author: AutoCAD SHX Text
Date:
Color:

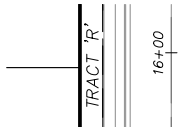

Subject: TRACT 'R'
Page Label: 4
Lock: Unlocked
Status:
Checkmark: Unchecked
Author: AutoCAD SHX Text
Date:
Color:

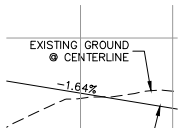

Subject: EXISTING GROUND @ CENTERLINE
Page Label: 4
Lock: Unlocked
Status:
Checkmark: Unchecked
Author: AutoCAD SHX Text
Date:
Color:

2+00

Subject:
Page Label: 4
Lock: Unlocked
Status:
Checkmark: Unchecked
Author: AutoCAD SHX Text
Date:
Color:

2+00

VEHICLE PLAN
DATE: 11/10/2017
SHEET 4 OF 8

Subject:
Page Label: 4
Lock: Unlocked
Status:
Checkmark: Unchecked
Author: AutoCAD SHX Text
Date:
Color:

SHEET 4 OF 8

KRACH FILIN
ENT PLANS
11/10/2017
SHEET 4 OF 8

Subject:
Page Label: 4
Lock: Unlocked
Status:
Checkmark: Unchecked
Author: AutoCAD SHX Text
Date:
Color:

11/10/2017

0+00

Subject:
Page Label: 4
Lock: Unlocked
Status:
Checkmark: Unchecked
Author: AutoCAD SHX Text
Date:
Color:

0+00

FOR AND ON
BEHALF OF
M&S CIVIL
CONSULTANTS,
INC.

Subject:
Page Label: 4
Lock: Unlocked
Status:
Checkmark: Unchecked
Author: AutoCAD SHX Text
Date:
Color:

FOR AND ON BEHALF OF M&S CIVIL
CONSULTANTS, INC.


TRACT 'K'

Subject:
Page Label: 4
Lock: Unlocked
Status:
Checkmark: Unchecked
Author: AutoCAD SHX Text
Date:
Color:

TRACT 'K'

100

Subject: 100
Page Label: 4
Lock: Unlocked
Status:
Checkmark: Unchecked
Author: AutoCAD SHX Text
Date:
Color:

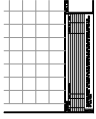

Subject: THE ENGINEER PREPARING THESE PLANS
Page Label: 4 WILL NOT BE RESPONSIBLE, OR LIABLE FOR,
Lock: Unlocked UNAUTHORIZED CHANGES TO OR USES OF
Status: THESE PLANS. ALL CHANGES TO THE PLANS
Checkmark: Unchecked MUST BE IN WRITING AND MUST BE
Author: AutoCAD SHX Text APPROVED BY THE PREPARER OF THESE
Date: PLANS.
Color:

SIONS:
DATE:

Subject: DATE:
Page Label: 4
Lock: Unlocked
Status:
Checkmark: Unchecked
Author: AutoCAD SHX Text
Date:
Color:

43

Subject: 43
Page Label: 4
Lock: Unlocked
Status:
Checkmark: Unchecked
Author: AutoCAD SHX Text
Date:
Color:

VAS
ELY
GW

Subject: ELY
Page Label: 4
Lock: Unlocked
Status:
Checkmark: Unchecked
Author: AutoCAD SHX Text
Date:
Color:

25

Subject: 25
Page Label: 4
Lock: Unlocked
Status:
Checkmark: Unchecked
Author: AutoCAD SHX Text
Date:
Color:

PROJECT NO. 01
DESIGNED BY:
DRAWN BY:
CHECKED BY:

Subject:
Page Label: 4
Lock: Unlocked
Status:
Checkmark: Unchecked
Author: AutoCAD SHX Text
Date:
Color:

CHECKED BY:

3+00
L 24 50


Subject:
Page Label: 4
Lock: Unlocked
Status:
Checkmark: Unchecked
Author: AutoCAD SHX Text
Date:
Color:

3+00

7050


Subject:
Page Label: 4
Lock: Unlocked
Status:
Checkmark: Unchecked
Author: AutoCAD SHX Text
Date:
Color:

7050

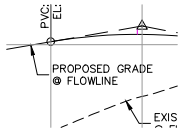

Subject:
Page Label: 4
Lock: Unlocked
Status:
Checkmark: Unchecked
Author: AutoCAD SHX Text
Date:
Color:

PROPOSED GRADE @ FLOWLINE

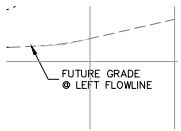

Subject:
Page Label: 4
Lock: Unlocked
Status:
Checkmark: Unchecked
Author: AutoCAD SHX Text
Date:
Color:

FUTURE GRADE @ LEFT FLOWLINE



Subject:
Page Label: 4
Lock: Unlocked
Status:
Checkmark: Unchecked
Author: AutoCAD SHX Text
Date:
Color:

TRACT 'L'



Subject: CALL 1-800-922-1987
Page Label: 4
Lock: Unlocked
Status:
Checkmark: Unchecked
Author: AutoCAD SHX Text
Date:
Color:

VAS
ELY

Subject: VAS
Page Label: 4
Lock: Unlocked
Status:
Checkmark: Unchecked
Author: AutoCAD SHX Text
Date:
Color:

RE
NO.


Subject: NO.
Page Label: 4
Lock: Unlocked
Status:
Checkmark: Unchecked
Author: AutoCAD SHX Text
Date:
Color:

7060

Subject: 7060
Page Label: 4
Lock: Unlocked
Status:
Checkmark: Unchecked
Author: AutoCAD SHX Text
Date:
Color:

7060

Subject: 7060
Page Label: 4
Lock: Unlocked
Status:
Checkmark: Unchecked
Author: AutoCAD SHX Text
Date:
Color:

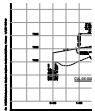

Subject: File: O:\09006A\Sterling Ranch No 3\dwg\Const
Page Label: 4 Dwg\Street Plans\Residential\SI04.dwg
Lock: Unlocked Plotstamp: 11/7/2017 10:08 AM
Status:
Checkmark: Unchecked
Author: AutoCAD SHX Text
Date:
Color:

SCALE:
HORIZONTAL:
1"=50'
VERTICAL:
1"=5'

Subject:
Page Label: 4
Lock: Unlocked
Status:
Checkmark: Unchecked
Author: AutoCAD SHX Text
Date:
Color:

VERTICAL:

7055

Subject:
Page Label: 4
Lock: Unlocked
Status:
Checkmark: Unchecked
Author: AutoCAD SHX Text
Date:
Color:

7055

25 50
Scale in Feet

Subject:
Page Label: 4
Lock: Unlocked
Status:
Checkmark: Unchecked
Author: AutoCAD SHX Text
Date:
Color:

Scale in Feet

CAUTION

Subject:
Page Label: 4
Lock: Unlocked
Status:
Checkmark: Unchecked
Author: AutoCAD SHX Text
Date:
Color:

CAUTION

1+00
MOED


Subject:
Page Label: 4
Lock: Unlocked
Status:
Checkmark: Unchecked
Author: AutoCAD SHX Text
Date:
Color:

1+00


42

Subject:
Page Label: 4
Lock: Unlocked
Status:
Checkmark: Unchecked
Author: AutoCAD SHX Text
Date:
Color:

42

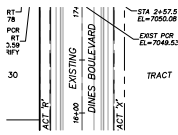

Subject: DINES BOULEVARD
Page Label: 4
Lock: Unlocked
Status:
Checkmark: Unchecked
Author: AutoCAD SHX Text
Date:
Color:

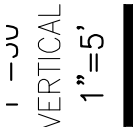

Subject: 1"=5'
Page Label: 4
Lock: Unlocked
Status:
Checkmark: Unchecked
Author: AutoCAD SHX Text
Date:
Color:



Subject: 1"=50'
Page Label: 4
Lock: Unlocked
Status:
Checkmark: Unchecked
Author: AutoCAD SHX Text
Date:
Color:

39

Subject: 39
Page Label: 4
Lock: Unlocked
Status:
Checkmark: Unchecked
Author: AutoCAD SHX Text
Date:
Color:

7060

Subject: 7060
Page Label: 4
Lock: Unlocked
Status:
Checkmark: Unchecked
Author: AutoCAD SHX Text
Date:
Color:


DESCRIPTION

Subject: DESCRIPTION:
Page Label: 5
Lock: Unlocked
Status:
Checkmark: Unchecked
Author: AutoCAD SHX Text
Date:
Color:

7045

Subject:
Page Label: 5
Lock: Unlocked
Status:
Checkmark: Unchecked
Author: AutoCAD SHX Text
Date:
Color:

7045

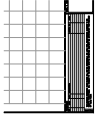

Subject:
Page Label: 5
Lock: Unlocked
Status:
Checkmark: Unchecked
Author: AutoCAD SHX Text
Date:
Color:

THE ENGINEER PREPARING THESE PLANS
WILL NOT BE RESPONSIBLE, OR LIABLE FOR,
UNAUTHORIZED CHANGES TO OR USES OF
THESE PLANS. ALL CHANGES TO THE PLANS
MUST BE IN WRITING AND MUST BE
APPROVED BY THE PREPARER OF THESE
PLANS.

3+00

2+10

Subject:
Page Label: 5
Lock: Unlocked
Status:
Checkmark: Unchecked
Author: AutoCAD SHX Text
Date:
Color:

3+00

16

Subject:
Page Label: 5
Lock: Unlocked
Status:
Checkmark: Unchecked
Author: AutoCAD SHX Text
Date:
Color:

16

BY:

Subject:
Page Label: 5
Lock: Unlocked
Status:
Checkmark: Unchecked
Author: AutoCAD SHX Text
Date:
Color:

BY:

ET IMPROV
SCALE:
HORIZONTAL:
1"=50'
VERTICAL:
1"=5'

Subject:
Page Label: 5
Lock: Unlocked
Status:
Checkmark: Unchecked
Author: AutoCAD SHX Text
Date:
Color:

HORIZONTAL:

0


Subject:
Page Label: 5
Lock: Unlocked
Status:
Checkmark: Unchecked
Author: AutoCAD SHX Text
Date:
Color:

0

33

Subject:
Page Label: 5
Lock: Unlocked
Status:
Checkmark: Unchecked
Author: AutoCAD SHX Text
Date:
Color:

33

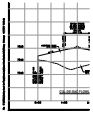

Subject:
Page Label: 5
Lock: Unlocked
Status:
Checkmark: Unchecked
Author: AutoCAD SHX Text
Date:
Color:

File: O:\09006A\Sterling Ranch No 3\dwg\Const
Dwg\Street Plans\Residential\SI05.dwg
Plotstamp: 11/7/2017 10:18 AM



Subject:
Page Label: 5
Lock: Unlocked
Status:
Checkmark: Unchecked
Author: AutoCAD SHX Text
Date:
Color:

CALL 1-800-922-1987

29

Subject:
Page Label: 5
Lock: Unlocked
Status:
Checkmark: Unchecked
Author: AutoCAD SHX Text
Date:
Color:

29

LL1
GW

Subject:
Page Label: 5
Lock: Unlocked
Status:
Checkmark: Unchecked
Author: AutoCAD SHX Text
Date:
Color:

GW

7045

Subject:
Page Label: 5
Lock: Unlocked
Status:
Checkmark: Unchecked
Author: AutoCAD SHX Text
Date:
Color:

7045



Subject:
Page Label: 5
Lock: Unlocked
Status:
Checkmark: Unchecked
Author: AutoCAD SHX Text
Date:
Color:

TRACT 'L'



Subject:
Page Label: 5
Lock: Unlocked
Status:
Checkmark: Unchecked
Author: AutoCAD SHX Text
Date:
Color:

DATE:

32

Subject:
Page Label: 5
Lock: Unlocked
Status:
Checkmark: Unchecked
Author: AutoCAD SHX Text
Date:
Color:

32

TRACT 'K'

Subject:
Page Label: 5
Lock: Unlocked
Status:
Checkmark: Unchecked
Author: AutoCAD SHX Text
Date:
Color:

TRACT 'K'

27

Subject:
Page Label: 5
Lock: Unlocked
Status:
Checkmark: Unchecked
Author: AutoCAD SHX Text
Date:
Color:

27

DATE:

Subject:
Page Label: 5
Lock: Unlocked
Status:
Checkmark: Unchecked
Author: AutoCAD SHX Text
Date:
Color:

DATE:

1+00

UTER

Subject:
Page Label: 5
Lock: Unlocked
Status:
Checkmark: Unchecked
Author: AutoCAD SHX Text
Date:
Color:

1+00

21

Subject:
Page Label: 5
Lock: Unlocked
Status:
Checkmark: Unchecked
Author: AutoCAD SHX Text
Date:
Color:

21

34

Subject:
Page Label: 5
Lock: Unlocked
Status:
Checkmark: Unchecked
Author: AutoCAD SHX Text
Date:
Color:

34

STREE

09-006

VAS
ETV


Subject:
Page Label: 5
Lock: Unlocked
Status:
Checkmark: Unchecked
Author: AutoCAD SHX Text
Date:
Color:

09-006

7050

Subject:
Page Label: 5
Lock: Unlocked
Status:
Checkmark: Unchecked
Author: AutoCAD SHX Text
Date:
Color:

7050

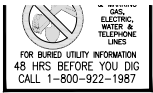

Subject:
Page Label: 5
Lock: Unlocked
Status:
Checkmark: Unchecked
Author: AutoCAD SHX Text
Date:
Color:

48 HRS BEFORE YOU DIG

VAS
ELY

Subject:
Page Label: 5
Lock: Unlocked
Status:
Checkmark: Unchecked
Author: AutoCAD SHX Text
Date:
Color:

VAS



Subject:
Page Label: 5
Lock: Unlocked
Status:
Checkmark: Unchecked
Author: AutoCAD SHX Text
Date:
Color:

SHEET 5 OF 8



Subject:
Page Label: 5
Lock: Unlocked
Status:
Checkmark: Unchecked
Author: AutoCAD SHX Text
Date:
Color:

DRAWN BY:

18


Subject:
Page Label: 5
Lock: Unlocked
Status:
Checkmark: Unchecked
Author: AutoCAD SHX Text
Date:
Color:

18

7040

Subject:
Page Label: 5
Lock: Unlocked
Status:
Checkmark: Unchecked
Author: AutoCAD SHX Text
Date:
Color:

7040

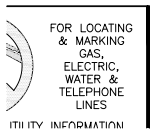


Subject:
Page Label: 5
Lock: Unlocked
Status:
Checkmark: Unchecked
Author: AutoCAD SHX Text
Date:
Color:

FOR LOCATING & MARKING GAS, ELECTRIC,
 WATER & TELEPHONE LINES

25


Subject:
Page Label: 5
Lock: Unlocked
Status:
Checkmark: Unchecked
Author: AutoCAD SHX Text
Date:
Color:

25

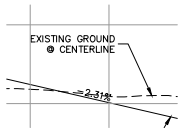


Subject:
Page Label: 5
Lock: Unlocked
Status:
Checkmark: Unchecked
Author: AutoCAD SHX Text
Date:
Color:

EXISTING GROUND @ CENTERLINE

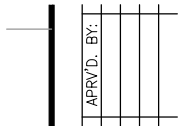

Subject:
Page Label: 5
Lock: Unlocked
Status:
Checkmark: Unchecked
Author: AutoCAD SHX Text
Date:
Color:

APRV'D. BY:

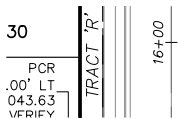

Subject:
Page Label: 5
Lock: Unlocked
Status:
Checkmark: Unchecked
Author: AutoCAD SHX Text
Date:
Color:

TRACT 'R'

50'

Subject:
Page Label: 5
Lock: Unlocked
Status:
Checkmark: Unchecked
Author: AutoCAD SHX Text
Date:
Color:

50'

RANCH FLIN
ENT PLANS
11/10/2017
LET 5 OF 8

Subject: 11/10/2017
Page Label: 5
Lock: Unlocked
Status:
Checkmark: Unchecked
Author: AutoCAD SHX Text
Date:
Color:

00' RT
043.42
VERIFY
TRACT 'S'
19


Subject: TRACT 'S'
Page Label: 5
Lock: Unlocked
Status:
Checkmark: Unchecked
Author: AutoCAD SHX Text
Date:
Color:

30

Subject: 30
Page Label: 5
Lock: Unlocked
Status:
Checkmark: Unchecked
Author: AutoCAD SHX Text
Date:
Color:

7050

Subject: 7050
Page Label: 5
Lock: Unlocked
Status:
Checkmark: Unchecked
Author: AutoCAD SHX Text
Date:
Color:

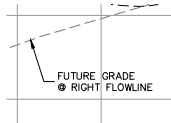

Subject: FUTURE GRADE @ RIGHT FLOWLINE
Page Label: 5
Lock: Unlocked
Status:
Checkmark: Unchecked
Author: AutoCAD SHX Text
Date:
Color:

0+00

Subject: 0+00
Page Label: 5
Lock: Unlocked
Status:
Checkmark: Unchecked
Author: AutoCAD SHX Text
Date:
Color:

PROJECT NO. 01
DESIGNED BY:
DRAWN BY:
CHECKED BY:

Subject:
Page Label: 5
Lock: Unlocked
Status:
Checkmark: Unchecked
Author: AutoCAD SHX Text
Date:
Color:

CHECKED BY:

26

Subject:
Page Label: 5
Lock: Unlocked
Status:
Checkmark: Unchecked
Author: AutoCAD SHX Text
Date:
Color:

26

31

Subject:
Page Label: 5
Lock: Unlocked
Status:
Checkmark: Unchecked
Author: AutoCAD SHX Text
Date:
Color:

31

7045

Subject:
Page Label: 5
Lock: Unlocked
Status:
Checkmark: Unchecked
Author: AutoCAD SHX Text
Date:
Color:

7045

23

Subject:
Page Label: 5
Lock: Unlocked
Status:
Checkmark: Unchecked
Author: AutoCAD SHX Text
Date:
Color:

23

CAUTION

Subject:
Page Label: 5
Lock: Unlocked
Status:
Checkmark: Unchecked
Author: AutoCAD SHX Text
Date:
Color:

CAUTION

IMPR'
SCALE:
HORIZONTAL
1"=50'

Subject:
Page Label: 5
Lock: Unlocked
Status:
Checkmark: Unchecked
Author: AutoCAD SHX Text
Date:
Color:

SCALE:

7040

Subject:
Page Label: 5
Lock: Unlocked
Status:
Checkmark: Unchecked
Author: AutoCAD SHX Text
Date:
Color:

7040

88 81 28
34 27 28
32
HACK EXISTING
DINES BOULEVARD
01-7042.75
0201.P01
01-7042.19

Subject:
Page Label: 5
Lock: Unlocked
Status:
Checkmark: Unchecked
Author: AutoCAD SHX Text
Date:
Color:

DINES BOULEVARD

1 - JU
VERTICAL
1"=5'

Subject:
Page Label: 5
Lock: Unlocked
Status:
Checkmark: Unchecked
Author: AutoCAD SHX Text
Date:
Color:

1"=5'

D
TRACT 'W'

Subject:
Page Label: 5
Lock: Unlocked
Status:
Checkmark: Unchecked
Author: AutoCAD SHX Text
Date:
Color:

TRACT 'W'

DRAWING
S
PROJECT NO. 0
DESIGNED BY:
DRAWN BY:
CHECKED BY:

Subject:
Page Label: 5
Lock: Unlocked
Status:
Checkmark: Unchecked
Author: AutoCAD SHX Text
Date:
Color:

PROJECT NO.

7045

Subject:
Page Label: 5
Lock: Unlocked
Status:
Checkmark: Unchecked
Author: AutoCAD SHX Text
Date:
Color:

7045

1+00

Subject:
Page Label: 5
Lock: Unlocked
Status:
Checkmark: Unchecked
Author: AutoCAD SHX Text
Date:
Color:

1+00

7040

Subject:
Page Label: 5
Lock: Unlocked
Status:
Checkmark: Unchecked
Author: AutoCAD SHX Text
Date:
Color:

7040

2+00

7040

Subject:
Page Label: 5
Lock: Unlocked
Status:
Checkmark: Unchecked
Author: AutoCAD SHX Text
Date:
Color:

2+00

7050

Subject:
Page Label: 5
Lock: Unlocked
Status:
Checkmark: Unchecked
Author: AutoCAD SHX Text
Date:
Color:

7050

SIONS:
DATE:

Subject:
Page Label: 5
Lock: Unlocked
Status:
Checkmark: Unchecked
Author: AutoCAD SHX Text
Date:
Color:

DATE:

7040


Subject:
Page Label: 5
Lock: Unlocked
Status:
Checkmark: Unchecked
Author: AutoCAD SHX Text
Date:
Color:

7040

7040

Subject:
Page Label: 5
Lock: Unlocked
Status:
Checkmark: Unchecked
Author: AutoCAD SHX Text
Date:
Color:

7040

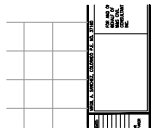

Subject:
Page Label: 5
Lock: Unlocked
Status:
Checkmark: Unchecked
Author: AutoCAD SHX Text
Date:
Color:

VIRGIL A. SANCHEZ, COLORADO P.E. NO.
37160

4+00

Subject:
Page Label: 5
Lock: Unlocked
Status:
Checkmark: Unchecked
Author: AutoCAD SHX Text
Date:
Color:

4+00

1" =

Subject:
Page Label: 5
Lock: Unlocked
Status:
Checkmark: Unchecked
Author: AutoCAD SHX Text
Date:
Color:

1" =

0+00

Subject:
Page Label: 5
Lock: Unlocked
Status:
Checkmark: Unchecked
Author: AutoCAD SHX Text
Date:
Color:

0+00



Subject:
Page Label: 5
Lock: Unlocked
Status:
Checkmark: Unchecked
Author: AutoCAD SHX Text
Date:
Color:

BRANDING IRON AT STERLING RANCH FILING NO. 1



Subject:
Page Label: 5
Lock: Unlocked
Status:
Checkmark: Unchecked
Author: AutoCAD SHX Text
Date:
Color:

STREET IMPROVEMENT PLANS

7045

Subject:
Page Label: 5
Lock: Unlocked
Status:
Checkmark: Unchecked
Author: AutoCAD SHX Text
Date:
Color:

7045

3/7/00
 FOR AND ON
 BEHALF OF
 M&S CIVIL
 CONSULTANTS,
 INC.

Subject:
Page Label: 5
Lock: Unlocked
Status:
Checkmark: Unchecked
Author: AutoCAD SHX Text
Date:
Color:

FOR AND ON BEHALF OF M&S CIVIL CONSULTANTS, INC.

7045

Subject:
Page Label: 5
Lock: Unlocked
Status:
Checkmark: Unchecked
Author: AutoCAD SHX Text
Date:
Color:

7045

REI
 NO.

Subject:
Page Label: 5
Lock: Unlocked
Status:
Checkmark: Unchecked
Author: AutoCAD SHX Text
Date:
Color:

NO.

ABBREVIATION LEGEND
 I-C CENTERLINE INTERSECTION
 F-I FLOWLINE INTERSECTION
 BT BEGIN TRANSITION
 ET END TRANSITION
 PC POINT OF CURVE
 PCC POINT OF COMPOUND CURVE
 PCR POINT OF CURB RETURN
 PRC POINT OF REVERSE CURVE
 PT POINT OF TANGENT
 EL ELEVATION
 LT LEFT
 RT RIGHT

Subject:
Page Label: 5
Lock: Unlocked
Status:
Checkmark: Unchecked
Author: AutoCAD SHX Text
Date:
Color:

ABBREVIATION LEGEND - CENTERLINE INTERSECTION
 CENTERLINE INTERSECTION
 - FLOWLINE INTERSECTION - FLOWLINE INTERSECTION
 FLOWLINE INTERSECTION BT BEGIN TRANSITION
 BEGIN TRANSITION ET END TRANSITION
 END TRANSITION PC POINT OF CURVE
 POINT OF CURVE PCC POINT OF COMPOUND CURVE
 POINT OF COMPOUND CURVE PCR POINT OF CURB RETURN
 POINT OF CURB RETURN PRC POINT OF REVERSE CURVE
 POINT OF REVERSE CURVE PT POINT OF TANGENT
 POINT OF TANGENT EL ELEVATION
 ELEVATION LT LEFT LEFT RT RIGHTRIGHT

2+00

Subject:
Page Label: 5
Lock: Unlocked
Status:
Checkmark: Unchecked
Author: AutoCAD SHX Text
Date:
Color:

2+00

VAS
 ELY
 GW


Subject:
Page Label: 5
Lock: Unlocked
Status:
Checkmark: Unchecked
Author: AutoCAD SHX Text
Date:
Color:

ELY

28

Subject:
Page Label: 5
Lock: Unlocked
Status:
Checkmark: Unchecked
Author: AutoCAD SHX Text
Date:
Color:

28

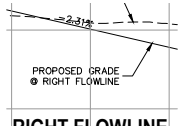


Subject:
Page Label: 5
Lock: Unlocked
Status:
Checkmark: Unchecked
Author: AutoCAD SHX Text
Date:
Color:

PROPOSED GRADE @ RIGHT FLOWLINE

SCALE:
 HORIZONTAL:
 1"=50'
 VERTICAL:
 1"=5'


Subject:
Page Label: 5
Lock: Unlocked
Status:
Checkmark: Unchecked
Author: AutoCAD SHX Text
Date:
Color:

VERTICAL:

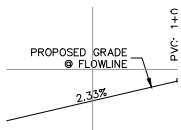

Subject:
Page Label: 5
Lock: Unlocked
Status:
Checkmark: Unchecked
Author: AutoCAD SHX Text
Date:
Color:

PROPOSED GRADE @ FLOWLINE

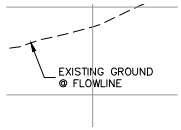


Subject:
Page Label: 5
Lock: Unlocked
Status:
Checkmark: Unchecked
Author: AutoCAD SHX Text
Date:
Color:

EXISTING GROUND @ FLOWLINE



Subject:
Page Label: 5
Lock: Unlocked
Status:
Checkmark: Unchecked
Author: AutoCAD SHX Text
Date:
Color:

7040

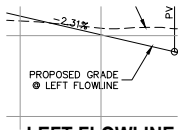

Subject:
Page Label: 5
Lock: Unlocked
Status:
Checkmark: Unchecked
Author: AutoCAD SHX Text
Date:
Color:

PROPOSED GRADE @ LEFT FLOWLINE




Subject:
Page Label: 5
Lock: Unlocked
Status:
Checkmark: Unchecked
Author: AutoCAD SHX Text
Date:
Color:

25



Subject:
Page Label: 5
Lock: Unlocked
Status:
Checkmark: Unchecked
Author: AutoCAD SHX Text
Date:
Color:

22

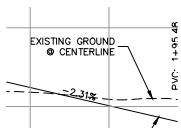

Subject:
Page Label: 5
Lock: Unlocked
Status:
Checkmark: Unchecked
Author: AutoCAD SHX Text
Date:
Color:

EXISTING GROUND @ CENTERLINE



Subject:
Page Label: 5
Lock: Unlocked
Status:
Checkmark: Unchecked
Author: AutoCAD SHX Text
Date:
Color:

TRACT 'X'

7050

Subject:
Page Label: 5
Lock: Unlocked
Status:
Checkmark: Unchecked
Author: AutoCAD SHX Text
Date:
Color:

7050

S105

Subject:
Page Label: 5
Lock: Unlocked
Status:
Checkmark: Unchecked
Author: AutoCAD SHX Text
Date:
Color:

S105



Subject:
Page Label: 5
Lock: Unlocked
Status:
Checkmark: Unchecked
Author: AutoCAD SHX Text
Date:
Color:

FOR BURIED UTILITY INFORMATION

19

Subject:
Page Label: 5
Lock: Unlocked
Status:
Checkmark: Unchecked
Author: AutoCAD SHX Text
Date:
Color:

19

15

Subject: 15
Page Label: 5
Lock: Unlocked
Status:
Checkmark: Unchecked
Author: AutoCAD SHX Text
Date:
Color:

7050

Subject: 7050
Page Label: 5
Lock: Unlocked
Status:
Checkmark: Unchecked
Author: AutoCAD SHX Text
Date:
Color:

RT RIGHT

STREET ABBREVIATIONS

KC KINTLA COURT
LGW LODGE GRASS WAY
MW MOSBY WAY
SW SPRAGUE WAY
WW WHITEFISH WAY
DB DINES BOULEVARD (EX.)
CDS CUL-DE-SAC


Subject: STREET ABBREVIATIONS
Page Label: 5 KC KINTLA COURT
Lock: Unlocked KINTLA COURT LGW LODGE GRASS WAY
Status: LODGE GRASS WAY MW MOSBY WAY MOSBY
Checkmark: Unchecked WAY SW SPRAGUE WAY SPRAGUE WAY
Author: AutoCAD SHX Text WW WHITEFISH WAY WHITEFISH WAY
Date: DB DINES BOULEVARD (EX.) DINES
Color: BOULEVARD (EX.)
CDS CUL-DE-SACCUL-DE-SAC

100

Subject: 100
Page Label: 5
Lock: Unlocked
Status:
Checkmark: Unchecked
Author: AutoCAD SHX Text
Date:
Color:

20

Subject: 20
Page Label: 5
Lock: Unlocked
Status:
Checkmark: Unchecked
Author: AutoCAD SHX Text
Date:
Color:

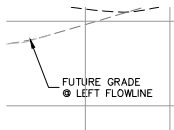

Subject: FUTURE GRADE @ LEFT FLOWLINE
Page Label: 5
Lock: Unlocked
Status:
Checkmark: Unchecked
Author: AutoCAD SHX Text
Date:
Color:

REVISIONS:	
NO.	DATE:

Subject:
Page Label: 5
Lock: Unlocked
Status:
Checkmark: Unchecked
Author: AutoCAD SHX Text
Date:
Color:

REVISIONS:

24

Subject:
Page Label: 5
Lock: Unlocked
Status:
Checkmark: Unchecked
Author: AutoCAD SHX Text
Date:
Color:

24

3+00

Subject:
Page Label: 5
Lock: Unlocked
Status:
Checkmark: Unchecked
Author: AutoCAD SHX Text
Date:
Color:

3+00

SCALE:
 HORIZONTAL
 1"=50'
 VERTICAL:
 1"=5'

Subject:
Page Label: 5
Lock: Unlocked
Status:
Checkmark: Unchecked
Author: AutoCAD SHX Text
Date:
Color:

1"=50'

50

Subject:
Page Label: 5
Lock: Unlocked
Status:
Checkmark: Unchecked
Author: AutoCAD SHX Text
Date:
Color:

50

EXISTING
BOULEVARD

Subject:
Page Label: 5
Lock: Unlocked
Status:
Checkmark: Unchecked
Author: AutoCAD SHX Text
Date:
Color:

EXISTING

17

Subject: 17
Page Label: 5
Lock: Unlocked
Status:
Checkmark: Unchecked
Author: AutoCAD SHX Text
Date:
Color:

7050

Subject: 7050
Page Label: 5
Lock: Unlocked
Status:
Checkmark: Unchecked
Author: AutoCAD SHX Text
Date:
Color:

25 50
Scale in Feet

Subject: Scale in Feet
Page Label: 5
Lock: Unlocked
Status:
Checkmark: Unchecked
Author: AutoCAD SHX Text
Date:
Color:

S
PROJECT NO. 06
DESIGNED BY:
DRAWN BY:
CHECKED BY:

Subject: DESIGNED BY:
Page Label: 5
Lock: Unlocked
Status:
Checkmark: Unchecked
Author: AutoCAD SHX Text
Date:
Color:

VAS
ELY

Subject: VAS
Page Label: 6
Lock: Unlocked
Status:
Checkmark: Unchecked
Author: AutoCAD SHX Text
Date:
Color:

7030

Subject: 7030
Page Label: 6
Lock: Unlocked
Status:
Checkmark: Unchecked
Author: AutoCAD SHX Text
Date:
Color:


RT RIGHT

STREET ABBREVIATIONS

KC	KINTLA COURT
LGW	LODGE GRASS WAY
MW	MOSBY WAY
SW	SPRAGUE WAY
WW	WHITEFISH WAY
DB	DINES BOULEVARD (EX.)
CDS	CUL-DE-SAC


Subject:
Page Label: 6
Lock: Unlocked
Status:
Checkmark: Unchecked
Author: AutoCAD SHX Text
Date:
Color:

STREET ABBREVIATIONS KC KINTLA COURT
 KINTLA COURT LGW LODGE GRASS WAY
 LODGE GRASS WAY MW MOSBY WAY MOSBY
 WAY SW SPRAGUE WAY SPRAGUE WAY
 WW WHITEFISH WAY WHITEFISH WAY
 DB DINES BOULEVARD (EX.) DINES
 BOULEVARD (EX.)
 CDS CUL-DE-SACCUL-DE-SAC

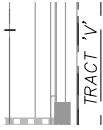


Subject:
Page Label: 6
Lock: Unlocked
Status:
Checkmark: Unchecked
Author: AutoCAD SHX Text
Date:
Color:

TRACT 'V'

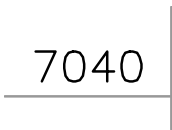

Subject:
Page Label: 6
Lock: Unlocked
Status:
Checkmark: Unchecked
Author: AutoCAD SHX Text
Date:
Color:

7040

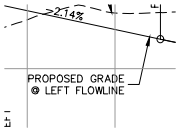

Subject:
Page Label: 6
Lock: Unlocked
Status:
Checkmark: Unchecked
Author: AutoCAD SHX Text
Date:
Color:

PROPOSED GRADE @ LEFT FLOWLINE



Subject:
Page Label: 6
Lock: Unlocked
Status:
Checkmark: Unchecked
Author: AutoCAD SHX Text
Date:
Color:

CHECKED BY:



Subject:
Page Label: 6
Lock: Unlocked
Status:
Checkmark: Unchecked
Author: AutoCAD SHX Text
Date:
Color:

HORIZONTAL:

16

Subject: 16
Page Label: 6
Lock: Unlocked
Status:
Checkmark: Unchecked
Author: AutoCAD SHX Text
Date:
Color:

7035

Subject: 7035
Page Label: 6
Lock: Unlocked
Status:
Checkmark: Unchecked
Author: AutoCAD SHX Text
Date:
Color:

3+00

2+00

Subject: 3+00
Page Label: 6
Lock: Unlocked
Status:
Checkmark: Unchecked
Author: AutoCAD SHX Text
Date:
Color:

2+00

1+00

Subject: 2+00
Page Label: 6
Lock: Unlocked
Status:
Checkmark: Unchecked
Author: AutoCAD SHX Text
Date:
Color:

SI06

DATE:

Subject: DATE:
Page Label: 6
Lock: Unlocked
Status:
Checkmark: Unchecked
Author: AutoCAD SHX Text
Date:
Color:

SI06

Subject: SI06
Page Label: 6
Lock: Unlocked
Status:
Checkmark: Unchecked
Author: AutoCAD SHX Text
Date:
Color:

11

Subject:
Page Label: 6
Lock: Unlocked
Status:
Checkmark: Unchecked
Author: AutoCAD SHX Text
Date:
Color:

11

7030

Subject:
Page Label: 6
Lock: Unlocked
Status:
Checkmark: Unchecked
Author: AutoCAD SHX Text
Date:
Color:

7030

50


Subject:
Page Label: 6
Lock: Unlocked
Status:
Checkmark: Unchecked
Author: AutoCAD SHX Text
Date:
Color:

50

VERTICAL
1"=5'

Subject:
Page Label: 6
Lock: Unlocked
Status:
Checkmark: Unchecked
Author: AutoCAD SHX Text
Date:
Color:

1"=5'

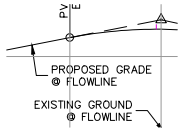


Subject:
Page Label: 6
Lock: Unlocked
Status:
Checkmark: Unchecked
Author: AutoCAD SHX Text
Date:
Color:

PROPOSED GRADE @ FLOWLINE

25

Subject:
Page Label: 6
Lock: Unlocked
Status:
Checkmark: Unchecked
Author: AutoCAD SHX Text
Date:
Color:

25

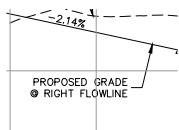

Subject:
Page Label: 6
Lock: Unlocked
Status:
Checkmark: Unchecked
Author: AutoCAD SHX Text
Date:
Color:

PROPOSED GRADE @ RIGHT FLOWLINE

17

Subject:
Page Label: 6
Lock: Unlocked
Status:
Checkmark: Unchecked
Author: AutoCAD SHX Text
Date:
Color:

17

14

Subject:
Page Label: 6
Lock: Unlocked
Status:
Checkmark: Unchecked
Author: AutoCAD SHX Text
Date:
Color:

14

7035

Subject:
Page Label: 6
Lock: Unlocked
Status:
Checkmark: Unchecked
Author: AutoCAD SHX Text
Date:
Color:

7035

BY:

Subject:
Page Label: 6
Lock: Unlocked
Status:
Checkmark: Unchecked
Author: AutoCAD SHX Text
Date:
Color:

BY:

REVISIONS:	NO.	DATE:

Subject:
Page Label: 6
Lock: Unlocked
Status:
Checkmark: Unchecked
Author: AutoCAD SHX Text
Date:
Color:

REVISIONS:

VAS
ELY
GW

Subject: ELY
Page Label: 6
Lock: Unlocked
Status:
Checkmark: Unchecked
Author: AutoCAD SHX Text
Date:
Color:

50'

Subject: 50'
Page Label: 6
Lock: Unlocked
Status:
Checkmark: Unchecked
Author: AutoCAD SHX Text
Date:
Color:

7040

Subject: 7040
Page Label: 6
Lock: Unlocked
Status:
Checkmark: Unchecked
Author: AutoCAD SHX Text
Date:
Color:

7045


Subject: 7045
Page Label: 6
Lock: Unlocked
Status:
Checkmark: Unchecked
Author: AutoCAD SHX Text
Date:
Color:

2+00

Subject: 2+00
Page Label: 6
Lock: Unlocked
Status:
Checkmark: Unchecked
Author: AutoCAD SHX Text
Date:
Color:

13

Subject: 13
Page Label: 6
Lock: Unlocked
Status:
Checkmark: Unchecked
Author: AutoCAD SHX Text
Date:
Color:

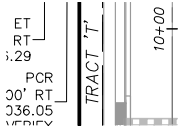

Subject: TRACT 'T'
Page Label: 6
Lock: Unlocked
Status:
Checkmark: Unchecked
Author: AutoCAD SHX Text
Date:
Color:

TRACT 'T'

19

Subject: 19
Page Label: 6
Lock: Unlocked
Status:
Checkmark: Unchecked
Author: AutoCAD SHX Text
Date:
Color:

19

7040

Subject: 7040
Page Label: 6
Lock: Unlocked
Status:
Checkmark: Unchecked
Author: AutoCAD SHX Text
Date:
Color:

7040

ELI
GW

Subject: GW
Page Label: 6
Lock: Unlocked
Status:
Checkmark: Unchecked
Author: AutoCAD SHX Text
Date:
Color:

GW

7030

Subject: 7030
Page Label: 6
Lock: Unlocked
Status:
Checkmark: Unchecked
Author: AutoCAD SHX Text
Date:
Color:

7030



Subject: BRANDING IRON AT STERLING RANCH FILING NO. 1
Page Label: 6
Lock: Unlocked
Status:
Checkmark: Unchecked
Author: AutoCAD SHX Text
Date:
Color:

BRANDING IRON AT STERLING RANCH FILING NO. 1

100

Subject:
Page Label: 6
Lock: Unlocked
Status:
Checkmark: Unchecked
Author: AutoCAD SHX Text
Date:
Color:

100

DRAWING

5

PROJECT NO. 0

DESIGNED BY:

DRAWN BY:

CHECKED BY:

Subject:
Page Label: 6
Lock: Unlocked
Status:
Checkmark: Unchecked
Author: AutoCAD SHX Text
Date:
Color:

PROJECT NO.

3+00

Subject:
Page Label: 6
Lock: Unlocked
Status:
Checkmark: Unchecked
Author: AutoCAD SHX Text
Date:
Color:

3+00

APRVD. BY:

Subject:
Page Label: 6
Lock: Unlocked
Status:
Checkmark: Unchecked
Author: AutoCAD SHX Text
Date:
Color:

APRV'D. BY:

1+00


Subject:
Page Label: 6
Lock: Unlocked
Status:
Checkmark: Unchecked
Author: AutoCAD SHX Text
Date:
Color:

1+00

7040

Subject:
Page Label: 6
Lock: Unlocked
Status:
Checkmark: Unchecked
Author: AutoCAD SHX Text
Date:
Color:

7040

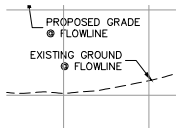

Subject:
Page Label: 6
Lock: Unlocked
Status:
Checkmark: Unchecked
Author: AutoCAD SHX Text
Date:
Color:

EXISTING GROUND @ FLOWLINE

7035


Subject:
Page Label: 6
Lock: Unlocked
Status:
Checkmark: Unchecked
Author: AutoCAD SHX Text
Date:
Color:

7035

7040

Subject:
Page Label: 6
Lock: Unlocked
Status:
Checkmark: Unchecked
Author: AutoCAD SHX Text
Date:
Color:

7040

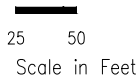

Subject:
Page Label: 6
Lock: Unlocked
Status:
Checkmark: Unchecked
Author: AutoCAD SHX Text
Date:
Color:

Scale in Feet




Subject:
Page Label: 6
Lock: Unlocked
Status:
Checkmark: Unchecked
Author: AutoCAD SHX Text
Date:
Color:

FOR LOCATING & MARKING GAS, ELECTRIC,
WATER & TELEPHONE LINES




Subject:
Page Label: 6
Lock: Unlocked
Status:
Checkmark: Unchecked
Author: AutoCAD SHX Text
Date:
Color:

SCALE:

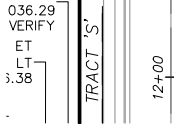

Subject:
Page Label: 6
Lock: Unlocked
Status:
Checkmark: Unchecked
Author: AutoCAD SHX Text
Date:
Color:

TRACT 'S'

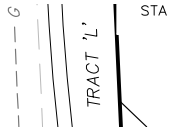

Subject:
Page Label: 6
Lock: Unlocked
Status:
Checkmark: Unchecked
Author: AutoCAD SHX Text
Date:
Color:

TRACT 'L'



Subject:
Page Label: 6
Lock: Unlocked
Status:
Checkmark: Unchecked
Author: AutoCAD SHX Text
Date:
Color:

7045




Subject:
Page Label: 6
Lock: Unlocked
Status:
Checkmark: Unchecked
Author: AutoCAD SHX Text
Date:
Color:

48 HRS BEFORE YOU DIG



Subject:
Page Label: 6
Lock: Unlocked
Status:
Checkmark: Unchecked
Author: AutoCAD SHX Text
Date:
Color:

DRAWN BY:

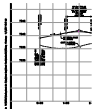

Subject:
Page Label: 6
Lock: Unlocked
Status:
Checkmark: Unchecked
Author: AutoCAD SHX Text
Date:
Color:

File: O:\09006A\Sterling Ranch No 3\dwg\Const
Dwg\Street Plans\Residential\SI06.dwg
Plotstamp: 11/7/2017 10:30 AM

7030

Subject: 7030
Page Label: 6
Lock: Unlocked
Status:
Checkmark: Unchecked
Author: AutoCAD SHX Text
Date:
Color:

DESCRIPTION:

Subject: DESCRIPTION:
Page Label: 6
Lock: Unlocked
Status:
Checkmark: Unchecked
Author: AutoCAD SHX Text
Date:
Color:

0+00

Subject: 0+00
Page Label: 6
Lock: Unlocked
Status:
Checkmark: Unchecked
Author: AutoCAD SHX Text
Date:
Color:

TRACT 'K'

TRACT 'K'

Subject: TRACT 'K'
Page Label: 6
Lock: Unlocked
Status:
Checkmark: Unchecked
Author: AutoCAD SHX Text
Date:
Color:

0

Subject: 0
Page Label: 6
Lock: Unlocked
Status:
Checkmark: Unchecked
Author: AutoCAD SHX Text
Date:
Color:

DATE:

Subject: DATE:
Page Label: 6
Lock: Unlocked
Status:
Checkmark: Unchecked
Author: AutoCAD SHX Text
Date:
Color:

7035

Subject: 7035
Page Label: 6
Lock: Unlocked
Status:
Checkmark: Unchecked
Author: AutoCAD SHX Text
Date:
Color:

4+00

Subject: 4+00
Page Label: 6
Lock: Unlocked
Status:
Checkmark: Unchecked
Author: AutoCAD SHX Text
Date:
Color:

DATE:

Subject: DATE:
Page Label: 6
Lock: Unlocked
Status:
Checkmark: Unchecked
Author: AutoCAD SHX Text
Date:
Color:

7030

Subject: 7030
Page Label: 6
Lock: Unlocked
Status:
Checkmark: Unchecked
Author: AutoCAD SHX Text
Date:
Color:

ABBREVIATION LEGEND
S-I CENTERLINE INTERSECTION
F-I FLOWLINE INTERSECTION
BT BEGIN TRANSITION
ET END TRANSITION
PC POINT OF CURVE
PCC POINT OF COMPOUND CURVE
PCR POINT OF CURB RETURN
PRC POINT OF REVERSE CURVE
PT POINT OF TANGENT
EL ELEVATION
LT LEFT
RT RIGHT

Subject: ABBREVIATION LEGEND - CENTERLINE INTERSECTION CENTERLINE INTERSECTION
Page Label: 6 INTERSECTION CENTERLINE INTERSECTION
Lock: Unlocked - FLOWLINE INTERSECTION - FLOWLINE INTERSECTION
Status: INTERSECTION FLOWLINE INTERSECTION
Checkmark: Unchecked FLOWLINE INTERSECTION
Author: AutoCAD SHX Text BT BEGIN
Date: TRANSITION BEGIN TRANSITION ET END
Color: TRANSITION END TRANSITION PC POINT OF
CURVE POINT OF CURVE PCC POINT OF
COMPOUND CURVE POINT OF COMPOUND
CURVE PCR POINT OF CURB RETURN
POINT OF CURB RETURN PRC POINT OF REVERSE
CURVE POINT OF REVERSE CURVE PT POINT
OF TANGENT POINT OF TANGENT
EL ELEVATION ELEVATION LT LEFT LEFT
RT RIGHTRIGHT



Subject: FOR BURIED UTILITY INFORMATION
Page Label: 6
Lock: Unlocked
Status:
Checkmark: Unchecked
Author: AutoCAD SHX Text
Date:
Color:

VEMENT PLAN
DATE: 11/10/2017
SHEET 6 OF 8

Subject:
Page Label: 6
Lock: Unlocked
Status:
Checkmark: Unchecked
Author: AutoCAD SHX Text
Date:
Color:

SHEET 6 OF 8

CAUTION

Subject:
Page Label: 6
Lock: Unlocked
Status:
Checkmark: Unchecked
Author: AutoCAD SHX Text
Date:
Color:

CAUTION

0+00

Subject:
Page Label: 6
Lock: Unlocked
Status:
Checkmark: Unchecked
Author: AutoCAD SHX Text
Date:
Color:

0+00

RANCH PLAN
ENT PLANS
11/10/2017
SHEET 6 OF 8

Subject:
Page Label: 6
Lock: Unlocked
Status:
Checkmark: Unchecked
Author: AutoCAD SHX Text
Date:
Color:

11/10/2017

1" =


Subject:
Page Label: 6
Lock: Unlocked
Status:
Checkmark: Unchecked
Author: AutoCAD SHX Text
Date:
Color:

1" =

S
PROJECT NO. 02
DESIGNED BY:
DRAWN BY:
CHECKED BY:

Subject:
Page Label: 6
Lock: Unlocked
Status:
Checkmark: Unchecked
Author: AutoCAD SHX Text
Date:
Color:

DESIGNED BY:

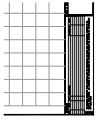


Subject:
Page Label: 6
Lock: Unlocked
Status:
Checkmark: Unchecked
Author: AutoCAD SHX Text
Date:
Color:

THE ENGINEER PREPARING THESE PLANS
 WILL NOT BE RESPONSIBLE, OR LIABLE FOR,
 UNAUTHORIZED CHANGES TO OR USES OF
 THESE PLANS. ALL CHANGES TO THE PLANS
 MUST BE IN WRITING AND MUST BE
 APPROVED BY THE PREPARER OF THESE
 PLANS.

7040

Subject:
Page Label: 6
Lock: Unlocked
Status:
Checkmark: Unchecked
Author: AutoCAD SHX Text
Date:
Color:

7040

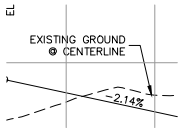

Subject:
Page Label: 6
Lock: Unlocked
Status:
Checkmark: Unchecked
Author: AutoCAD SHX Text
Date:
Color:

EXISTING GROUND @ CENTERLINE

7030


Subject:
Page Label: 6
Lock: Unlocked
Status:
Checkmark: Unchecked
Author: AutoCAD SHX Text
Date:
Color:

7030

SCALE:
 HORIZONTAL:
 1"=50'
 VERTICAL:
 1"=5'

Subject:
Page Label: 6
Lock: Unlocked
Status:
Checkmark: Unchecked
Author: AutoCAD SHX Text
Date:
Color:

VERTICAL:

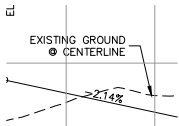

Subject:
Page Label: 6
Lock: Unlocked
Status:
Checkmark: Unchecked
Author: AutoCAD SHX Text
Date:
Color:

EXISTING GROUND @ CENTERLINE

18

Subject: 18
Page Label: 6
Lock: Unlocked
Status:
Checkmark: Unchecked
Author: AutoCAD SHX Text
Date:
Color:

SCALE:
HORIZONTAL
1"=50'
VERTICAL:
1"=5'

Subject: 1"=50'
Page Label: 6
Lock: Unlocked
Status:
Checkmark: Unchecked
Author: AutoCAD SHX Text
Date:
Color:

15

Subject: 15
Page Label: 6
Lock: Unlocked
Status:
Checkmark: Unchecked
Author: AutoCAD SHX Text
Date:
Color:

7035


Subject: 7035
Page Label: 6
Lock: Unlocked
Status:
Checkmark: Unchecked
Author: AutoCAD SHX Text
Date:
Color:

12

Subject: 12
Page Label: 6
Lock: Unlocked
Status:
Checkmark: Unchecked
Author: AutoCAD SHX Text
Date:
Color:



Subject: CALL 1-800-922-1987
Page Label: 6
Lock: Unlocked
Status:
Checkmark: Unchecked
Author: AutoCAD SHX Text
Date:
Color:

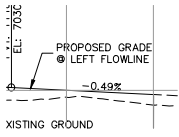

Subject:
Page Label: 7
Lock: Unlocked
Status:
Checkmark: Unchecked
Author: AutoCAD SHX Text
Date:
Color:

PROPOSED GRADE @ LEFT FLOWLINE

50

Subject:
Page Label: 7
Lock: Unlocked
Status:
Checkmark: Unchecked
Author: AutoCAD SHX Text
Date:
Color:

50

7020

Subject:
Page Label: 7
Lock: Unlocked
Status:
Checkmark: Unchecked
Author: AutoCAD SHX Text
Date:
Color:

7020

RANCH FILIN
ENT PLANS
11/10/2017
SET 7 OF 8

Subject:
Page Label: 7
Lock: Unlocked
Status:
Checkmark: Unchecked
Author: AutoCAD SHX Text
Date:
Color:

11/10/2017

VERTICAL
1"=5'


Subject:
Page Label: 7
Lock: Unlocked
Status:
Checkmark: Unchecked
Author: AutoCAD SHX Text
Date:
Color:

1"=5'

7035

Subject:
Page Label: 7
Lock: Unlocked
Status:
Checkmark: Unchecked
Author: AutoCAD SHX Text
Date:
Color:

7035

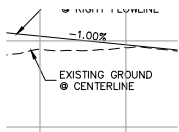

Subject:
Page Label: 7
Lock: Unlocked
Status:
Checkmark: Unchecked
Author: AutoCAD SHX Text
Date:
Color:

EXISTING GROUND @ CENTERLINE




Subject:
Page Label: 7
Lock: Unlocked
Status:
Checkmark: Unchecked
Author: AutoCAD SHX Text
Date:
Color:

1+00

5


Subject:
Page Label: 7
Lock: Unlocked
Status:
Checkmark: Unchecked
Author: AutoCAD SHX Text
Date:
Color:

5

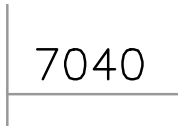


Subject:
Page Label: 7
Lock: Unlocked
Status:
Checkmark: Unchecked
Author: AutoCAD SHX Text
Date:
Color:

7040

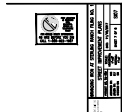

Subject:
Page Label: 7
Lock: Unlocked
Status:
Checkmark: Unchecked
Author: AutoCAD SHX Text
Date:
Color:

BRANDING IRON AT STERLING RANCH FILING NO. 1

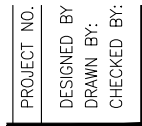

Subject:
Page Label: 7
Lock: Unlocked
Status:
Checkmark: Unchecked
Author: AutoCAD SHX Text
Date:
Color:

DRAWN BY:

7035

Subject: 7035
Page Label: 7
Lock: Unlocked
Status:
Checkmark: Unchecked
Author: AutoCAD SHX Text
Date:
Color:

VAS
ELY
GW

Subject: ELY
Page Label: 7
Lock: Unlocked
Status:
Checkmark: Unchecked
Author: AutoCAD SHX Text
Date:
Color:



Subject: TRACT 'V'
Page Label: 7
Lock: Unlocked
Status:
Checkmark: Unchecked
Author: AutoCAD SHX Text
Date:
Color:

7035

Subject: 7035
Page Label: 7
Lock: Unlocked
Status:
Checkmark: Unchecked
Author: AutoCAD SHX Text
Date:
Color:

7025

Subject: 7025
Page Label: 7
Lock: Unlocked
Status:
Checkmark: Unchecked
Author: AutoCAD SHX Text
Date:
Color:

25

Subject: 25
Page Label: 7
Lock: Unlocked
Status:
Checkmark: Unchecked
Author: AutoCAD SHX Text
Date:
Color:


RT RIGHT

STREET ABBREVIATIONS

KC KINTLA COURT
LGW LODGE GRASS WAY
MW MOSBY WAY
OW SPRAGUE WAY
WW WHITEFISH WAY
DB DINES BOULEVARD (EX.)
CDS CUL-DE-SAC


Subject:
Page Label: 7
Lock: Unlocked
Status:
Checkmark: Unchecked
Author: AutoCAD SHX Text
Date:
Color:

STREET ABBREVIATIONS KC KINTLA COURT
KINTLA COURT LGW LODGE GRASS WAY
LODGE GRASS WAY MW MOSBY WAY MOSBY
WAY SW SPRAGUE WAY SPRAGUE WAY
WW WHITEFISH WAY WHITEFISH WAY
DB DINES BOULEVARD (EX.) DINES
BOULEVARD (EX.)
CDS CUL-DE-SACCUL-DE-SAC

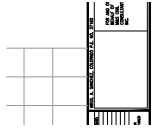

Subject:
Page Label: 7
Lock: Unlocked
Status:
Checkmark: Unchecked
Author: AutoCAD SHX Text
Date:
Color:

VIRGIL A. SANCHEZ, COLORADO P.E. NO.
37160

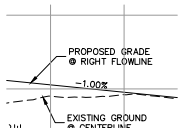


Subject:
Page Label: 7
Lock: Unlocked
Status:
Checkmark: Unchecked
Author: AutoCAD SHX Text
Date:
Color:

PROPOSED GRADE @ RIGHT FLOWLINE

ABBREVIATION LEGEND
I-I CENTERLINE INTERSECTION
F-F FLOWLINE INTERSECTION
BT BEGIN TRANSITION
ET END TRANSITION
PC POINT OF CURVE
PCC POINT OF COMPOUND CURVE
PCR POINT OF CURB RETURN
PRC POINT OF REVERSE CURVE
PT POINT OF TANGENT
EL ELEVATION
LT LEFT
RT RIGHT

Subject:
Page Label: 7
Lock: Unlocked
Status:
Checkmark: Unchecked
Author: AutoCAD SHX Text
Date:
Color:

ABBREVIATION LEGEND - CENTERLINE
INTERSECTION CENTERLINE INTERSECTION
- FLOWLINE INTERSECTION - FLOWLINE
INTERSECTION FLOWLINE INTERSECTION
FLOWLINE INTERSECTION BT BEGIN
TRANSITION BEGIN TRANSITION ET END
TRANSITION END TRANSITION PC POINT OF
CURVE POINT OF CURVE PCC POINT OF
COMPOUND CURVE POINT OF COMPOUND
CURVE PCR POINT OF CURB RETURN POINT
OF CURB RETURN PRC POINT OF REVERSE
CURVE POINT OF REVERSE CURVE PT POINT
OF TANGENT POINT OF TANGENT
EL ELEVATION ELEVATION LT LEFT LEFT
RT RIGHTRIGHT

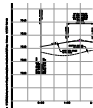

Subject:
Page Label: 7
Lock: Unlocked
Status:
Checkmark: Unchecked
Author: AutoCAD SHX Text
Date:
Color:

File: O:\09006A\Sterling Ranch No 3\dwg\Const
Dwg\Street Plans\Residential\SI07.dwg
Plotstamp: 11/7/2017 10:41 AM



Subject:
Page Label: 7
Lock: Unlocked
Status:
Checkmark: Unchecked
Author: AutoCAD SHX Text
Date:
Color:

CAUTION

1

Subject: 1
Page Label: 7
Lock: Unlocked
Status:
Checkmark: Unchecked
Author: AutoCAD SHX Text
Date:
Color:

7040

Subject: 7040
Page Label: 7
Lock: Unlocked
Status:
Checkmark: Unchecked
Author: AutoCAD SHX Text
Date:
Color:

3+00

Subject: 3+00
Page Label: 7
Lock: Unlocked
Status:
Checkmark: Unchecked
Author: AutoCAD SHX Text
Date:
Color:

7030

Subject: 7030
Page Label: 7
Lock: Unlocked
Status:
Checkmark: Unchecked
Author: AutoCAD SHX Text
Date:
Color:

2

Subject: 2
Page Label: 7
Lock: Unlocked
Status:
Checkmark: Unchecked
Author: AutoCAD SHX Text
Date:
Color:

10

Subject: 10
Page Label: 7
Lock: Unlocked
Status:
Checkmark: Unchecked
Author: AutoCAD SHX Text
Date:
Color:

7025

Subject:
Page Label: 7
Lock: Unlocked
Status:
Checkmark: Unchecked
Author: AutoCAD SHX Text
Date:
Color:

7025

0+00

Subject:
Page Label: 7
Lock: Unlocked
Status:
Checkmark: Unchecked
Author: AutoCAD SHX Text
Date:
Color:

0+00

VEHICLE PLAN	DATE: 11/10/201
	SHEET 7 OF 8

Subject:
Page Label: 7
Lock: Unlocked
Status:
Checkmark: Unchecked
Author: AutoCAD SHX Text
Date:
Color:

SHEET 7 OF 8

DRAWING	S
	PROJECT NO. 0
	DESIGNED BY:
	DRAWN BY: CHECKED BY:


Subject:
Page Label: 7
Lock: Unlocked
Status:
Checkmark: Unchecked
Author: AutoCAD SHX Text
Date:
Color:

PROJECT NO.

50'


Subject:
Page Label: 7
Lock: Unlocked
Status:
Checkmark: Unchecked
Author: AutoCAD SHX Text
Date:
Color:

50'

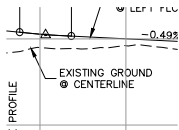

Subject:
Page Label: 7
Lock: Unlocked
Status:
Checkmark: Unchecked
Author: AutoCAD SHX Text
Date:
Color:

EXISTING GROUND @ CENTERLINE

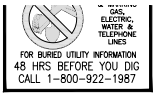

Subject:
Page Label: 7
Lock: Unlocked
Status:
Checkmark: Unchecked
Author: AutoCAD SHX Text
Date:
Color:

48 HRS BEFORE YOU DIG

6

Subject:
Page Label: 7
Lock: Unlocked
Status:
Checkmark: Unchecked
Author: AutoCAD SHX Text
Date:
Color:

6

13

Subject:
Page Label: 7
Lock: Unlocked
Status:
Checkmark: Unchecked
Author: AutoCAD SHX Text
Date:
Color:

13

REF | NO. |

Subject:
Page Label: 7
Lock: Unlocked
Status:
Checkmark: Unchecked
Author: AutoCAD SHX Text
Date:
Color:

NO.

0


Subject:
Page Label: 7
Lock: Unlocked
Status:
Checkmark: Unchecked
Author: AutoCAD SHX Text
Date:
Color:

0

7035

Subject:
Page Label: 7
Lock: Unlocked
Status:
Checkmark: Unchecked
Author: AutoCAD SHX Text
Date:
Color:

7035

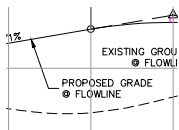


Subject:
Page Label: 7
Lock: Unlocked
Status:
Checkmark: Unchecked
Author: AutoCAD SHX Text
Date:
Color:

PROPOSED GRADE @ FLOWLINE

IONS:
DATE:

Subject:
Page Label: 7
Lock: Unlocked
Status:
Checkmark: Unchecked
Author: AutoCAD SHX Text
Date:
Color:

DATE:

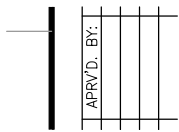

Subject:
Page Label: 7
Lock: Unlocked
Status:
Checkmark: Unchecked
Author: AutoCAD SHX Text
Date:
Color:

APRV'D. BY:

.=7028.43

TRACT 'DD'

Subject:
Page Label: 7
Lock: Unlocked
Status:
Checkmark: Unchecked
Author: AutoCAD SHX Text
Date:
Color:

TRACT 'DD'

7035

Subject:
Page Label: 7
Lock: Unlocked
Status:
Checkmark: Unchecked
Author: AutoCAD SHX Text
Date:
Color:

7035

DATE:

Subject:
Page Label: 7
Lock: Unlocked
Status:
Checkmark: Unchecked
Author: AutoCAD SHX Text
Date:
Color:

DATE:

7030

Subject:
Page Label: 7
Lock: Unlocked
Status:
Checkmark: Unchecked
Author: AutoCAD SHX Text
Date:
Color:

7030

DESCRIPTION:

Subject:
Page Label: 7
Lock: Unlocked
Status:
Checkmark: Unchecked
Author: AutoCAD SHX Text
Date:
Color:

DESCRIPTION:

REVISIONS:
NO. DATE:

Subject:
Page Label: 7
Lock: Unlocked
Status:
Checkmark: Unchecked
Author: AutoCAD SHX Text
Date:
Color:

REVISIONS:

25 50
Scale in Feet

Subject:
Page Label: 7
Lock: Unlocked
Status:
Checkmark: Unchecked
Author: AutoCAD SHX Text
Date:
Color:

Scale in Feet

ELL
GW

Subject:
Page Label: 7
Lock: Unlocked
Status:
Checkmark: Unchecked
Author: AutoCAD SHX Text
Date:
Color:

GW

7025

Subject:
Page Label: 7
Lock: Unlocked
Status:
Checkmark: Unchecked
Author: AutoCAD SHX Text
Date:
Color:

7025

3

Subject:
Page Label: 7
Lock: Unlocked
Status:
Checkmark: Unchecked
Author: AutoCAD SHX Text
Date:
Color:

3

7030

Subject:
Page Label: 7
Lock: Unlocked
Status:
Checkmark: Unchecked
Author: AutoCAD SHX Text
Date:
Color:


7030

7

Subject:
Page Label: 7
Lock: Unlocked
Status:
Checkmark: Unchecked
Author: AutoCAD SHX Text
Date:
Color:

7

10

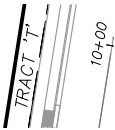

Subject:
Page Label: 7
Lock: Unlocked
Status:
Checkmark: Unchecked
Author: AutoCAD SHX Text
Date:
Color:

TRACT 'T'

PROJECT NO. 01
DESIGNED BY:
DRAWN BY:
CHECKED BY:

Subject:
Page Label: 7
Lock: Unlocked
Status:
Checkmark: Unchecked
Author: AutoCAD SHX Text
Date:
Color:

CHECKED BY:

IMPR'
SCALE:
HORIZONTAL
1"=50'

Subject:
Page Label: 7
Lock: Unlocked
Status:
Checkmark: Unchecked
Author: AutoCAD SHX Text
Date:
Color:

SCALE:

2+00

Subject: 2+00
Page Label: 7
Lock: Unlocked
Status:
Checkmark: Unchecked
Author: AutoCAD SHX Text
Date:
Color:

DATE:

Subject: DATE:
Page Label: 7
Lock: Unlocked
Status:
Checkmark: Unchecked
Author: AutoCAD SHX Text
Date:
Color:

ET IMPROV
SCALE:
HORIZONTAL:
1"=50'
VERTICAL:
1"=5'

Subject: HORIZONTAL:
Page Label: 7
Lock: Unlocked
Status:
Checkmark: Unchecked
Author: AutoCAD SHX Text
Date:
Color:

S
PROJECT NO. 06
DESIGNED BY:
DRAWN BY:
CHECKED BY:

Subject: DESIGNED BY:
Page Label: 7
Lock: Unlocked
Status:
Checkmark: Unchecked
Author: AutoCAD SHX Text
Date:
Color:

9

Subject: 9
Page Label: 7
Lock: Unlocked
Status:
Checkmark: Unchecked
Author: AutoCAD SHX Text
Date:
Color:

4

Subject: 4
Page Label: 7
Lock: Unlocked
Status:
Checkmark: Unchecked
Author: AutoCAD SHX Text
Date:
Color:


7025

Subject: 7025
Page Label: 7
Lock: Unlocked
Status:
Checkmark: Unchecked
Author: AutoCAD SHX Text
Date:
Color:

TRACT 'K'

XIST PCR

Subject: TRACT 'K'
Page Label: 7
Lock: Unlocked
Status:
Checkmark: Unchecked
Author: AutoCAD SHX Text
Date:
Color:

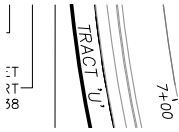


Subject: TRACT 'U'
Page Label: 7
Lock: Unlocked
Status:
Checkmark: Unchecked
Author: AutoCAD SHX Text
Date:
Color:



Subject: TRACT 'M'
Page Label: 7
Lock: Unlocked
Status:
Checkmark: Unchecked
Author: AutoCAD SHX Text
Date:
Color:

100

Subject: 100
Page Label: 7
Lock: Unlocked
Status:
Checkmark: Unchecked
Author: AutoCAD SHX Text
Date:
Color:

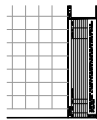

Subject:
Page Label: 7
Lock: Unlocked
Status:
Checkmark: Unchecked
Author: AutoCAD SHX Text
Date:
Color:

THE ENGINEER PREPARING THESE PLANS WILL NOT BE RESPONSIBLE, OR LIABLE FOR, UNAUTHORIZED CHANGES TO OR USES OF THESE PLANS. ALL CHANGES TO THE PLANS MUST BE IN WRITING AND MUST BE APPROVED BY THE PREPARER OF THESE PLANS.

7020

Subject: 7020
Page Label: 7
Lock: Unlocked
Status:
Checkmark: Unchecked
Author: AutoCAD SHX Text
Date:
Color:

11

Subject: 11
Page Label: 7
Lock: Unlocked
Status:
Checkmark: Unchecked
Author: AutoCAD SHX Text
Date:
Color:

12

Subject: 12
Page Label: 7
Lock: Unlocked
Status:
Checkmark: Unchecked
Author: AutoCAD SHX Text
Date:
Color:

7030

Subject: 7030
Page Label: 7
Lock: Unlocked
Status:
Checkmark: Unchecked
Author: AutoCAD SHX Text
Date:
Color:

STREE
|
| . 09-006
| VAS ETV

Subject: 09-006
Page Label: 7
Lock: Unlocked
Status:
Checkmark: Unchecked
Author: AutoCAD SHX Text
Date:
Color:


1+00

Subject: 1+00
Page Label: 7
Lock: Unlocked
Status:
Checkmark: Unchecked
Author: AutoCAD SHX Text
Date:
Color:

SCALE:
HORIZONTAL:
1"=50'
VERTICAL:
1"=5'

Subject:
Page Label: 7
Lock: Unlocked
Status:
Checkmark: Unchecked
Author: AutoCAD SHX Text
Date:
Color:

VERTICAL:

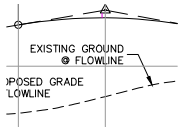

Subject:
Page Label: 7
Lock: Unlocked
Status:
Checkmark: Unchecked
Author: AutoCAD SHX Text
Date:
Color:

EXISTING GROUND @ FLOWLINE

7035

Subject:
Page Label: 7
Lock: Unlocked
Status:
Checkmark: Unchecked
Author: AutoCAD SHX Text
Date:
Color:

7035

2+00

TO ST

Subject:
Page Label: 7
Lock: Unlocked
Status:
Checkmark: Unchecked
Author: AutoCAD SHX Text
Date:
Color:

2+00

FOR AND ON
BEHALF OF
M&S CIVIL
CONSULTANTS,
INC.

Subject:
Page Label: 7
Lock: Unlocked
Status:
Checkmark: Unchecked
Author: AutoCAD SHX Text
Date:
Color:

FOR AND ON BEHALF OF M&S CIVIL
CONSULTANTS, INC.

7025

Subject:
Page Label: 7
Lock: Unlocked
Status:
Checkmark: Unchecked
Author: AutoCAD SHX Text
Date:
Color:

7025

7030

Subject: 7030
Page Label: 7
Lock: Unlocked
Status:
Checkmark: Unchecked
Author: AutoCAD SHX Text
Date:
Color:

SCALE:
HORIZONTAL
1"=50'
VERTICAL:
1"=5'

Subject: 1"=50'
Page Label: 7
Lock: Unlocked
Status:
Checkmark: Unchecked
Author: AutoCAD SHX Text
Date:
Color:

0+00

Subject: 0+00
Page Label: 7
Lock: Unlocked
Status:
Checkmark: Unchecked
Author: AutoCAD SHX Text
Date:
Color:

7030

Subject: 7030
Page Label: 7
Lock: Unlocked
Status:
Checkmark: Unchecked
Author: AutoCAD SHX Text
Date:
Color:

7025

Subject: 7025
Page Label: 7
Lock: Unlocked
Status:
Checkmark: Unchecked
Author: AutoCAD SHX Text
Date:
Color:

1" =

Subject: 1" =
Page Label: 7
Lock: Unlocked
Status:
Checkmark: Unchecked
Author: AutoCAD SHX Text
Date:
Color:



Subject:
Page Label: 9
Lock: Unlocked
Status:
Checkmark: Unchecked
Author: AutoCAD SHX Text
Date:
Color:

GENERAL NOTES 1. ALL UTILITY CONSTRUCTION TO BE CONDUCTED IN CONFORMANCE WITH THE CURRENT STERLING RANCH METROPOLITAN ALL UTILITY CONSTRUCTION TO BE CONDUCTED IN CONFORMANCE WITH THE CURRENT STERLING RANCH METROPOLITAN THE JOB SITE SHALL BE SIGNED BY THE DISTRICT AND THE DISTRICT'S ENGINEER. ANY REVISION TO

SCALE:
HORIZONTAL
1"=50'
VERTICAL:
1"=5'

Subject: 1"=50'
Page Label: 9
Lock: Unlocked
Status:
Checkmark: Unchecked
Author: AutoCAD SHX Text
Date:
Color:

VERTICAL
1"=5'

Subject: 1"=5'
Page Label: 9
Lock: Unlocked
Status:
Checkmark: Unchecked
Author: AutoCAD SHX Text
Date:
Color:



Subject: CAUTION
Page Label: 9
Lock: Unlocked
Status:
Checkmark: Unchecked
Author: AutoCAD SHX Text
Date:
Color:

ELI
GW

Subject: GW
Page Label: 9
Lock: Unlocked
Status:
Checkmark: Unchecked
Author: AutoCAD SHX Text
Date:
Color:



Subject: POWERS BLVD
Page Label: 9
Lock: Unlocked
Status:
Checkmark: Unchecked
Author: AutoCAD SHX Text
Date:
Color:




MAP

Subject: MARKSHEFFEL RD
Page Label: 9
Lock: Unlocked
Status:
Checkmark: Unchecked
Author: AutoCAD SHX Text
Date:
Color:

DATE:

Subject:
Page Label: 9
Lock: Unlocked
Status:
Checkmark: Unchecked
Author: AutoCAD SHX Text
Date:
Color:

DATE:

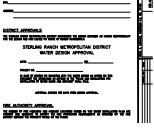

Subject:
Page Label: 9
Lock: Unlocked
Status:
Checkmark: Unchecked
Author: AutoCAD SHX Text
Date:
Color:

DISTRICT APPROVALS THE STERLING RANCH METROPOLITAN DISTRICT RECOGNIZES THE DESIGN ENGINEER AS HAVING RESPONSIBILITY STERLING RANCH METROPOLITAN DISTRICT WATER DESIGN APPROVAL DATE: BY: BY: PROJECT NO. IN CASE OF ERRORS OR OMISSIONS WITH THE WATER DESIGN AS SHOWN ON THIS DOCUMENT THE STANDARDS AS DEFINED IN THE "RULES AND REGULATIONS FOR INSTALLATION OF WATER MAINS AND SERVICES" SHALL RULE. APPROVAL EXPIRES 180 DAYS FROM DESIGN APPROVAL.

STERLING
(FUTURE) RAI

Subject:
Page Label: 9
Lock: Unlocked
Status:
Checkmark: Unchecked
Author: AutoCAD SHX Text
Date:
Color:

STERLING

SCALE:
HORIZONTAL:
1"=50'
VERTICAL:
1"=5'

Subject:
Page Label: 9
Lock: Unlocked
Status:
Checkmark: Unchecked
Author: AutoCAD SHX Text
Date:
Color:

VERTICAL:

WT01

Subject:
Page Label: 9
Lock: Unlocked
Status:
Checkmark: Unchecked
Author: AutoCAD SHX Text
Date:
Color:

WT01

2/1/00

FOR AND ON
BEHALF OF
M&S CIVIL
CONSULTANTS,
INC.


Subject:
Page Label: 9
Lock: Unlocked
Status:
Checkmark: Unchecked
Author: AutoCAD SHX Text
Date:
Color:

FOR AND ON BEHALF OF M&S CIVIL
CONSULTANTS, INC.




Subject:
Page Label: 9
Lock: Unlocked
Status:
Checkmark: Unchecked
Author: AutoCAD SHX Text
Date:
Color:

WATER SYSTEM INSTALLATION NOTES 1. ALL WATER AND FORCE MAIN PIPE SHALL BE AWWA C900 PVC, OR EQUAL, PRESSURE CLASS 200. ALL WATER AND FORCE MAIN FITTINGS SHALL HAVE ALL WATER AND FORCE MAIN PIPE SHALL BE AWWA C900 PVC, OR EQUAL, PRESSURE CLASS 200. 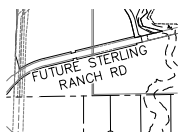

Subject:
Page Label: 9
Lock: Unlocked
Status:
Checkmark: Unchecked
Author: AutoCAD SHX Text
Date:
Color:

FUTURE STERLING RANCH RD

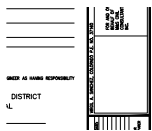

Subject:
Page Label: 9
Lock: Unlocked
Status:
Checkmark: Unchecked
Author: AutoCAD SHX Text
Date:
Color:

VIRGIL A. SANCHEZ, COLORADO P.E. NO. 37160

COWPOKE RD

Subject:
Page Label: 9
Lock: Unlocked
Status:
Checkmark: Unchecked
Author: AutoCAD SHX Text
Date:
Color:

COWPOKE RD



Subject:
Page Label: 9
Lock: Unlocked
Status:
Checkmark: Unchecked
Author: AutoCAD SHX Text
Date:
Color:

RANCH RD

VAS
ELY
GW

Subject:
Page Label: 9
Lock: Unlocked
Status:
Checkmark: Unchecked
Author: AutoCAD SHX Text
Date:
Color:

ELY




Subject:
Page Label: 9
Lock: Unlocked
Status:
Checkmark: Unchecked
Author: AutoCAD SHX Text
Date:
Color:

HORIZONTAL:

VAS
ELY


Subject:
Page Label: 9
Lock: Unlocked
Status:
Checkmark: Unchecked
Author: AutoCAD SHX Text
Date:
Color:

VAS

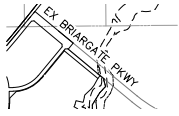

Subject:
Page Label: 9
Lock: Unlocked
Status:
Checkmark: Unchecked
Author: AutoCAD SHX Text
Date:
Color:

EX BRIARGATE PKWY

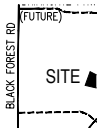

Subject:
Page Label: 9
Lock: Unlocked
Status:
Checkmark: Unchecked
Author: AutoCAD SHX Text
Date:
Color:

BLACK FOREST RD



Subject:
Page Label: 9
Lock: Unlocked
Status:
Checkmark: Unchecked
Author: AutoCAD SHX Text
Date:
Color:

CALL 1-800-922-1987

WATEF
SCALE:
HORIZONTAL
1" = 50'


Subject:
Page Label: 9
Lock: Unlocked
Status:
Checkmark: Unchecked
Author: AutoCAD SHX Text
Date:
Color:

SCALE:




Subject:
Page Label: 9
Lock: Unlocked
Status:
Checkmark: Unchecked
Author: AutoCAD SHX Text
Date:
Color:

BRANDING IRON AT STERLING RANCH FILING NO. 1

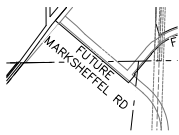


Subject:
Page Label: 9
Lock: Unlocked
Status:
Checkmark: Unchecked
Author: AutoCAD SHX Text
Date:
Color:

FUTURE MARKSHEFFEL RD

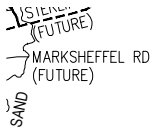

Subject:
Page Label: 9
Lock: Unlocked
Status:
Checkmark: Unchecked
Author: AutoCAD SHX Text
Date:
Color:

MARKSHEFFEL RD (FUTURE)

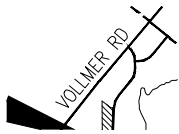

Subject:
Page Label: 9
Lock: Unlocked
Status:
Checkmark: Unchecked
Author: AutoCAD SHX Text
Date:
Color:

VOLLMER RD



Subject:
Page Label: 9
Lock: Unlocked
Status:
Checkmark: Unchecked
Author: AutoCAD SHX Text
Date:
Color:

PROJECT NO.



Subject:
Page Label: 9
Lock: Unlocked
Status:
Checkmark: Unchecked
Author: AutoCAD SHX Text
Date:
Color:


CHECKED BY:



Subject:
Page Label: 9
Lock: Unlocked
Status:
Checkmark: Unchecked
Author: AutoCAD SHX Text
Date:
Color:

FIRE AUTHORITY APPROVAL THE NUMBER OF
FIRE HYDRANTS AND HYDRANT LOCATIONS
SHOWN ON THIS WATER INSTALLATION PLAN
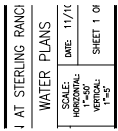

Subject: WATER PLANS
Page Label: 9
Lock: Unlocked
Status:
Checkmark: Unchecked
Author: AutoCAD SHX Text
Date:
Color:

WATER PLANS



Subject: SITE MAP N.T.S.
Page Label: 9
Lock: Unlocked
Status:
Checkmark: Unchecked
Author: AutoCAD SHX Text
Date:
Color:

SITE MAP N.T.S.



Subject: THE ENGINEER PREPARING THESE PLANS
Page Label: 9
Lock: Unlocked
Status:
Checkmark: Unchecked
Author: AutoCAD SHX Text
Date:
Color:

THE ENGINEER PREPARING THESE PLANS
 WILL NOT BE RESPONSIBLE, OR LIABLE FOR,
 UNAUTHORIZED CHANGES TO OR USES OF
 THESE PLANS. ALL CHANGES TO THE PLANS
 MUST BE IN WRITING AND MUST BE
 APPROVED BY THE PREPARER OF THESE
 PLANS.



Subject: DATE:
Page Label: 9
Lock: Unlocked
Status:
Checkmark: Unchecked
Author: AutoCAD SHX Text
Date:
Color:

DATE:




Subject: (STERLING (FUTURE))
Page Label: 9
Lock: Unlocked
Status:
Checkmark: Unchecked
Author: AutoCAD SHX Text
Date:
Color:

(FUTURE)




Subject: FOR BURIED UTILITY INFORMATION
Page Label: 9
Lock: Unlocked
Status:
Checkmark: Unchecked
Author: AutoCAD SHX Text
Date:
Color:

FOR BURIED UTILITY INFORMATION

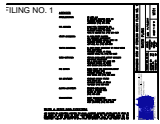

Subject:
Page Label: 9
Lock: Unlocked
Status:
Checkmark: Unchecked
Author: AutoCAD SHX Text
Date:
Color:

AGENCIES OWNER/DEVELOPER: SR LAND, LLC SR LAND, LLC 20 BOULDER CRESCENT, SUITE 201 , SUITE 201 COLORADO SPRINGS, CO 80903 JIM MORLEY (719) 471-1742 CIVIL ENGINEER: M & S CIVIL CONSULTANTS, INC. M & S CIVIL CONSULTANTS, INC. 20 BOULDER CRESCENT, SUITE 110 COLORADO SPRINGS, CO 80903 VIRGIL A. SANCHEZ P.E. (719) 955-5485 COUNTY ENGINEERING: EL PASO COUNTY PLANNING EL PASO COUNTY PLANNING AND COMMUNITY DEVELOPMENT 2880 INTERNATIONAL CIRCLE, SUITE 110 COLORADO SPRINGS, CO 80910 JEFF RICE, P.E. (719) 520-6300 TRAFFIC ENGINEERING: EL PASO COUNTY DEPARTMENT OF PUBLIC WORKS EL PASO COUNTY DEPARTMENT OF PUBLIC WORKS 3275 AKERS DRIVE COLORADO SPRINGS, CO 80922 JENNIFER IRVINE, P.E. (719) 520-6460 WATER RESOURCES: STERLING RANCH METRO DISTRICT ENGINEERS STERLING RANCH METRO DISTRICT ENGINEERS JDS-HYDRO CONSULTANTS 545 E. PIKES PEAK AVE., SUITE 300 COLORADO SPRINGS, CO 80903 JOHN MCGINN (719) 668-8769 FIRE DISTRICT: BLACK FOREST FIRE PROTECTION DISTRICT BLACK FOREST FIRE PROTECTION DISTRICT 11445 TEACHOUT ROAD COLORADO SPRINGS, CO 80908 CHIEF BRYAN JACK (719) 495-4300 GAS DEPARTMENT: COLORADO SPRINGS UTILITIES COLORADO SPRINGS UTILITIES 7710 DURANT DR. COLORADO SPRINGS, CO 80947 TIM WENDT (719) 668-3556 ELECTRIC DEPARTMENT: MOUNTAIN VIEW ELECTRIC MOUNTAIN VIEW ELECTRIC 11140 E. WOODMEN ROAD FALCON, CO 80831 (719) 495-2283 COMMUNICATIONS: QWEST COMMUNICATIONS QWEST COMMUNICATIONS (U.N.C.C. LOCATORS) (800) 922-1987 AT&T (LOCATORS) (719) 635-3674

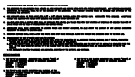

Subject:
Page Label: 9
Lock: Unlocked
Status:
Checkmark: Unchecked
Author: AutoCAD SHX Text
Date:
Color:

BENCHMARKS 1. THE TOP OF AN ALUMINUM SURVEYORS CAP, STAMPED "9853", AT THE TOP OF AN ALUMINUM SURVEYORS CAP, STAMPED "9853", AT THE SOUTHEAST BOUNDARY CORNER OF BARBARICK SUBDIVISION NORTHING = 411416.273 = 411416.273 EASTING = 235167.071 = 235167.071 ELEVATION = 7023.42 = 7023.42 2. THE TOP OF A RED PLASTIC SURVEYORS CAP, ILLEGIBLE, AT THE THE TOP OF A RED PLASTIC SURVEYORS CAP, ILLEGIBLE, AT THE NORTHWEST BOUNDARY CORNER OF PAWNEE RANCHEROS SUBDIVISION NORTHING = 410095.404 = 410095.404 EASTING = 235052.131 = 235052.131 ELEVATION = 7000.40 = 7000.40 3. THE TOP OF A RED PLASTIC SURVEYORS CAP, STAMPED "38141", AT THE TOP OF A RED PLASTIC SURVEYORS CAP, STAMPED "38141", AT THE SOUTHWEST BOUNDARY CORNER OF BARBARICK SUBDISION NORTHING = 411399.962 = 411399.962 EASTING = 233849.817 = 233849.817 ELEVATION = 7030.82= 7030.82

REF
NO.

Subject:
Page Label: 9
Lock: Unlocked
Status:
Checkmark: Unchecked
Author: AutoCAD SHX Text
Date:
Color:

NO.

PROJECT NO.
DESIGNED BY:
DRAWN BY:
CHECKED BY:

Subject:
Page Label: 9
Lock: Unlocked
Status:
Checkmark: Unchecked
Author: AutoCAD SHX Text
Date:
Color:

DRAWN BY:

BRIARGATE PKWY
(FUTURE)
I RD

Subject:
Page Label: 9
Lock: Unlocked
Status:
Checkmark: Unchecked
Author: AutoCAD SHX Text
Date:
Color:

BRIARGATE PKWY

PROJECT NO. 06
DESIGNED BY:
DRAWN BY:
CHECKED BY:

Subject:
Page Label: 9
Lock: Unlocked
Status:
Checkmark: Unchecked
Author: AutoCAD SHX Text
Date:
Color:

DESIGNED BY:

BY:


Subject:
Page Label: 9
Lock: Unlocked
Status:
Checkmark: Unchecked
Author: AutoCAD SHX Text
Date:
Color:

BY:

HUNL
ES
ATION
DIG
987
REVISIONS:
DATE:
NO.:

Subject:
Page Label: 9
Lock: Unlocked
Status:
Checkmark: Unchecked
Author: AutoCAD SHX Text
Date:
Color:

REVISIONS:

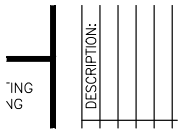


Subject:
Page Label: 9
Lock: Unlocked
Status:
Checkmark: Unchecked
Author: AutoCAD SHX Text
Date:
Color:

DESCRIPTION:



Subject:
Page Label: 9
Lock: Unlocked
Status:
Checkmark: Unchecked
Author: AutoCAD SHX Text
Date:
Color:

BURGESS RD

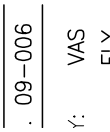

Subject:
Page Label: 9
Lock: Unlocked
Status:
Checkmark: Unchecked
Author: AutoCAD SHX Text
Date:
Color:

09-006



Subject:
Page Label: 9
Lock: Unlocked
Status:
Checkmark: Unchecked
Author: AutoCAD SHX Text
Date:
Color:

File: O:\09006A\Sterling Ranch No 3\dwg\Const
 Dwg\Water Plans\WT01.dwg Plotstamp:
 11/7/2017 8:43 AM



Subject:
Page Label: 9
Lock: Unlocked
Status:
Checkmark: Unchecked
Author: AutoCAD SHX Text
Date:
Color:

EXISTING VOLLMER RD



Subject:
Page Label: 9
Lock: Unlocked
Status:
Checkmark: Unchecked
Author: AutoCAD SHX Text
Date:
Color:

WATER & SEWER MAIN EXTENTIONS ANY CHANGES OR ALTERATIONS AFFECTING THE GRADE, ALIGNMENT, ELEVATION AND/OR DEPTH OF COVER OF APPURTENANCE SHOWN ON THIS DRAWING SHALL BE THE OTHER APPURTENANCE SHOWN ON THIS DRAWING SHALL BE THE 

SIGNED FIRE PROTECTION DISTRICT

SHEET INDEX

SHEET 1 TITLE SHEET
SHEET 2 WATER DISTRICT MAIN PLAN
SHEET 3 UTILITY SERVICE PLAN

Subject:
Page Label: 9
Lock: Unlocked
Status:
Checkmark: Unchecked
Author: AutoCAD SHX Text
Date:
Color:

SHEET INDEX SHEET 1 TITLE SHEET TITLE
SHEET SHEET 2 WATER DISTRICT MAIN PLAN
WATER DISTRICT MAIN PLAN SHEET 3 UTILITY
SERVICE PLAN UTILITY SERVICE PLAN

RANCH FILLIN
INS
11/10/2017
SHEET 1 OF 3

Subject:
Page Label: 9
Lock: Unlocked
Status:
Checkmark: Unchecked
Author: AutoCAD SHX Text
Date:
Color:

11/10/2017

APRVD. BY:

Subject:
Page Label: 9
Lock: Unlocked
Status:
Checkmark: Unchecked
Author: AutoCAD SHX Text
Date:
Color:

APRV'D. BY:

FOR LOCATING & MARKING
GAS,
ELECTRIC,
WATER &
TELEPHONE
LINES
UTILITY INFORMATION

Subject:
Page Label: 9
Lock: Unlocked
Status:
Checkmark: Unchecked
Author: AutoCAD SHX Text
Date:
Color:

FOR LOCATING & MARKING GAS, ELECTRIC,
WATER & TELEPHONE LINES

PLANS
DATE: 11/10/2017
SHEET 1 OF 3

Subject:
Page Label: 9
Lock: Unlocked
Status:
Checkmark: Unchecked
Author: AutoCAD SHX Text
Date:
Color:

SHEET 1 OF 3

E WOODMEN RD
FOREST MEADOWS AVE

VIC

Subject:
Page Label: 9
Lock: Unlocked
Status:
Checkmark: Unchecked
Author: AutoCAD SHX Text
Date:
Color:

FOREST MEADOWS AVE




Subject:
Page Label: 9
Lock: Unlocked
Status:
Checkmark: Unchecked
Author: AutoCAD SHX Text
Date:
Color:

48 HRS BEFORE YOU DIG




Subject:
Page Label: 9
Lock: Unlocked
Status:
Checkmark: Unchecked
Author: AutoCAD SHX Text
Date:
Color:

DATE:

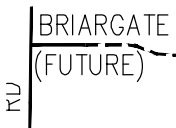

Subject:
Page Label: 9
Lock: Unlocked
Status:
Checkmark: Unchecked
Author: AutoCAD SHX Text
Date:
Color:

(FUTURE)

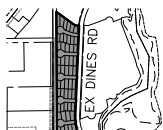

Subject:
Page Label: 9
Lock: Unlocked
Status:
Checkmark: Unchecked
Author: AutoCAD SHX Text
Date:
Color:

EX DINES RD



Subject:
Page Label: 9
Lock: Unlocked
Status:
Checkmark: Unchecked
Author: AutoCAD SHX Text
Date:
Color:

E WOODMEN RD

UNPLATTED

Subject:
Page Label: 10
Lock: Unlocked
Status:
Checkmark: Unchecked
Author: AutoCAD SHX Text
Date:
Color:

UNPLATTED

7

Subject:
Page Label: 10
Lock: Unlocked
Status:
Checkmark: Unchecked
Author: AutoCAD SHX Text
Date:
Color:

7

46

Subject:
Page Label: 10
Lock: Unlocked
Status:
Checkmark: Unchecked
Author: AutoCAD SHX Text
Date:
Color:

46



Subject:
Page Label: 10
Lock: Unlocked
Status:
Checkmark: Unchecked
Author: AutoCAD SHX Text
Date:
Color:

EX 12" PVC SAN SEW

26

Subject:
Page Label: 10
Lock: Unlocked
Status:
Checkmark: Unchecked
Author: AutoCAD SHX Text
Date:
Color:

26

2


Subject:
Page Label: 10
Lock: Unlocked
Status:
Checkmark: Unchecked
Author: AutoCAD SHX Text
Date:
Color:

2

10

Subject:
Page Label: 10
Lock: Unlocked
Status:
Checkmark: Unchecked
Author: AutoCAD SHX Text
Date:
Color:

10

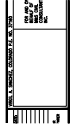

Subject:
Page Label: 10
Lock: Unlocked
Status:
Checkmark: Unchecked
Author: AutoCAD SHX Text
Date:
Color:

VIRGIL A. SANCHEZ, COLORADO P.E. NO. 37160

VAS
ELY

Subject:
Page Label: 10
Lock: Unlocked
Status:
Checkmark: Unchecked
Author: AutoCAD SHX Text
Date:
Color:

VAS

11


Subject:
Page Label: 10
Lock: Unlocked
Status:
Checkmark: Unchecked
Author: AutoCAD SHX Text
Date:
Color:

11

PROJECT NO. 06
DESIGNED BY:
DRAWN BY:
CHECKED BY:


Subject:
Page Label: 10
Lock: Unlocked
Status:
Checkmark: Unchecked
Author: AutoCAD SHX Text
Date:
Color:

DESIGNED BY:

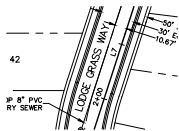

Subject:
Page Label: 10
Lock: Unlocked
Status:
Checkmark: Unchecked
Author: AutoCAD SHX Text
Date:
Color:

LODGE GRASS WAY

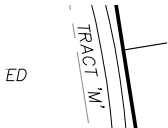

Subject:
Page Label: 10
Lock: Unlocked
Status:
Checkmark: Unchecked
Author: AutoCAD SHX Text
Date:
Color:

TRACT 'M'

45

Subject: 45
Page Label: 10
Lock: Unlocked
Status:
Checkmark: Unchecked
Author: AutoCAD SHX Text
Date:
Color:

8

Subject: 8
Page Label: 10
Lock: Unlocked
Status:
Checkmark: Unchecked
Author: AutoCAD SHX Text
Date:
Color:

20

Subject: 20
Page Label: 10
Lock: Unlocked
Status:
Checkmark: Unchecked
Author: AutoCAD SHX Text
Date:
Color:

UNPLATTED

Subject: UNPLATTED
Page Label: 10
Lock: Unlocked
Status:
Checkmark: Unchecked
Author: AutoCAD SHX Text
Date:
Color:

51

Subject: 51
Page Label: 10
Lock: Unlocked
Status:
Checkmark: Unchecked
Author: AutoCAD SHX Text
Date:
Color:

TRACT 'R'

EX 12" PVC SAN SEW
EX 16" PVC WATER

Subject: EX 12" PVC SAN SEW
Page Label: 10
Lock: Unlocked
Status:
Checkmark: Unchecked
Author: AutoCAD SHX Text
Date:
Color:

TRACT 'Y'

Subject: TRACT 'Y'
Page Label: 10
Lock: Unlocked
Status:
Checkmark: Unchecked
Author: AutoCAD SHX Text
Date:
Color:

21

Subject: 21
Page Label: 10
Lock: Unlocked
Status:
Checkmark: Unchecked
Author: AutoCAD SHX Text
Date:
Color:

ACT 'X'

Subject: TRACT 'X'
Page Label: 10
Lock: Unlocked
Status:
Checkmark: Unchecked
Author: AutoCAD SHX Text
Date:
Color:



Subject: BRANDING IRON AT STERLING RANCH FILING NO. 1
Page Label: 10
Lock: Unlocked
Status:
Checkmark: Unchecked
Author: AutoCAD SHX Text
Date:
Color:

6

Subject: 6
Page Label: 10
Lock: Unlocked
Status:
Checkmark: Unchecked
Author: AutoCAD SHX Text
Date:
Color:

15

Subject: 15
Page Label: 10
Lock: Unlocked
Status:
Checkmark: Unchecked
Author: AutoCAD SHX Text
Date:
Color:

ELI
GW

Subject: GW
Page Label: 10
Lock: Unlocked
Status:
Checkmark: Unchecked
Author: AutoCAD SHX Text
Date:
Color:

09-006

VAS
E1 V


Subject: 09-006
Page Label: 10
Lock: Unlocked
Status:
Checkmark: Unchecked
Author: AutoCAD SHX Text
Date:
Color:

TRACT "G"
STERLING RANCH
FUTURE
RESIDENTIAL

Subject: TRACT "G" STERLING RANCH FUTURE
RESIDENTIAL
Page Label: 10
Lock: Unlocked
Status:
Checkmark: Unchecked
Author: AutoCAD SHX Text
Date:
Color:



Subject: FOR BURIED UTILITY INFORMATION
Page Label: 10
Lock: Unlocked
Status:
Checkmark: Unchecked
Author: AutoCAD SHX Text
Date:
Color:

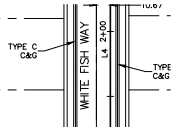

Subject: WHITE FISH WAY
Page Label: 10
Lock: Unlocked
Status:
Checkmark: Unchecked
Author: AutoCAD SHX Text
Date:
Color:

PROJECT NO. 01
DESIGNED BY:
DRAWN BY:
CHECKED BY:

Subject: CHECKED BY:
Page Label: 10
Lock: Unlocked
Status:
Checkmark: Unchecked
Author: AutoCAD SHX Text
Date:
Color:

33

Subject: 33
Page Label: 10
Lock: Unlocked
Status:
Checkmark: Unchecked
Author: AutoCAD SHX Text
Date:
Color:

IONS:
DATE:

Subject: DATE:
Page Label: 10
Lock: Unlocked
Status:
Checkmark: Unchecked
Author: AutoCAD SHX Text
Date:
Color:

TRACT 'R'

Subject: TRACT 'R'
Page Label: 10
Lock: Unlocked
Status:
Checkmark: Unchecked
Author: AutoCAD SHX Text
Date:
Color:

39

Subject: 39
Page Label: 10
Lock: Unlocked
Status:
Checkmark: Unchecked
Author: AutoCAD SHX Text
Date:
Color:

50

Subject: 50
Page Label: 10
Lock: Unlocked
Status:
Checkmark: Unchecked
Author: AutoCAD SHX Text
Date:
Color:

50'

Subject: 50'
Page Label: 10
Lock: Unlocked
Status:
Checkmark: Unchecked
Author: AutoCAD SHX Text
Date:
Color:

35

Subject:
Page Label: 10
Lock: Unlocked
Status:
Checkmark: Unchecked
Author: AutoCAD SHX Text
Date:
Color:

MCCLINTOCK
STATION
LOT C

Subject:
Page Label: 10
Lock: Unlocked
Status:
Checkmark: Unchecked
Author: AutoCAD SHX Text
Date:
Color:

TRACT 'W'

),00
PLUG & ROV ASSY

Subject:
Page Label: 10
Lock: Unlocked
Status:
Checkmark: Unchecked
Author: AutoCAD SHX Text
Date:
Color:

TRACT 'W'

Subject:
Page Label: 10
Lock: Unlocked
Status:
Checkmark: Unchecked
Author: AutoCAD SHX Text
Date:
Color:

PROJECT NO.

Subject:
Page Label: 10
Lock: Unlocked
Status:
Checkmark: Unchecked
Author: AutoCAD SHX Text
Date:
Color:

TRACT 'X'

& ROV ASSY

Subject:
Page Label: 10
Lock: Unlocked
Status:
Checkmark: Unchecked
Author: AutoCAD SHX Text
Date:
Color:

TRACT 'U'

Subject: TRACT 'U'
Page Label: 10
Lock: Unlocked
Status:
Checkmark: Unchecked
Author: AutoCAD SHX Text
Date:
Color:

30

Subject: 30
Page Label: 10
Lock: Unlocked
Status:
Checkmark: Unchecked
Author: AutoCAD SHX Text
Date:
Color:

EX 12" PVC SAN SEW
EX 16" PVC WATER

Subject: EX 12" PVC SAN SEW
Page Label: 10
Lock: Unlocked
Status:
Checkmark: Unchecked
Author: AutoCAD SHX Text
Date:
Color:

EX 12" PVC SAN SEW
EX 16" PVC WATER

Subject: EX 16" PVC WATER
Page Label: 10
Lock: Unlocked
Status:
Checkmark: Unchecked
Author: AutoCAD SHX Text
Date:
Color:

MOSBY WAY

Subject: MOSBY WAY
Page Label: 10
Lock: Unlocked
Status:
Checkmark: Unchecked
Author: AutoCAD SHX Text
Date:
Color:

TRACT 'Q'

Subject: TRACT 'Q'
Page Label: 10
Lock: Unlocked
Status:
Checkmark: Unchecked
Author: AutoCAD SHX Text
Date:
Color:

25

Subject: 25
Page Label: 10
Lock: Unlocked
Status:
Checkmark: Unchecked
Author: AutoCAD SHX Text
Date:
Color:

23

Subject: 23
Page Label: 10
Lock: Unlocked
Status:
Checkmark: Unchecked
Author: AutoCAD SHX Text
Date:
Color:

VAS
ELY
GW

Subject: ELY
Page Label: 10
Lock: Unlocked
Status:
Checkmark: Unchecked
Author: AutoCAD SHX Text
Date:
Color:

41

Subject: 41
Page Label: 10
Lock: Unlocked
Status:
Checkmark: Unchecked
Author: AutoCAD SHX Text
Date:
Color:

UNPLATTED

--- BARB,

Subject: UNPLATTED
Page Label: 10
Lock: Unlocked
Status:
Checkmark: Unchecked
Author: AutoCAD SHX Text
Date:
Color:

49

Subject: 49
Page Label: 10
Lock: Unlocked
Status:
Checkmark: Unchecked
Author: AutoCAD SHX Text
Date:
Color:

9

Subject:
Page Label: 10
Lock: Unlocked
Status:
Checkmark: Unchecked
Author: AutoCAD SHX Text
Date:
Color:

9



Subject:
Page Label: 10
Lock: Unlocked
Status:
Checkmark: Unchecked
Author: AutoCAD SHX Text
Date:
Color:

TRACT "K" STERLING RANCH FUTURE RESIDENTIAL

TRACT 'L'

Subject:
Page Label: 10
Lock: Unlocked
Status:
Checkmark: Unchecked
Author: AutoCAD SHX Text
Date:
Color:

TRACT 'L'

22

Subject:
Page Label: 10
Lock: Unlocked
Status:
Checkmark: Unchecked
Author: AutoCAD SHX Text
Date:
Color:

22

42


Subject:
Page Label: 10
Lock: Unlocked
Status:
Checkmark: Unchecked
Author: AutoCAD SHX Text
Date:
Color:

42

BY:

Subject:
Page Label: 10
Lock: Unlocked
Status:
Checkmark: Unchecked
Author: AutoCAD SHX Text
Date:
Color:

BY:

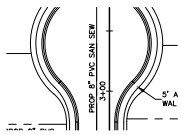


Subject: PROP 8" PVC SAN SEW
Page Label: 10
Lock: Unlocked
Status:
Checkmark: Unchecked
Author: AutoCAD SHX Text
Date:
Color:

PROP 8" PVC SAN SEW

1


Subject: 1
Page Label: 10
Lock: Unlocked
Status:
Checkmark: Unchecked
Author: AutoCAD SHX Text
Date:
Color:

1

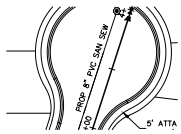


Subject: PROP 8" PVC SAN SEW
Page Label: 10
Lock: Unlocked
Status:
Checkmark: Unchecked
Author: AutoCAD SHX Text
Date:
Color:

PROP 8" PVC SAN SEW

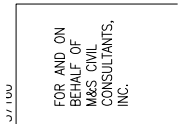

Subject: FOR AND ON BEHALF OF M&S CIVIL CONSULTANTS, INC.
Page Label: 10
Lock: Unlocked
Status:
Checkmark: Unchecked
Author: AutoCAD SHX Text
Date:
Color:

FOR AND ON BEHALF OF M&S CIVIL CONSULTANTS, INC.

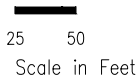

Subject: Scale in Feet
Page Label: 10
Lock: Unlocked
Status:
Checkmark: Unchecked
Author: AutoCAD SHX Text
Date:
Color:

Scale in Feet



Subject: TRACT 'R'
Page Label: 10
Lock: Unlocked
Status:
Checkmark: Unchecked
Author: AutoCAD SHX Text
Date:
Color:

TRACT 'R'

1 AT STERLING RANCH	WATER PLANS	DATE: 11/11	SHEET 2 OF
		SCALE: 1"=50'	
		PROJECT:	

Subject: WATER PLANS
Page Label: 10
Lock: Unlocked
Status:
Checkmark: Unchecked
Author: AutoCAD SHX Text
Date:
Color:

APRV'D. BY:	

Subject: APRV'D. BY:
Page Label: 10
Lock: Unlocked
Status:
Checkmark: Unchecked
Author: AutoCAD SHX Text
Date:
Color:

TRACT 'P'

Subject: TRACT 'P'
Page Label: 10
Lock: Unlocked
Status:
Checkmark: Unchecked
Author: AutoCAD SHX Text
Date:
Color:

44

Subject: 44
Page Label: 10
Lock: Unlocked
Status:
Checkmark: Unchecked
Author: AutoCAD SHX Text
Date:
Color:

16

Subject: 16
Page Label: 10
Lock: Unlocked
Status:
Checkmark: Unchecked
Author: AutoCAD SHX Text
Date:
Color:

TRACT 'Q'
PVC EXISTING DINES BOULEVARD
TRACT 'Y'

Subject: EXISTING DINES BOULEVARD
Page Label: 10
Lock: Unlocked
Status:
Checkmark: Unchecked
Author: AutoCAD SHX Text
Date:
Color:

14

Subject: 14
Page Label: 10
Lock: Unlocked
Status:
Checkmark: Unchecked
Author: AutoCAD SHX Text
Date:
Color:

27

Subject: 27
Page Label: 10
Lock: Unlocked
Status:
Checkmark: Unchecked
Author: AutoCAD SHX Text
Date:
Color:

TRACT "DD"
DETENTION
POND 8

Subject: TRACT "DD" DETENTION POND 8
Page Label: 10
Lock: Unlocked
Status:
Checkmark: Unchecked
Author: AutoCAD SHX Text
Date:
Color:

25

Subject: 25
Page Label: 10
Lock: Unlocked
Status:
Checkmark: Unchecked
Author: AutoCAD SHX Text
Date:
Color:

24

Subject: 24
Page Label: 10
Lock: Unlocked
Status:
Checkmark: Unchecked
Author: AutoCAD SHX Text
Date:
Color:

TRACT 'L'

Subject: TRACT 'L'
Page Label: 10
Lock: Unlocked
Status:
Checkmark: Unchecked
Author: AutoCAD SHX Text
Date:
Color:

17

Subject:
Page Label: 10
Lock: Unlocked
Status:
Checkmark: Unchecked
Author: AutoCAD SHX Text
Date:
Color:

17

TR

Subject:
Page Label: 10
Lock: Unlocked
Status:
Checkmark: Unchecked
Author: AutoCAD SHX Text
Date:
Color:

TRACT 'X'

37

Subject:
Page Label: 10
Lock: Unlocked
Status:
Checkmark: Unchecked
Author: AutoCAD SHX Text
Date:
Color:

37

PLANS
DATE: 11/10/201
SHEET 2 OF 3

Subject:
Page Label: 10
Lock: Unlocked
Status:
Checkmark: Unchecked
Author: AutoCAD SHX Text
Date:
Color:

SHEET 2 OF 3



Subject:
Page Label: 10
Lock: Unlocked
Status:
Checkmark: Unchecked
Author: AutoCAD SHX Text
Date:
Color:

48 HRS BEFORE YOU DIG

UNPLATTED

Subject:
Page Label: 10
Lock: Unlocked
Status:
Checkmark: Unchecked
Author: AutoCAD SHX Text
Date:
Color:

UNPLATTED



Subject: CAUTION
Page Label: 10
Lock: Unlocked
Status:
Checkmark: Unchecked
Author: AutoCAD SHX Text
Date:
Color:

18


Subject: 18
Page Label: 10
Lock: Unlocked
Status:
Checkmark: Unchecked
Author: AutoCAD SHX Text
Date:
Color:

5

Subject: 5
Page Label: 10
Lock: Unlocked
Status:
Checkmark: Unchecked
Author: AutoCAD SHX Text
Date:
Color:



Subject: REVISIONS:
Page Label: 10
Lock: Unlocked
Status:
Checkmark: Unchecked
Author: AutoCAD SHX Text
Date:
Color:

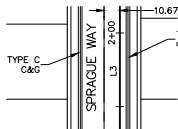

Subject: SPRAGUE WAY
Page Label: 10
Lock: Unlocked
Status:
Checkmark: Unchecked
Author: AutoCAD SHX Text
Date:
Color:

12

Subject: 12
Page Label: 10
Lock: Unlocked
Status:
Checkmark: Unchecked
Author: AutoCAD SHX Text
Date:
Color:

13


Subject:
Page Label: 10
Lock: Unlocked
Status:
Checkmark: Unchecked
Author: AutoCAD SHX Text
Date:
Color:

13

29

Subject:
Page Label: 10
Lock: Unlocked
Status:
Checkmark: Unchecked
Author: AutoCAD SHX Text
Date:
Color:

29

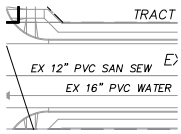


Subject:
Page Label: 10
Lock: Unlocked
Status:
Checkmark: Unchecked
Author: AutoCAD SHX Text
Date:
Color:

EX 12" PVC SAN SEW

28

Subject:
Page Label: 10
Lock: Unlocked
Status:
Checkmark: Unchecked
Author: AutoCAD SHX Text
Date:
Color:

28

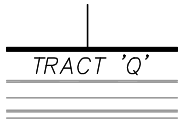

Subject:
Page Label: 10
Lock: Unlocked
Status:
Checkmark: Unchecked
Author: AutoCAD SHX Text
Date:
Color:

TRACT 'Q'




Subject:
Page Label: 10
Lock: Unlocked
Status:
Checkmark: Unchecked
Author: AutoCAD SHX Text
Date:
Color:

TRACT 'L'

47

Subject:
Page Label: 10
Lock: Unlocked
Status:
Checkmark: Unchecked
Author: AutoCAD SHX Text
Date:
Color:

47

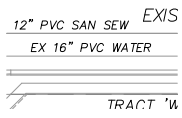


Subject:
Page Label: 10
Lock: Unlocked
Status:
Checkmark: Unchecked
Author: AutoCAD SHX Text
Date:
Color:

EX 16" PVC WATER

43


Subject:
Page Label: 10
Lock: Unlocked
Status:
Checkmark: Unchecked
Author: AutoCAD SHX Text
Date:
Color:

43

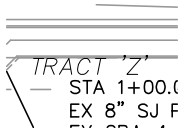


Subject:
Page Label: 10
Lock: Unlocked
Status:
Checkmark: Unchecked
Author: AutoCAD SHX Text
Date:
Color:

TRACT 'Z'

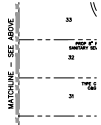

Subject:
Page Label: 10
Lock: Unlocked
Status:
Checkmark: Unchecked
Author: AutoCAD SHX Text
Date:
Color:

MATCHLINE - SEE ABOVE

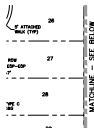

Subject:
Page Label: 10
Lock: Unlocked
Status:
Checkmark: Unchecked
Author: AutoCAD SHX Text
Date:
Color:

MATCHLINE - SEE BELOW

WT02

Subject: WT02
Page Label: 10
Lock: Unlocked
Status:
Checkmark: Unchecked
Author: AutoCAD SHX Text
Date:
Color:

32

Subject: 32
Page Label: 10
Lock: Unlocked
Status:
Checkmark: Unchecked
Author: AutoCAD SHX Text
Date:
Color:

TRACT 'Y'

Subject: TRACT 'Y'
Page Label: 10
Lock: Unlocked
Status:
Checkmark: Unchecked
Author: AutoCAD SHX Text
Date:
Color:

1" =

Subject: 1" =
Page Label: 10
Lock: Unlocked
Status:
Checkmark: Unchecked
Author: AutoCAD SHX Text
Date:
Color:

TRACT 'S'

Subject: TRACT 'S'
Page Label: 10
Lock: Unlocked
Status:
Checkmark: Unchecked
Author: AutoCAD SHX Text
Date:
Color:

50

Subject: 50
Page Label: 10
Lock: Unlocked
Status:
Checkmark: Unchecked
Author: AutoCAD SHX Text
Date:
Color:

TRACT "F"
DETENTION
R POND 8

Subject:
Page Label: 10
Lock: Unlocked
Status:
Checkmark: Unchecked
Author: AutoCAD SHX Text
Date:
Color:

TRACT "F" DETENTION POND 8

38

Subject:
Page Label: 10
Lock: Unlocked
Status:
Checkmark: Unchecked
Author: AutoCAD SHX Text
Date:
Color:

38

KRANCH FILIN
NS
11/10/2017
:ET 2 OF 3

Subject:
Page Label: 10
Lock: Unlocked
Status:
Checkmark: Unchecked
Author: AutoCAD SHX Text
Date:
Color:

11/10/2017

BARBARICK
SUBDIVISION
LOT 3

Subject:
Page Label: 10
Lock: Unlocked
Status:
Checkmark: Unchecked
Author: AutoCAD SHX Text
Date:
Color:

BARBARICK SUBDIVISION LOT 3

3

Subject:
Page Label: 10
Lock: Unlocked
Status:
Checkmark: Unchecked
Author: AutoCAD SHX Text
Date:
Color:

3

TRACT 'T'

Subject:
Page Label: 10
Lock: Unlocked
Status:
Checkmark: Unchecked
Author: AutoCAD SHX Text
Date:
Color:

TRACT 'T'

34

Subject:
Page Label: 10
Lock: Unlocked
Status:
Checkmark: Unchecked
Author: AutoCAD SHX Text
Date:
Color:

34



Subject:
Page Label: 10
Lock: Unlocked
Status:
Checkmark: Unchecked
Author: AutoCAD SHX Text
Date:
Color:

File: O:\09006A\Sterling Ranch No 3\dwg\Const
Dwg\Water Plans\WT02.dwg Plotstamp:
11/7/2017 9:03 AM

I - JU
VERTICAL
1" = 5'

Subject:
Page Label: 10
Lock: Unlocked
Status:
Checkmark: Unchecked
Author: AutoCAD SHX Text
Date:
Color:

1"=5'

48

Subject:
Page Label: 10
Lock: Unlocked
Status:
Checkmark: Unchecked
Author: AutoCAD SHX Text
Date:
Color:

48

DATE:


Subject:
Page Label: 10
Lock: Unlocked
Status:
Checkmark: Unchecked
Author: AutoCAD SHX Text
Date:
Color:

DATE:

4


Subject:
Page Label: 10
Lock: Unlocked
Status:
Checkmark: Unchecked
Author: AutoCAD SHX Text
Date:
Color:

4

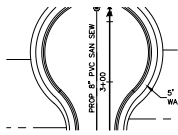


Subject:
Page Label: 10
Lock: Unlocked
Status:
Checkmark: Unchecked
Author: AutoCAD SHX Text
Date:
Color:

PROP 8" PVC SAN SEW

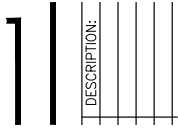

Subject:
Page Label: 10
Lock: Unlocked
Status:
Checkmark: Unchecked
Author: AutoCAD SHX Text
Date:
Color:

DESCRIPTION:

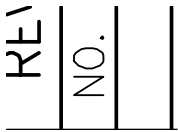

Subject:
Page Label: 10
Lock: Unlocked
Status:
Checkmark: Unchecked
Author: AutoCAD SHX Text
Date:
Color:

NO.



Subject:
Page Label: 10
Lock: Unlocked
Status:
Checkmark: Unchecked
Author: AutoCAD SHX Text
Date:
Color:

VERTICAL:




Subject:
Page Label: 10
Lock: Unlocked
Status:
Checkmark: Unchecked
Author: AutoCAD SHX Text
Date:
Color:

SCALE:



Subject:
Page Label: 10
Lock: Unlocked
Status:
Checkmark: Unchecked
Author: AutoCAD SHX Text
Date:
Color:

HORIZONTAL:

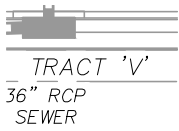


Subject: TRACT 'V'
Page Label: 10
Lock: Unlocked
Status:
Checkmark: Unchecked
Author: AutoCAD SHX Text
Date:
Color:




Subject: BARBARICK SUBDIVISION LOT 3
Page Label: 10
Lock: Unlocked
Status:
Checkmark: Unchecked
Author: AutoCAD SHX Text
Date:
Color:

100

Subject: 100
Page Label: 10
Lock: Unlocked
Status:
Checkmark: Unchecked
Author: AutoCAD SHX Text
Date:
Color:

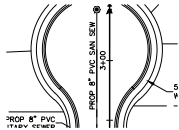

Subject: PROP 8" PVC SAN SEW
Page Label: 10
Lock: Unlocked
Status:
Checkmark: Unchecked
Author: AutoCAD SHX Text
Date:
Color:

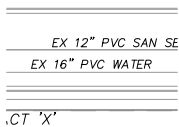

Subject: EX 16" PVC WATER
Page Label: 10
Lock: Unlocked
Status:
Checkmark: Unchecked
Author: AutoCAD SHX Text
Date:
Color:



Subject: 1"=50'
Page Label: 10
Lock: Unlocked
Status:
Checkmark: Unchecked
Author: AutoCAD SHX Text
Date:
Color:

SCALE:
HORIZONTAL
1"=50'
VERTICAL:
1"=5'

BARBARICK
SUBDIVISION
LOT 4


Subject:
Page Label: 10
Lock: Unlocked
Status:
Checkmark: Unchecked
Author: AutoCAD SHX Text
Date:
Color:

BARBARICK SUBDIVISION LOT 4



Subject:
Page Label: 10
Lock: Unlocked
Status:
Checkmark: Unchecked
Author: AutoCAD SHX Text
Date:
Color:

THE ENGINEER PREPARING THESE PLANS
WILL NOT BE RESPONSIBLE, OR LIABLE FOR,
UNAUTHORIZED CHANGES TO OR USES OF
THESE PLANS. ALL CHANGES TO THE PLANS
MUST BE IN WRITING AND MUST BE
APPROVED BY THE PREPARER OF THESE
PLANS.

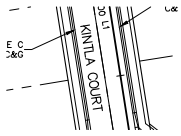


Subject:
Page Label: 10
Lock: Unlocked
Status:
Checkmark: Unchecked
Author: AutoCAD SHX Text
Date:
Color:

KINTLA COURT




Subject:
Page Label: 10
Lock: Unlocked
Status:
Checkmark: Unchecked
Author: AutoCAD SHX Text
Date:
Color:

DATE:

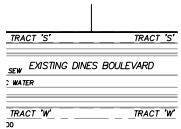


Subject:
Page Label: 10
Lock: Unlocked
Status:
Checkmark: Unchecked
Author: AutoCAD SHX Text
Date:
Color:

EXISTING DINES BOULEVARD

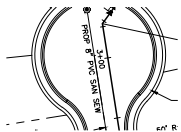

Subject:
Page Label: 10
Lock: Unlocked
Status:
Checkmark: Unchecked
Author: AutoCAD SHX Text
Date:
Color:

PROP 8" PVC SAN SEW

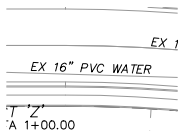

Subject: EX 16" PVC WATER
Page Label: 10
Lock: Unlocked
Status:
Checkmark: Unchecked
Author: AutoCAD SHX Text
Date:
Color:



Subject: DRAWN BY:
Page Label: 10
Lock: Unlocked
Status:
Checkmark: Unchecked
Author: AutoCAD SHX Text
Date:
Color:



Subject: CALL 1-800-922-1987
Page Label: 10
Lock: Unlocked
Status:
Checkmark: Unchecked
Author: AutoCAD SHX Text
Date:
Color:



Subject: TRACT 'L'
Page Label: 10
Lock: Unlocked
Status:
Checkmark: Unchecked
Author: AutoCAD SHX Text
Date:
Color:

36

Subject: 36
Page Label: 10
Lock: Unlocked
Status:
Checkmark: Unchecked
Author: AutoCAD SHX Text
Date:
Color:

31

Subject: 31
Page Label: 10
Lock: Unlocked
Status:
Checkmark: Unchecked
Author: AutoCAD SHX Text
Date:
Color:

40

Subject: 40
Page Label: 10
Lock: Unlocked
Status:
Checkmark: Unchecked
Author: AutoCAD SHX Text
Date:
Color:

TRACT 'S'

Subject: TRACT 'S'
Page Label: 10
Lock: Unlocked
Status:
Checkmark: Unchecked
Author: AutoCAD SHX Text
Date:
Color:

19

Subject: 19
Page Label: 10
Lock: Unlocked
Status:
Checkmark: Unchecked
Author: AutoCAD SHX Text
Date:
Color:

FOR LOCATING & MARKING GAS, ELECTRIC, WATER & TELEPHONE LINES
UTILITY INFORMATION


Subject: FOR LOCATING & MARKING GAS, ELECTRIC, WATER & TELEPHONE LINES
Page Label: 10
Lock: Unlocked
Status:
Checkmark: Unchecked
Author: AutoCAD SHX Text
Date:
Color:

TRACT "K"
STERLING RANCH
FUTURE RESIDENTIAL

Subject: TRACT "K" STERLING RANCH FUTURE RESIDENTIAL
Page Label: 10
Lock: Unlocked
Status:
Checkmark: Unchecked
Author: AutoCAD SHX Text
Date:
Color:


0

Subject: 0
Page Label: 10
Lock: Unlocked
Status:
Checkmark: Unchecked
Author: AutoCAD SHX Text
Date:
Color:

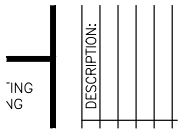

Subject:
Page Label: 12
Lock: Unlocked
Status:
Checkmark: Unchecked
Author: AutoCAD SHX Text
Date:
Color:

DESCRIPTION:

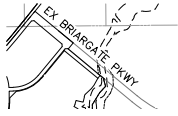

Subject:
Page Label: 12
Lock: Unlocked
Status:
Checkmark: Unchecked
Author: AutoCAD SHX Text
Date:
Color:

EX BRIARGATE PKWY



Subject:
Page Label: 12
Lock: Unlocked
Status:
Checkmark: Unchecked
Author: AutoCAD SHX Text
Date:
Color:

DRAWN BY:




Subject:
Page Label: 12
Lock: Unlocked
Status:
Checkmark: Unchecked
Author: AutoCAD SHX Text
Date:
Color:

DATE:




Subject:
Page Label: 12
Lock: Unlocked
Status:
Checkmark: Unchecked
Author: AutoCAD SHX Text
Date:
Color:

STERLING

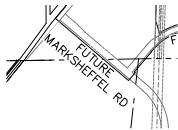

Subject:
Page Label: 12
Lock: Unlocked
Status:
Checkmark: Unchecked
Author: AutoCAD SHX Text
Date:
Color:

FUTURE MARKSHEFFEL RD

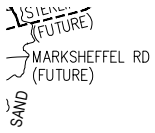


Subject:
Page Label: 12
Lock: Unlocked
Status:
Checkmark: Unchecked
Author: AutoCAD SHX Text
Date:
Color:

MARKSHEFFEL RD (FUTURE)



Subject:
Page Label: 12
Lock: Unlocked
Status:
Checkmark: Unchecked
Author: AutoCAD SHX Text
Date:
Color:

CALL 1-800-922-1987

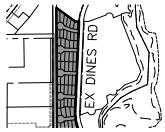

Subject:
Page Label: 12
Lock: Unlocked
Status:
Checkmark: Unchecked
Author: AutoCAD SHX Text
Date:
Color:

EX DINES RD



Subject:
Page Label: 12
Lock: Unlocked
Status:
Checkmark: Unchecked
Author: AutoCAD SHX Text
Date:
Color:

BURGESS RD



Subject:
Page Label: 12
Lock: Unlocked
Status:
Checkmark: Unchecked
Author: AutoCAD SHX Text
Date:
Color:

SHEET 1 OF 4



Subject:
Page Label: 12
Lock: Unlocked
Status:
Checkmark: Unchecked
Author: AutoCAD SHX Text
Date:
Color:

VOLLMER RD

SAI

. 09-006

VAS
EIV


Subject:
Page Label: 12
Lock: Unlocked
Status:
Checkmark: Unchecked
Author: AutoCAD SHX Text
Date:
Color:

09-006



Subject:
Page Label: 12
Lock: Unlocked
Status:
Checkmark: Unchecked
Author: AutoCAD SHX Text
Date:
Color:

RANCH RD

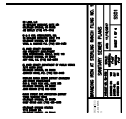

Subject:
Page Label: 12
Lock: Unlocked
Status:
Checkmark: Unchecked
Author: AutoCAD SHX Text
Date:
Color:


BRANDING IRON AT STERLING RANCH FILING NO. 1



MAP

Subject:
Page Label: 12
Lock: Unlocked
Status:
Checkmark: Unchecked
Author: AutoCAD SHX Text
Date:
Color:

MARKSHEFFEL RD

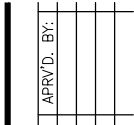

Subject:
Page Label: 12
Lock: Unlocked
Status:
Checkmark: Unchecked
Author: AutoCAD SHX Text
Date:
Color:

APRV'D. BY:



Subject:
Page Label: 12
Lock: Unlocked
Status:
Checkmark: Unchecked
Author: AutoCAD SHX Text
Date:
Color:

WATER & SEWER MAIN EXTENTIONS ANY CHANGES OR ALTERATIONS AFFECTING THE GRADE, ALIGNMENT, ELEVATION AND/OR DEPTH OF COVER OF GRADE, ALIGNMENT, ELEVATION AND/OR DEPTH OF COVER OF Page Label: 12
Lock: Unlocked
Status:
Checkmark: Unchecked
Author: AutoCAD SHX Text
Date:
Color:

BY:

REI
NO.

Subject:
Page Label: 12
Lock: Unlocked
Status:
Checkmark: Unchecked
Author: AutoCAD SHX Text
Date:
Color:

NO.

DATE:


Subject:
Page Label: 12
Lock: Unlocked
Status:
Checkmark: Unchecked
Author: AutoCAD SHX Text
Date:
Color:

DATE:

DATE:

Subject:
Page Label: 12
Lock: Unlocked
Status:
Checkmark: Unchecked
Author: AutoCAD SHX Text
Date:
Color:

DATE:

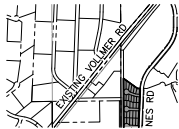


Subject:
Page Label: 12
Lock: Unlocked
Status:
Checkmark: Unchecked
Author: AutoCAD SHX Text
Date:
Color:

EXISTING VOLLMER RD

SANITARY SEWER PLANS			


Subject:
Page Label: 12
Lock: Unlocked
Status:
Checkmark: Unchecked
Author: AutoCAD SHX Text
Date:
Color:

SANITARY SEWER PLANS

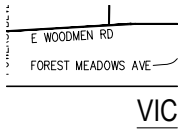


Subject:
Page Label: 12
Lock: Unlocked
Status:
Checkmark: Unchecked
Author: AutoCAD SHX Text
Date:
Color:

FOREST MEADOWS AVE

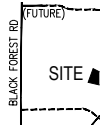


Subject:
Page Label: 12
Lock: Unlocked
Status:
Checkmark: Unchecked
Author: AutoCAD SHX Text
Date:
Color:

BLACK FOREST RD

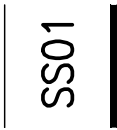


Subject:
Page Label: 12
Lock: Unlocked
Status:
Checkmark: Unchecked
Author: AutoCAD SHX Text
Date:
Color:

SS01

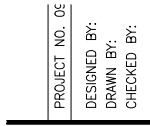

Subject:
Page Label: 12
Lock: Unlocked
Status:
Checkmark: Unchecked
Author: AutoCAD SHX Text
Date:
Color:

DESIGNED BY:

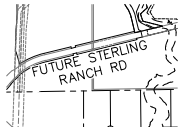

Subject:
Page Label: 12
Lock: Unlocked
Status:
Checkmark: Unchecked
Author: AutoCAD SHX Text
Date:
Color:

FUTURE STERLING RANCH RD



Subject:
Page Label: 12
Lock: Unlocked
Status:
Checkmark: Unchecked
Author: AutoCAD SHX Text
Date:
Color:

48 HRS BEFORE YOU DIG

COWPOKE RD

Subject:
Page Label: 12
Lock: Unlocked
Status:
Checkmark: Unchecked
Author: AutoCAD SHX Text
Date:
Color:

COWPOKE RD

HUN ES ATION DIG 987	REVISIONS:			
	NO.			
	DATE:			

Subject:
Page Label: 12
Lock: Unlocked
Status:
Checkmark: Unchecked
Author: AutoCAD SHX Text
Date:
Color:

REVISIONS:



Subject:
Page Label: 12
Lock: Unlocked
Status:
Checkmark: Unchecked
Author: AutoCAD SHX Text
Date:
Color:

WASTEWATER SYSTEM INSTALLATION
NOTES 1. SANITARY SEWER LENGTHS ARE
MH CENTER-MH CENTER. ALL SANITARY
SEWER PIPES SHALL BE SDR 35 PVC OR
EQUAL. SANITARY SEWER LENGTHS ARE MH
SEWER LINES MAY NOT EXCEED 7% GRADE
FOR ANY SIZE WITHOUT PRIOR APPROVAL
OF THE DISTRICT. ALL NEWLY LINES MAY

FILE NO. 1	1
PROJECT NO.	
DESIGNED BY:	
DRAWN BY:	
CHECKED BY:	

Subject:
Page Label: 12
Lock: Unlocked
Status:
Checkmark: Unchecked
Author: AutoCAD SHX Text
Date:
Color:

AGENCIES OWNER/DEVELOPER: SR LAND, LLC SR LAND, LLC 20 BOULDER CRESCENT, SUITE 201 , SUITE 201 COLORADO SPRINGS, CO 80903 JIM MORLEY (719) 471-1742 CIVIL ENGINEER: M & S CIVIL CONSULTANTS, INC. M & S CIVIL CONSULTANTS, INC. 20 BOULDER CRESCENT, SUITE 110 COLORADO SPRINGS, CO 80903 VIRGIL A. SANCHEZ P.E. (719) 955-5485 COUNTY ENGINEERING: EL PASO COUNTY PLANNING EL PASO COUNTY PLANNING AND COMMUNITY DEVELOPMENT 2880 INTERNATIONAL CIRCLE, SUITE 110 COLORADO SPRINGS, CO 80910 JEFF RICE, P.E. (719) 520-6300 TRAFFIC ENGINEERING: EL PASO COUNTY DEPARTMENT OF PUBLIC WORKS EL PASO COUNTY DEPARTMENT OF PUBLIC WORKS 3275 AKERS DRIVE COLORADO SPRINGS, CO 80922 JENNIFER IRVINE, P.E. (719) 520-6460 WATER RESOURCES: STERLING RANCH METRO DISTRICT ENGINEERS STERLING RANCH METRO DISTRICT ENGINEERS JDS-HYDRO CONSULTANTS 545 E. PIKES PEAK AVE., SUITE 300 COLORADO SPRINGS, CO 80903 JOHN MCGINN (719) 668-8769 FIRE DISTRICT: BLACK FOREST FIRE PROTECTION DISTRICT BLACK FOREST FIRE PROTECTION DISTRICT 11445 TEACHOUT ROAD COLORADO SPRINGS, CO 80908 CHIEF BRYAN JACK (719) 495-4300 GAS DEPARTMENT: COLORADO SPRINGS UTILITIES COLORADO SPRINGS UTILITIES 7710 DURANT DR. COLORADO SPRINGS, CO 80947 TIM WENDT (719) 668-3556 ELECTRIC DEPARTMENT: MOUNTAIN VIEW ELECTRIC MOUNTAIN VIEW ELECTRIC 11140 E. WOODMEN ROAD FALCON, CO 80831 (719) 495-2283 COMMUNICATIONS: QWEST COMMUNICATIONS QWEST COMMUNICATIONS (U.N.C.C. LOCATORS) (800) 922-1987 AT&T (LOCATORS) (719) 635-3674

PROJECT NO. 0	
DESIGNED BY:	
DRAWN BY:	
CHECKED BY:	


Subject:
Page Label: 12
Lock: Unlocked
Status:
Checkmark: Unchecked
Author: AutoCAD SHX Text
Date:
Color:

PROJECT NO.

BRIARGATE PKWY (FUTURE)	
-------------------------	--

Subject:
Page Label: 12
Lock: Unlocked
Status:
Checkmark: Unchecked
Author: AutoCAD SHX Text
Date:
Color:

BRIARGATE PKWY

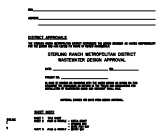

Subject:
Page Label: 12
Lock: Unlocked
Status:
Checkmark: Unchecked
Author: AutoCAD SHX Text
Date:
Color:

DISTRICT APPROVALS THE STERLING RANCH METROPOLITAN DISTRICT RECOGNIZES THE DESIGN ENGINEER AS HAVING RESPONSIBILITY STERLING RANCH METROPOLITAN DISTRICT WASTEWATER DESIGN APPROVAL DATE: BY: BY: PROJECT NO. IN CASE OF ERRORS OR OMISSIONS WITH THE WATER DESIGN AS SHOWN ON THIS DOCUMENT THE STANDARDS AS DEFINED IN THE "RULES AND REGULATIONS FOR INSTALLATION OF WASTEWATER MAINS AND SERVICES" SHALL RULE. APPROVAL EXPIRES 180 DAYS FROM DESIGN APPROVAL.

{STERLING
 (FUTURE)}
 → MARKSHFFF


Subject:
Page Label: 12
Lock: Unlocked
Status:
Checkmark: Unchecked
Author: AutoCAD SHX Text
Date:
Color:

(FUTURE)

TARY
SCALE:
HORIZONTAL
1"=50'

Subject:
Page Label: 12
Lock: Unlocked
Status:
Checkmark: Unchecked
Author: AutoCAD SHX Text
Date:
Color:

SCALE:

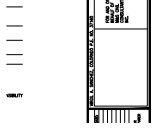

Subject:
Page Label: 12
Lock: Unlocked
Status:
Checkmark: Unchecked
Author: AutoCAD SHX Text
Date:
Color:

VIRGIL A. SANCHEZ, COLORADO P.E. NO.
37160



Subject:
Page Label: 12
Lock: Unlocked
Status:
Checkmark: Unchecked
Author: AutoCAD SHX Text
Date:
Color:

BENCHMARKS 1. THE TOP OF AN ALUMINUM SURVEYORS CAP, STAMPED "9853", AT THE TOP OF AN ALUMINUM SURVEYORS CAP, STAMPED "9853", AT THE SOUTHEAST BOUNDARY CORNER OF BARBARICK SUBDIVISION NORTHING = 411416.273 = 411416.273 EASTING = 235167.071 = 235167.071 ELEVATION = 7023.42 = 7023.42
2. THE TOP OF A RED PLASTIC SURVEYORS CAP, ILLEGIBLE, AT THE THE TOP OF A RED PLASTIC SURVEYORS CAP, ILLEGIBLE, AT THE NORTHWEST BOUNDARY CORNER OF PAWNEE RANCHEROS SUBDIVISION NORTHING = 410095.404 = 410095.404 EASTING = 235052.131 = 235052.131 ELEVATION = 7000.40 = 7000.40
3. THE TOP OF A RED PLASTIC SURVEYORS CAP, STAMPED "38141", AT THE TOP OF A RED PLASTIC SURVEYORS CAP, STAMPED "38141", AT THE SOUTHWEST BOUNDARY CORNER OF BARBARICK SUBDISION NORTHING = 411399.962 = 411399.962 EASTING = 233849.817 = 233849.817 ELEVATION = 7030.82 = 7030.82

RANCH FILIN
PLANS
11/10/2017
1 OF 4

Subject:
Page Label: 12
Lock: Unlocked
Status:
Checkmark: Unchecked
Author: AutoCAD SHX Text
Date:
Color:

11/10/2017



Subject:
Page Label: 12
Lock: Unlocked
Status:
Checkmark: Unchecked
Author: AutoCAD SHX Text
Date:
Color:

CAUTION

3/1/10

FOR AND ON
BEHALF OF
M&S CIVIL
CONSULTANTS,
INC.

Subject:
Page Label: 12
Lock: Unlocked
Status:
Checkmark: Unchecked
Author: AutoCAD SHX Text
Date:
Color:

FOR AND ON BEHALF OF M&S CIVIL
CONSULTANTS, INC.

POWERS BLVD
E. WOODM
FOREST A

Subject:
Page Label: 12
Lock: Unlocked
Status:
Checkmark: Unchecked
Author: AutoCAD SHX Text
Date:
Color:

POWERS BLVD

FOR LOCATING
& MARKING
GAS,
ELECTRIC,
WATER &
TELEPHONE
LINES
UTILITY INFORMATION

INS.
DATE: 11/01/10

Subject:
Page Label: 12
Lock: Unlocked
Status:
Checkmark: Unchecked
Author: AutoCAD SHX Text
Date:
Color:

FOR LOCATING & MARKING GAS, ELECTRIC,
WATER & TELEPHONE LINES



Subject:
Page Label: 12
Lock: Unlocked
Status:
Checkmark: Unchecked
Author: AutoCAD SHX Text
Date:
Color:

GENERAL NOTES 1. ALL UTILITY CONSTRUCTION TO BE CONDUCTED IN CONFORMANCE WITH THE CURRENT STERLING RANCH METROPOLITAN ALL UTILITY CONSTRUCTION TO BE CONDUCTED IN CONFORMANCE WITH THE CURRENT STERLING RANCH METROPOLITAN VERTICAL
1"=5'

Subject: 1"=5'
Page Label: 12
Lock: Unlocked
Status:
Checkmark: Unchecked
Author: AutoCAD SHX Text
Date:
Color:

VAS
ELY
GW

Subject: ELY
Page Label: 12
Lock: Unlocked
Status:
Checkmark: Unchecked
Author: AutoCAD SHX Text
Date:
Color:

APPROVAL EXPIRES 180 DAYS FROM
SHEET INDEX
SHEET 1 TITLE SHEET
SHEET 2 PLAN & PROFILE - KINTLA COURT
SHEET 3 PLAN & PROFILE - MOSBY WAY
SHEET 4 UTILITY SERVICE PLAN

Subject: SHEET INDEX SHEET 1 TITLE SHEET TITLE
Page Label: 12 SHEET SHEET 2 PLAN & PROFILE - KINTLA
Lock: Unlocked COURT PLAN & PROFILE - KINTLA COURT -
Status: KINTLA COURT - SPRAGUE WAY - WHITE FISH
Checkmark: Unchecked WAY SHEET 3 PLAN & PROFILE - MOSBY WAY
Author: AutoCAD SHX Text PLAN & PROFILE - MOSBY WAY - MOSBY WAY
Date: - LODGE GRASS WAY SHEET 4 UTILITY
Color: SERVICE PLAN UTILITY SERVICE PLAN



Subject: FOR BURIED UTILITY INFORMATION
Page Label: 12
Lock: Unlocked
Status:
Checkmark: Unchecked
Author: AutoCAD SHX Text
Date:
Color:



Subject: E WOODMEN RD
Page Label: 12
Lock: Unlocked
Status:
Checkmark: Unchecked
Author: AutoCAD SHX Text
Date:
Color:

SCALE:
HORIZONTAL:
1"=50'
VERTICAL:
1"=5'

Subject: VERTICAL:
Page Label: 12
Lock: Unlocked
Status:
Checkmark: Unchecked
Author: AutoCAD SHX Text
Date:
Color:

VAS
ELY

Subject:
Page Label: 12
Lock: Unlocked
Status:
Checkmark: Unchecked
Author: AutoCAD SHX Text
Date:
Color:

VAS



Subject:
Page Label: 12
Lock: Unlocked
Status:
Checkmark: Unchecked
Author: AutoCAD SHX Text
Date:
Color:

File: O:\09006A\Sterling Ranch No 3\dwg\Const
Dwg\Sanitary Sewer Plans\SS01.dwg Plotstamp:
11/6/2017 8:22 PM

PROJECT NO.: 01
DESIGNED BY:
DRAWN BY:
CHECKED BY:

Subject:
Page Label: 12
Lock: Unlocked
Status:
Checkmark: Unchecked
Author: AutoCAD SHX Text
Date:
Color:

CHECKED BY:

ELI
GW

Subject:
Page Label: 12
Lock: Unlocked
Status:
Checkmark: Unchecked
Author: AutoCAD SHX Text
Date:
Color:

GW

SCALE:
HORIZONTAL
1"=50'
VERTICAL:
1"=5'

Subject:
Page Label: 12
Lock: Unlocked
Status:
Checkmark: Unchecked
Author: AutoCAD SHX Text
Date:
Color:

1"=50'



Subject:
Page Label: 12
Lock: Unlocked
Status:
Checkmark: Unchecked
Author: AutoCAD SHX Text
Date:
Color:

LEGEND
ROW RIGHT OF WAY
RIGHT OF WAY
FL-FL FLOWLINE
TO FLOWLINE
FLOWLINE TO
FLOWLINE
BOP BOTTOM OF PIPE
BOTTOM OF PIPE
TOP OF PIPE
TOP OF PIPE
SS SANITARY SEWER
SANITARY SEWER
STM STORM SEWER
STORM SEWER
WL WATER WATER STA
STATION STATION
9 LOT NUMBER
LOT NUMBER
BT BEGIN
TRANSITION
BEGIN TRANSITION
ET END
TRANSITION
END TRANSITION
PCR POINT OF
CURB RETURN
POINT OF CURB
RETURN
PRC POINT OF
REVERSE CURVE
POINT OF
REVERSE CURVE
PCC POINT OF
COMPOUND
POINT OF
COMPOUND CURVE
PC POINT OF
CURVE
POINT OF CURVE
PT POINT OF
TANGENT
POINT OF TANGENT
SPECIAL
BEDDING NOTES



Subject:
Page Label: 12
Lock: Unlocked
Status:
Checkmark: Unchecked
Author: AutoCAD SHX Text
Date:
Color:

THE ENGINEER PREPARING THESE PLANS
 WILL NOT BE RESPONSIBLE, OR LIABLE FOR,
 UNAUTHORIZED CHANGES TO OR USES OF
 THESE PLANS. ALL CHANGES TO THE PLANS
 MUST BE IN WRITING AND MUST BE
 APPROVED BY THE PREPARER OF THESE
 PLANS.

VITARY SE
 SCALE:
 HORIZONTAL:
 1"=50'
 VERTICAL:
 1"=5'

Subject:
Page Label: 12
Lock: Unlocked
Status:
Checkmark: Unchecked
Author: AutoCAD SHX Text
Date:
Color:

HORIZONTAL:

KLU
 BRIARGATE
 (FUTURE)

Subject:
Page Label: 12
Lock: Unlocked
Status:
Checkmark: Unchecked
Author: AutoCAD SHX Text
Date:
Color:

(FUTURE)

4

Subject:
Page Label: 13
Lock: Unlocked
Status:
Checkmark: Unchecked
Author: AutoCAD SHX Text
Date:
Color:

4

TRACT 'X'
 CH
 VITAL


Subject:
Page Label: 13
Lock: Unlocked
Status:
Checkmark: Unchecked
Author: AutoCAD SHX Text
Date:
Color:

TRACT 'X'

TRACT 'S'
 EX 8" PVC SAN SEW
 EX 8" PVC WATER
 TRACT 'W'

Subject:
Page Label: 13
Lock: Unlocked
Status:
Checkmark: Unchecked
Author: AutoCAD SHX Text
Date:
Color:

EX 8" PVC WATER

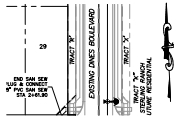

Subject:
Page Label: 13
Lock: Unlocked
Status:
Checkmark: Unchecked
Author: AutoCAD SHX Text
Date:
Color:

EXISTING DINES BOULEVARD

BY:


Subject:
Page Label: 13
Lock: Unlocked
Status:
Checkmark: Unchecked
Author: AutoCAD SHX Text
Date:
Color:

BY:

2

Subject:
Page Label: 13
Lock: Unlocked
Status:
Checkmark: Unchecked
Author: AutoCAD SHX Text
Date:
Color:

2

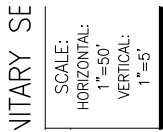

Subject:
Page Label: 13
Lock: Unlocked
Status:
Checkmark: Unchecked
Author: AutoCAD SHX Text
Date:
Color:

HORIZONTAL:

3


Subject:
Page Label: 13
Lock: Unlocked
Status:
Checkmark: Unchecked
Author: AutoCAD SHX Text
Date:
Color:

3




Subject:
Page Label: 13
Lock: Unlocked
Status:
Checkmark: Unchecked
Author: AutoCAD SHX Text
Date:
Color:

EX 8" PVC WATER

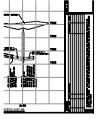

Subject:
Page Label: 13
Lock: Unlocked
Status:
Checkmark: Unchecked
Author: AutoCAD SHX Text
Date:
Color:

THE ENGINEER PREPARING THESE PLANS
 WILL NOT BE RESPONSIBLE, OR LIABLE FOR,
 UNAUTHORIZED CHANGES TO OR USES OF
 THESE PLANS. ALL CHANGES TO THE PLANS
 MUST BE IN WRITING AND MUST BE
 APPROVED BY THE PREPARER OF THESE
 PLANS.

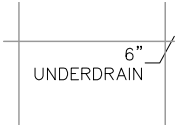


Subject:
Page Label: 13
Lock: Unlocked
Status:
Checkmark: Unchecked
Author: AutoCAD SHX Text
Date:
Color:

6" UNDERDRAIN



Subject:
Page Label: 13
Lock: Unlocked
Status:
Checkmark: Unchecked
Author: AutoCAD SHX Text
Date:
Color:

1+00

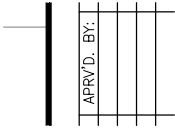


Subject:
Page Label: 13
Lock: Unlocked
Status:
Checkmark: Unchecked
Author: AutoCAD SHX Text
Date:
Color:

APRV'D. BY:

11


Subject:
Page Label: 13
Lock: Unlocked
Status:
Checkmark: Unchecked
Author: AutoCAD SHX Text
Date:
Color:

11

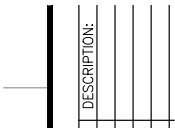


Subject:
Page Label: 13
Lock: Unlocked
Status:
Checkmark: Unchecked
Author: AutoCAD SHX Text
Date:
Color:


DESCRIPTION:

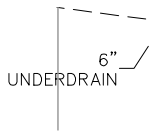

Subject: 6" UNDERDRAIN
Page Label: 13
Lock: Unlocked
Status:
Checkmark: Unchecked
Author: AutoCAD SHX Text
Date:
Color:

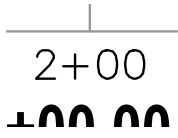

Subject: 2+00
Page Label: 13
Lock: Unlocked
Status:
Checkmark: Unchecked
Author: AutoCAD SHX Text
Date:
Color:

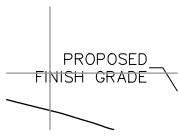


Subject: PROPOSED FINISH GRADE
Page Label: 13
Lock: Unlocked
Status:
Checkmark: Unchecked
Author: AutoCAD SHX Text
Date:
Color:



Subject: TRACT 'V'
Page Label: 13
Lock: Unlocked
Status:
Checkmark: Unchecked
Author: AutoCAD SHX Text
Date:
Color:



Subject: 7030
Page Label: 13
Lock: Unlocked
Status:
Checkmark: Unchecked
Author: AutoCAD SHX Text
Date:
Color:

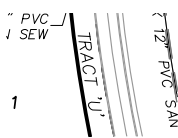

Subject: TRACT 'U'
Page Label: 13
Lock: Unlocked
Status:
Checkmark: Unchecked
Author: AutoCAD SHX Text
Date:
Color:

EX 8" PVC W
TRACT 'W'

Subject: TRACT 'W'
Page Label: 13
Lock: Unlocked
Status:
Checkmark: Unchecked
Author: AutoCAD SHX Text
Date:
Color:

SCALE:
HORIZONTAL
1"=50'
VERTICAL:
1"=5'

Subject: 1"=50'
Page Label: 13
Lock: Unlocked
Status:
Checkmark: Unchecked
Author: AutoCAD SHX Text
Date:
Color:

FOR LOCATING
& MARKING
GAS,
ELECTRIC,
WATER &
TELEPHONE
LINES
UTILITY INFORMATION
37160

Subject: FOR LOCATING & MARKING GAS, ELECTRIC,
WATER & TELEPHONE LINES
Page Label: 13
Lock: Unlocked
Status:
Checkmark: Unchecked
Author: AutoCAD SHX Text
Date:
Color:

RANCH FILIN
R PLANS
11/10/2017
SET 2 OF 4

Subject: 11/10/2017
Page Label: 13
Lock: Unlocked
Status:
Checkmark: Unchecked
Author: AutoCAD SHX Text
Date:
Color:

14

Subject: 14
Page Label: 13
Lock: Unlocked
Status:
Checkmark: Unchecked
Author: AutoCAD SHX Text
Date:
Color:

PROJECT NO.
DESIGNED BY
DRAWN BY:
CHECKED BY:

Subject: DRAWN BY:
Page Label: 13
Lock: Unlocked
Status:
Checkmark: Unchecked
Author: AutoCAD SHX Text
Date:
Color:

7045

Subject:
Page Label: 13
Lock: Unlocked
Status:
Checkmark: Unchecked
Author: AutoCAD SHX Text
Date:
Color:


7045

19



Subject:
Page Label: 13
Lock: Unlocked
Status:
Checkmark: Unchecked
Author: AutoCAD SHX Text
Date:
Color:

TRACT 'S'

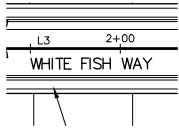

Subject:
Page Label: 13
Lock: Unlocked
Status:
Checkmark: Unchecked
Author: AutoCAD SHX Text
Date:
Color:

WHITE FISH WAY

7

Subject:
Page Label: 13
Lock: Unlocked
Status:
Checkmark: Unchecked
Author: AutoCAD SHX Text
Date:
Color:

7

15


Subject:
Page Label: 13
Lock: Unlocked
Status:
Checkmark: Unchecked
Author: AutoCAD SHX Text
Date:
Color:

15

7025

Subject:
Page Label: 13
Lock: Unlocked
Status:
Checkmark: Unchecked
Author: AutoCAD SHX Text
Date:
Color:

7025

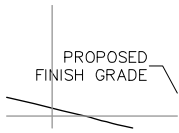


Subject: PROPOSED FINISH GRADE
Page Label: 13
Lock: Unlocked
Status:
Checkmark: Unchecked
Author: AutoCAD SHX Text
Date:
Color:

29

Subject: 29
Page Label: 13
Lock: Unlocked
Status:
Checkmark: Unchecked
Author: AutoCAD SHX Text
Date:
Color:

7045


Subject: 7045
Page Label: 13
Lock: Unlocked
Status:
Checkmark: Unchecked
Author: AutoCAD SHX Text
Date:
Color:

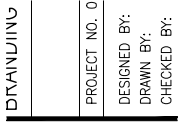

Subject: PROJECT NO.
Page Label: 13
Lock: Unlocked
Status:
Checkmark: Unchecked
Author: AutoCAD SHX Text
Date:
Color:



Subject: CAUTION
Page Label: 13
Lock: Unlocked
Status:
Checkmark: Unchecked
Author: AutoCAD SHX Text
Date:
Color:

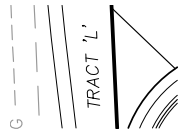

Subject: TRACT 'L'
Page Label: 13
Lock: Unlocked
Status:
Checkmark: Unchecked
Author: AutoCAD SHX Text
Date:
Color:

7035


Subject:
Page Label: 13
Lock: Unlocked
Status:
Checkmark: Unchecked
Author: AutoCAD SHX Text
Date:
Color:

7035



Subject:
Page Label: 13
Lock: Unlocked
Status:
Checkmark: Unchecked
Author: AutoCAD SHX Text
Date:
Color:

BARBARICK SUBDIVISION LOT 4

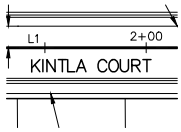

Subject:
Page Label: 13
Lock: Unlocked
Status:
Checkmark: Unchecked
Author: AutoCAD SHX Text
Date:
Color:

KINTLA COURT

100


Subject:
Page Label: 13
Lock: Unlocked
Status:
Checkmark: Unchecked
Author: AutoCAD SHX Text
Date:
Color:

100

ELI
GW

Subject:
Page Label: 13
Lock: Unlocked
Status:
Checkmark: Unchecked
Author: AutoCAD SHX Text
Date:
Color:

GW

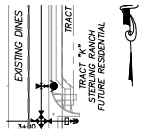

Subject:
Page Label: 13
Lock: Unlocked
Status:
Checkmark: Unchecked
Author: AutoCAD SHX Text
Date:
Color:

TRACT "K" STERLING RANCH FUTURE RESIDENTIAL

7025

Subject: 7025
Page Label: 13
Lock: Unlocked
Status:
Checkmark: Unchecked
Author: AutoCAD SHX Text
Date:
Color:

21

Subject: 21
Page Label: 13
Lock: Unlocked
Status:
Checkmark: Unchecked
Author: AutoCAD SHX Text
Date:
Color:

0+00

Subject: 0+00
Page Label: 13
Lock: Unlocked
Status:
Checkmark: Unchecked
Author: AutoCAD SHX Text
Date:
Color:

PROJECT NO. 06
DESIGNED BY:
DRAWN BY:
CHECKED BY:

Subject: DESIGNED BY:
Page Label: 13
Lock: Unlocked
Status:
Checkmark: Unchecked
Author: AutoCAD SHX Text
Date:
Color:

7040

Subject: 7040
Page Label: 13
Lock: Unlocked
Status:
Checkmark: Unchecked
Author: AutoCAD SHX Text
Date:
Color:

9

TRACT 'R'
DINES BOUL

Subject: TRACT 'R'
Page Label: 13
Lock: Unlocked
Status:
Checkmark: Unchecked
Author: AutoCAD SHX Text
Date:
Color:

VAS
ELY

Subject:
Page Label: 13
Lock: Unlocked
Status:
Checkmark: Unchecked
Author: AutoCAD SHX Text
Date:
Color:

VAS

2+00
D T O S

Subject:
Page Label: 13
Lock: Unlocked
Status:
Checkmark: Unchecked
Author: AutoCAD SHX Text
Date:
Color:

2+00

EXISTING GROUND

Subject:
Page Label: 13
Lock: Unlocked
Status:
Checkmark: Unchecked
Author: AutoCAD SHX Text
Date:
Color:

EXISTING GROUND

AN SEW
10
TRACT 'T'
EX 8" PVC SAI

Subject:
Page Label: 13
Lock: Unlocked
Status:
Checkmark: Unchecked
Author: AutoCAD SHX Text
Date:
Color:

TRACT 'T'

REI
NO.


Subject:
Page Label: 13
Lock: Unlocked
Status:
Checkmark: Unchecked
Author: AutoCAD SHX Text
Date:
Color:

NO.

7025


Subject:
Page Label: 13
Lock: Unlocked
Status:
Checkmark: Unchecked
Author: AutoCAD SHX Text
Date:
Color:

7025

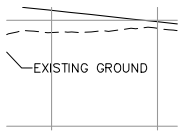


Subject:
Page Label: 13
Lock: Unlocked
Status:
Checkmark: Unchecked
Author: AutoCAD SHX Text
Date:
Color:

EXISTING GROUND

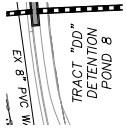

Subject:
Page Label: 13
Lock: Unlocked
Status:
Checkmark: Unchecked
Author: AutoCAD SHX Text
Date:
Color:

TRACT "DD" DETENTION POND 8

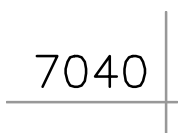

Subject:
Page Label: 13
Lock: Unlocked
Status:
Checkmark: Unchecked
Author: AutoCAD SHX Text
Date:
Color:

7040



Subject:
Page Label: 13
Lock: Unlocked
Status:
Checkmark: Unchecked
Author: AutoCAD SHX Text
Date:
Color:

16



Subject:
Page Label: 13
Lock: Unlocked
Status:
Checkmark: Unchecked
Author: AutoCAD SHX Text
Date:
Color:

27



Subject:
Page Label: 13
Lock: Unlocked
Status:
Checkmark: Unchecked
Author: AutoCAD SHX Text
Date:
Color:


13

22


Subject: 22
Page Label: 13
Lock: Unlocked
Status:
Checkmark: Unchecked
Author: AutoCAD SHX Text
Date:
Color:

25

Subject: 25
Page Label: 13
Lock: Unlocked
Status:
Checkmark: Unchecked
Author: AutoCAD SHX Text
Date:
Color:

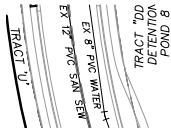

Subject: EX 8" PVC WATER
Page Label: 13
Lock: Unlocked
Status:
Checkmark: Unchecked
Author: AutoCAD SHX Text
Date:
Color:

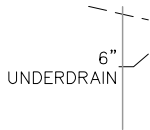

Subject: 6" UNDERDRAIN
Page Label: 13
Lock: Unlocked
Status:
Checkmark: Unchecked
Author: AutoCAD SHX Text
Date:
Color:

20

Subject: 20
Page Label: 13
Lock: Unlocked
Status:
Checkmark: Unchecked
Author: AutoCAD SHX Text
Date:
Color:

6

Subject: 6
Page Label: 13
Lock: Unlocked
Status:
Checkmark: Unchecked
Author: AutoCAD SHX Text
Date:
Color:

7020

Subject: 7020
Page Label: 13
Lock: Unlocked
Status:
Checkmark: Unchecked
Author: AutoCAD SHX Text
Date:
Color:

12

Subject: 12
Page Label: 13
Lock: Unlocked
Status:
Checkmark: Unchecked
Author: AutoCAD SHX Text
Date:
Color:

EMER PLANS
DATE: 11/10/2017
SHEET 2 OF 4

Subject: SHEET 2 OF 4
Page Label: 13
Lock: Unlocked
Status:
Checkmark: Unchecked
Author: AutoCAD SHX Text
Date:
Color:

7050

Subject: 7050
Page Label: 13
Lock: Unlocked
Status:
Checkmark: Unchecked
Author: AutoCAD SHX Text
Date:
Color:

28

Subject: 28
Page Label: 13
Lock: Unlocked
Status:
Checkmark: Unchecked
Author: AutoCAD SHX Text
Date:
Color:

24

Subject: 24
Page Label: 13
Lock: Unlocked
Status:
Checkmark: Unchecked
Author: AutoCAD SHX Text
Date:
Color:

7035


Subject:
Page Label: 13
Lock: Unlocked
Status:
Checkmark: Unchecked
Author: AutoCAD SHX Text
Date:
Color:

7035

3+00

Subject:
Page Label: 13
Lock: Unlocked
Status:
Checkmark: Unchecked
Author: AutoCAD SHX Text
Date:
Color:

3+00

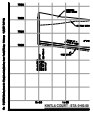

Subject:
Page Label: 13
Lock: Unlocked
Status:
Checkmark: Unchecked
Author: AutoCAD SHX Text
Date:
Color:

File: O:\09006A\Sterling Ranch No 3\dwg\Const
Dwg\Sanitary Sewer Plans\SS02.dwg Plotstamp:
11/6/2017 8:37 PM

SS02

Subject:
Page Label: 13
Lock: Unlocked
Status:
Checkmark: Unchecked
Author: AutoCAD SHX Text
Date:
Color:

SS02

1" =

Subject:
Page Label: 13
Lock: Unlocked
Status:
Checkmark: Unchecked
Author: AutoCAD SHX Text
Date:
Color:

1" =

7015

Subject:
Page Label: 13
Lock: Unlocked
Status:
Checkmark: Unchecked
Author: AutoCAD SHX Text
Date:
Color:

7015

7040


Subject:
Page Label: 13
Lock: Unlocked
Status:
Checkmark: Unchecked
Author: AutoCAD SHX Text
Date:
Color:

7040



Subject:
Page Label: 13
Lock: Unlocked
Status:
Checkmark: Unchecked
Author: AutoCAD SHX Text
Date:
Color:


CALL 1-800-922-1987

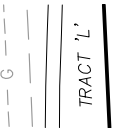

24

Subject:
Page Label: 13
Lock: Unlocked
Status:
Checkmark: Unchecked
Author: AutoCAD SHX Text
Date:
Color:

TRACT 'L'

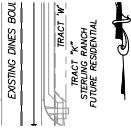

Subject:
Page Label: 13
Lock: Unlocked
Status:
Checkmark: Unchecked
Author: AutoCAD SHX Text
Date:
Color:

TRACT "K" STERLING RANCH FUTURE RESIDENTIAL



Subject:
Page Label: 13
Lock: Unlocked
Status:
Checkmark: Unchecked
Author: AutoCAD SHX Text
Date:
Color:

48 HRS BEFORE YOU DIG

7030


Subject:
Page Label: 13
Lock: Unlocked
Status:
Checkmark: Unchecked
Author: AutoCAD SHX Text
Date:
Color:

7030

1

Subject:
Page Label: 13
Lock: Unlocked
Status:
Checkmark: Unchecked
Author: AutoCAD SHX Text
Date:
Color:

1

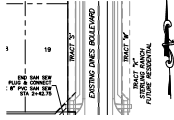

Subject:
Page Label: 13
Lock: Unlocked
Status:
Checkmark: Unchecked
Author: AutoCAD SHX Text
Date:
Color:

EXISTING DINES BOULEVARD



INTL A CO


Subject:
Page Label: 13
Lock: Unlocked
Status:
Checkmark: Unchecked
Author: AutoCAD SHX Text
Date:
Color:

TRACT 'M'



Subject:
Page Label: 13
Lock: Unlocked
Status:
Checkmark: Unchecked
Author: AutoCAD SHX Text
Date:
Color:


DATE:

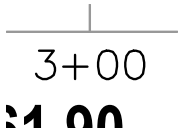

3+00

Subject:
Page Label: 13
Lock: Unlocked
Status:
Checkmark: Unchecked
Author: AutoCAD SHX Text
Date:
Color:

3+00

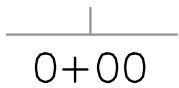

0+00

Subject:
Page Label: 13
Lock: Unlocked
Status:
Checkmark: Unchecked
Author: AutoCAD SHX Text
Date:
Color:

0+00

DATE:

Subject:
Page Label: 13
Lock: Unlocked
Status:
Checkmark: Unchecked
Author: AutoCAD SHX Text
Date:
Color:

DATE:

TRACT 'T'
BOULEVARD

Subject:
Page Label: 13
Lock: Unlocked
Status:
Checkmark: Unchecked
Author: AutoCAD SHX Text
Date:
Color:

TRACT 'T'

17


Subject:
Page Label: 13
Lock: Unlocked
Status:
Checkmark: Unchecked
Author: AutoCAD SHX Text
Date:
Color:

17

8

Subject:
Page Label: 13
Lock: Unlocked
Status:
Checkmark: Unchecked
Author: AutoCAD SHX Text
Date:
Color:

8

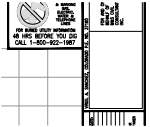

Subject:
Page Label: 13
Lock: Unlocked
Status:
Checkmark: Unchecked
Author: AutoCAD SHX Text
Date:
Color:

VIRGIL A. SANCHEZ, COLORADO P.E. NO.
37160

7035

Subject:
Page Label: 13
Lock: Unlocked
Status:
Checkmark: Unchecked
Author: AutoCAD SHX Text
Date:
Color:

7035

25 50
Scale in Feet



Subject:
Page Label: 13
Lock: Unlocked
Status:
Checkmark: Unchecked
Author: AutoCAD SHX Text
Date:
Color:

Scale in Feet

7040

Subject:
Page Label: 13
Lock: Unlocked
Status:
Checkmark: Unchecked
Author: AutoCAD SHX Text
Date:
Color:

7040

0+00

Subject:
Page Label: 13
Lock: Unlocked
Status:
Checkmark: Unchecked
Author: AutoCAD SHX Text
Date:
Color:

0+00

2/7/00

FOR AND ON
BEHALF OF
M&S CIVIL
CONSULTANTS,
INC.


Subject:
Page Label: 13
Lock: Unlocked
Status:
Checkmark: Unchecked
Author: AutoCAD SHX Text
Date:
Color:

FOR AND ON BEHALF OF M&S CIVIL
CONSULTANTS, INC.

7030

Subject:
Page Label: 13
Lock: Unlocked
Status:
Checkmark: Unchecked
Author: AutoCAD SHX Text
Date:
Color:

7030

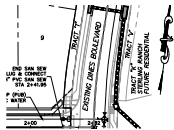

Subject:
Page Label: 13
Lock: Unlocked
Status:
Checkmark: Unchecked
Author: AutoCAD SHX Text
Date:
Color:

EXISTING DINES BOULEVARD

0

Subject:
Page Label: 13
Lock: Unlocked
Status:
Checkmark: Unchecked
Author: AutoCAD SHX Text
Date:
Color:

0

50'

Subject:
Page Label: 13
Lock: Unlocked
Status:
Checkmark: Unchecked
Author: AutoCAD SHX Text
Date:
Color:

50'

VAS
ELY
GW

Subject:
Page Label: 13
Lock: Unlocked
Status:
Checkmark: Unchecked
Author: AutoCAD SHX Text
Date:
Color:

ELY

7045

Subject:
Page Label: 13
Lock: Unlocked
Status:
Checkmark: Unchecked
Author: AutoCAD SHX Text
Date:
Color:

7045

2+00
00 00 7

Subject:
Page Label: 13
Lock: Unlocked
Status:
Checkmark: Unchecked
Author: AutoCAD SHX Text
Date:
Color:

2+00

SAI
09-006
VAS
E1 >

Subject:
Page Label: 13
Lock: Unlocked
Status:
Checkmark: Unchecked
Author: AutoCAD SHX Text
Date:
Color:

09-006

7035

Subject: 7035
Page Label: 13
Lock: Unlocked
Status:
Checkmark: Unchecked
Author: AutoCAD SHX Text
Date:
Color:

1+00

VIEW

Subject: 1+00
Page Label: 13
Lock: Unlocked
Status:
Checkmark: Unchecked
Author: AutoCAD SHX Text
Date:
Color:

7030

Subject: 7030
Page Label: 13
Lock: Unlocked
Status:
Checkmark: Unchecked
Author: AutoCAD SHX Text
Date:
Color:

26

Subject: 26
Page Label: 13
Lock: Unlocked
Status:
Checkmark: Unchecked
Author: AutoCAD SHX Text
Date:
Color:

VERTICAL
1"=5'

Subject: 1"=5'
Page Label: 13
Lock: Unlocked
Status:
Checkmark: Unchecked
Author: AutoCAD SHX Text
Date:
Color:

50

Subject: 50
Page Label: 13
Lock: Unlocked
Status:
Checkmark: Unchecked
Author: AutoCAD SHX Text
Date:
Color:

PROJECT NO. 01
DESIGNED BY:
DRAWN BY:
CHECKED BY:

Subject:
Page Label: 13
Lock: Unlocked
Status:
Checkmark: Unchecked
Author: AutoCAD SHX Text
Date:
Color:

CHECKED BY:

7030

Subject:
Page Label: 13
Lock: Unlocked
Status:
Checkmark: Unchecked
Author: AutoCAD SHX Text
Date:
Color:


7030

3+00

75

Subject:
Page Label: 13
Lock: Unlocked
Status:
Checkmark: Unchecked
Author: AutoCAD SHX Text
Date:
Color:

3+00

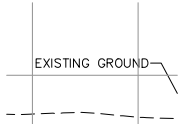

Subject:
Page Label: 13
Lock: Unlocked
Status:
Checkmark: Unchecked
Author: AutoCAD SHX Text
Date:
Color:

EXISTING GROUND

TARY
SCALE:
HORIZONTAL
1"=50'

Subject:
Page Label: 13
Lock: Unlocked
Status:
Checkmark: Unchecked
Author: AutoCAD SHX Text
Date:
Color:

SCALE:



Subject:
Page Label: 13
Lock: Unlocked
Status:
Checkmark: Unchecked
Author: AutoCAD SHX Text
Date:
Color:

TRACT 'L'

DATE:

Subject:
Page Label: 13
Lock: Unlocked
Status:
Checkmark: Unchecked
Author: AutoCAD SHX Text
Date:
Color:

DATE:

1+00

FIELD

Subject:
Page Label: 13
Lock: Unlocked
Status:
Checkmark: Unchecked
Author: AutoCAD SHX Text
Date:
Color:

1+00

7020

Subject:
Page Label: 13
Lock: Unlocked
Status:
Checkmark: Unchecked
Author: AutoCAD SHX Text
Date:
Color:

7020

5

Subject:
Page Label: 13
Lock: Unlocked
Status:
Checkmark: Unchecked
Author: AutoCAD SHX Text
Date:
Color:

5

PROPOSED
FINISH GRADE

Subject:
Page Label: 13
Lock: Unlocked
Status:
Checkmark: Unchecked
Author: AutoCAD SHX Text
Date:
Color:

PROPOSED FINISH GRADE

2 2+00
SPRAGUE WAY

Subject:
Page Label: 13
Lock: Unlocked
Status:
Checkmark: Unchecked
Author: AutoCAD SHX Text
Date:
Color:

SPRAGUE WAY

9

Subject:
Page Label: 13
Lock: Unlocked
Status:
Checkmark: Unchecked
Author: AutoCAD SHX Text
Date:
Color:

9



Subject:
Page Label: 13
Lock: Unlocked
Status:
Checkmark: Unchecked
Author: AutoCAD SHX Text
Date:
Color:

TRACT 'V'

19

Subject:
Page Label: 13
Lock: Unlocked
Status:
Checkmark: Unchecked
Author: AutoCAD SHX Text
Date:
Color:

19




Subject:
Page Label: 13
Lock: Unlocked
Status:
Checkmark: Unchecked
Author: AutoCAD SHX Text
Date:
Color:

FOR BURIED UTILITY INFORMATION

REVISIONS:	
NO.	DATE:

Subject:
Page Label: 13
Lock: Unlocked
Status:
Checkmark: Unchecked
Author: AutoCAD SHX Text
Date:
Color:

REVISIONS:

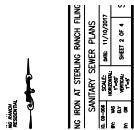

Subject:
Page Label: 13
Lock: Unlocked
Status:
Checkmark: Unchecked
Author: AutoCAD SHX Text
Date:
Color:

SANITARY SEWER PLANS

25

Subject:
Page Label: 13
Lock: Unlocked
Status:
Checkmark: Unchecked
Author: AutoCAD SHX Text
Date:
Color:

25

20

TRACT 'S'
EX 12" PVC SA

Subject:
Page Label: 13
Lock: Unlocked
Status:
Checkmark: Unchecked
Author: AutoCAD SHX Text
Date:
Color:

TRACT 'S'

SCALE:
HORIZONTAL:
1"=50'
VERTICAL:
1"=5'

Subject:
Page Label: 13
Lock: Unlocked
Status:
Checkmark: Unchecked
Author: AutoCAD SHX Text
Date:
Color:

VERTICAL:

10

Subject:
Page Label: 13
Lock: Unlocked
Status:
Checkmark: Unchecked
Author: AutoCAD SHX Text
Date:
Color:

10

TRACT 'W'
RANCH
IDENTICAL

Subject:
Page Label: 13
Lock: Unlocked
Status:
Checkmark: Unchecked
Author: AutoCAD SHX Text
Date:
Color:

TRACT 'W'

18


Subject:
Page Label: 13
Lock: Unlocked
Status:
Checkmark: Unchecked
Author: AutoCAD SHX Text
Date:
Color:

18

7035


Subject:
Page Label: 13
Lock: Unlocked
Status:
Checkmark: Unchecked
Author: AutoCAD SHX Text
Date:
Color:

7035

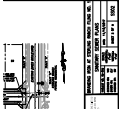

Subject:
Page Label: 13
Lock: Unlocked
Status:
Checkmark: Unchecked
Author: AutoCAD SHX Text
Date:
Color:

BRANDING IRON AT STERLING RANCH FILING NO. 1

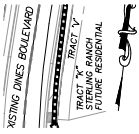


Subject:
Page Label: 13
Lock: Unlocked
Status:
Checkmark: Unchecked
Author: AutoCAD SHX Text
Date:
Color:

TRACT "K" STERLING RANCH FUTURE RESIDENTIAL

23


Subject:
Page Label: 13
Lock: Unlocked
Status:
Checkmark: Unchecked
Author: AutoCAD SHX Text
Date:
Color:

23

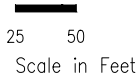


Subject:
Page Label: 14
Lock: Unlocked
Status:
Checkmark: Unchecked
Author: AutoCAD SHX Text
Date:
Color:

Scale in Feet

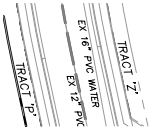

Subject:
Page Label: 14
Lock: Unlocked
Status:
Checkmark: Unchecked
Author: AutoCAD SHX Text
Date:
Color:


EX 16" PVC WATER

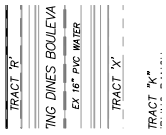


Subject: EX 16" PVC WATER
Page Label: 14
Lock: Unlocked
Status:
Checkmark: Unchecked
Author: AutoCAD SHX Text
Date:
Color:



Subject: CAUTION
Page Label: 14
Lock: Unlocked
Status:
Checkmark: Unchecked
Author: AutoCAD SHX Text
Date:
Color:

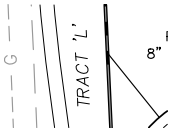


Subject: TRACT 'L'
Page Label: 14
Lock: Unlocked
Status:
Checkmark: Unchecked
Author: AutoCAD SHX Text
Date:
Color:

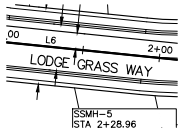

Subject: LODGE GRASS WAY
Page Label: 14
Lock: Unlocked
Status:
Checkmark: Unchecked
Author: AutoCAD SHX Text
Date:
Color:



Subject: 7040
Page Label: 14
Lock: Unlocked
Status:
Checkmark: Unchecked
Author: AutoCAD SHX Text
Date:
Color:

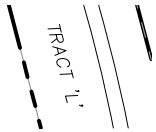

Subject: TRACT 'L'
Page Label: 14
Lock: Unlocked
Status:
Checkmark: Unchecked
Author: AutoCAD SHX Text
Date:
Color:

7055

Subject: 7055
Page Label: 14
Lock: Unlocked
Status:
Checkmark: Unchecked
Author: AutoCAD SHX Text
Date:
Color:

25

Subject: 25
Page Label: 14
Lock: Unlocked
Status:
Checkmark: Unchecked
Author: AutoCAD SHX Text
Date:
Color:

EX 16" PVC WATER
TRACT 'Z'
7 STE

Subject: TRACT 'Z'
Page Label: 14
Lock: Unlocked
Status:
Checkmark: Unchecked
Author: AutoCAD SHX Text
Date:
Color:

7035

Subject: 7035
Page Label: 14
Lock: Unlocked
Status:
Checkmark: Unchecked
Author: AutoCAD SHX Text
Date:
Color:

1" =

Subject: 1" =
Page Label: 14
Lock: Unlocked
Status:
Checkmark: Unchecked
Author: AutoCAD SHX Text
Date:
Color:

EX 16" PVC W
TRACT 'X'
TRACT 'K'
LING RANCH

Subject: TRACT 'X'
Page Label: 14
Lock: Unlocked
Status:
Checkmark: Unchecked
Author: AutoCAD SHX Text
Date:
Color:

45

Subject: 45
Page Label: 14
Lock: Unlocked
Status:
Checkmark: Unchecked
Author: AutoCAD SHX Text
Date:
Color:

0+00

Subject: 0+00
Page Label: 14
Lock: Unlocked
Status:
Checkmark: Unchecked
Author: AutoCAD SHX Text
Date:
Color:

7050

Subject: 7050
Page Label: 14
Lock: Unlocked
Status:
Checkmark: Unchecked
Author: AutoCAD SHX Text
Date:
Color:

FOR AND ON BEHALF OF M&S CIVIL CONSULTANTS, INC.

Subject: FOR AND ON BEHALF OF M&S CIVIL CONSULTANTS, INC.
Page Label: 14
Lock: Unlocked
Status:
Checkmark: Unchecked
Author: AutoCAD SHX Text
Date:
Color:

TRACT 'Y'

Subject: TRACT 'Y'
Page Label: 14
Lock: Unlocked
Status:
Checkmark: Unchecked
Author: AutoCAD SHX Text
Date:
Color:

100

Subject: 100
Page Label: 14
Lock: Unlocked
Status:
Checkmark: Unchecked
Author: AutoCAD SHX Text
Date:
Color:

RANCH FILIN
R PLANS
11/10/2017
LET 3 OF 4

Subject: 11/10/2017
Page Label: 14
Lock: Unlocked
Status:
Checkmark: Unchecked
Author: AutoCAD SHX Text
Date:
Color:

MCCLINTOCK
STATION
LOT C

Subject: MCCLINTOCK STATION LOT C
Page Label: 14
Lock: Unlocked
Status:
Checkmark: Unchecked
Author: AutoCAD SHX Text
Date:
Color:

DATE:

Subject: DATE:
Page Label: 14
Lock: Unlocked
Status:
Checkmark: Unchecked
Author: AutoCAD SHX Text
Date:
Color:

46

Subject: 46
Page Label: 14
Lock: Unlocked
Status:
Checkmark: Unchecked
Author: AutoCAD SHX Text
Date:
Color:




Subject: 48 HRS BEFORE YOU DIG
Page Label: 14
Lock: Unlocked
Status:
Checkmark: Unchecked
Author: AutoCAD SHX Text
Date:
Color:



Subject: CALL 1-800-922-1987
Page Label: 14
Lock: Unlocked
Status:
Checkmark: Unchecked
Author: AutoCAD SHX Text
Date:
Color:

7045

Subject: 7045
Page Label: 14
Lock: Unlocked
Status:
Checkmark: Unchecked
Author: AutoCAD SHX Text
Date:
Color:

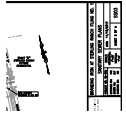

Subject: BRANDING IRON AT STERLING RANCH FILING NO. 1
Page Label: 14
Lock: Unlocked
Status:
Checkmark: Unchecked
Author: AutoCAD SHX Text
Date:
Color:




Subject: TRACT 'Y'
Page Label: 14
Lock: Unlocked
Status:
Checkmark: Unchecked
Author: AutoCAD SHX Text
Date:
Color:

42

Subject: 42
Page Label: 14
Lock: Unlocked
Status:
Checkmark: Unchecked
Author: AutoCAD SHX Text
Date:
Color:

50

Subject: 50
Page Label: 14
Lock: Unlocked
Status:
Checkmark: Unchecked
Author: AutoCAD SHX Text
Date:
Color:

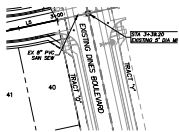

Subject: EXISTING DINES BOULEVARD
Page Label: 14
Lock: Unlocked
Status:
Checkmark: Unchecked
Author: AutoCAD SHX Text
Date:
Color:

3+00
1175 20

Subject:
Page Label: 14 3+00
Lock: Unlocked
Status:
Checkmark: Unchecked
Author: AutoCAD SHX Text
Date:
Color:

51
TRACT 'P'
EX 12" PVC

Subject:
Page Label: 14 TRACT 'P'
Lock: Unlocked
Status:
Checkmark: Unchecked
Author: AutoCAD SHX Text
Date:
Color:



Subject:
Page Label: 14 FOR BURIED UTILITY INFORMATION
Lock: Unlocked
Status:
Checkmark: Unchecked
Author: AutoCAD SHX Text
Date:
Color:

REF
NO.

Subject:
Page Label: 14 NO.
Lock: Unlocked
Status:
Checkmark: Unchecked
Author: AutoCAD SHX Text
Date:
Color:

7055

Subject:
Page Label: 14 7055
Lock: Unlocked
Status:
Checkmark: Unchecked
Author: AutoCAD SHX Text
Date:
Color:

39
TRACT 'Q'
PVC SAN SEW

Subject:
Page Label: 14 TRACT 'Q'
Lock: Unlocked
Status:
Checkmark: Unchecked
Author: AutoCAD SHX Text
Date:
Color:

3+00
TA 210

Subject: 3+00
Page Label: 14
Lock: Unlocked
Status:
Checkmark: Unchecked
Author: AutoCAD SHX Text
Date:
Color:

7045


Subject: 7045
Page Label: 14
Lock: Unlocked
Status:
Checkmark: Unchecked
Author: AutoCAD SHX Text
Date:
Color:

4+00

Subject: 4+00
Page Label: 14
Lock: Unlocked
Status:
Checkmark: Unchecked
Author: AutoCAD SHX Text
Date:
Color:

ELI
GW

Subject: GW
Page Label: 14
Lock: Unlocked
Status:
Checkmark: Unchecked
Author: AutoCAD SHX Text
Date:
Color:

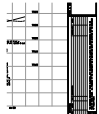

Subject: THE ENGINEER PREPARING THESE PLANS
Page Label: 14 WILL NOT BE RESPONSIBLE, OR LIABLE FOR,
Lock: Unlocked UNAUTHORIZED CHANGES TO OR USES OF
Status: THESE PLANS. ALL CHANGES TO THE PLANS
Checkmark: Unchecked MUST BE IN WRITING AND MUST BE
Author: AutoCAD SHX Text APPROVED BY THE PREPARER OF THESE
Date: PLANS.
Color:

35

Subject: 35
Page Label: 14
Lock: Unlocked
Status:
Checkmark: Unchecked
Author: AutoCAD SHX Text
Date:
Color:

37


Subject:
Page Label: 14
Lock: Unlocked
Status:
Checkmark: Unchecked
Author: AutoCAD SHX Text
Date:
Color:

37

49

Subject:
Page Label: 14
Lock: Unlocked
Status:
Checkmark: Unchecked
Author: AutoCAD SHX Text
Date:
Color:

49

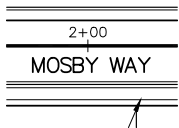

Subject:
Page Label: 14
Lock: Unlocked
Status:
Checkmark: Unchecked
Author: AutoCAD SHX Text
Date:
Color:

MOSBY WAY

43


Subject:
Page Label: 14
Lock: Unlocked
Status:
Checkmark: Unchecked
Author: AutoCAD SHX Text
Date:
Color:

43

40

Subject:
Page Label: 14
Lock: Unlocked
Status:
Checkmark: Unchecked
Author: AutoCAD SHX Text
Date:
Color:

40

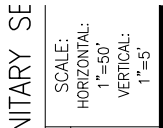

Subject:
Page Label: 14
Lock: Unlocked
Status:
Checkmark: Unchecked
Author: AutoCAD SHX Text
Date:
Color:

HORIZONTAL:

UNPLATTED

Subject:
Page Label: 14
Lock: Unlocked
Status:
Checkmark: Unchecked
Author: AutoCAD SHX Text
Date:
Color:

UNPLATTED

50

Subject:
Page Label: 14
Lock: Unlocked
Status:
Checkmark: Unchecked
Author: AutoCAD SHX Text
Date:
Color:

50

DATE:

Subject:
Page Label: 14
Lock: Unlocked
Status:
Checkmark: Unchecked
Author: AutoCAD SHX Text
Date:
Color:

DATE:

7060

Subject:
Page Label: 14
Lock: Unlocked
Status:
Checkmark: Unchecked
Author: AutoCAD SHX Text
Date:
Color:

7060

PROJECT NO. 0:
DESIGNED BY:
DRAWN BY:
CHECKED BY:

Subject:
Page Label: 14
Lock: Unlocked
Status:
Checkmark: Unchecked
Author: AutoCAD SHX Text
Date:
Color:

CHECKED BY:

BARBARICK
SUBDIVISION
LOT 3

Subject:
Page Label: 14
Lock: Unlocked
Status:
Checkmark: Unchecked
Author: AutoCAD SHX Text
Date:
Color:

BARBARICK SUBDIVISION LOT 3

SCALE:
HORIZONTAL:
1"=50'
VERTICAL:
1"=5'

Subject:
Page Label: 14
Lock: Unlocked
Status:
Checkmark: Unchecked
Author: AutoCAD SHX Text
Date:
Color:

VERTICAL:

48

Subject:
Page Label: 14
Lock: Unlocked
Status:
Checkmark: Unchecked
Author: AutoCAD SHX Text
Date:
Color:

48

39

Subject:
Page Label: 14
Lock: Unlocked
Status:
Checkmark: Unchecked
Author: AutoCAD SHX Text
Date:
Color:

39

SCALE:
HORIZONTAL:
1"=50'
VERTICAL:
1"=5'

Subject:
Page Label: 14
Lock: Unlocked
Status:
Checkmark: Unchecked
Author: AutoCAD SHX Text
Date:
Color:

1"=50'

VAS
ELY

Subject:
Page Label: 14
Lock: Unlocked
Status:
Checkmark: Unchecked
Author: AutoCAD SHX Text
Date:
Color:

VAS

DESCRIPTION:

Subject:
Page Label: 14
Lock: Unlocked
Status:
Checkmark: Unchecked
Author: AutoCAD SHX Text
Date:
Color:

DESCRIPTION:

7055

Subject:
Page Label: 14
Lock: Unlocked
Status:
Checkmark: Unchecked
Author: AutoCAD SHX Text
Date:
Color:

7055

7050

Subject:
Page Label: 14
Lock: Unlocked
Status:
Checkmark: Unchecked
Author: AutoCAD SHX Text
Date:
Color:

7050

34

Subject:
Page Label: 14
Lock: Unlocked
Status:
Checkmark: Unchecked
Author: AutoCAD SHX Text
Date:
Color:

34

PROJECT NO.
DESIGNED BY
DRAWN BY
CHECKED BY:

Subject:
Page Label: 14
Lock: Unlocked
Status:
Checkmark: Unchecked
Author: AutoCAD SHX Text
Date:
Color:

DRAWN BY:

DRAWING
PROJECT NO. 0
DESIGNED BY:
DRAWN BY:
CHECKED BY:

Subject:
Page Label: 14
Lock: Unlocked
Status:
Checkmark: Unchecked
Author: AutoCAD SHX Text
Date:
Color:

PROJECT NO.

TARY
SCALE:
HORIZONTAL
1"=50'

Subject:
Page Label: 14
Lock: Unlocked
Status:
Checkmark: Unchecked
Author: AutoCAD SHX Text
Date:
Color:

SCALE:

36

Subject: 36
Page Label: 14
Lock: Unlocked
Status:
Checkmark: Unchecked
Author: AutoCAD SHX Text
Date:
Color:

REVISIONS:	
NO.	DATE:

Subject: REVISIONS:
Page Label: 14
Lock: Unlocked
Status:
Checkmark: Unchecked
Author: AutoCAD SHX Text
Date:
Color:

0

Subject: 0
Page Label: 14
Lock: Unlocked
Status:
Checkmark: Unchecked
Author: AutoCAD SHX Text
Date:
Color:

2+00
0+00

Subject: 2+00
Page Label: 14
Lock: Unlocked
Status:
Checkmark: Unchecked
Author: AutoCAD SHX Text
Date:
Color:

7050

Subject: 7050
Page Label: 14
Lock: Unlocked
Status:
Checkmark: Unchecked
Author: AutoCAD SHX Text
Date:
Color:

30

Subject: 30
Page Label: 14
Lock: Unlocked
Status:
Checkmark: Unchecked
Author: AutoCAD SHX Text
Date:
Color:

4+00

Subject: 4+00
Page Label: 14
Lock: Unlocked
Status:
Checkmark: Unchecked
Author: AutoCAD SHX Text
Date:
Color:

7065

Subject: 7065
Page Label: 14
Lock: Unlocked
Status:
Checkmark: Unchecked
Author: AutoCAD SHX Text
Date:
Color:

2+00

STA 0

Subject: 2+00
Page Label: 14
Lock: Unlocked
Status:
Checkmark: Unchecked
Author: AutoCAD SHX Text
Date:
Color:

7060


Subject: 7060
Page Label: 14
Lock: Unlocked
Status:
Checkmark: Unchecked
Author: AutoCAD SHX Text
Date:
Color:

7045

Subject: 7045
Page Label: 14
Lock: Unlocked
Status:
Checkmark: Unchecked
Author: AutoCAD SHX Text
Date:
Color:

41

Subject: 41
Page Label: 14
Lock: Unlocked
Status:
Checkmark: Unchecked
Author: AutoCAD SHX Text
Date:
Color:

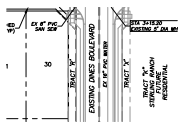

Subject:
Page Label: 14
Lock: Unlocked
Status:
Checkmark: Unchecked
Author: AutoCAD SHX Text
Date:
Color:

EXISTING DINES BOULEVARD



Subject:
Page Label: 14
Lock: Unlocked
Status:
Checkmark: Unchecked
Author: AutoCAD SHX Text
Date:
Color:

SHEET 3 OF 4



Subject:
Page Label: 14
Lock: Unlocked
Status:
Checkmark: Unchecked
Author: AutoCAD SHX Text
Date:
Color:

SS03



Subject:
Page Label: 14
Lock: Unlocked
Status:
Checkmark: Unchecked
Author: AutoCAD SHX Text
Date:
Color:

BY:

38

Subject:
Page Label: 14
Lock: Unlocked
Status:
Checkmark: Unchecked
Author: AutoCAD SHX Text
Date:
Color:

38



Subject:
Page Label: 14
Lock: Unlocked
Status:
Checkmark: Unchecked
Author: AutoCAD SHX Text
Date:
Color:

TRACT "K" STERLING RANCH FUTURE RESIDENTIAL

NO	DATE	BY	REVISION
1			
2			
3			
4			
5			
6			
7			
8			
9			
10			

Subject: SANITARY SEWER PLANS
Page Label: 14
Lock: Unlocked
Status:
Checkmark: Unchecked
Author: AutoCAD SHX Text
Date:
Color:

50'

Subject: 50'
Page Label: 14
Lock: Unlocked
Status:
Checkmark: Unchecked
Author: AutoCAD SHX Text
Date:
Color:

7040

Subject: 7040
Page Label: 14
Lock: Unlocked
Status:
Checkmark: Unchecked
Author: AutoCAD SHX Text
Date:
Color:

TRACT "G"
STERLING RANCH
FUTURE
RESIDENTIAL

Subject: TRACT "G" STERLING RANCH FUTURE RESIDENTIAL
Page Label: 14
Lock: Unlocked
Status:
Checkmark: Unchecked
Author: AutoCAD SHX Text
Date:
Color:

32

Subject: 32
Page Label: 14
Lock: Unlocked
Status:
Checkmark: Unchecked
Author: AutoCAD SHX Text
Date:
Color:

7060

Subject: 7060
Page Label: 14
Lock: Unlocked
Status:
Checkmark: Unchecked
Author: AutoCAD SHX Text
Date:
Color:

31

Subject:
Page Label: 14
Lock: Unlocked
Status:
Checkmark: Unchecked
Author: AutoCAD SHX Text
Date:
Color:

31

EX 16" P.C. MAT
TRACT "K"
TRACT "K"
STERLING RANCH
FUTURE
RESIDENTIAL

Subject:
Page Label: 14
Lock: Unlocked
Status:
Checkmark: Unchecked
Author: AutoCAD SHX Text
Date:
Color:

TRACT "K" STERLING RANCH FUTURE
RESIDENTIAL

FOR LOCATING
& MARKING
GAS,
ELECTRIC,
WATER &
TELEPHONE
LINES
UTILITY INFORMATION

37160

Subject:
Page Label: 14
Lock: Unlocked
Status:
Checkmark: Unchecked
Author: AutoCAD SHX Text
Date:
Color:

FOR LOCATING & MARKING GAS, ELECTRIC,
WATER & TELEPHONE LINES

VERTICAL
1"=5'

Subject:
Page Label: 14
Lock: Unlocked
Status:
Checkmark: Unchecked
Author: AutoCAD SHX Text
Date:
Color:

1"=5'

33

Subject:
Page Label: 14
Lock: Unlocked
Status:
Checkmark: Unchecked
Author: AutoCAD SHX Text
Date:
Color:

33

1+00
MOSBY

Subject:
Page Label: 14
Lock: Unlocked
Status:
Checkmark: Unchecked
Author: AutoCAD SHX Text
Date:
Color:

1+00

PROJECT NO. 05
DESIGNED BY:
DRAWN BY:
CHECKED BY:

Subject:
Page Label: 14
Lock: Unlocked
Status:
Checkmark: Unchecked
Author: AutoCAD SHX Text
Date:
Color:

DESIGNED BY:

CTIONS:
DATE:

Subject:
Page Label: 14
Lock: Unlocked
Status:
Checkmark: Unchecked
Author: AutoCAD SHX Text
Date:
Color:

DATE:

7040

Subject:
Page Label: 14
Lock: Unlocked
Status:
Checkmark: Unchecked
Author: AutoCAD SHX Text
Date:
Color:

7040

0+00

Subject:
Page Label: 14
Lock: Unlocked
Status:
Checkmark: Unchecked
Author: AutoCAD SHX Text
Date:
Color:

0+00

30
TRACT 'R'
NG DINES BC

Subject:
Page Label: 14
Lock: Unlocked
Status:
Checkmark: Unchecked
Author: AutoCAD SHX Text
Date:
Color:

TRACT 'R'

40
TRACT 'Q'
S BOULEVAR

Subject:
Page Label: 14
Lock: Unlocked
Status:
Checkmark: Unchecked
Author: AutoCAD SHX Text
Date:
Color:

TRACT 'Q'

7050

Subject:
Page Label: 14
Lock: Unlocked
Status:
Checkmark: Unchecked
Author: AutoCAD SHX Text
Date:
Color:

7050

44

Subject:
Page Label: 14
Lock: Unlocked
Status:
Checkmark: Unchecked
Author: AutoCAD SHX Text
Date:
Color:

44

VAS
ELY
GW

Subject:
Page Label: 14
Lock: Unlocked
Status:
Checkmark: Unchecked
Author: AutoCAD SHX Text
Date:
Color:

ELY

7055

Subject:
Page Label: 14
Lock: Unlocked
Status:
Checkmark: Unchecked
Author: AutoCAD SHX Text
Date:
Color:

7055

51


Subject:
Page Label: 14
Lock: Unlocked
Status:
Checkmark: Unchecked
Author: AutoCAD SHX Text
Date:
Color:

51

47


Subject:
Page Label: 14
Lock: Unlocked
Status:
Checkmark: Unchecked
Author: AutoCAD SHX Text
Date:
Color:

47

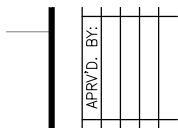


Subject:
Page Label: 14
Lock: Unlocked
Status:
Checkmark: Unchecked
Author: AutoCAD SHX Text
Date:
Color:

APRV'D. BY:

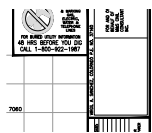


Subject:
Page Label: 14
Lock: Unlocked
Status:
Checkmark: Unchecked
Author: AutoCAD SHX Text
Date:
Color:

VIRGIL A. SANCHEZ, COLORADO P.E. NO. 37160

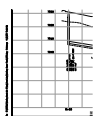


Subject:
Page Label: 14
Lock: Unlocked
Status:
Checkmark: Unchecked
Author: AutoCAD SHX Text
Date:
Color:

File: O:\09006A\Sterling Ranch No 3\dwg\Const Dwg\Sanitary Sewer Plans\SS03.dwg Plotstamp: 11/6/2017 8:49 PM

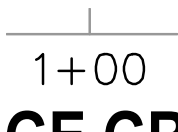

Subject:
Page Label: 14
Lock: Unlocked
Status:
Checkmark: Unchecked
Author: AutoCAD SHX Text
Date:
Color:

1+00

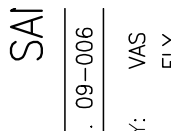

Subject:
Page Label: 14
Lock: Unlocked
Status:
Checkmark: Unchecked
Author: AutoCAD SHX Text
Date:
Color:

09-006