
Uploading this in place of storm water plan/ permit because I was told by County that no site plan would be need since we are permiting an existing structure. Please except this for this spot so we can get the permits going.

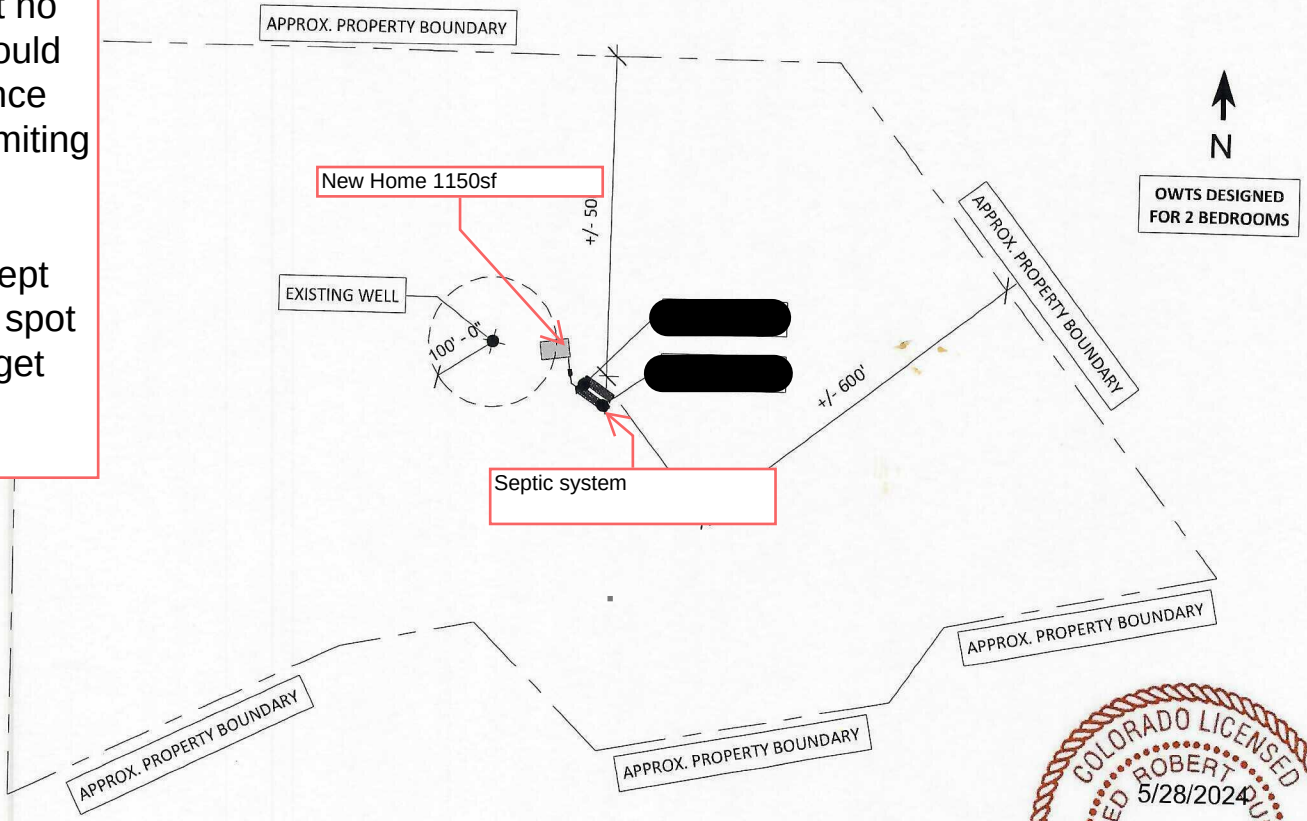

COLORADO LICENSED
JARED ROBERT DUMKE
5/28/2024
54410
PROFESSIONAL ENGINEER

SPECIAL NOTE TO INSTALLER:
A SEWAGE HANDLING PUMP MAY BE REQUIRED IF GRAVITY FLOW TO THE SEPTIC TANK IS NOT POSSIBLE DUE TO TOPOGRAPHY ONSITE AND/OR FINAL RESIDENTIAL AS-BUILT CONDITIONS. LIFT STATION IS OUTSIDE THE SCOPE OF THIS DESIGN.

WHILE EVERY EFFORT WAS MADE TO ORIENT THE FIELD TO MINIMIZE TREE LOSS, SOME TREES WILL HAVE TO BE REMOVED. THE INSTALLER MAY SHIFT THE FIELD SLIGHTLY, WITHIN THE AREA OF THE PROFILE EVALUATION, AT THEIR DISCRETION TO MINIMIZE TREE LOSS.

THIS IS NOT A SURVEY: INFORMATION SHOWN ON THIS PLOT MAP IS FOR THE PURPOSE OF OBTAINING A SEPTIC PERMIT IN EL PASO COUNTY, CO AND IS BASED ON INFORMATION OBTAINED FROM THE EL PASO COUNTY ASSESSORS WEBSITE, ONLINE RESOURCES, AND INFORMATION PROVIDED BY THE HOMEOWNER.

(1) 01 - Vicinity Plan
1" = 300'-0"

JDM CONSULTING, LLC
P.O. Box 26137, Colorado Springs, CO 80936
p. 719.251.5291 267.261.1825
e. daniel@jdmengineers.com jared@jdmengineers.com

20170 Saddle Blanket Ln, 80831

OWTS Design

Vicinity Plan

Project number	24-096
Date	5/28/2024
Drawn by	D.MIZICKO
Checked by	J.DUMKE

Scale 1" = 300'-0"