3 **GREENHOUSE EXAMPLE**
(SHOWN FOR REFERENCE ONLY)

Please provide location and setbacks for proposed greenhouse on site development plan. Provide square footage and height as well.

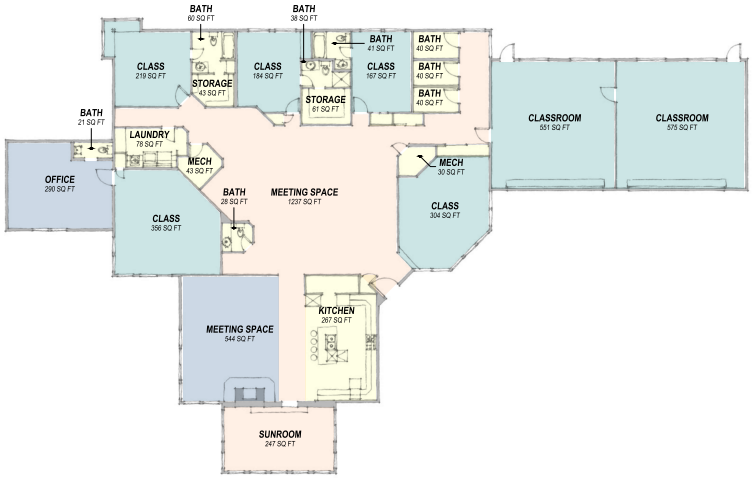

2 **SCHOOL HOUSE FLOOR PLAN**
SCALE 3/32" = 1'-0"

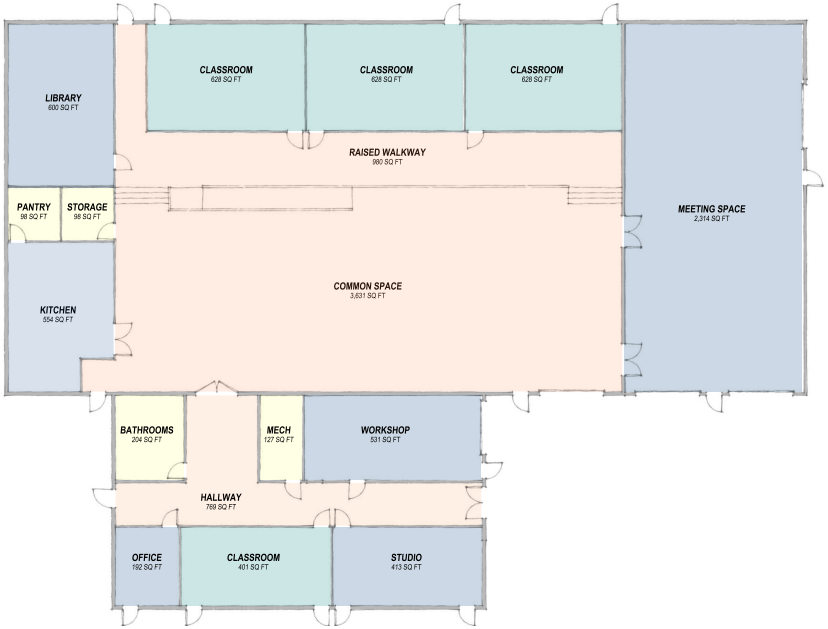

1 **SCHOOL BARN FLOOR PLAN**
SCALE 3/32" = 1'-0"

4CREEKS
324 S SANTA FE
SUITE A
VISALIA, CA 93292
WEB: 4-Creeks.com
TEL: 559.802.3052
FAX: 559.802.3215

LICENSED ARCHITECT
WILLIAM D. RUDFF III
NOT FOR CONSTRUCTION
ARC 00407313
10.31.2023
RENEWAL
STATE OF COLORADO

DATE	SUBMITTAL

APPROVED BY:

DATE SIGNATURE

THESE DRAWINGS ARE INSTRUMENTS OF SERVICE AND ARE THE PROPERTY OF 4CREEKS. THE DESIGN AND INFORMATION REPRESENTED ON THESE DRAWINGS ARE EXCLUSIVELY FOR THE PROJECT INDICATED AND SHALL NOT BE TRANSFERRED OR OTHERWISE REPRODUCED WITHOUT EXPRESS WRITTEN PERMISSION FROM 4CREEKS.

HAVEN SCHOOL
5484 BURGESS RD.
COLORADO SPRINGS, CO 80908
APN 62-201-0037

PLOT DATE: 7/12/2023
JOB NO.: 22470

FLOOR PLANS

A2.0