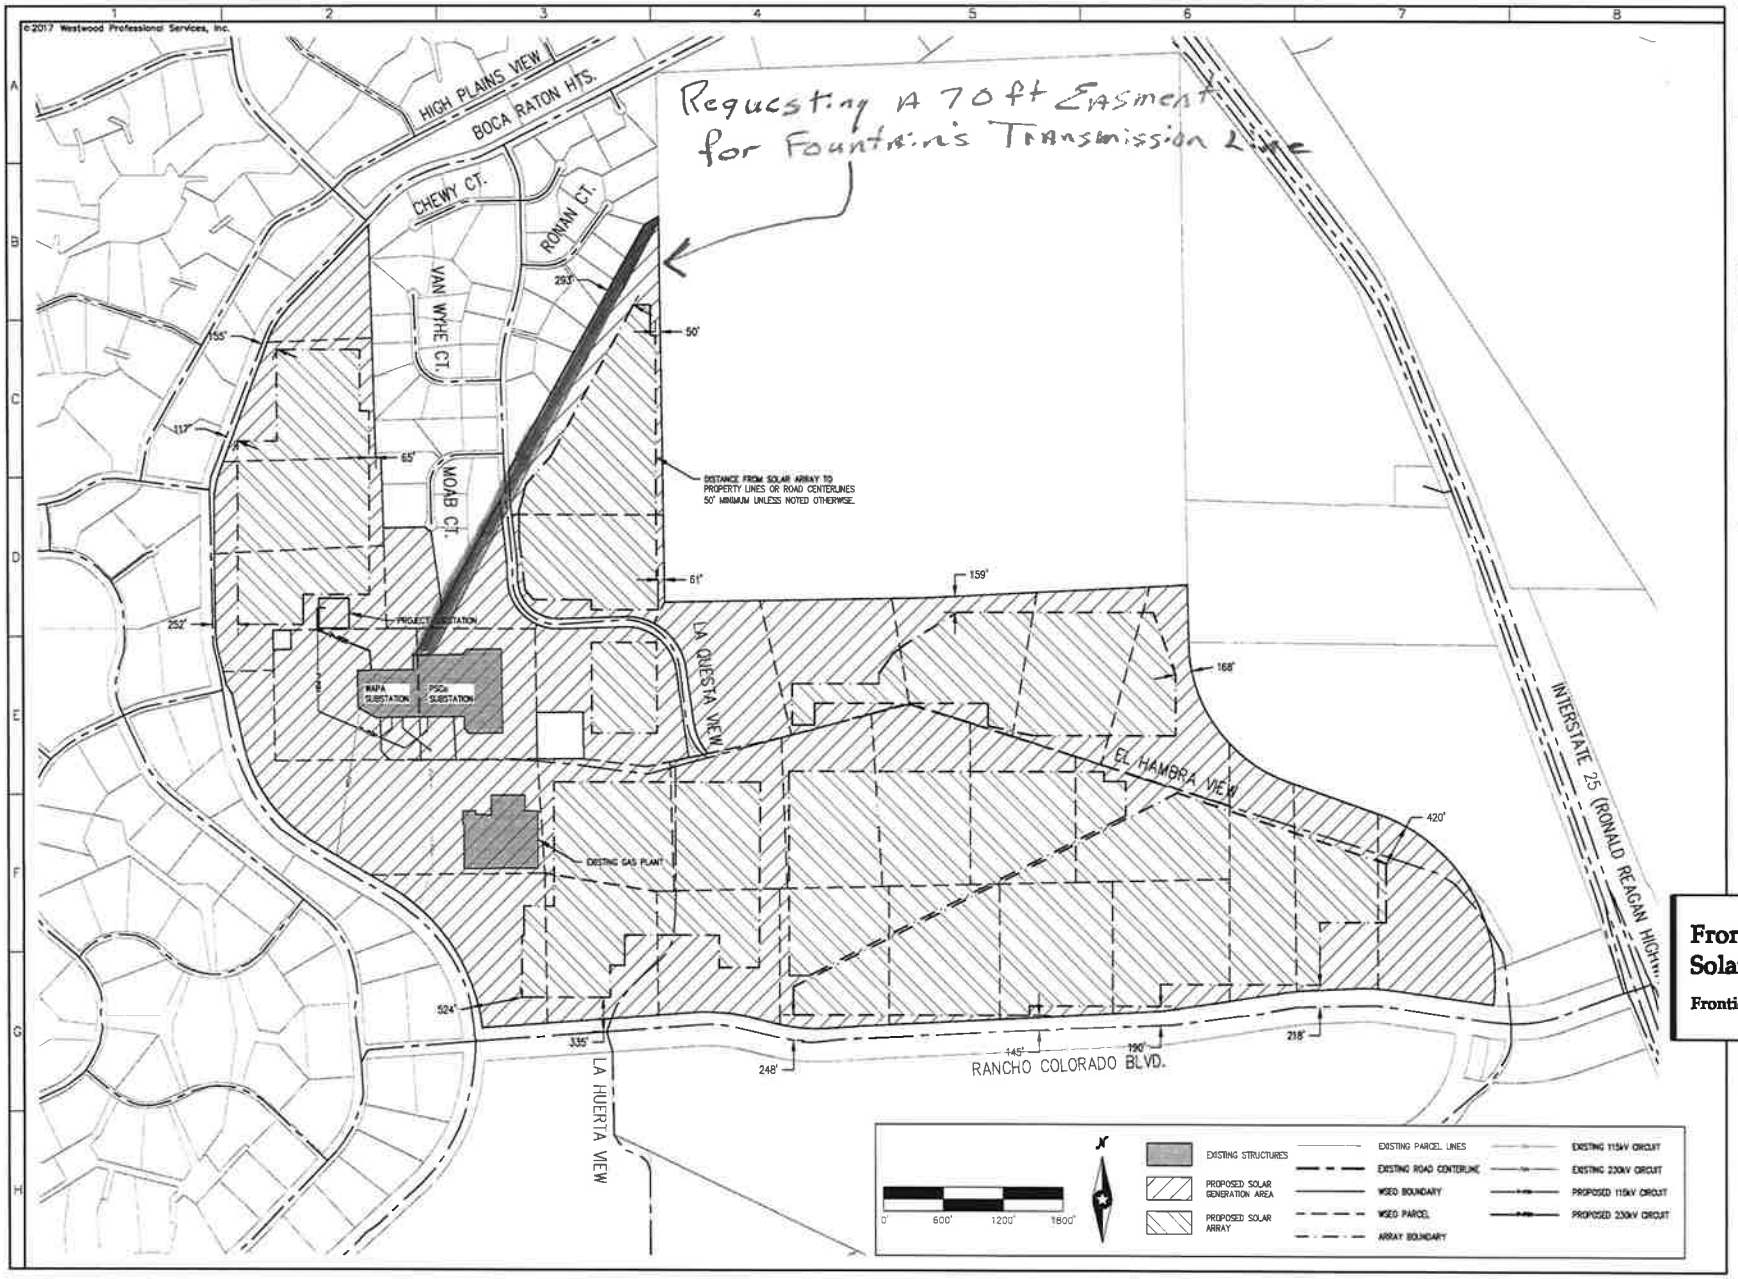

Westwood

Phone: (214) 473-4640 9740 Dallas Parkway N.,#350
Toll Free: (888) 937-5150 Plano, TX 75093
www.westwoodps.com

Westwood Professional Services, Inc.

Designed: DCB
Checked: JMH
Drawn: DCB
Record Drawing by/date:

Revisions #	DATE	DESCRIPTION

Prepared for:

TRADEWIND ENERGY

16105 West 113th Street, Suite 105
Lenexa, KS 66219

Front Range-Midway Solar Project

Frontier, CO

Proposed Solar Generation Map

Preliminary
Not For Construction

Date: 10/6/17
Drawing No: 5 of 12