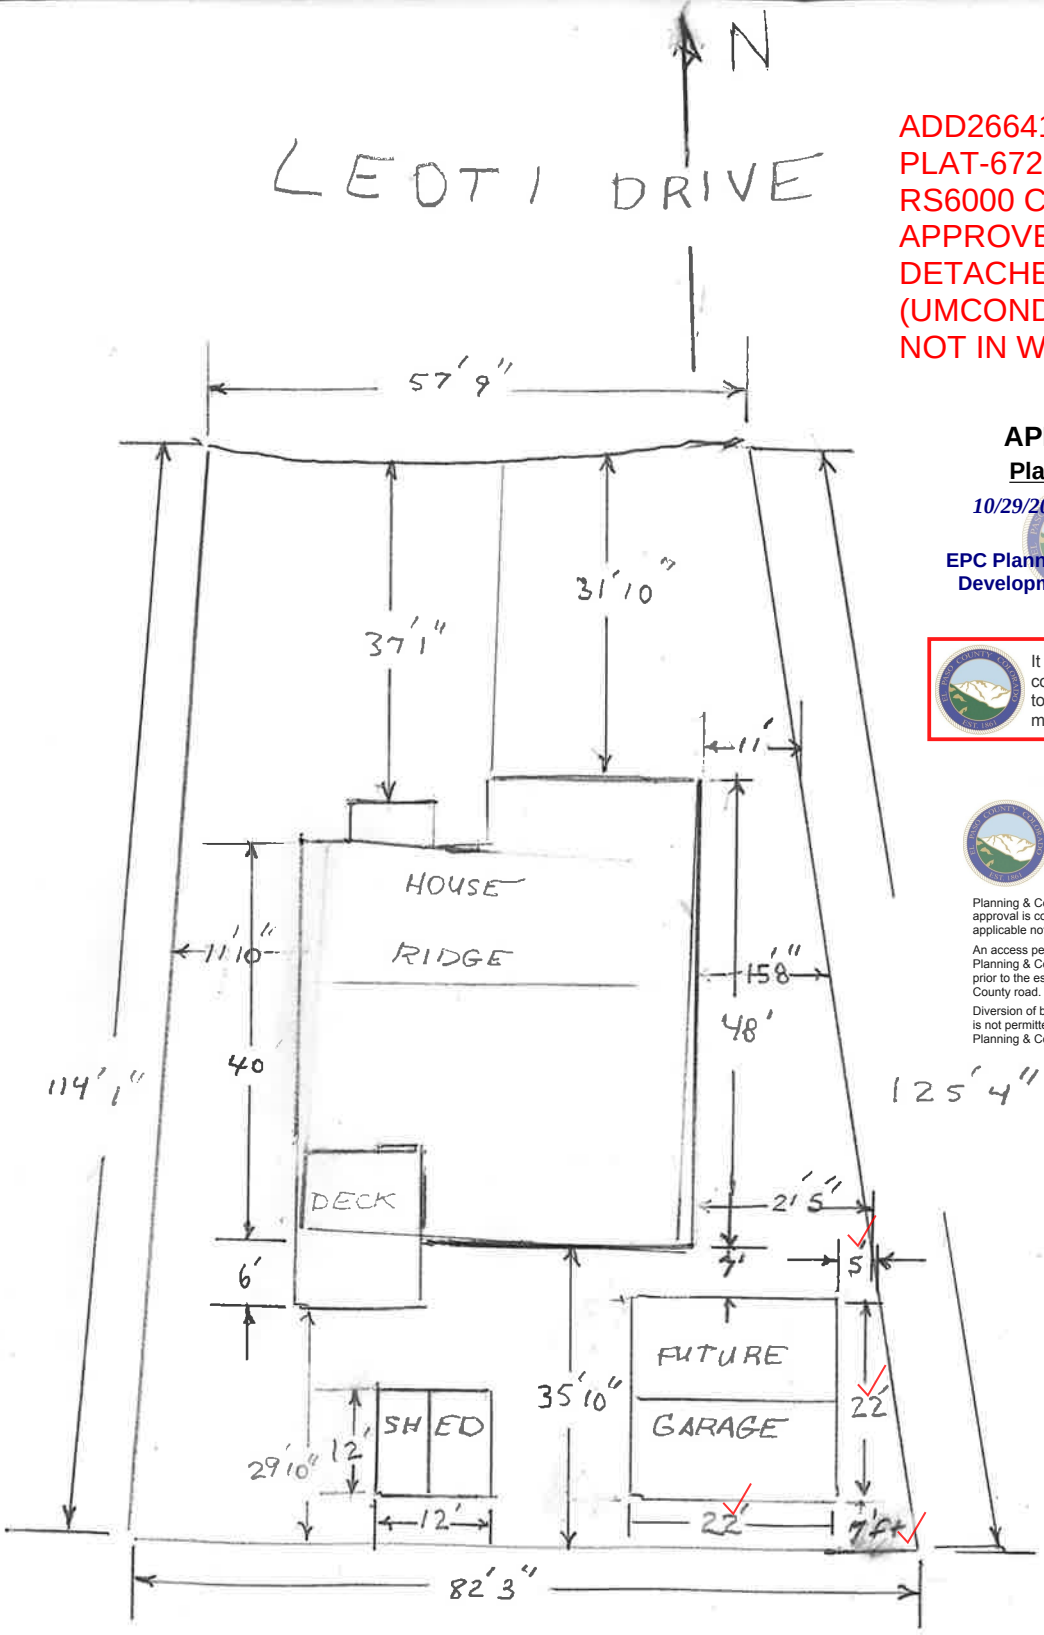


ADD26641
PLAT-6720
RS6000 CAD-O
APPROVED 484 SQ FT
DETACHED GARAGE
(UMCONDITIONED)
NOT IN WUI

APPROVED

Plan Review

10/29/2026 8:57:03 AM
dsdhills

EPC Planning & Community Development Department

It is the owner's responsibility to coordinate with easement holders to avoid impact to utilities that may be located in the easements.

ANY APPROVAL GIVEN BY EL PASO COUNTY DOES NOT OBVIATE THE NEED TO COMPLY WITH APPLICABLE FEDERAL, STATE, OR LOCAL LAWS AND/OR REGULATION

Planning & Community Development Department approval is contingent upon compliance with all applicable notes on the recorded plat.

An access permit must be granted by the Planning & Community Development Department prior to the establishment of any driveway onto a County road.

Diversion of blockage of any drainage way is not permitted without approval of the Planning & Community Development Department

SCALE 1"=20'

SITE PLAN

5406422018
1925 LEOTI DR✓
RS-6000✓
R06720✓
LOT 77✓ CONSTITUTION HILLS FIL NO.1