Please Include:
-At what height will wall mounted fixtures be hung up at?
- 5 parking spots or more requires lighting in parking lot

Detailed description of illuminating devices, fixtures, lamps, supports, reflectors, installation, and electrical details and other devices to include an elevation drawing. The description may include, but is not limited to, manufacturers specifications and catalog cuts sheets, and drawings. A key and legend may be required at the discretion of the PCD.

Photometric data and plan, including maps and diagrams furnished by manufacturers or similar showing the angle of the cut off or light emission.

Photometric plan depicting the lighting levels (foot candles) throughout the property, at property lines, and along any adjacent rights-of-way.

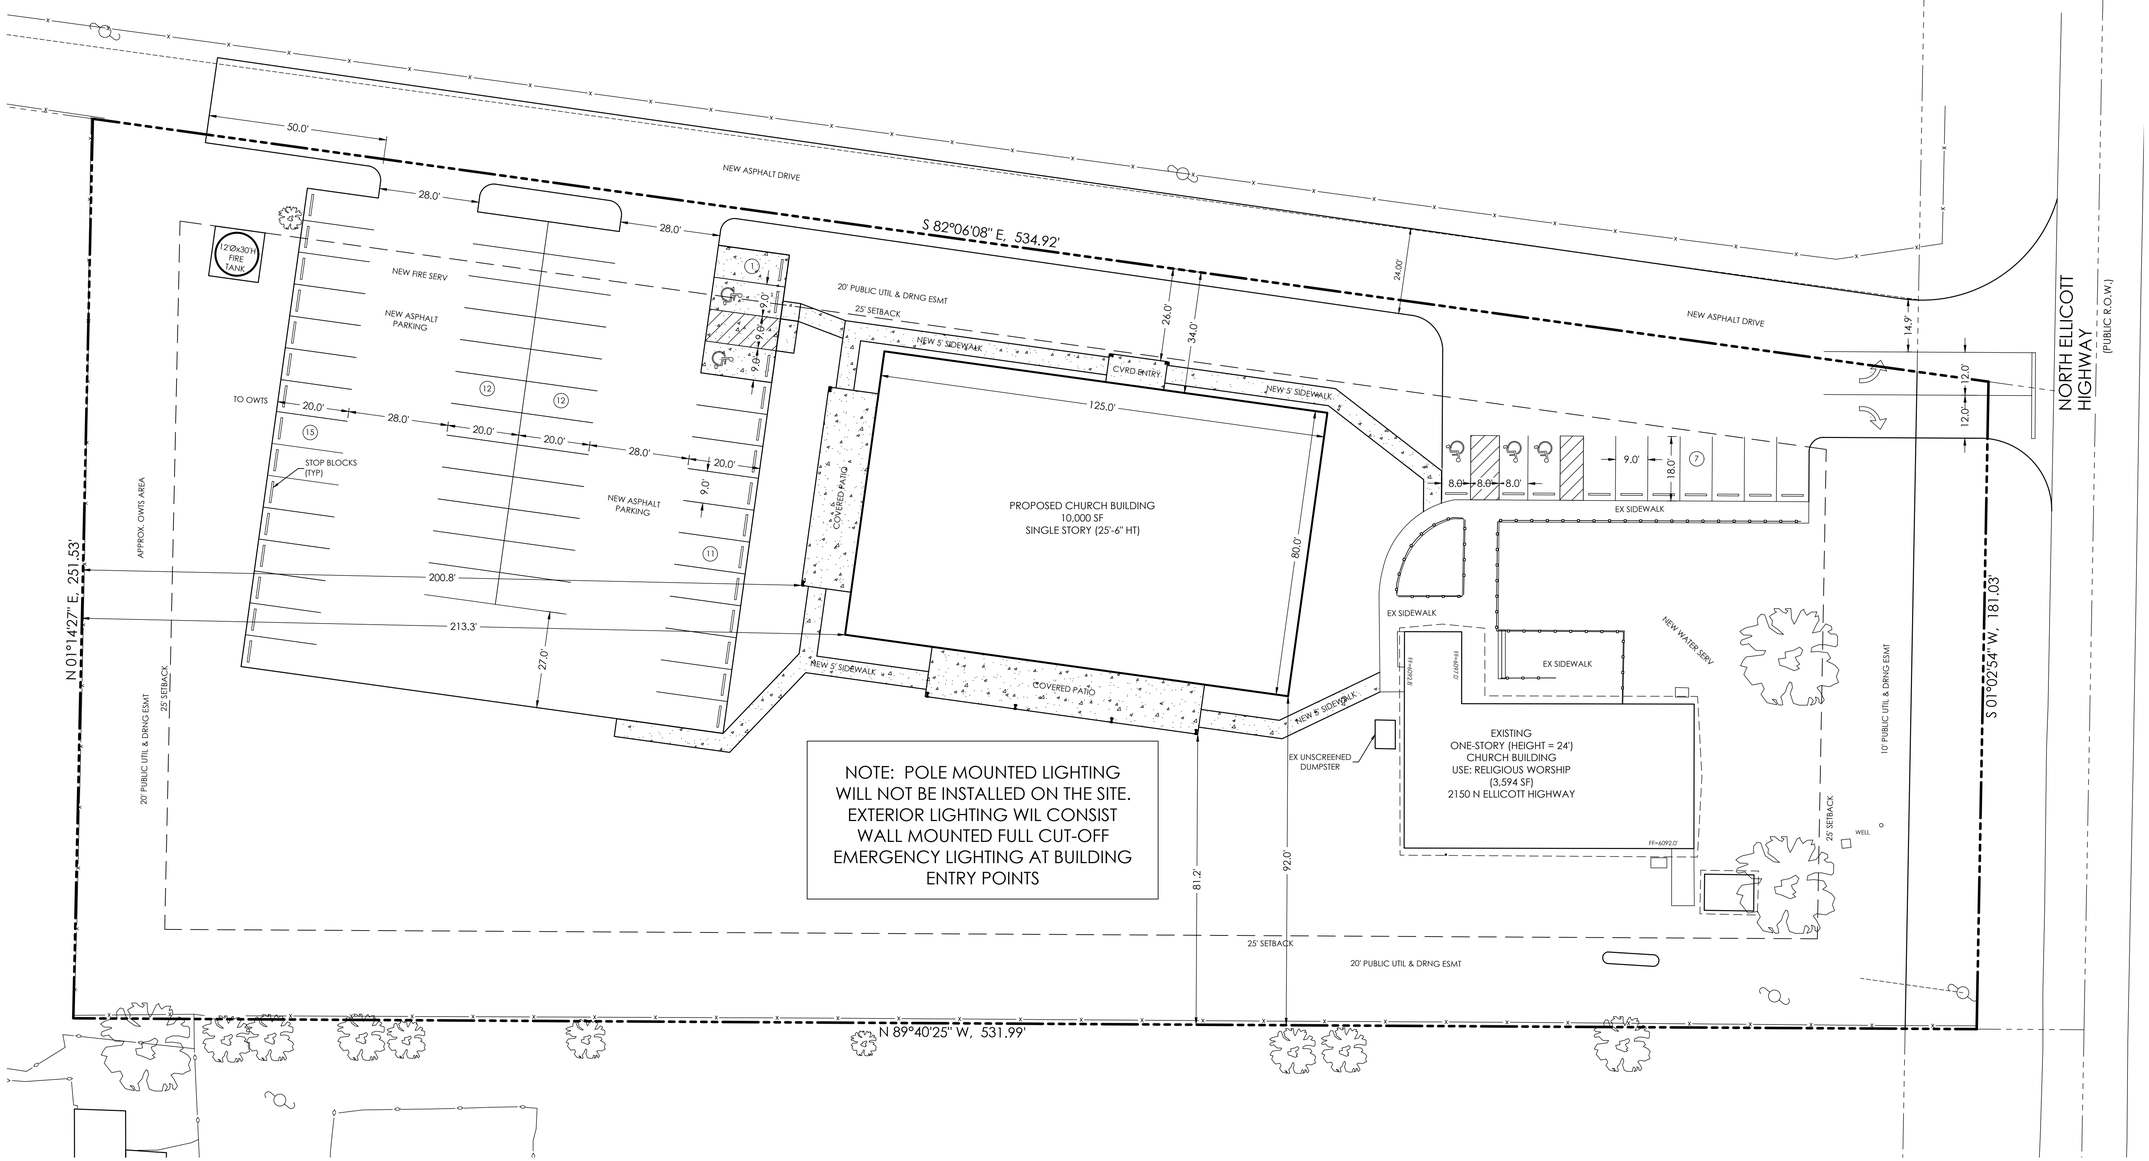

NOTE: POLE MOUNTED LIGHTING WILL NOT BE INSTALLED ON THE SITE. EXTERIOR LIGHTING WIL CONSIST WALL MOUNTED FULL CUT-OFF EMERGENCY LIGHTING AT BUILDING ENTRY POINTS

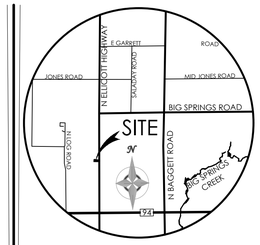

VICINITY MAP
NOT TO SCALE

BENCHMARK

5 0 10 20 40
1" = 20' 1:240

MVE, INC.
ENGINEERS SURVEYORS
1903 lelaray street, suite 200 colorado springs co 80909 719.635.5736

REVISIONS

DESIGNED BY
DRAWN BY
CHECKED BY
AS-BUILTS BY
CHECKED BY

ROCKY MOUNTAIN CALVARY
CHAPEL - ELLICOTT

Light Plan

LP-1

MVE PROJECT 61182
MVE DRAWING LIGHT PLN

JANUARY 29, 2024
SHEET 1 OF 1

PCD FILE # PPR2420