



1155 Kelly Johnson Blvd., Suite 305  
Colorado Springs, CO 80920  
719.900.7220 • [GallowayUS.com](http://GallowayUS.com)

September 26, 2024

Brady Shyrock, on Behalf of Galloway  
1155 Kelly Johnson Blvd., Suite 305  
Colorado Springs, CO 80920

RE: Lot 2 Elm Grove Villa - Smith Plumbing & Heating; Water Quality Detention Pond Certification

Dear Natahsa Grimaldo,

Please accept this letter as formal documentation of conformance of the Water Quality Detention Pond for stormwater quality and detention at the Lot 2 Elm Grove Villa - Smith Plumbing & Heating development. The Lot 2 Elm Grove Villa - Smith Plumbing & Heating (Site) is located at 1875 Main Street, Colorado Springs within El Paso County, Colorado. The project site is located east of Main Street, which is also designated as Hancock Expressway and south/southwest of Bradley Road. The Site is located in the Southwest  $\frac{1}{4}$  of the Southwest  $\frac{1}{4}$  of Section 01, Township 15 South, Range 66 West of the 6th Principal Meridian, City of Colorado Springs, County of El Paso, State of Colorado.

Survey data detailing the Water Quality Detention Pond at the site was provided to Galloway & Company, Inc. on February 14, 2024 and updated February 23, 2024 & March 12, 2024, by Ridge Line Land Surveying. The pond was constructed based on the pond design prepared by Galloway, Inc. in the approved Lot 2 Elm Grove Villa Subdivision Final Drainage Report dated March, 2022.

### **WQCV Design**

The WQCV has a volume of 0.030-acre feet and a depth of 2.74 feet. The WQCV has a 99% drain time of 45 hours which is in conformance with MHFD Criteria and City of Colorado Springs Criteria.

### **EURV, 5-Year, & 100-Year Design**

Per the approved FDR, the EURV and 100-year volumes will be conveyed via the Modified CDOT Type C Outlet structure to the existing inlet, downstream to the existing concrete flume, and outfalls into the existing 6' concrete valley pan flowing in a southward direction within the townhome site. concrete pan and Elm Grove Drive roadway section with curb & gutter). The proposed development does not increase runoff being discharged from the site, therefore the pond release flows can sufficiently be handled by the existing conveyance system as originally intended. Runoff then sheet flows across Elm Grove Drive (to the east) to an existing low point on the east side of Elm Grove Drive (existing concrete chase), to the existing concrete rundown structure and into the existing pond situated to the south of the existing townhomes. Storm events larger than the 100-year storm will overtop the emergency overflow weir and free release into the structures as described below.



The water quality volume release will be controlled with an orifice plate that will release over a period of 45 hours. The water quality pond will release treated flows into the existing flume and existing 6' concrete valley pan within the Elm Grove Villa townhome development to the south as described above. According to the approved **FDR**, the existing detention pond to the south was designed to accommodate runoff from this development and is functioning as intended.

Total area which will not be treated via the on-site facility is less than 1.0 acre and less than 20%, which of the total site, as required.

### **Miscellaneous**

As-builts were also conducted to verify the construction of the roof drain that conveys developed runoff from the southern half of the building roof to the WQCV pond, as well as the forebay and trickle channel of the pond. Based on those as-builts, the roof drain, forebay and trickle channel are in substantial compliance with the approved design.

Per the approved WQ Plan ("*Final Drainage Report for Lot 2 Elm Grove Villa Subdivision; Smith Plumbing & Heating; PCD Filing No. PPR2143*", Galloway & Company, Inc., May 18, 2022), the area designated as a grass buffer was intended to be a receiving pervious area (RPA). The area was constructed as a landscaped area complete with trees, shrubs, and landscaped rock. Due to the fact that there is no upstream impervious surface that drains to this area, the landscaped area is to be considered a separate pervious area (SPA) and will not be detained in the PBMP per Section I.7.1.C.1. The % imperviousness that drains to this area is negligible in size and carries a 2% imperviousness. Therefore, the grass buffer area may remain as landscaping (SPA).

### **Conclusion**

In summary I, Brady Shyrock, a registered professional engineer in the State of Colorado, do hereby affirm, to the best of my knowledge, based on the as-built survey provided by Ridge Line Land Surveying and information provided to date by the general contractor, the Water Quality Detention Pond for Lot 2 Elm Grove Villa - Smith Plumbing & Heating and associated drainage facilities were constructed in accordance with the design intent of the approved drainage report and construction drawings, and in accordance with local standards and specifications, regional jurisdictional design criteria and state statutes.

The site and adjacent properties (as affected by work performed under the County permit) are stable with respect to settlement and subsidence, sloughing of cut and fill slopes, revegetation or other ground cover, and that the improvements (public improvements, common improvements, site grading and paving) meet or exceed the minimum design requirements.

Lot 2 Elm Grove Villa  
Water Quality Detention Pond Certification  
September 26, 2024

The facilities outlined in this certification letter provide the required WQCV and will meet the required release rates (as documented by the attached MHFD design form), the stage areas, elevations, and outlet dimensions.

Should you have any further questions, or require additional information, please do not hesitate to contact me at (719) 900-7220.

Sincerely,  
**GALLOWAY**



Brady Shyrock, PE  
Project Manager  
[BradyShyrock@GallowayUS.com](mailto:BradyShyrock@GallowayUS.com)



cc: John Radcliffe, PE  
Principal & Regional Office Manager  
[JohnRadcliffe@GallowayUS.com](mailto:JohnRadcliffe@GallowayUS.com)



**Attached Documents:**

- MHFD WQ Detention Pond Calculations
- Roof Drain Drainage Map
- Roof Drain Rational Calculations
- Roof Drain Capacity Calculations
- As-Built Drawings



# DETENTION BASIN STAGE-STORAGE TABLE BUILDER


MHFD-*Detention*, Version 4.05 (January 2022)

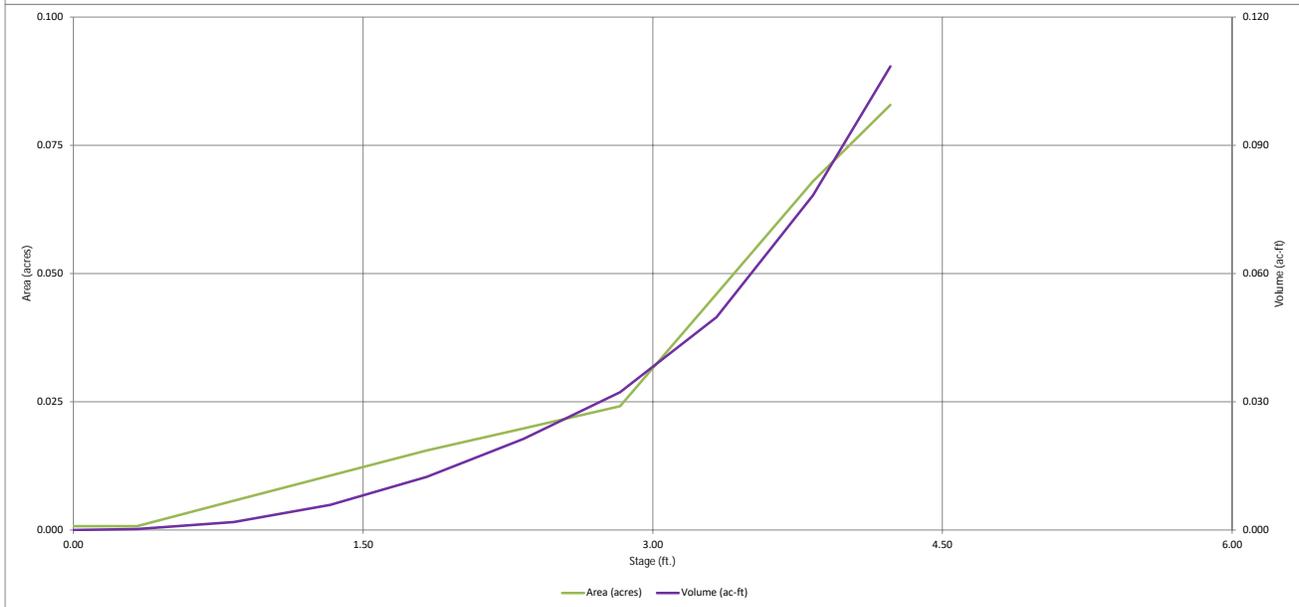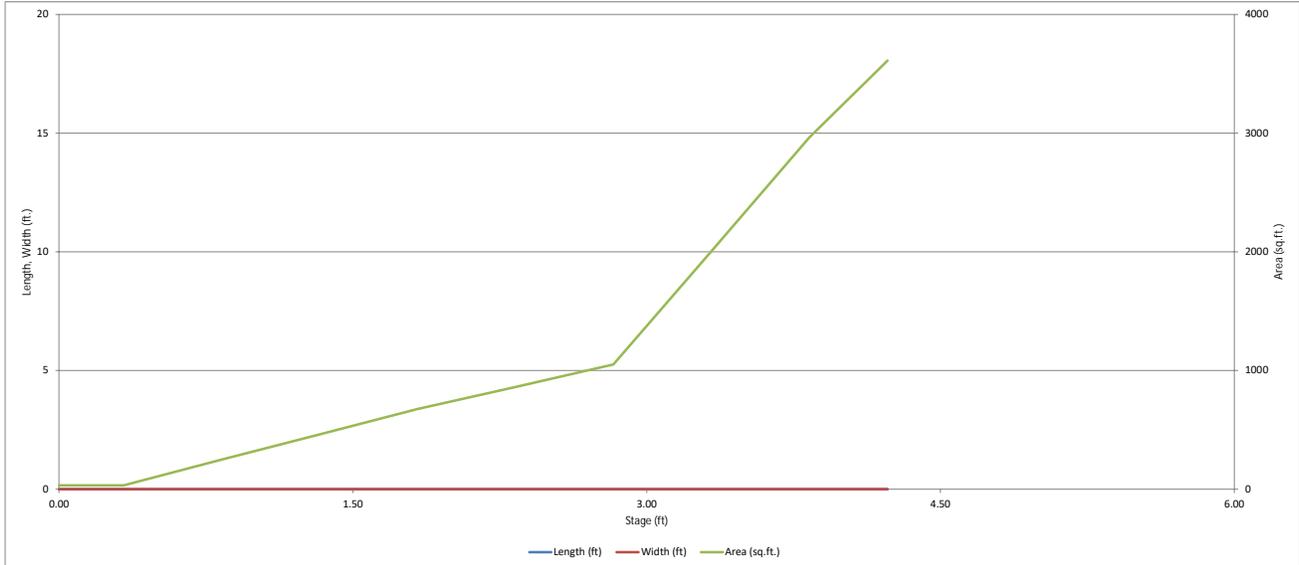

# DETENTION BASIN OUTLET STRUCTURE DESIGN

MHFD-Detention, Version 4.05 (January 2022)

Project: Smith Plumbing  
Basin ID: WQCV Pond As-Built

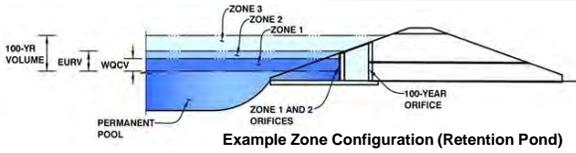

	Estimated Stage (ft)	Estimated Volume (ac-ft)	Outlet Type
Zone 1 (WQCV)	2.74	0.030	Orifice Plate
Zone 2 (User)	3.34	0.020	Weir&Pipe (Restrict)
Zone 3			
Total (all zones)		0.050	

User Input: Orifice at Underdrain Outlet (typically used to drain WQCV in a Filtration BMP)

Underdrain Orifice Invert Depth =  ft (distance below the filtration media surface)  
Underdrain Orifice Diameter =  inches

Calculated Parameters for Underdrain  
Underdrain Orifice Area =  ft<sup>2</sup>  
Underdrain Orifice Centroid =  feet

User Input: Orifice Plate with one or more orifices or Elliptical Slot Weir (typically used to drain WQCV and/or EURV in a sedimentation BMP)

Centroid of Lowest Orifice =  0.00 ft (relative to basin bottom at Stage = 0 ft)  
Depth at top of Zone using Orifice Plate =  2.92 ft (relative to basin bottom at Stage = 0 ft)  
Orifice Plate: Orifice Vertical Spacing =  N/A inches  
Orifice Plate: Orifice Area per Row =  0.12 sq. inches (diameter = 3/8 inch)

Calculated Parameters for Plate  
WQ Orifice Area per Row =  8.333E-04 ft<sup>2</sup>  
Elliptical Half-Width =  N/A feet  
Elliptical Slot Centroid =  N/A feet  
Elliptical Slot Area =  N/A ft<sup>2</sup>

User Input: Stage and Total Area of Each Orifice Row (numbered from lowest to highest)

	Row 1 (required)	Row 2 (optional)	Row 3 (optional)	Row 4 (optional)	Row 5 (optional)	Row 6 (optional)	Row 7 (optional)	Row 8 (optional)
Stage of Orifice Centroid (ft)	0.01	1.09	2.09					
Orifice Area (sq. inches)	0.12	0.12	0.12					

	Row 9 (optional)	Row 10 (optional)	Row 11 (optional)	Row 12 (optional)	Row 13 (optional)	Row 14 (optional)	Row 15 (optional)	Row 16 (optional)
Stage of Orifice Centroid (ft)								
Orifice Area (sq. inches)								

User Input: Vertical Orifice (Circular or Rectangular)

Invert of Vertical Orifice =  Not Selected  Not Selected ft (relative to basin bottom at Stage = 0 ft)  
Depth at top of Zone using Vertical Orifice =  ft (relative to basin bottom at Stage = 0 ft)  
Vertical Orifice Diameter =  inches

Calculated Parameters for Vertical Orifice  
Vertical Orifice Area =  Not Selected  Not Selected ft<sup>2</sup>  
Vertical Orifice Centroid =  feet

User Input: Overflow Weir (Dropbox with Flat or Sloped Gate and Outlet Pipe OR Rectangular/Trapezoidal Weir and No Outlet Pipe)

Overflow Weir Front Edge Height, Ho =  2.76 ft (relative to basin bottom at Stage = 0 ft)  
Overflow Weir Front Edge Length =  2.92 feet  
Overflow Weir Gate Slope =  0.00 H:V  
Horiz. Length of Weir Sides =  2.92 feet  
Overflow Gate Type =  Close Mesh Gate  
Debris Clogging % =  50% %

Calculated Parameters for Overflow Weir  
Height of Gate Upper Edge, H<sub>1</sub> =  2.76 feet  
Overflow Weir Slope Length =  2.92 feet  
Gate Open Area / 100-yr Orifice Area =  29.40  
Overflow Gate Open Area w/o Debris =  6.74 ft<sup>2</sup>  
Overflow Gate Open Area w/ Debris =  3.37 ft<sup>2</sup>

User Input: Outlet Pipe w/ Flow Restriction Plate (Circular Orifice, Restrictor Plate, or Rectangular Orifice)

Depth to Invert of Outlet Pipe =  2.50 ft (distance below basin bottom at Stage = 0 ft)  
Outlet Pipe Diameter =  18.00 inches  
Restrictor Plate Height Above Pipe Invert =  3.38 inches

Calculated Parameters for Outlet Pipe w/ Flow Restriction Plate  
Outlet Orifice Area =  0.23 ft<sup>2</sup>  
Outlet Orifice Centroid =  0.17 feet  
Half-Central Angle of Restrictor Plate on Pipe =  0.90 N/A radians

User Input: Emergency Spillway (Rectangular or Trapezoidal)

Spillway Invert Stage =  3.82 ft (relative to basin bottom at Stage = 0 ft)  
Spillway Crest Length =  12.02 feet  
Spillway End Slopes =  4.00 H:V  
Freeboard above Max Water Surface =  0.00 feet

Calculated Parameters for Spillway  
Spillway Design Flow Depth =  0.21 feet  
Stage at Top of Freeboard =  4.03 feet  
Basin Area at Top of Freeboard =  0.08 acres  
Basin Volume at Top of Freeboard =  0.09 acre-ft




## Routed Hydrograph Results

The user can override the default CUHP hydrographs and runoff volumes by entering new values in the Inflow Hydrographs table (Columns W through AF).

	WQCV	EURV	2 Year	5 Year	10 Year	25 Year	50 Year	100 Year	500 Year
Design Storm Return Period	N/A	N/A	1.19	1.50	1.75	2.00	2.25	2.52	3.68
One-Hour Rainfall Depth (in)	N/A	N/A	0.073	0.094	0.111	0.131	0.150	0.171	0.262
CUHP Runoff Volume (acre-ft)	0.030	0.113	0.073	0.094	0.111	0.131	0.150	0.171	0.262
Inflow Hydrograph Volume (acre-ft)	N/A	N/A	0.073	0.094	0.111	0.131	0.150	0.171	0.262
CUHP Predevelopment Peak Q (cfs)	N/A	N/A	0.0	0.0	0.0	0.3	0.5	0.8	2.0
OPTIONAL Override Predevelopment Peak Q (cfs)	N/A	N/A							
Predevelopment Unit Peak Flow, q (cfs/acre)	N/A	N/A	0.01	0.02	0.03	0.25	0.48	0.79	1.97
Peak Inflow Q (cfs)	N/A	N/A	1.6	2.1	2.4	2.9	3.4	3.8	5.8
Peak Outflow Q (cfs)	0.0	6.2	1.1	1.8	2.1	2.6	2.6	2.6	3.8
Ratio Peak Outflow to Predevelopment Q	N/A	N/A	N/A	90.4	75.4	10.2	5.4	3.4	1.9
Structure Controlling Flow	Plate	Outlet Plate 1	Overflow Weir 1	Overflow Weir 1	Overflow Weir 1	Outlet Plate 1	Outlet Plate 1	Outlet Plate 1	Spillway
Max Velocity through Gate 1 (fps)	N/A	0.39	0.17	0.3	0.3	0.4	0.4	0.4	0.4
Max Velocity through Gate 2 (fps)	N/A	N/A	N/A	N/A	N/A	N/A	N/A	N/A	N/A
Time to Drain 97% of Inflow Volume (hours)	42	37	40	38	37	35	34	33	28
Time to Drain 99% of Inflow Volume (hours)	44	43	45	45	44	43	43	42	39
Maximum Ponding Depth (ft)	2.74	3.56	2.91	2.97	2.99	3.06	3.22	3.37	3.91
Area at Maximum Ponding Depth (acres)	0.02	0.06	0.03	0.03	0.03	0.03	0.04	0.05	0.07
Maximum Volume Stored (acre-ft)	0.030	0.061	0.034	0.036	0.036	0.039	0.045	0.051	0.084

# DETENTION BASIN OUTLET STRUCTURE DESIGN

*MHFD-Detention, Version 4.05 (January 2022)*

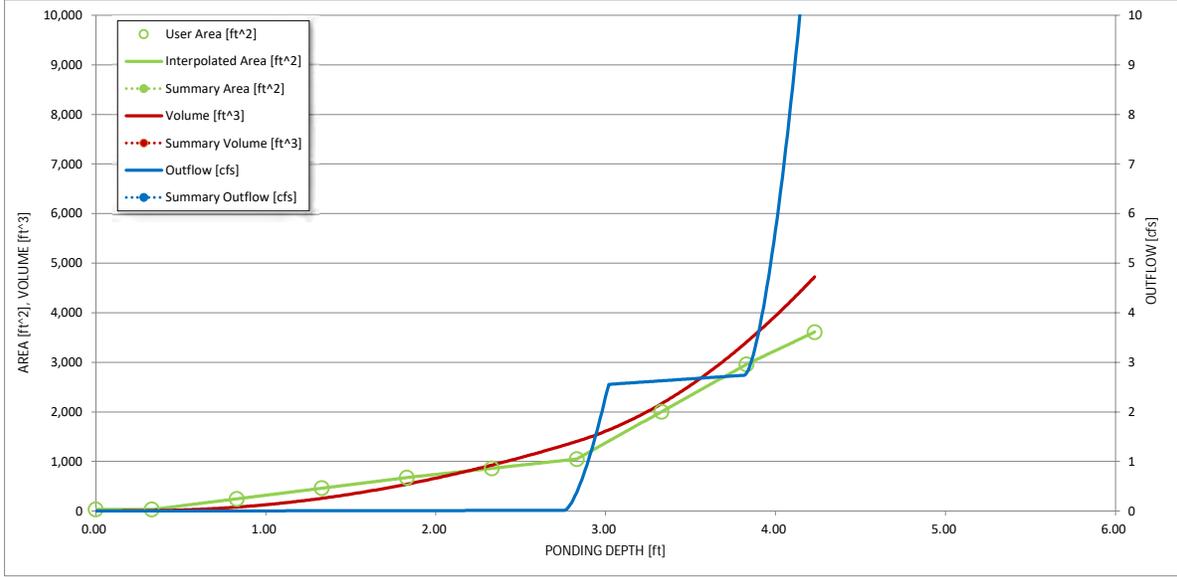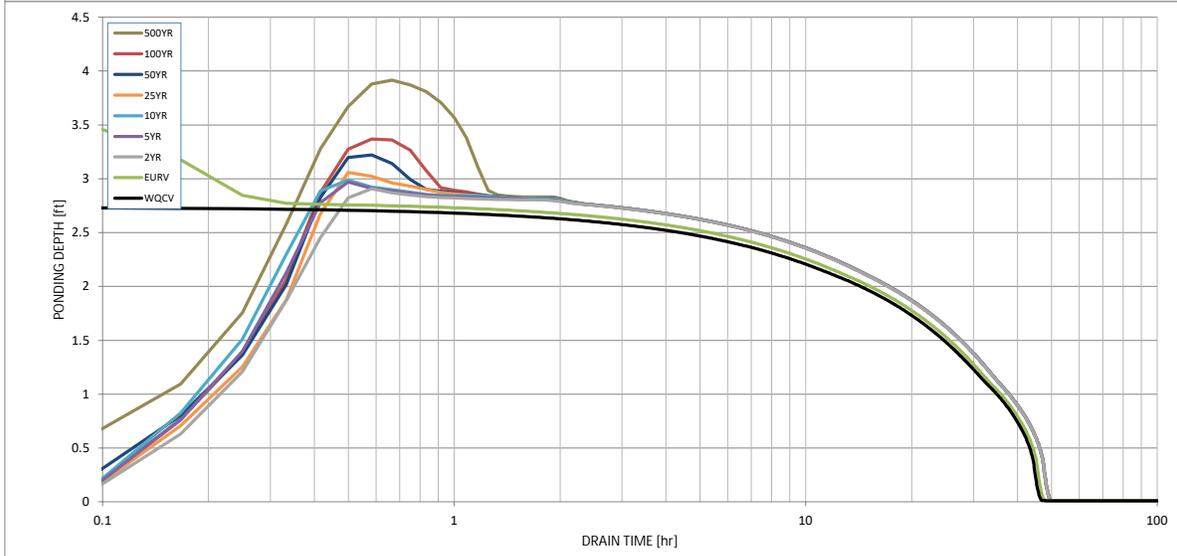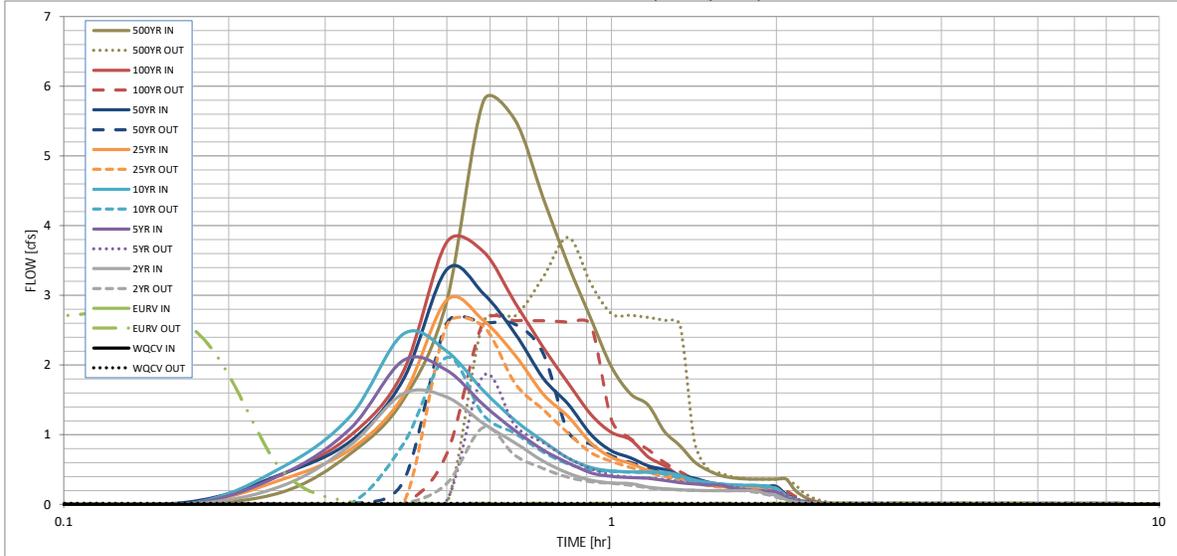

S-A-V-D Chart Axis Override	X-axis	Left Y-Axis	Right Y-Axis
minimum bound			
maximum bound			

# DETENTION BASIN OUTLET STRUCTURE DESIGN

Outflow Hydrograph Workbook Filename: \_\_\_\_\_

## Inflow Hydrographs

The user can override the calculated inflow hydrographs from this workbook with inflow hydrographs developed in a separate program.

Time Interval	SOURCE	CUHP	CUHP	CUHP	CUHP	CUHP	CUHP	CUHP	CUHP	CUHP
	TIME	WOCV [cfs]	EURV [cfs]	2 Year [cfs]	5 Year [cfs]	10 Year [cfs]	25 Year [cfs]	50 Year [cfs]	100 Year [cfs]	500 Year [cfs]
5.00 min	0:00:00	0.00	0.00	0.00	0.00	0.00	0.00	0.00	0.00	0.00
	0:05:00	0.00	0.00	0.00	0.00	0.00	0.00	0.00	0.00	0.00
	0:10:00	0.00	0.00	0.00	0.00	0.00	0.00	0.03	0.00	0.18
	0:15:00	0.00	0.00	0.26	0.43	0.53	0.36	0.43	0.43	0.73
	0:20:00	0.00	0.00	0.85	1.09	1.26	0.79	0.91	0.99	1.50
	0:25:00	0.00	0.00	1.59	2.07	2.44	1.56	1.79	1.91	2.92
	0:30:00	0.00	0.00	1.54	1.92	2.20	2.93	3.37	3.76	5.79
	0:35:00	0.00	0.00	1.16	1.43	1.63	2.64	3.03	3.63	5.52
	0:40:00	0.00	0.00	0.88	1.06	1.21	2.14	2.45	2.90	4.40
	0:45:00	0.00	0.00	0.62	0.78	0.91	1.58	1.81	2.26	3.44
	0:50:00	0.00	0.00	0.45	0.60	0.67	1.26	1.44	1.74	2.67
	0:55:00	0.00	0.00	0.35	0.46	0.53	0.88	1.01	1.29	1.98
	1:00:00	0.00	0.00	0.31	0.40	0.48	0.68	0.77	1.03	1.58
	1:05:00	0.00	0.00	0.30	0.38	0.47	0.59	0.67	0.93	1.43
	1:10:00	0.00	0.00	0.25	0.38	0.46	0.49	0.55	0.68	1.04
	1:15:00	0.00	0.00	0.23	0.34	0.46	0.44	0.50	0.55	0.84
	1:20:00	0.00	0.00	0.21	0.31	0.42	0.37	0.42	0.41	0.61
	1:25:00	0.00	0.00	0.20	0.29	0.35	0.33	0.38	0.33	0.49
	1:30:00	0.00	0.00	0.20	0.28	0.31	0.28	0.32	0.28	0.41
	1:35:00	0.00	0.00	0.20	0.28	0.29	0.26	0.29	0.26	0.38
	1:40:00	0.00	0.00	0.20	0.23	0.28	0.24	0.27	0.25	0.37
	1:45:00	0.00	0.00	0.20	0.21	0.28	0.23	0.26	0.25	0.36
	1:50:00	0.00	0.00	0.20	0.20	0.27	0.23	0.26	0.25	0.36
	1:55:00	0.00	0.00	0.15	0.19	0.26	0.23	0.26	0.25	0.36
	2:00:00	0.00	0.00	0.13	0.18	0.23	0.23	0.26	0.25	0.36
	2:05:00	0.00	0.00	0.07	0.10	0.12	0.13	0.14	0.14	0.20
	2:10:00	0.00	0.00	0.04	0.05	0.07	0.07	0.08	0.07	0.11
	2:15:00	0.00	0.00	0.02	0.03	0.03	0.04	0.04	0.04	0.05
	2:20:00	0.00	0.00	0.01	0.01	0.01	0.02	0.02	0.02	0.02
	2:25:00	0.00	0.00	0.00	0.00	0.00	0.00	0.00	0.00	0.01
	2:30:00	0.00	0.00	0.00	0.00	0.00	0.00	0.00	0.00	0.00
	2:35:00	0.00	0.00	0.00	0.00	0.00	0.00	0.00	0.00	0.00
	2:40:00	0.00	0.00	0.00	0.00	0.00	0.00	0.00	0.00	0.00
	2:45:00	0.00	0.00	0.00	0.00	0.00	0.00	0.00	0.00	0.00
	2:50:00	0.00	0.00	0.00	0.00	0.00	0.00	0.00	0.00	0.00
	2:55:00	0.00	0.00	0.00	0.00	0.00	0.00	0.00	0.00	0.00
	3:00:00	0.00	0.00	0.00	0.00	0.00	0.00	0.00	0.00	0.00
	3:05:00	0.00	0.00	0.00	0.00	0.00	0.00	0.00	0.00	0.00
	3:10:00	0.00	0.00	0.00	0.00	0.00	0.00	0.00	0.00	0.00
	3:15:00	0.00	0.00	0.00	0.00	0.00	0.00	0.00	0.00	0.00
	3:20:00	0.00	0.00	0.00	0.00	0.00	0.00	0.00	0.00	0.00
	3:25:00	0.00	0.00	0.00	0.00	0.00	0.00	0.00	0.00	0.00
	3:30:00	0.00	0.00	0.00	0.00	0.00	0.00	0.00	0.00	0.00
	3:35:00	0.00	0.00	0.00	0.00	0.00	0.00	0.00	0.00	0.00
	3:40:00	0.00	0.00	0.00	0.00	0.00	0.00	0.00	0.00	0.00
	3:45:00	0.00	0.00	0.00	0.00	0.00	0.00	0.00	0.00	0.00
	3:50:00	0.00	0.00	0.00	0.00	0.00	0.00	0.00	0.00	0.00
	3:55:00	0.00	0.00	0.00	0.00	0.00	0.00	0.00	0.00	0.00
	4:00:00	0.00	0.00	0.00	0.00	0.00	0.00	0.00	0.00	0.00
	4:05:00	0.00	0.00	0.00	0.00	0.00	0.00	0.00	0.00	0.00
	4:10:00	0.00	0.00	0.00	0.00	0.00	0.00	0.00	0.00	0.00
	4:15:00	0.00	0.00	0.00	0.00	0.00	0.00	0.00	0.00	0.00
	4:20:00	0.00	0.00	0.00	0.00	0.00	0.00	0.00	0.00	0.00
	4:25:00	0.00	0.00	0.00	0.00	0.00	0.00	0.00	0.00	0.00
	4:30:00	0.00	0.00	0.00	0.00	0.00	0.00	0.00	0.00	0.00
	4:35:00	0.00	0.00	0.00	0.00	0.00	0.00	0.00	0.00	0.00
	4:40:00	0.00	0.00	0.00	0.00	0.00	0.00	0.00	0.00	0.00
	4:45:00	0.00	0.00	0.00	0.00	0.00	0.00	0.00	0.00	0.00
	4:50:00	0.00	0.00	0.00	0.00	0.00	0.00	0.00	0.00	0.00
	4:55:00	0.00	0.00	0.00	0.00	0.00	0.00	0.00	0.00	0.00
	5:00:00	0.00	0.00	0.00	0.00	0.00	0.00	0.00	0.00	0.00
	5:05:00	0.00	0.00	0.00	0.00	0.00	0.00	0.00	0.00	0.00
	5:10:00	0.00	0.00	0.00	0.00	0.00	0.00	0.00	0.00	0.00
	5:15:00	0.00	0.00	0.00	0.00	0.00	0.00	0.00	0.00	0.00
	5:20:00	0.00	0.00	0.00	0.00	0.00	0.00	0.00	0.00	0.00
	5:25:00	0.00	0.00	0.00	0.00	0.00	0.00	0.00	0.00	0.00
	5:30:00	0.00	0.00	0.00	0.00	0.00	0.00	0.00	0.00	0.00
	5:35:00	0.00	0.00	0.00	0.00	0.00	0.00	0.00	0.00	0.00
	5:40:00	0.00	0.00	0.00	0.00	0.00	0.00	0.00	0.00	0.00
	5:45:00	0.00	0.00	0.00	0.00	0.00	0.00	0.00	0.00	0.00
	5:50:00	0.00	0.00	0.00	0.00	0.00	0.00	0.00	0.00	0.00
	5:55:00	0.00	0.00	0.00	0.00	0.00	0.00	0.00	0.00	0.00
	6:00:00	0.00	0.00	0.00	0.00	0.00	0.00	0.00	0.00	0.00

**Design Procedure Form: Runoff Reduction**

UD-BMP (Version 3.07, March 2018)

Sheet 1 of 1

**Designer:** BAS  
**Company:** Galloway & Co.  
**Date:** September 26, 2024  
**Project:** Lot 2 Elm Grove Villa - Smith Plumbing - WQCV Pond Separate Pervious Area  
**Location:** El Paso County, CO

**SITE INFORMATION (User Input in Blue Cells)**

WQCV Rainfall Depth = 0.60 inches  
 Depth of Average Runoff Producing Storm,  $d_6$  = 0.43 inches (for Watersheds Outside of the Denver Region, Figure 3-1 in USDCM Vol. 3)

Area Type	SPA																			
Area ID	E-6																			
Downstream Design Point ID	E-6																			
Downstream BMP Type	None																			
DCIA (ft <sup>2</sup> )	--																			
UIA (ft <sup>2</sup> )	--																			
RPA (ft <sup>2</sup> )	--																			
SPA (ft <sup>2</sup> )	11,326																			
HSG A (%)	100%																			
HSG B (%)	0%																			
HSG C/D (%)	0%																			
Average Slope of RPA (ft/ft)	--																			
UIA:RPA Interface Width (ft)	--																			

**CALCULATED RUNOFF RESULTS**

Area ID	E-6																			
UIA:RPA Area (ft <sup>2</sup> )	--																			
L / W Ratio	--																			
UIA / Area	--																			
Runoff (in)	0.00																			
Runoff (ft <sup>3</sup> )	0																			
Runoff Reduction (ft <sup>3</sup> )	566																			

**CALCULATED WQCV RESULTS**

Area ID	E-6																			
WQCV (ft <sup>3</sup> )	0																			
WQCV Reduction (ft <sup>3</sup> )	0																			
WQCV Reduction (%)	0%																			
Untreated WQCV (ft <sup>3</sup> )	0																			

**CALCULATED DESIGN POINT RESULTS (sums results from all columns with the same Downstream Design Point ID)**

Downstream Design Point ID	E-6																			
DCIA (ft <sup>2</sup> )	0																			
UIA (ft <sup>2</sup> )	0																			
RPA (ft <sup>2</sup> )	0																			
SPA (ft <sup>2</sup> )	11,326																			
Total Area (ft <sup>2</sup> )	11,326																			
Total Impervious Area (ft <sup>2</sup> )	0																			
WQCV (ft <sup>3</sup> )	0																			
WQCV Reduction (ft <sup>3</sup> )	0																			
WQCV Reduction (%)	0%																			
Untreated WQCV (ft <sup>3</sup> )	0																			

**CALCULATED SITE RESULTS (sums results from all columns in worksheet)**

Total Area (ft <sup>2</sup> )	11,326
Total Impervious Area (ft <sup>2</sup> )	0
WQCV (ft <sup>3</sup> )	0
WQCV Reduction (ft <sup>3</sup> )	0
WQCV Reduction (%)	0%
Untreated WQCV (ft <sup>3</sup> )	0





# COMPOSITE % IMPERVIOUS CALCULATIONS: PROPOSED CONDITIONS

Subdivision: Elm Grove Villa  
 Location: CO, Colorado Springs

Project Name: Smith Plumbing  
 Project No.: HCI000008  
 Calculated By: BAS  
 Checked By: TJE  
 Date: 9/10/24

Basin ID	Total Area (ac)	Paved/Gravel Roads			Undeveloped			Roofs			Basins Total Weighted % Imp.
		% Imp.	Area (ac)	Weighted % Imp.	% Imp.	Area (ac)	Weighted % Imp.	% Imp.	Area (ac)	Weighted % Imp.	
OS-1	0.34	100	0.20	58.8	2	0.14	0.8	90	0.00	0.0	59.6
OS-2	0.34	100	0.18	52.9	2	0.08	0.5	90	0.08	21.2	74.6
E-1	0.02	100	0.02	100.0	2	0.00	0.0	90	0.00	0.0	100.0
E-2	0.10	100	0.10	100.0	2	0.00	0.0	90	0.00	0.0	100.0
E-3	0.13	100	0.07	51.6	2	0.06	1.0	90	0.00	0.0	52.6
E-4	0.58	100	0.31	52.8	2	0.00	0.0	90	0.27	42.5	95.3
E-5	0.11	100	0.11	96.3	2	0.00	0.0	90	0.00	0.0	96.3
E-6	0.26	100	0.00	0.0	2	0.26	2.0	90	0.00	0.0	2.0
E-7	0.06	100	0.00	0.0	2	0.06	2.0	90	0.00	0.0	2.0
E-8	0.12	100	0.05	44.4	2	0.07	1.1	90	0.00	0.0	45.5
E-4 (roof)	0.14	100	0.00	0.0	2	0.00	0.0	90	0.14	90.0	90.0

**NOTES:**

*% Impervious values are taken directly from Table 6-6 in the Colorado Springs DCM Vol. 1. CH. 6 (Referencing UDFCD 2001)*

# COMPOSITE RUNOFF COEFFICIENT CALCULATIONS: PROPOSED CONDITIONS

**Subdivision:** Elm Grove Villa  
**Location:** CO, Colorado Springs

**Project Name:** Smith Plumbing  
**Project No.:** HCI000008  
**Calculated By:** BAS  
**Checked By:** TJE  
**Date:** 9/10/24

Basin ID	Total Area (ac)	Paved/Gravel Roads			Lawns/Undeveloped			Roofs			Composite C <sub>5</sub>	Composite C <sub>100</sub>
		C <sub>5</sub>	C <sub>100</sub>	Area (ac)	C <sub>5</sub>	C <sub>100</sub>	Area (ac)	C <sub>5</sub>	C <sub>100</sub>	Area (ac)		
OS-1	0.34	0.90	0.96	0.20	0.09	0.36	0.14	0.73	0.81	0.00	0.57	0.71
OS-2	0.34	0.90	0.96	0.18	0.09	0.36	0.08	0.73	0.81	0.08	0.67	0.78
E-1	0.02	0.90	0.96	0.02	0.09	0.36	0.00	0.73	0.81	0.00	0.90	0.96
E-2	0.10	0.90	0.96	0.10	0.09	0.36	0.00	0.73	0.81	0.00	0.90	0.96
E-3	0.13	0.90	0.96	0.07	0.09	0.36	0.06	0.73	0.81	0.00	0.51	0.67
E-4	0.58	0.90	0.96	0.31	0.09	0.36	0.00	0.73	0.81	0.27	0.82	0.89
E-5	0.11	0.90	0.96	0.11	0.09	0.36	0.00	0.73	0.81	0.00	0.87	0.94
E-6	0.26	0.90	0.96	0.00	0.09	0.36	0.26	0.73	0.81	0.00	0.09	0.36
E-7	0.06	0.90	0.96	0.00	0.09	0.36	0.06	0.73	0.81	0.00	0.09	0.36
E-8	0.12	0.90	0.96	0.05	0.09	0.36	0.07	0.73	0.81	0.00	0.45	0.63
E-4 (roof)	0.14	0.90	0.96	0.00	0.09	0.36	0.00	0.73	0.81	0.14	0.73	0.81

**NOTES:**

*C values are taken directly from Table 6-6 in the Colorado Springs DCM Vol. 1, CH. 6 (Referencing UDFCD 2001)  
Coefficients use HSG A&B soils - Refer to "Appendix A: Exhibits and Figures" for soil map*

## STANDARD FORM SF-2: PROPOSED CONDITIONS TIME OF CONCENTRATION

**Subdivision:** Elm Grove Villa  
**Location:** CO, Colorado Springs

**Project Name:** Smith Plumbing  
**Project No.:** HCI000008  
**Calculated By:** BAS  
**Checked By:** TJE  
**Date:** 9/10/24

SUB-BASIN						INITIAL/OVERLAND			TRAVEL TIME					T <sub>c</sub> CHECK			FINAL
DATA						(T <sub>i</sub> )			(T <sub>t</sub> )					(URBANIZED BASINS)			
BASIN ID	D.A. (AC)	Hydrologic Soils Group	Impervious (%)	C <sub>5</sub>	C <sub>100</sub>	L (FT)	S (%)	T <sub>i</sub> (MIN)	L (FT)	S (%)	C <sub>v</sub>	VEL. (FPS)	T <sub>t</sub> (MIN)	COMP. T <sub>c</sub> (MIN)	TOTAL LENGTH(FT)	Urbanized T <sub>c</sub> (MIN)	T <sub>c</sub> (MIN)
OS-1	0.34	A	59.6	0.57	0.71	35	1.2	5.4	0	0.0	15	0.0	0.0	5.4	35.0	10.2	5.4
OS-2	0.34	A	74.6	0.67	0.78	75	2.0	5.4	100	2.0	20	2.8	0.6	6.0	175.0	11.0	6.0
E-1	0.02	A	100.0	0.90	0.96	30	4.5	1.2	0	0.0	20	0.0	0.0	1.2	30.0	10.2	5.0
E-2	0.10	A	100.0	0.90	0.96	30	4.5	1.2	0	0.0	20	0.0	0.0	1.2	30.0	10.2	5.0
E-3	0.13	A	52.6	0.51	0.67	5	4.0	1.5	185	3.3	20	3.6	0.8	2.4	190.0	11.1	5.0
E-4	0.58	A	95.3	0.82	0.89	100	0.7	5.8	300	0.5	20	1.4	3.5	9.3	400.0	12.2	9.3
E-5	0.11	A	96.3	0.87	0.94	65	1.4	3.0	45	0.5	20	1.4	0.5	3.6	110.0	10.6	5.0
E-6	0.26	A	2.0	0.09	0.36	10	25.0	2.0	450	0.5	15	1.1	7.1	9.1	460.0	12.6	9.1
E-7	0.06	A	2.0	0.09	0.36	10	25.0	2.0	50	0.5	15	1.1	0.8	2.8	60.0	10.3	5.0
E-8	0.12	A	45.5	0.45	0.63	5	2.0	2.1	65	2.0	20	2.8	0.4	2.5	70.0	10.4	5.0
E-4 (roof)	0.14	A	90.0	0.73	0.81	25	0.1	6.9	170	1.2	20	2.2	1.3	8.2	195.0	11.1	8.2

**NOTES:**

$T_i = (0.395 * (1.1 - C_5) * (L)^{0.5}) / ((S)^{0.33})$ , S in ft/ft

$T_t = L / 60V$  (Velocity From Fig. 501)

Velocity  $V = C_v * S^{0.5}$ , S in ft/ft

T<sub>c</sub> Check = 10 + L/180

For Urbanized basins a minimum T<sub>c</sub> of 5.0 minutes is required.

For non-urbanized basins a minimum T<sub>c</sub> of 10.0 minutes is required

Type of Land Surface	C <sub>v</sub>
Heavy Meadow	2.5
Tillage/field	5
Short pasture and lawns	7
Nearly bare ground	10
Grassed waterway	15
Paved areas and shallow paved swales	20

**STANDARD FORM SF-3: PROPOSED CONDITIONS**  
**STORM DRAINAGE SYSTEM DESIGN**  
(RATIONAL METHOD PROCEDURE)

Subdivision: Elm Grove Villa  
Location: CO, Colorado Springs  
Design Storm: 5-Year

Project Name: Smith Plumbing  
Project No.: HC1000008  
Calculated By: BAS  
Checked By: TJE  
Date: 9/10/24

STREET	Design Point	DIRECT RUNOFF							TOTAL RUNOFF				STREET		PIPE			TRAVEL TIME			REMARKS
		Basin ID	Area (Ac)	Runoff Coeff.	Tc (min)	C* A (Ac)	I (in/hr)	Q (cfs)	Tc (min)	C* A (Ac)	I (in/hr)	Q (cfs)	Slope (%)	Street Flow (cfs)	Design Flow (cfs)	Slope (%)	Pipe Size (inches)	Length (ft)	Velocity (fps)	Tt (min)	
	1	OS-1	0.34	0.57	5.4	0.19	5.05	1.0													Offsite flows north of property directed southeast per existing report
	9	OS-2	0.34	0.67	6.0	0.23	4.90	1.1													Offsite flows northwest of property flowing through site
	2	E-1	0.02	0.90	5.0	0.02	5.17	0.1													Existing basin at entrance which reach Hanock Expressway
	3	E-2	0.10	0.90	5.0	0.09	5.17	0.5													Existing basin through entrance which flows offsite (across existing parking lot)
	8	E-3	0.13	0.51	5.0	0.07	5.17	0.4													Basin located along western edge of property line, reaches existing inlet through curb cut
	4	E-4	0.58	0.82	9.3	0.48	4.24	2.0													Bulk of site which flows towards proposed curb cut-north side pond
		E-4 (roof)	0.14	0.73	8.2	0.10	4.44	0.4													One-half of roof area draining to 6-inch PVC roof drain
	5	E-5	0.11	0.87	5.0	0.10	5.17	0.5													Basin along east of pond-releases through curb cut
	6	E-8	0.12	0.45	5.0	0.05	5.17	0.3													Basin along north of pond-releases through curb cut
		E-6	0.26	0.09	9.1	0.02	4.28	0.1													Basin along north, east & south property line which drains to the the townhome property per the existing report
		E-7	0.06	0.09	5.0	0.01	5.17	0.1													Pond area
	7								9.3	0.64	4.24	2.7									All flows entering pond (Basins E-4, E-5, E-7, E-8) Detained for a 0.2 cfs reduction
									Pond Detained Release =			2.5									
Total Release Into Conc. Pan												23.6									EX 23.7 cfs Basin B - 3 cfs (Basin A-6) + DP8 + DP7

**STANDARD FORM SF-3: PROPOSED CONDITIONS**  
**STORM DRAINAGE SYSTEM DESIGN**  
(RATIONAL METHOD PROCEDURE)

Subdivision: Elm Grove Villa  
Location: CO, Colorado Springs  
Design Storm: 100-Year

Project Name: Smith Plumbing  
Project No.: HCI000008  
Calculated By: BAS  
Checked By: TJE  
Date: 9/10/24

STREET	Design Point	DIRECT RUNOFF							TOTAL RUNOFF				STREET		PIPE			TRAVEL TIME			REMARKS
		Basin ID	Area (Ac)	Runoff Coeff.	Tc (min)	C <sup>*A</sup> (Ac)	I (in/hr)	Q (cfs)	Tc (min)	C <sup>*A</sup> (Ac)	I (in/hr)	Q (cfs)	Slope (%)	Street Flow (cfs)	Design Flow (cfs)	Slope (%)	Pipe Size (inches)	Length (ft)	Velocity (fps)	Tt (min)	
	1	OS-1	0.34	0.71	5.4	0.24	8.48	2.0													Offsite flows north of property directed southeast per existing report
	9	OS-2	0.34	0.78	6.0	0.27	8.22	2.2													Offsite flows northwest of property flowing through site
	2	E-1	0.02	0.96	5.0	0.02	8.68	0.2													Existing basin at entrance which reach Hanock Expressway
	3	E-2	0.10	0.96	5.0	0.10	8.68	0.9													Existing basin through entrance which flows offsite (across existing parking lot)
	8	E-3	0.13	0.67	5.0	0.09	8.68	0.8													Basin located along western edge of property line, reaches existing inlet through curb cut
	4	E-4	0.58	0.89	9.3	0.52	7.11	3.7													Bulk of site which flows towards proposed curb cut-north side pond
		E-4 (roof)	0.14	0.81	8.2	0.11	7.45	0.8													One-half of roof area draining to 6-inch PVC roof drain
	5	E-5	0.11	0.94	5.0	0.10	8.68	0.9													Basin along east of pond-releases through curb cut
	6	E-8	0.12	0.63	5.0	0.07	8.68	0.6													Basin along north of pond-releases through curb cut
		E-6	0.26	0.36	9.1	0.09	7.18	0.6													Basin along north, east & south property line which drains to the the townhome property per the existing report
		E-7	0.06	0.36	5.0	0.02	8.68	0.2													Pond area
	7								9.3	0.71	7.11	5.0									All flows entering pond (Basins E-4, E-5, E-7, E-8) Detained to release 1 cfs lower
									Pond Detained Release =			4.0									
Total Release Into Conc. Pan												37.3									EX 38.4 cfs Basin B - 5.9 cfs (Basin A-6) + DP8 + DP7

---

## Roof Drain 6 IN - PVC

---

### Project Description

Friction Method	Manning Formula
Solve For	Normal Depth

### Input Data

Roughness Coefficient	0.010	
Channel Slope	0.01203	ft/ft
Diameter	0.50	ft
Discharge	0.80	ft <sup>3</sup> /s

### Results

Normal Depth	0.41	ft
Flow Area	0.17	ft <sup>2</sup>
Wetted Perimeter	1.13	ft
Hydraulic Radius	0.15	ft
Top Width	0.38	ft
Critical Depth	0.44	ft
Percent Full	82.0	%
Critical Slope	0.01072	ft/ft
Velocity	4.64	ft/s
Velocity Head	0.34	ft
Specific Energy	0.75	ft
Froude Number	1.22	
Maximum Discharge	0.86	ft <sup>3</sup> /s
Discharge Full	0.80	ft <sup>3</sup> /s
Slope Full	0.01203	ft/ft
Flow Type	SuperCritical	

### GVF Input Data

Downstream Depth	0.00	ft
Length	0.00	ft
Number Of Steps	0	

### GVF Output Data

Upstream Depth	0.00	ft
Profile Description		
Profile Headloss	0.00	ft
Average End Depth Over Rise	0.00	%
Normal Depth Over Rise	81.96	%
Downstream Velocity	Infinity	ft/s

---

## Roof Drain 6 IN - PVC

---

### GVF Output Data

Upstream Velocity	Infinity	ft/s
Normal Depth	0.41	ft
Critical Depth	0.44	ft
Channel Slope	0.01203	ft/ft
Critical Slope	0.01072	ft/ft
























Concrete Washout Area (CWA)

MM-1

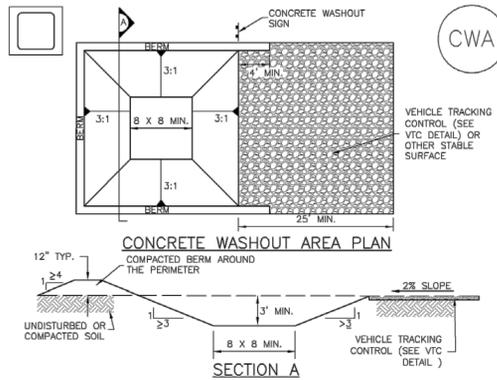

CWA-1. CONCRETE WASHOUT AREA

CWA INSTALLATION NOTES

- 1. SEE PLAN VIEW FOR: -CWA INSTALLATION LOCATION.
2. DO NOT LOCATE AN UNLINED CWA WITHIN 400' OF ANY NATURAL DRAINAGE PATHWAY OR WATERBODY...
3. THE CWA SHALL BE INSTALLED PRIOR TO CONCRETE PLACEMENT ON SITE.
4. CWA SHALL INCLUDE A FLAT SUBSURFACE PIT THAT IS AT LEAST 8' BY 8' SLOPES LEADING OUT OF THE SUBSURFACE PIT SHALL BE 3:1 OR FLATTER...
5. BERM SURROUNDING SIDES AND BACK OF THE CWA SHALL HAVE MINIMUM HEIGHT OF 1'.
6. VEHICLE TRACKING PAD SHALL BE SLOPED 2% TOWARDS THE CWA.
7. SIGNS SHALL BE PLACED AT THE CONSTRUCTION ENTRANCE, AT THE CWA, AND ELSEWHERE AS NECESSARY TO CLEARLY INDICATE THE LOCATION OF THE CWA TO OPERATORS OF CONCRETE TRUCKS AND PUMP RIGS.
8. USE EXCAVATED MATERIAL FOR PERIMETER BERM CONSTRUCTION.

November 2010 Urban Drainage and Flood Control District Urban Storm Drainage Criteria Manual Volume 3 CWA-3

Concrete Washout Area (CWA)

MM-1


CWA MAINTENANCE NOTES

- 1. INSPECT BMPs EACH WORKDAY, AND MAINTAIN THEM IN EFFECTIVE OPERATING CONDITION. MAINTENANCE OF BMPs SHOULD BE PROACTIVE, NOT REACTIVE...
2. FREQUENT OBSERVATIONS AND MAINTENANCE ARE NECESSARY TO MAINTAIN BMPs IN EFFECTIVE OPERATING CONDITION...
3. WHERE BMPs HAVE FAILED, REPAIR OR REPLACEMENT SHOULD BE INITIATED UPON DISCOVERY OF THE FAILURE.
4. THE CWA SHALL BE REPAIRED, CLEANED, OR ENLARGED AS NECESSARY TO MAINTAIN CAPACITY FOR CONCRETE WASTE...
5. CONCRETE WASHOUT WATER, WASTED PIECES OF CONCRETE AND ALL OTHER DEBRIS IN THE SUBSURFACE PIT SHALL BE TRANSPORTED FROM THE JOB SITE...
6. THE CWA SHALL REMAIN IN PLACE UNTIL ALL CONCRETE FOR THE PROJECT IS PLACED.
7. WHEN THE CWA IS REMOVED, COVER THE DISTURBED AREA WITH TOP SOIL, SEED AND MULCH OR OTHERWISE STABILIZED IN A MANNER APPROVED BY THE LOCAL JURISDICTION.

CWA-4 Urban Drainage and Flood Control District Urban Storm Drainage Criteria Manual Volume 3 November 2010

Stabilized Staging Area (SSA)

SM-6

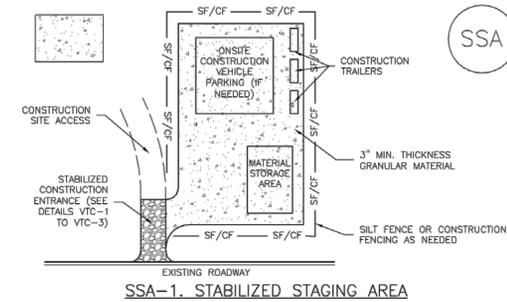

SSA-1. STABILIZED STAGING AREA

STABILIZED STAGING AREA INSTALLATION NOTES

- 1. SEE PLAN VIEW FOR: -LOCATION OF STAGING AREA(S). -CONTRACTOR MAY ADJUST LOCATION AND SIZE OF STAGING AREA WITH APPROVAL FROM THE LOCAL JURISDICTION.
2. STABILIZED STAGING AREA SHOULD BE APPROPRIATE FOR THE NEEDS OF THE SITE. OVERSIZING RESULTS IN A LARGER AREA TO STABILIZE FOLLOWING CONSTRUCTION.
3. STAGING AREA SHALL BE STABILIZED PRIOR TO OTHER OPERATIONS ON THE SITE.
4. THE STABILIZED STAGING AREA SHALL CONSIST OF A MINIMUM 3" THICK GRANULAR MATERIAL.
5. UNLESS OTHERWISE SPECIFIED BY LOCAL JURISDICTION, ROCK SHALL CONSIST OF DOT SECT. #703, AASHTO #3 COARSE AGGREGATE OR 6" (MINUS) ROCK.
6. ADDITIONAL PERIMETER BMPs MAY BE REQUIRED INCLUDING BUT NOT LIMITED TO SILT FENCE AND CONSTRUCTION FENCING.


STABILIZED STAGING AREA MAINTENANCE NOTES

- 1. INSPECT BMPs EACH WORKDAY, AND MAINTAIN THEM IN EFFECTIVE OPERATING CONDITION. MAINTENANCE OF BMPs SHOULD BE PROACTIVE, NOT REACTIVE...
2. FREQUENT OBSERVATIONS AND MAINTENANCE ARE NECESSARY TO MAINTAIN BMPs IN EFFECTIVE OPERATING CONDITION...
3. WHERE BMPs HAVE FAILED, REPAIR OR REPLACEMENT SHOULD BE INITIATED UPON DISCOVERY OF THE FAILURE.
4. ROCK SHALL BE REAPPLIED OR REGRADED AS NECESSARY IF RUTTING OCCURS OR UNDERLYING SUBGRADE BECOMES EXPOSED.

November 2010 Urban Drainage and Flood Control District Urban Storm Drainage Criteria Manual Volume 3 SSA-3

Stockpile Management (SP)

MM-2

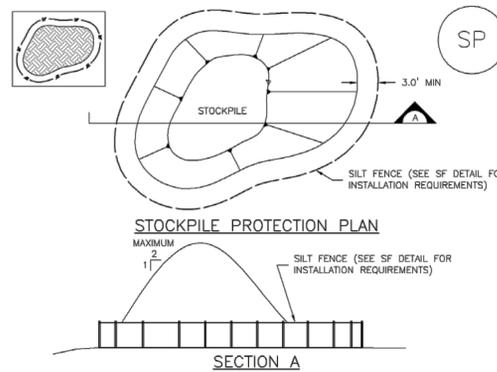

SP-1. STOCKPILE PROTECTION

STOCKPILE PROTECTION INSTALLATION NOTES

- 1. SEE PLAN VIEW FOR: -LOCATION OF STOCKPILES. -TYPE OF STOCKPILE PROTECTION.
2. INSTALL PERIMETER CONTROLS IN ACCORDANCE WITH THEIR RESPECTIVE DESIGN DETAILS. SILT FENCE IS SHOWN IN THE STOCKPILE PROTECTION DETAILS; HOWEVER, OTHER TYPES OF PERIMETER CONTROLS INCLUDING SEDIMENT CONTROL LOGS OR ROCK SOCKS MAY BE SUITABLE IN SOME CIRCUMSTANCES...
3. STABILIZE THE STOCKPILE SURFACE WITH SURFACE ROUGHENING, TEMPORARY SEEDING AND MULCHING, EROSION CONTROL BLANKETS, OR SOIL BINDERS...
4. FOR TEMPORARY STOCKPILES ON THE INTERIOR PORTION OF A CONSTRUCTION SITE, WHERE OTHER DOWNGRADEMENT CONTROLS, INCLUDING PERIMETER CONTROL, ARE IN PLACE, STOCKPILE PERIMETER CONTROLS MAY NOT BE REQUIRED.

November 2010 Urban Drainage and Flood Control District Urban Storm Drainage Criteria Manual Volume 3 SP-3

Stockpile Management (SM)

MM-2

STOCKPILE PROTECTION MAINTENANCE NOTES

- 1. INSPECT BMPs EACH WORKDAY, AND MAINTAIN THEM IN EFFECTIVE OPERATING CONDITION. MAINTENANCE OF BMPs SHOULD BE PROACTIVE, NOT REACTIVE...
2. FREQUENT OBSERVATIONS AND MAINTENANCE ARE NECESSARY TO MAINTAIN BMPs IN EFFECTIVE OPERATING CONDITION...
3. WHERE BMPs HAVE FAILED, REPAIR OR REPLACEMENT SHOULD BE INITIATED UPON DISCOVERY OF THE FAILURE.

STOCKPILE PROTECTION INSTALLATION NOTES

- 4. IF PERIMETER PROTECTION MUST BE MOVED TO ACCESS SOIL STOCKPILE, REPLACE PERIMETER CONTROLS BY THE END OF THE WORKDAY.
5. STOCKPILE PERIMETER CONTROLS CAN BE REMOVED ONCE ALL THE MATERIAL FROM THE STOCKPILE HAS BEEN USED.
(Details adapted from Parker, Colorado, not available in AutoCAD)
NOTE: MANY JURISDICTIONS HAVE BMP DETAILS THAT VARY FROM UDFCD STANDARD DETAILS. CONSULT WITH LOCAL JURISDICTIONS AS TO WHICH DETAIL SHOULD BE USED WHEN DIFFERENCES ARE NOTED.

SP-4 Urban Drainage and Flood Control District Urban Storm Drainage Criteria Manual Volume 3 November 2010

Stabilized Staging Area (SSA)

SM-6

STABILIZED STAGING AREA MAINTENANCE NOTES

- 5. STABILIZED STAGING AREA SHALL BE ENLARGED IF NECESSARY TO CONTAIN PARKING, STORAGE, AND UNLOADING/LOADING OPERATIONS.
6. THE STABILIZED STAGING AREA SHALL BE REMOVED AT THE END OF CONSTRUCTION. THE GRANULAR MATERIAL SHALL BE REMOVED OR, IF APPROVED BY THE LOCAL JURISDICTION, USED ON SITE, AND THE AREA COVERED WITH TOPSOIL, SEEDING AND MULCH OR OTHERWISE STABILIZED IN A MANNER APPROVED BY LOCAL JURISDICTION.
NOTE: MANY MUNICIPALITIES PROHIBIT THE USE OF RECYCLED CONCRETE AS GRANULAR MATERIAL FOR STABILIZED STAGING AREAS DUE TO DIFFICULTIES WITH RE-ESTABLISHMENT OF VEGETATION IN AREAS WHERE RECYCLED CONCRETE WAS PLACED.
NOTE: MANY JURISDICTIONS HAVE BMP DETAILS THAT VARY FROM UDFCD STANDARD DETAILS. CONSULT WITH LOCAL JURISDICTIONS AS TO WHICH DETAIL SHOULD BE USED WHEN DIFFERENCES ARE NOTED.
(Details adapted from Douglas County, Colorado, not available in AutoCAD)

SSA-4 Urban Drainage and Flood Control District Urban Storm Drainage Criteria Manual Volume 3 November 2010

ENGINEERING RECORD DRAWINGS AS-BUILT DRAWINGS



COPYRIGHT THESE PLANS ARE AN INSTRUMENT OF SERVICE AND ARE THE PROPERTY OF GALLOWAY, AND MAY NOT BE DUPLICATED, DISCLOSED, OR REPRODUCED WITHOUT THE WRITTEN CONSENT OF GALLOWAY. COPYRIGHTS AND INFRINGEMENTS WILL BE ENFORCED AND PROSECUTED.



CONSTRUCTION DOCUMENTS SMITH PLUMBING & HEATING FOR HAMMERS CONSTRUCTION, LLC 1875 MAIN STREET COLORADO SPRINGS, CO 80911 - EL PASO COUNTY

Table with 3 columns: #, Date, Issue / Description, Init. It contains several rows of empty space for tracking changes.

Project No: HCI000008 Drawn By: TPPT Checked By: Date: 05/20/2024 GEC DETAILS











