HADDEN HEIGHTS NO. 2
ION OF LOT 18, HADDEN HEIGHTS

A portion of the Southeast One-quarter (SE1/4) of Section 13
Township 13 South (T13S), Range 65 West (R65W) of the 6TH P.M.
County of El Paso, State of Colorado

a portion of the title is missing, please add the complete title.

KNOW ALL MEN BY THESE PRESENTS:

That Jose A. Contreras and Mary W. Contreras, being the owners of the described tracts of land, to wit:

LAND DESCRIPTION:

A tract of land located in a portion of the Southeast One-quarter (SE1/4) of Section 13, Township 13 South (T13S), Range 65 West (R65W) of the 6TH P.M., County of El Paso, State of Colorado, being more particularly described as follows:

A vacation and replat of a portion of Lot 18, Hadden Heights, recorded under Reception No. 04040 as described in Warranty Deed, recorded under Reception No. 001479902, all in the records of the Clerk and Recorder's Office, County of El Paso, State of Colorado.

Said Tract contains 5.105 acres (222,395 s.f.) more or less.

OWNERS CERTIFICATE:

The undersigned, being all the owners, mortgagees, beneficiaries of deeds of trust and holders of other interests in the land described herein, have laid out, subdivided, and platted said lands into lots and easements as shown hereon under the name and subdivision of HADDEN HEIGHTS NO. 2. All public improvements so platted are hereby dedicated to public use and said owner does hereby covenant and agree that the public improvements will be constructed to El Paso County standards and that proper drainage and erosion control for same will be provided at said owner's expense, all to the satisfaction of the Board of County Commissioners of El Paso County, Colorado. Upon acceptance by resolution, all public improvements so dedicated will become matters of maintenance by El Paso County, Colorado. The utility easements shown hereon are hereby dedicated for public utilities and communication systems and other purposes as shown hereon. The entities responsible for providing the services for which the easements are established are hereby granted the perpetual right of ingress and egress from and to adjacent properties for installation, maintenance, and replacement of utility lines and related facilities.

Jose A. Contreras (Owner East Half Lot 18) Mary W. Contreras (Owner East Half Lot 18)

NOTARIAL:

STATE OF COLORADO)
) SS
COUNTY OF EL PASO)

The foregoing instrument was acknowledged before me this _____ day of _____, 20__ A.D., by Jose A. Contreras and Mary W. Contreras.

Witness my Hand and Seal: _____
Notary Public
My Commission Expires:_____

Address: _____

BASIS OF BEARINGS STATEMENT:

The bearings of this plat are based upon the West line of the tract of land described in Deed recorded at Reception No. 213118086 in the records of the Clerk and Recorder's Office, County of El Paso, State of Colorado, being monumented at the Southwest corner of said tract by a found #4 rebar and at the Northwest corner of said tract by a found #4 rebar. Said line bears N17°52'20"W a distance of 759.40 feet measured (759.49 feet deeded).

EASEMENTS:

please specify

Unless otherwise indicated, all side lot lines are hereby platted on either side with a ten (10') foot public utility and drainage easement. All rear lot lines are hereby platted with a twenty (20') foot public utility easement. All front lot lines are hereby platted with a fifteen (15') foot Equestrian easement as noted on the original plat of Hadden Heights. The sole responsibility for maintenance of these easements is hereby vested with the individual property owners.

APPROVALS:

This plat for HADDEN HEIGHTS NO. 2 was approved for filing by the El Paso County, Colorado Board of County Commissioners on the _____ day of _____, 20____, subject to any notes or conditions specified hereon.

Previous plat name in entirety is amended for the areas described by this Vacation and Replat is subject to all covenants, conditions, and restrictions recorded against and appurtenant to the original plat recorded in the Office of the El Paso County Clerk and Recorder at Reception No. 04040.

please put correct information in

Chair, Board of County Commissioners Date

RECORDING:

STATE OF COLORADO)
) SS
COUNTY OF EL PASO)

I hereby certify that this instrument was filed for record in my office at _____ o'clock ___.M., this _____ day of _____, 20___ A.D., and is duly recorded at Reception No. ___ _____ of the records of El Paso County, Colorado.

SURCHARGE: _____ CHUCK BROERMAN, Recorder

FEE: _____ By: _____
Deputy

SCHOOL FEE – DISTRICT# _____: _____

PARK FEES:
REGIONAL: _____
NEIGHBORHOOD: _____

DRAINAGE BASIN:_____
DRAINAGE FEE: _____
BRIDGE FEE: _____

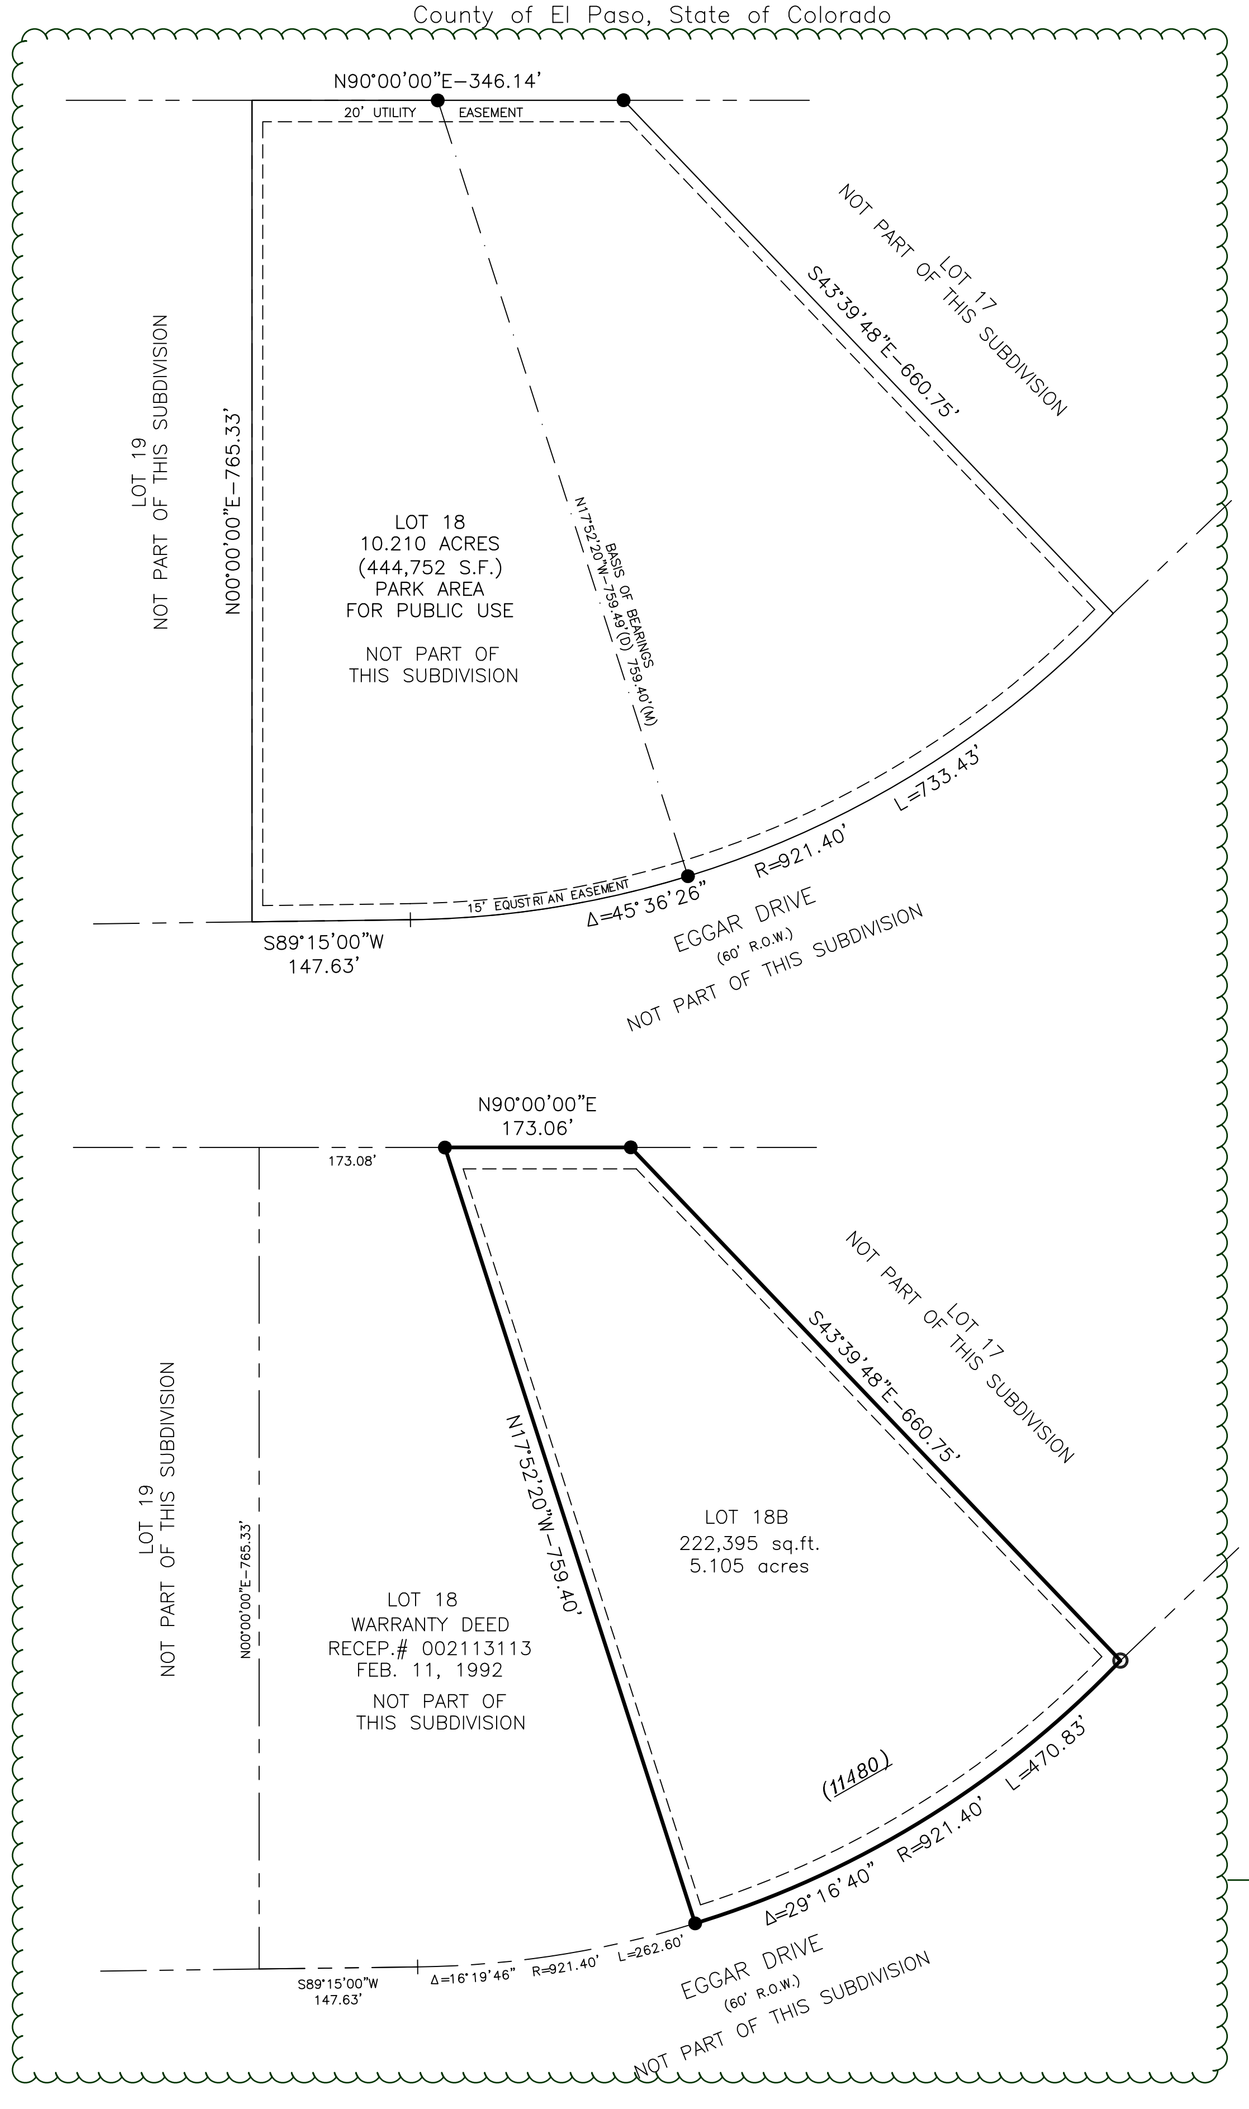

LEGEND

- BOUNDARY LINE
- LOT LINE
- EASEMENT LINE
- ADJACENT LOT LINE
- SET #4 REBAR & CAP MARKED "PLSC RLS 25968"
- FOUND #4 REBAR

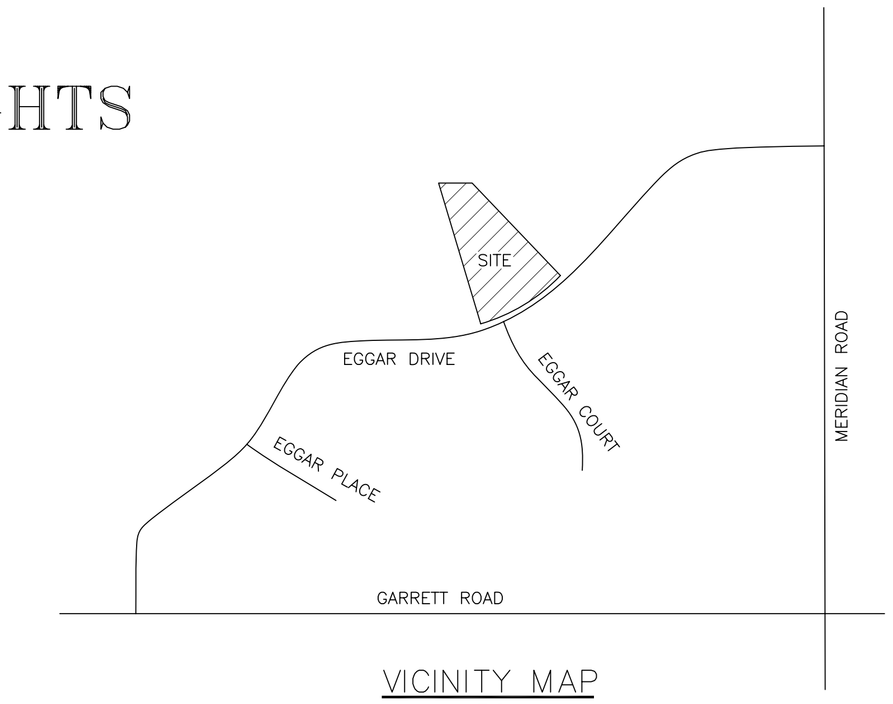

VICINITY MAP
N.T.S.

NOTES:

1. This survey does not constitute a title search by Pinnacle Land Surveying Company to determine ownership of easements of record. For all information regarding easement, rights-of-way and title of record, Pinnacle Land Surveying Company relied upon an a Commitment for Title Insuance, prepared by Commonwealth Land Title Insuance Company, effective date May 30, 2017, Commitment No. 598-H0506202-072-DR8.

8. Terms, conditions, restrictions, provisions, notes and easements but omitting any covenants or restrictions, if any, including but not limited to those based upon race, color, religion, sex, sexual orientation, familial status, marital status, disability, handicap, national origin, ancestry, or source of income, as set forth in applicable state or federal laws, except to the extent that said covenant or restriction is permitted by applicable law, as set forth on the Plat(s) of said subdivision set forth below: Recording Date: August 2, 1973 Recording No: Plat Book Z2 at Page 24.

9. Covenants, conditions and restrictions but omitting any covenants or restrictions, if any, including but not limited to those based upon race, color, religion, sex, sexual orientation, familial status, marital status, disability, handicap, national origin, ancestry, source of income, gender, gender identity, gender expression, medical condition or genetic information, as set forth in applicable state or federal laws, except to the extent that said covenant or restriction is permitted by applicable law, as set forth in the document recorded June 26, 1974 in Book 2686 at Page 759 and any and all amendments or supplements thereto.

10. Terms, conditions, provisions, agreements and obligations contained in the resolution as set forth below: Recording Date: March 10, 1981 Recording No.: 751613.

2. Individual wells are the responsibility of each property owner. Permits for individual wells must be obtained from the State Engineer who by law has the authority to set conditions for the issuance of these permits.

3. Sewage treatment is the responsibility of each individual property owner. The El Paso County Department of Health and Environment must approve each system and, in some cases the Department may require an engineer designed system prior to permit approval. These systems may cost more to design, install, and maintain.

4. All property owners are responsible for maintaining proper storm water drainage in and through their property. Public drainage easements as specifically noted on the plat shall be maintained by the individual lot owners unless otherwise indicated. Structures, fences, materials or landscaping that could impede the flow of runoff shall not be placed in drainage easements.

5. No driveway shall be established unless an access permit has been granted by El Paso County. Individual lot purchasers are responsible for constructing driveways, including necessary drainage culverts from Egger Drive per Land Development Code Section 6.3.3.C.2 and 6.3.3.C.3. Due to their length, some of the driveways will need to be specifically approved by the Falcon Fire Protection District.

6. All structural foundations shall be located and designed by a Professional Engineer, currently registered in the State of Colorado.

7. The addresses (10000) exhibited on this plat are for informational purposes only. They are not the legal descriptions and are subject to change.

8. Developer shall comply with federal and state laws, regulations, ordinances, review and permit requirements, and other agency requirements, if any, of applicable agencies including, but not limited to, the Colorado Division of Wildlife, Colorado Department of Transportation, U.S. Army Corps of Engineers and the U.S. Fish and Wildlife Service regarding the Endangered Species Act, particularly as it relates to the listed species (e.g., Preble's Meadow Jumping Mouse).

9. Mailboxes shall be installed in accordance with all El Paso County Department of Transportation and United States Postal Service regulations.

10. This property is located in Flood Zone X determined to be outside the 500-year floodplain as determined by the FEMA Flood Insurance Rate Map, Community Map Number 08041C0575 F, effective date March 17, 1997.

11. The Subdivider(s) agrees on behalf of him/herself and any developer or builder successors and assignees that Subdivider and/or said successors and assigns shall be required to pay traffic impact fees in accordance with the El Paso County Road Impact Fee Program Resolution (Resolution No. 16-454), or any amendments thereto, at or prior to the time of building permit submittals. The fee obligation, if not paid at final plat recording, shall be documented on all sales documents and on plat notes to ensure that a title search would find the fee obligation before sale Pursuant to the Land of the property.

12. The approval of this plat vacates the Lot 18 plat restrictions regarding "Park Area Dedicate I

pleas e add a note that state s: The rema inder of lot 18 is not inclu ded withi n this actio n

SURVEYOR'S CERTIFICATION:

I John W. Towner, a duly registered Professional Land Surveyor in the State of Colorado, do hereby certify that this plat truly and correctly represents the results of a survey made on date of survey, by me or under my direct supervision and that all monuments exist as shown hereon; that mathematical closure errors are less than 1:10,000 ; and that said plat has been prepared in full compliance with all applicable laws of the State of Colorado dealing with monuments, subdivision, or surveying of land and all applicable provisions of the El Paso County Land Development Code.

I attest the above on this _____ day of _____, 200___.

PINNACLE LAND SURVEYING CO., INC.

_____
John W. Towner, Date
Colorado registered PLS No. 25968

PCD FILE NO. VR-17-017

PINNACLE LAND SURVEYING COMPANY, INC.
121 COUNTY ROAD 5, DIVIDE, CO 687-7360

NOTICE: ACCORDING TO COLORADO LAW YOU MUST COMMENCE ANY LEGAL ACTION BASED UPON ANY DEFECT IN THIS SURVEY WITHIN THREE YEARS AFTER YOU FIRST DISCOVER SUCH DEFECT. IN NO EVENT, MAY ANY ACTION BASED UPON ANY DEFECT IN THIS SURVEY BE COMMENCED MORE THAN TEN YEARS FROM THE DATE OF THE CERTIFICATION SHOWN HEREON.

HADDEN HEIGHTS NO. 2		
DRAWN BY:MWW	CHECKED BY: JWT	DATE: 07/03/18
JOB NO.: 16003900	DWG: 16003900-AP.DWG	SHEET 1 OF 1