

MyGarage@Northcrest
Units B133 & B134

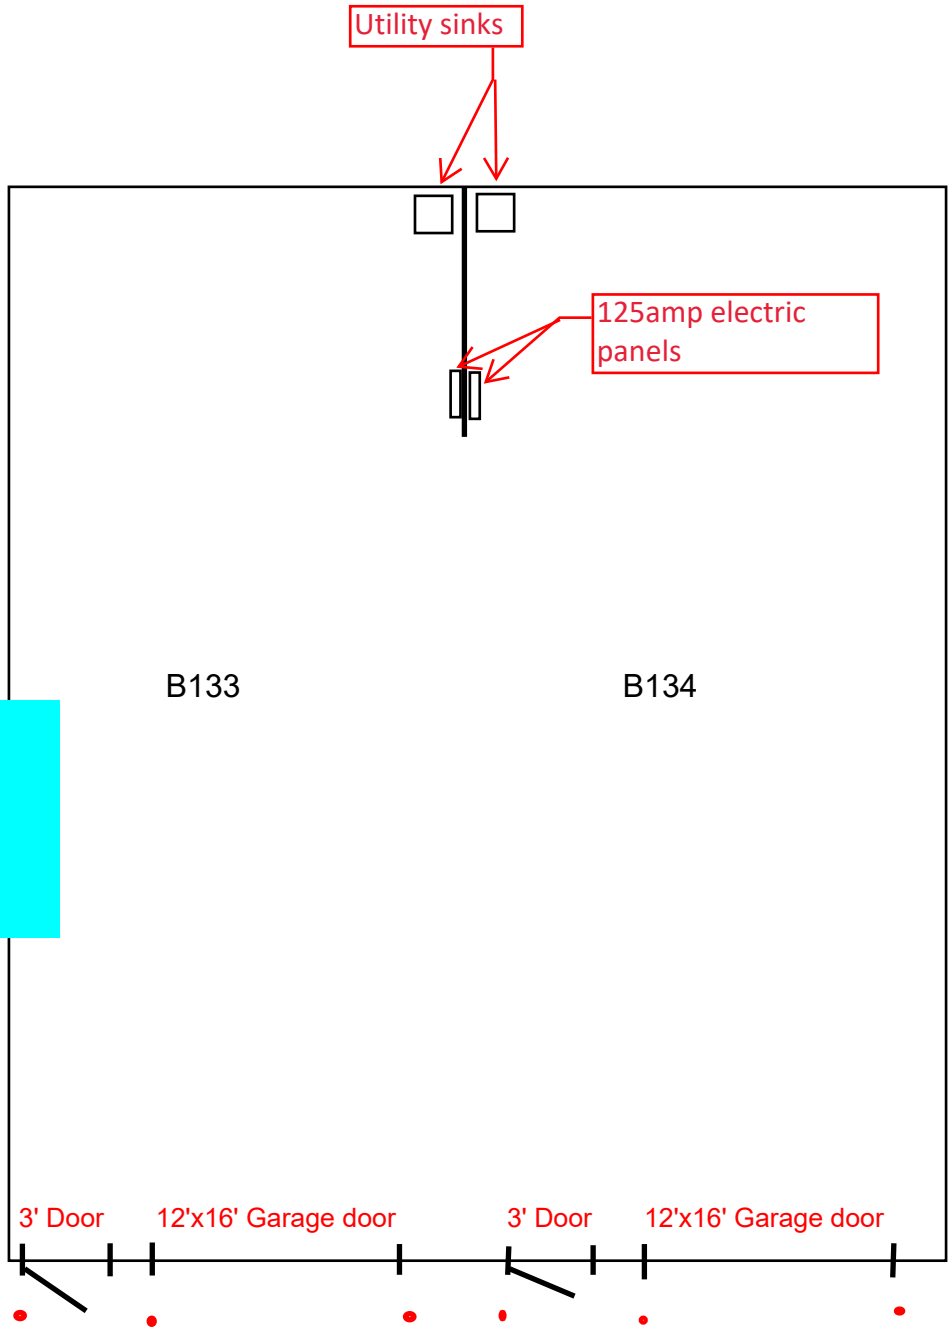


Please provide dimensions for all units, add sqft, Depict walls, bathrooms, office spaces, etc.

# V1_Floor Plans (8.5 x 11) (Includes Markup Summary).pdf Markup Summary

## Text Box (1)

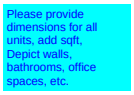


**Subject:** Text Box
**Page Label:** 1
**Author:** eschoenheit
**Date:** 10/20/2026 3:58:58 PM
**Status:**
**Color:**
**Layer:**
**Space:**

Please provide dimensions for all units, add sqft, Depict walls, bathrooms, office spaces, etc.