
SDP Admin data needed per checklist.

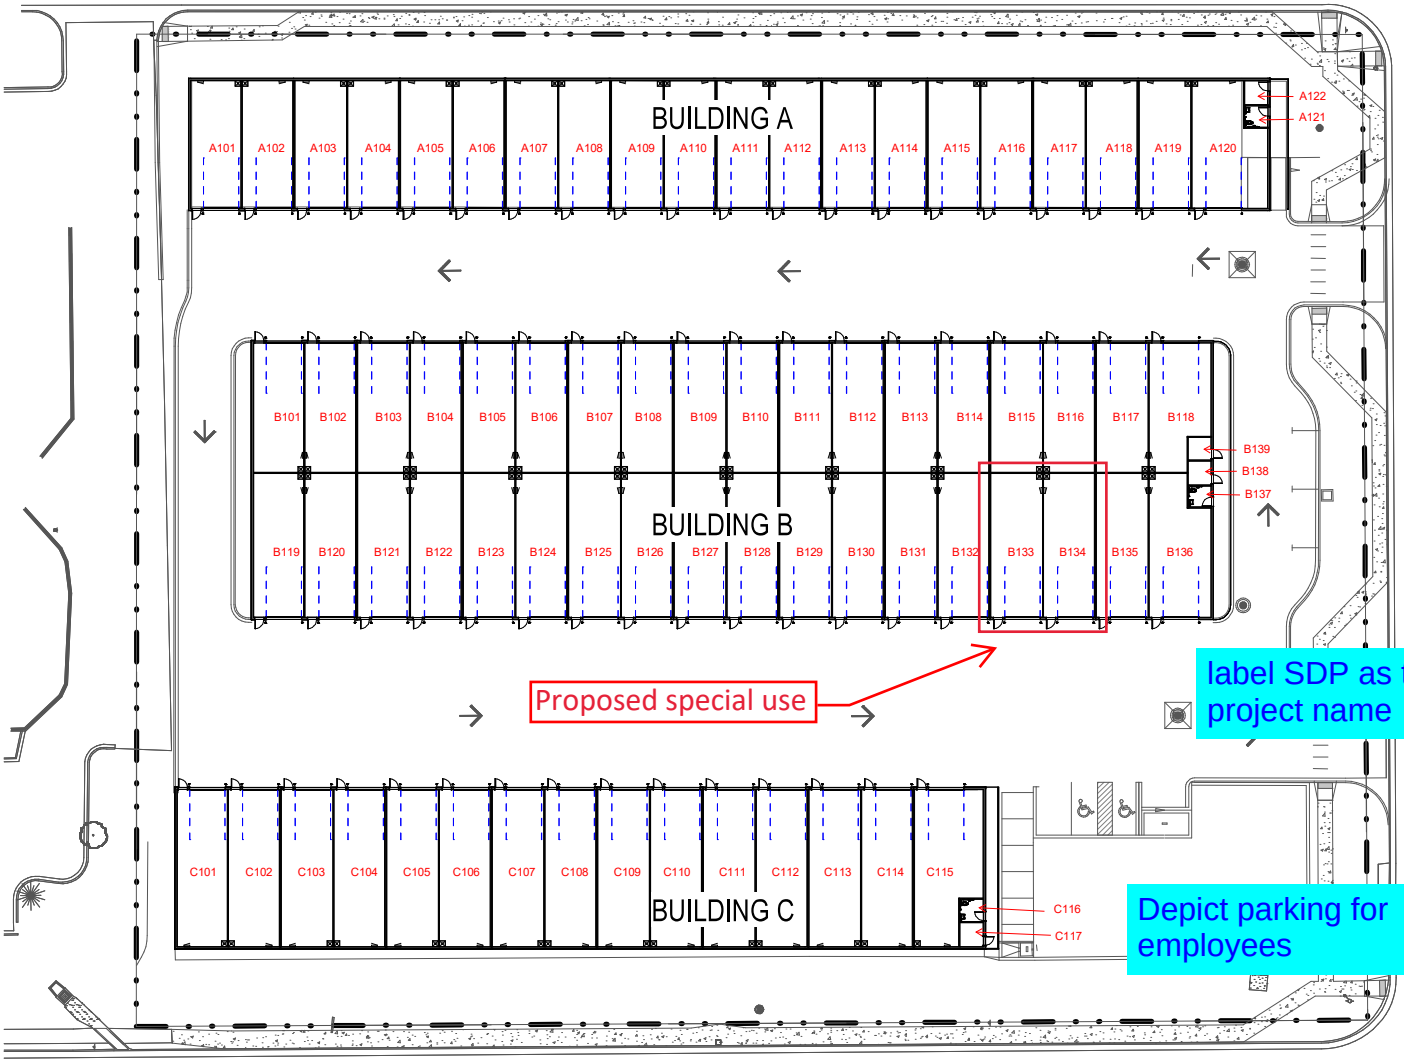


label SDP as the project name

Depict parking for employees

NORTH

1 AS100 OVERALL SITE PLAN
1" = 20'-0" [REF. 1 / A100]


Y | O | W Architects PC
Architecture & Planning
115 S. Weber Colorado Springs, Colorado 719-475-8133


Revision Schedule

NOT FOR CONSTRUCTION

MyGarage @ Northcrest - C
2510 CANADA DRIVE
COLORADO SPRINGS, CO

SCHEMATIC DESIGN


Project Number: 24037
Date: 03/04/2024
Drawn By: JDC
Checked By: YOW

AS100
ARCH SITE PLAN
Scale: 1" = 20'-0"

3/4/2024 12:49:27 PM

# V1_Site Plan Drawing (Includes Markup Summary).pdf Markup Summary


## Cloud+ (1)

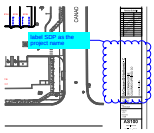


**Subject:** Cloud+
**Page Label:** 1
**Author:** eschoenheit
**Date:** 10/20/2026 3:58:13 PM
**Status:**
**Color:**
**Layer:**
**Space:**

label SDP as the project name

## Highlight (1)

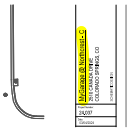

**Subject:** Highlight
**Page Label:** 1
**Author:** eschoenheit
**Date:** 10/20/2026 3:58:21 PM
**Status:**
**Color:**
**Layer:**
**Space:**


## Text Box (2)




**Subject:** Text Box
**Page Label:** 1
**Author:** eschoenheit
**Date:** 10/20/2026 12:02:34 PM
**Status:**
**Color:**
**Layer:**
**Space:**

Depict parking for employees

---

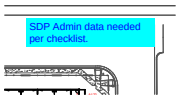


**Subject:** Text Box
**Page Label:** 1
**Author:** eschoenheit
**Date:** 10/21/2026 2:22:22 PM
**Status:**
**Color:**
**Layer:**
**Space:**

SDP Admin data needed per checklist.