


Township 13 South

SCALE: 1" = 500'

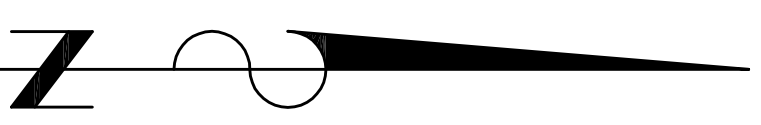

LEGAL DESCRIPTION

THE SOUTHWEST QUARTER OF THE SOUTHWEST QUARTER OF SECTION 01, AND THE SOUTHEAST QUARTER OF THE SOUTHWEST QUARTER OF SECTION 02, AND THE EAST HALF OF THE NORTHWEST QUARTER OF SECTION 11 AND THE NORTHWEST QUARTER OF SECTION 12, ALL WITHIN TOWNSHIP 13 SOUTH, RANGE 68 WEST, COLORADO BASELINE, 6TH PRINCIPAL MERIDIAN, COUNTY OF EL PASO, STATE OF COLORADO.

EL PASO COUNTY TAX PARCEL NUMBER: 8300000097

SITE ADDRESS


6935 RAMPART RANGE ROAD
EL PASO COUNTY, COLORADO
EXISTING ZONING: R-1
EXISTING LAND USE: RESIDENTIAL RELIGIOUS PURPOSES

OWNER & PREPARER

THE NAVIGATORS
MIKE WENGER
3820 N. 30TH STREET
COLORADO SPRINGS, COLORADO 80904-5001
PHONE: 719-272-7453

500 foot OWNERSHIP

EL PASO COUNTY TAX PARCEL NUMBERS:
8300000040 & 8300000096
PIKE AND SAN ISABEL NATIONAL FOREST
2840 KACHINA DRIVE
FUEBLI, CO 81008
719-553-1400
EXISTING ZONING: R-1
EXISTING LAND USE: VACANT

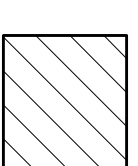

Please provide revised vicinity map which shows relationship of property to major roads.



EAGLE LAKE CAMP
THE NAVIGATORS, COLORADO SPRINGS, COLORADO
SPECIAL USE PERMIT EXHIBIT
BOUNDARY AND 500 FOOT RADIUS MAP

DRWN: SEPT. 9, 2019

DRAWN BY: LJW

SHEET:
1 of 2