update the design data per the new roadway classifications due to the developments traffic


DESIGN DATA	COUNTY LINE RD (MINOR ARTERIAL)	BEACON LITE RD (MINOR COLLECTOR)
MINIMUM RADIUS OF CURVE*	533	533
MINIMUM GRADE	1%	1%
MAXIMUM GRADE	6%	8%
MINIMUM S.S.D. HORIZONTAL**	305 FT	305 FT
K CREST***	44	44
K SAG****	64	64
MAXIMUM DESIGN SPEED	40 MPH	40 MPH
POSTED SPEED	35 MPH	35 MPH
E MAX	4%	4%

DESIGN DATA	BEACON LITE RD (ROUNDABOUT)
K CREST***	12
K SAG****	26
MAXIMUM DESIGN SPEED	25 MPH
E MAX	4%

*BASED ON AASHTO TABLE 3–8. EMAX=4%
**BASED ON AASHTO TABLE 3–1.
***BASED ON AASHTO TABLE 3–35.
****BASED ON AASHTO TABLE 3–37.

EL PASO COUNTY

I-25 AND COUNTY LINE ROAD
60% SUBMITTAL
EL PASO COUNTY, COLORADO

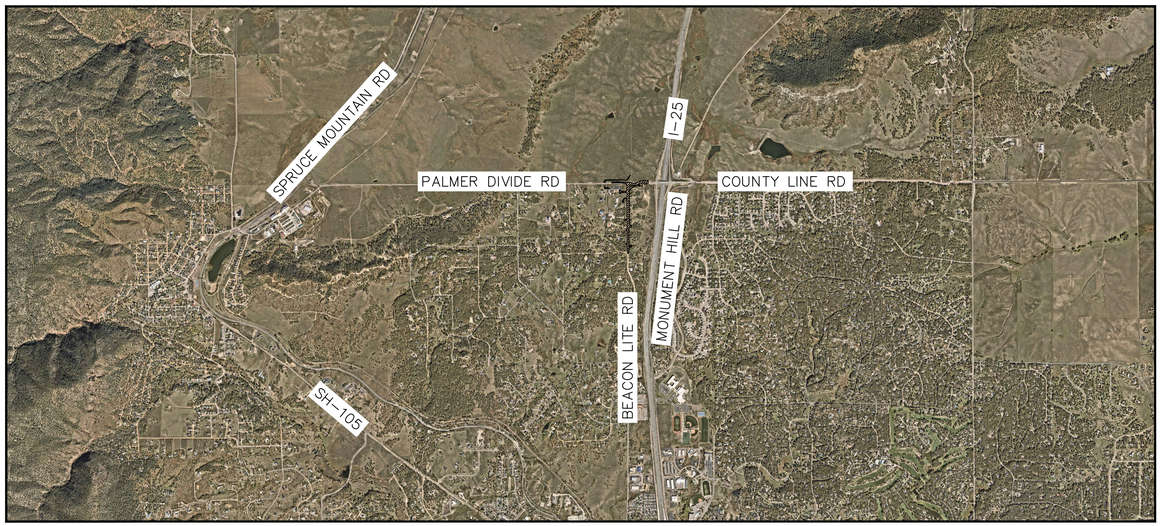

N.T.S

NORTH

LEGEND

PROJECT SITE LIMITS

SHEET INDEX

SHEET NO.	SHEET NAME
1	COVER SHEET
2	GENERAL NOTES
3	LEGEND, SYMBOLS, AND ABBREVIATIONS
4–7	TYPICAL SECTIONS
8–10	HORIZONTAL CONTROL
11–16	REMOVALS
17–30	PLAN & PROFILE
31–41	ROADWAY DETAILS
42–55	OFFSITE STORM P&P ABC
56–61	SIGNING AND MARKING
62	TRAFFIC SIGNAL PLAN

Do not duplicate sheets between County and CDOTs plan sets

Provide following signature blocks:

- Engineer's
- Owners/Developers
- EPC Administrator

All necessary offsite easement must be acquired by the owner/developer before plans are approved.
It is the owner/developer's responsibility to obtain all necessary offsite easements.

Show the Town of Monument (TOM) city limits. Coordinate with TOM regarding any improvements located with their City Limits.

The County is amenable to having both EPC and TOM improvements within the same construction plan set; however, the plan set must be clear which sheets or section each jurisdiction is approving.

BENCHMARK AND CONTROL
GEOID 2018 (CONUS)
PROJECT HEIGHT = 6501.443 FT (NAVD 88)

PROJECT BENCHMARK (LJAS # 50):
COLORADO DEPARTMENT OF TRANSPORTATION NO V395 (KK1315) BEING A STAINLESS STEEL ROD IN MONUMENT BOX
ELEVATION = 7346.61'(NAVD 88)

PROJECT CONTROL STATEMENT:
PROJECT COORDINATES ARE BASED ON THE COLORADO DEPARTMENT OF TRANSPORTATION LOCAL COORDINATE SYSTEM BASED ON THE FOLLOWING PUBLISHED INFORMATION DERIVED FROM A MODIFIED NAD 83 (2011) COLORADO STATE PLANE CENTRAL ZONE (0502) IN US SURVEY FEET:

PROJECTION: TRANSVERSE MERCATOR PROJECTION
POINT OF ORIGIN: U396 (KK1328)
NORTHING: 1,000,000 FT
EASTING: 3,000,000 FT
PROJECT/SCALE FACTOR HEIGHT: 6604.141 FT (NAVD 88)
SCALE FACTOR: 1.0003689763

OWNER
BUC–EE'S LTD
2500 NORTH HIGHWAY 288
ANGLETON, TX, 77515
EMAIL: SCOTT.RATCLIFF@BUC–EES.COM
CONTACT: SCOTT RATCLIFF, P.E.

CIVIL ENGINEER
KIMLEY–HORN AND ASSOCIATES, INC.
6200 SOUTH SYRACUSE WAY, SUITE 300
GREENWOOD VILLAGE, CO 80111
EMAIL: MARK.FLOOD@KIMLEY–HORN.COM
CONTACT: MARK FLOOD, P.E.

EL PASO COUNTY
MAIN COUNTY PHONE: 719–520–7276
DEPARTMENT OF PUBLIC WORKS:
719–520–6460
PLANNING AND COMMUNITY DEVELOPMENT:
719–520–6819

CDOT REGION 2
EMAIL: ADAM.LANCASTER@STATE.CO.US
CONTACT: ADAM LANCASTER

Removed CDOT information from County plans

ELECTRIC (RURAL EL PASO COUNTY)
MOUNTAIN VIEW ELETRIC ASSOCIATION
800–388–9881

NATURAL GAS
BLACK HILLS ENERGY
888–890–5554

TELECOM
COMCAST (XFINITY)
1–800–XFINITY

Know what's below. Call before you dig.

This document, together with the concepts and designs presented herein, as an instrument of service, is intended only for the specific purpose and client for which it was prepared. Reuse of and improper reliance on this document without written authorization and adaptation by Kimley-Horn and Associates, Inc. shall be without liability to Kimley-Horn and Associates, Inc.

Print Date: 5/19/26
Drawing File Name: epc-01_cover sheet.dwg

Kimley»Horn
KIMLEY–HORN AND ASSOCIATES, INC.
6200 SOUTH SYRACUSE WAY
SUITE 300
GREENWOOD VILLAGE, COLORADO 80111
(303) 228–2300

	Sheet Revisions		
	Date:	Comments:	Init.
R–X			
R–X			
R–X			
R–X			

EL PASO COUNTY
DEPARTMENT OF PUBLIC WORKS
3275 AKERS DRIVE
COLORADO SPRINGS, CO
80922

R – FINAL
FOR REVIEW ONLY
NOT FOR CONSTRUCTION
Kimley»Horn
Kimley-Horn and Associates, Inc.

60% PLANS
No Revisions:
Revised:
Void:

EL PASO COUNTY TRAVEL CENTER
PREPARED FOR
BUC-EE'S, LTD.
COVER SHEET

Designer:	APW	Structure Numbers	
Detailer:	DJC		
Checked By:	MPF	Subset Sheet:	1 of 1

Project No./Code

KH 196094002

Sheet Number 1

EL PASO COUNTY STANDARD NOTES:

1. ALL DRAINAGE AND ROADWAY CONSTRUCTION SHALL MEET THE STANDARDS AND SPECIFICATIONS OF THE CITY OF COLORADO SPRINGS/EL PASO COUNTY DRAINAGE CRITERIA MANUAL, VOLUMES 1 AND 2, AND THE EL PASO COUNTY ENGINEERING CRITERIA MANUAL.
2. CONTRACTOR SHALL BE RESPONSIBLE FOR THE NOTIFICATION AND FIELD NOTIFICATION OF ALL EXISTING UTILITIES, WHETHER SHOWN ON THE PLANS OR NOT, BEFORE BEGINNING CONSTRUCTION. LOCATION OF EXISTING UTILITIES SHALL BE VERIFIED BY THE CONTRACTOR PRIOR TO CONSTRUCTION. CALL 811 TO CONTACT THE UTILITY NOTIFICATION CENTER OF COLORADO (UNCC).
3. CONTRACTOR SHALL KEEP A COPY OF THESE APPROVED PLANS, THE GRADING AND EROSION CONTROL PLAN, THE STORMWATER MANAGEMENT PLAN (SWMP), THE SOILS AND GEOTECHNICAL REPORT, AND THE APPROPRIATE DESIGN AND CONSTRUCTION STANDARDS AND SPECIFICATIONS AT THE JOB SITE AT ALL TIMES, INCLUDING THE FOLLOWING:
   A. EL PASO COUNTY ENGINEERING CEITERIA MANUAL (ECM)
   B. CITY OF COLORADO SPRINGS/EL PASO COUNTY DRAINAGE CRITERIA MANUAL, VOLUME 1 AND 2
   C. COLORADO DEPARTMENT OF TRANSPORTATION (CDOT) STANDARD SPECIFICATIONS FOR ROAD AND BRIDGE CONSTRUCTION
   D. CDOT M & S STANDARDS
4. NOTWITHSTANDING ANYTHING DEPICTED IN THESE PLANS IN WORDS OR GRAPHIC REPRESENTATION, ALL DESIGN AND CONSTRUCTION RELATED TO ROADS, STORM DRAINAGE AND EROSION CONTROL SHALL CONFORM TO THE STANDARDS AND REQUIREMENTS OF THE MOST RECENT VERSION OF THE RELEVANT ADOPTED EL PASO COUNTY STANDARDS, INCLUDING THE LAND DEVELOPMENT CODE, THE ENGINEERING CRITERIA MANUAL, THE DRAINAGE CRITERIA MANUAL, AND THE DRAINAGE CRITERIA MANUAL VOLUME 2. ANY DEVIATIONS FROM REGULATIONS AND STANDARDS MUST BE REQUESTED, AND APPROVED, IN WRITING. ANY MODIFICATIONS NECESSARY TO MEET CRITERIA AFTER-THE-FACT WILL BE ENTIRELY THE DEVELOPER'S RESPONSIBILITY TO RECTIFY.
5. IT IS THE DESIGN ENGINEER'S RESPONSIBILITY TO ACCURATELY SHOW EXISTING CONDITIONS, BOTH ONSITE AND OFFSITE, ON THE CONSTRUCTION PLANS. ANY MODIFICATIONS NECESSARY DUE TO CONFLICTS, OMISSIONS, OR CHANGED CONDITIONS WILL BE ENTIRELY THE DEVELOPER'S RESPONSIBILITY TO RECTIFY.
6. CONTRACTOR SHALL SCHEDULE A PRE-CONSTRUCTION MEETING WITH EL PASO COUNTY PLANNING AND COMMUNITY DEVELOPMENT (PCD) - INSPECTIONS, PRIOR TO STARTING CONSTRUCTION.
7. IT IS THE CONTRACTOR'S RESPONSIBILITY TO UNDERSTAND THE REQUIREMENTS OF ALL JURISDICTIONAL AGENCIES AND TO OBTAIN ALL REQUIRED PERMITS, INCLUDING BUT NOT LIMITED TO EL PASO COUNTY EROSION AND STORMWATER QUALITY CONTROL PERMIT (ESQCP), REGIONAL BUILDING FLOODPLAIN DEVELOPMENT PERMIT, U.S. ARMY CORPS OF ENGINEERS-ISSUED 401 AND/OR 404 PERMITS, AND COUNTY AND STATE FUGITIVE DUST PERMITS.
8. CONTRACTOR SHALL NOT DEVIATE FROM THE PLANS WITHOUT FIRST OBTAINING WRITTEN APPROVAL FROM THE DESIGN ENGINEER AND PCD. CONTRACTOR SHALL NOTIFY THE DESIGN ENGINEER IMMEDIATELY UPON DISCOVERY OF ANY ERRORS OR INCONSISTENCIES.
9. ALL STORM DRAIN PIPE SHALL BE CLASS III RCP UNLESS OTHERWISE NOTED AND APPROVED BY PCD.
10. CONTRACTOR SHALL COORDINATE GEOTECHNICAL TESTING PER ECM STANDARDS. PAVEMENT DESIGN SHALL BE APPROVED BY EL PASO COUNTY PCD PRIOR TO PLACEMENT OF CURB AND GUTTER AND PAVEMENT.
11. ALL CONSTRUCTION TRAFFIC MUST ENTER/EXIT THE SITE AT APPROVED CONSTRUCTION ACCESS POINTS.
12. SIGHT VISIBILITY TRIANGLES AS IDENTIFIED IN THE PLANS SHALL BE PROVIDED AT ALL INTERSECTIONS. OBSTRUCTIONS GREATER THAN 18 INCHES ABOVE FLOWLINE ARE NOT ALLOWED WITHIN SIGHT TRIANGLES.
13. SIGNING AND STRIPING SHALL COMPLY WITH EL PASO COUNTY DOT AND MUTCD CRITERIA.
14. CONTRACTOR SHALL OBTAIN ANY PERMITS REQUIRED BY EL PASO COUNTY DOT, INCLUDING WORK WITHIN THE RIGHT-OF-WAY AND SPECIAL TRANSPORT PERMITS.
15. THE LIMITS OF CONSTRUCTION SHALL REMAIN WITHIN THE PROPERTY LINE UNLESS OTHERWISE NOTED. THE OWNER/DEVELOPER SHALL OBTAIN WRITTEN PERMISSION AND EASEMENTS, WHERE REQUIRED, FROM ADJOINING PROPERTY OWNER(S) PRIOR TO ANY OFF-SITE DISTURBANCE, GRADING, OR CONSTRUCTION.
16. EL PASO COUNTY DOES NOT OWN AND IS NOT RESPONSIBLE FOR THE UNDERDRAINS OR GROUNDWATER DISCHARGE SYSTEMS SHOWN ON THESE PLANS AND ASSUMES NO LIABILITY FOR WATER RIGHTS ADMINISTRATION BY APPROVING THESE PLANS. MAINTENANCE AND WATER RIGHTS ARE THE RESPONSIBILITY OF THE DEVELOPER.

EL PASO COUNTY SIGNING AND STRIPING NOTES:

update to current signing and stripping notes

1. ALL SIGNS AND PAVEMENT MARKINGS SHALL BE IN COMPLIANCE WITH THE CURRENT MANUAL ON UNIFORM TRAFFIC CONTROL DEVICES (MUTCD).
2. REMOVAL OF EXISTING PAVEMENT MARKINGS SHALL BE ACCOMPLISHED BY A METHOD THAT DOES NOT MATERIALLY DAMAGE THE PAVEMENT. THE PAVEMENT MARKINGS SHALL BE REMOVED TO THE EXTENT THAT THEY WILL NOT BE VISIBLE UNDER DAY OR NIGHT CONDITIONS. AT NO TIME WILL IT BE ACCEPTABLE TO PAINT OVER EXISTING PAVEMENT MARKINGS.
3. ANY DEVIATION FROM THE STRIPING AND SIGNING PLAN SHALL BE APPROVED BY EL PASO COUNTY PLANNING AND COMMUNITY DEVELOPMENT.
4. ALL SIGNS SHOWN ON THE SIGNING AND STRIPING PLAN SHALL BE NEW SIGNS. EXISTING SIGNS MAY REMAIN OR BE REUSED IF THEY MEET CURRENT EL PASO COUNTY AND MUTCD STANDARDS.
5. STREET NAME AND REGULATORY STOP SIGNS SHALL BE ON THE SAME POST AT INTERSECTIONS.
6. ALL REMOVED SIGNS SHALL BE DISPOSED OF IN A PROPER MANNER BY THE CONTRACTOR.
7. ALL TRAFFIC SIGNS SHALL HAVE A MINIMUM HIGH INTENSITY PRISMATIC GRADE SHEETING.
8. ALL LOCAL RESIDENTIAL STREET SIGNS SHALL BE MOUNTED ON A 1.75" X 1.75" SQUARE TUBE SIGN POST AND STUB POST BASE. FOR OTHER APPLICATIONS, REFER TO THE CDOT STANDARD S-614-8 REGARDING USE OF THE P2 TUBULAR STEEL POST SLIPBASE DESIGN.
9. ALL LIMIT LINES/STOP LINES, CROSSWALK LINES, PAVEMENT LEGENDS, AND ARROWS SHALL BE A MINIMUM 125 MIL THICKNESS PREFORMED THERMOPLASTIC PAVEMENT MARKINGS WITH TAPERED LEADING EDGES PER CDOT STANDARD S-627-1. STOP BARS SHALL BE 24" IN WIDTH. CROSSWALKS LINES SHALL BE 24" WIDE AND A MINIMUM OF 9' LONG.
10. WORD AND SYMBOL MARKINGS SHALL BE THE NARROW TYPE.
11. ALL LONGITUDINAL LINES SHALL BE A MINIMUM 15MIL THICKNESS EPOXY PAINT. ALL NON-LOCAL RESIDENTIAL ROADWAYS SHALL INCLUDE BOTH RIGHT AND LEFT EDGE LINE STRIPING AND ANY ADDITIONAL STRIPING AS REQUIRED BY CDOT S-627-1.
12. THE CONTRACTOR SHALL NOTIFY EL PASO COUNTY PLANNING AND COMMUNITY DEVELOPMENT (719) 520-6819 PRIOR TO AND UPON COMPLETION OF SIGNING AND STRIPING.
13. THE CONTRACTOR SHALL OBTAIN A WORK IN THE RIGHT OF WAY PERMIT FROM THE EL PASO COUNTY DEPARTMENT OF PUBLIC WORKS (DPW) PRIOR TO ANY SIGNAGE OR STRIPING WORK WITHIN AN EXISTING EL PASO COUNTY ROADWAY

Know what's **below.** **Call** before you dig.

This document, together with the concepts and designs presented herein, as an instrument of service, is intended only for the specific purpose and client for which it was prepared. Reuse of and improper reliance on this document without written authorization and adaptation by Kimley-Horn and Associates, Inc. shall be without liability to Kimley-Horn and Associates, Inc.

Print Date: 5/19/26
Drawing File Name: epc-02_general notes.dwg

Kimley»Horn
KIMLEY-HORN AND ASSOCIATES, INC.
6200 SOUTH SYRACUSE WAY
SUITE 300
GREENWOOD VILLAGE, COLORADO 80111
(303) 228-2300

Sheet Revisions

	Date:	Comments:	Init.
R-X			
R-X			
R-X			
R-X			

EL PASO COUNTY
DEPARTMENT OF PUBLIC WORKS
3275 AKERS DRIVE
COLORADO SPRINGS, CO
80922

FOR REVIEW ONLY
NOT FOR CONSTRUCTION
Kimley»Horn
Kimley-Horn and Associates, Inc.

60% PLANS

No Revisions:
Revised:
Void:

EL PASO COUNTY TRAVEL CENTER
PREPARED FOR
BUC-EE'S, LTD.
GENERAL NOTES

Designer: APW
Detailer: DJC
Checked By: MPF
Structure Numbers:
Subset Sheet: 1 of 2

Project No./Code
KH 196094002
Sheet Number 2

ABBREVIATIONS:

℄	BASELINE
BP	BEGIN POINT
℄	CENTERLINE
CIP	CAST IN PLACE
C&G	CURB AND GUTTER
CR	CURB RETURN
DIA.	DIAMETER
DTL	DETAIL
EL	ELEVATION
EG	EXISTING GROUND
EOP	EDGE OF PAVEMENT
EP	END POINT
ESMT	EASEMENT
ETW	EDGE OF TRAVELED WAY
EX	EXISTING
FES	FLARED END SECTION
FG	FINISHED GRADE
FL	FLOW LINE
HCL	HORIZONTAL CONTROL LINE
LF	LINEAR FOOT/FEET
LOD	LIMITS OF DISTURBANCE
LT	LEFT
ME	MATCH EXISTING
NO	NUMBER
NTS	NOT TO SCALE
OFF	OFFSET
PC	POINT OF CURVE
PCC	POINT OF COMPOUND CURVE
PCR	POINT OF CURB RETURN
PGL	PROFILE GRADE LINE
PGP	PROFILE GRADE POINT
PRC	POINT OF REVERSE CURVE
PROP	PROPOSED
PT	POINT OF TANGENCY
PVI	POINT OF VERTICAL INTERSECTION
R	RADIUS
RD	ROAD
RT	RIGHT
ROW	RIGHT OF WAY
SF	SQUARE FEET
SNS	STREET NAME SIGN
SSD	STOPPING SIGHT DISTANCE
STA	STATION
STD	STANDARD
SWK	SIDEWALK
SY	SQUARE YARDS
TC	TOP OF CURB
TCE	TEMPORARY CONSTRUCTION EASEMENT
TYP	TYPICAL
UE	UTILITY EASEMENT
UTIL	UTILITY
VAR	VARIES
VC	VERTICAL CURVE
VPC	VERTICAL POINT OF CURVATURE
VPI	VERTICAL POINT OF INTERSECTION
VPT	VERTICAL POINT OF TANGENCY
W	WEST
N	NORTH

LEGEND

- EXISTING UNDERGROUND STORM LINE
- EXISTING GAS LINE
- EXISTING COMM LINE
- EXISTING UNDERGROUND ELECTRIC LINE
- EXISTING OVERHEAD ELECTRIC LINE
- EXISTING UNKNOWN UTILITY LINE
- EXISTING CHAIN LINK FENCE
- EXISTING BARBED–WIRE FENCE
- EXISTING GUARD–RAIL
- EXISTING MINOR CONTOUR
- EXISTING MAJOR CONTOUR
- EXISTING PROPERTY LINE
- SECTION LINE
- EXISTING RIGHT–OF–WAY LINE
- PROPOSED RIGHT–OF–WAY LINE
- EXISTING EASEMENT LINE

HATCHING LEGEND

- PROPOSED ASPHALT (COUNTY LINE ROAD)
- PROPOSED ASPHALT (BEACON LITE ROAD)
- PROPOSED ASPHALT (DRIVEWAYS)
- PROPOSED ABC (ACCESS ROAD)
- PROPOSED CONCRETE PAVEMENT (TRUCK APRON)
- PROPOSED CONCRETE MEDIAN
- EXISTING RIPRAP
- EXISTING EASEMENT

EXISTING SYMBOLS

- EXISTING UTILITY POLE
- EXISTING GUY ANCHOR
- EXISTING LIGHT POLE
- EXISTING POWER HANDHOLE
- EXISTING POWER BOX
- EXISTING POWER MARKER
- EXISTING POWER MARKER
- EXISTING GAS METER
- EXISTING GAS MARKER
- EXISTING GAS TEST STATION
- EXISTING CATV MARKER
- EXISTING CATV HANDHOLE
- EXISTING FIBER BOX
- EXISTING TELEPHONE MANHOLE
- EXISTING COMM MARKER
- EXISTING SIGN
- EXISTING SIGN
- EXISTING MAILBOX
- EXISTING TREE
- EXISTING END ANCHOR
- EXISTING INLET
- EXISTING FLARED END SECTION

This document, together with the concepts and designs presented herein, as an instrument of service, is intended only for the specific purpose and client for which it was prepared. Reuse of and improper reliance on this document without written authorization and adaptation by Kimley-Horn and Associates, Inc. shall be without liability to Kimley-Horn and Associates, Inc.

Know what's **below.** **Call** before you dig.

Print Date: 5/19/26

Drawing File Name: epc-02_general notes.dwg

Kimley»Horn
KIMLEY–HORN AND ASSOCIATES, INC.
6200 SOUTH SYRACUSE WAY
SUITE 300
GREENWOOD VILLAGE, COLORADO 80111
(303) 228–2300

Sheet Revisions

	Date:	Comments:	Init.
R–X			
R–X			
R–X			
R–X			

EL PASO COUNTY COLORADO EST. 1861

EL PASO COUNTY
DEPARTMENT OF PUBLIC WORKS
3275 AKERS DRIVE
COLORADO SPRINGS, CO
80922

FOR REVIEW ONLY
NOT FOR CONSTRUCTION
Kimley»Horn
Kimley-Horn and Associates, Inc.

60% PLANS

No Revisions:

Revised:

Void:

EL PASO COUNTY TRAVEL CENTER
PREPARED FOR
BUC-EE'S, LTD.
LEGEND, SYMBOLS, AND ABBREVIATIONS

Designer: APW
Detailer: DJC
Checked By: MPF


Structure Numbers

Subset Sheet: 2 of 2


Project No./Code

KH 196094002


Sheet Number 3

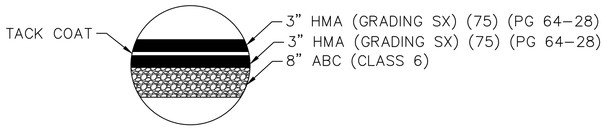


PROPOSED PAVEMENT
STRUCTURAL SECTION
(COUNTY LINE ROAD)

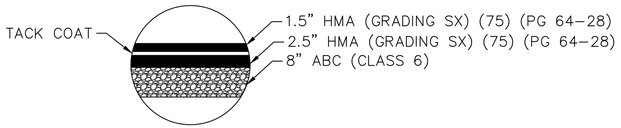


PROPOSED PAVEMENT
STRUCTURAL SECTION
(BEACON LITE ROAD)

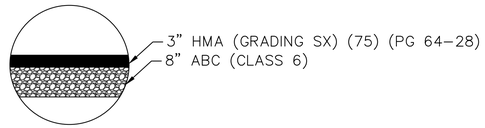


PROPOSED PAVEMENT
STRUCTURAL SECTION
(DRIVEWAYS)

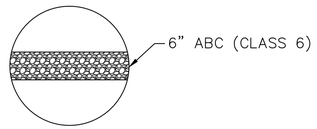

PROPOSED PAVEMENT
STRUCTURAL SECTION
(ACCESS ROAD)

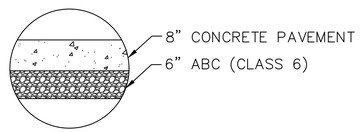


PROPOSED PAVEMENT
STRUCTURAL SECTION
(TRUCK APRON)

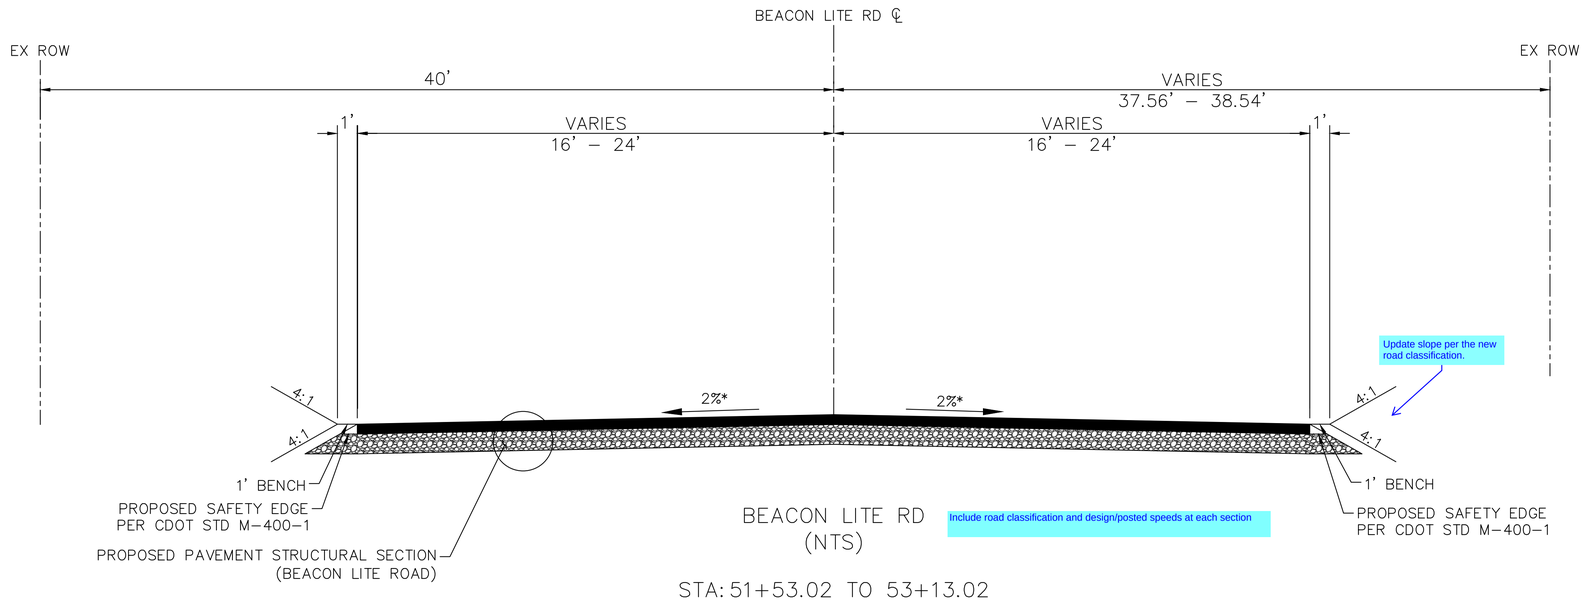

BEACON LITE RD
(NTS)

Include road classification and design/posted speeds at each section

STA: 51+53.02 TO 53+13.02

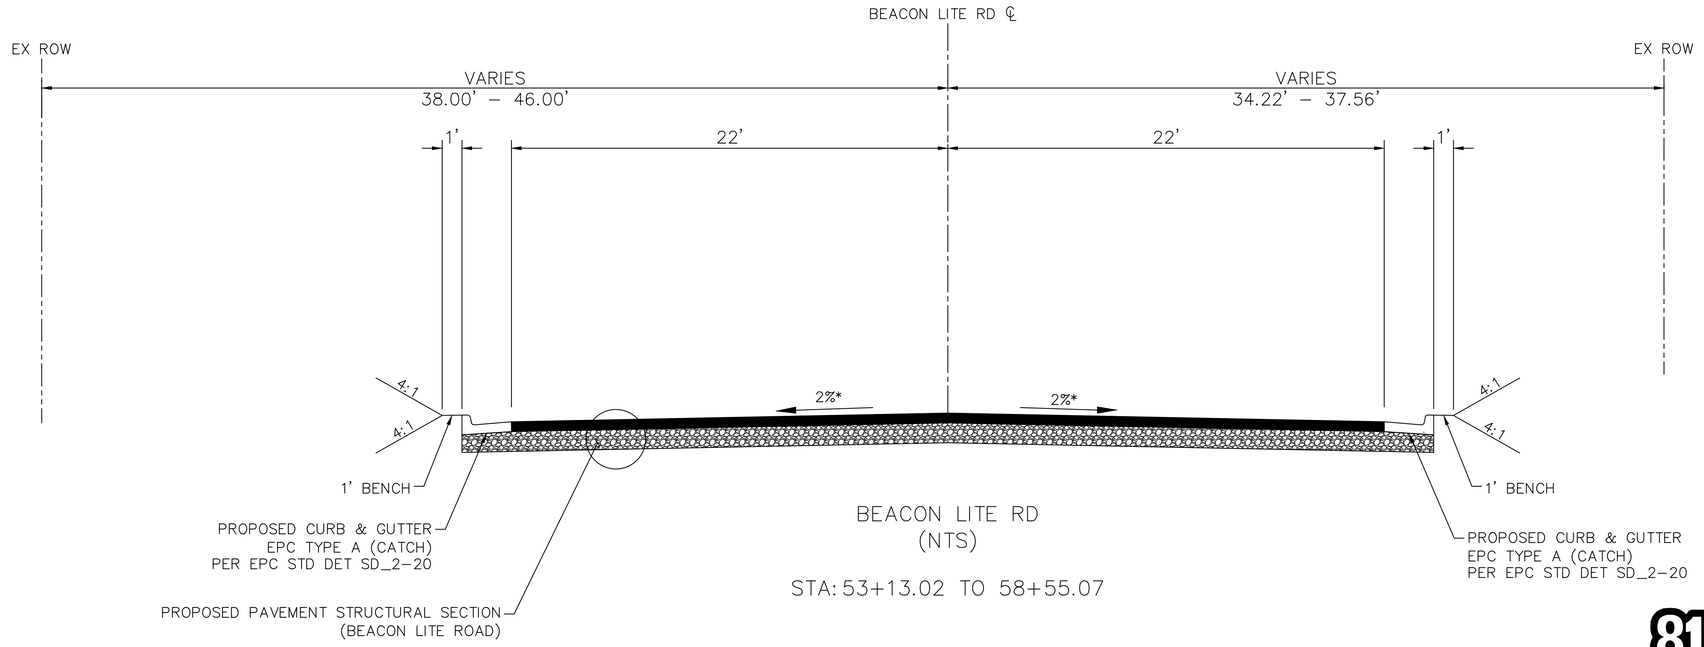

BEACON LITE RD
(NTS)

STA: 53+13.02 TO 58+55.07

*SEE ROADWAY DETAIL SHEETS AND PROFILES FOR CROSS SLOPE TRANSITION INFORMATION.

Know what's **below.**
Call before you dig.

This document, together with the concepts and designs presented herein, as an instrument of service, is intended only for the specific purpose and client for which it was prepared. Reuse of and improper reliance on this document without written authorization and adaptation by Kimley-Horn and Associates, Inc. shall be without liability to Kimley-Horn and Associates, Inc.

Print Date: 5/19/26
Drawing File Name: epc-03_typical sections.dwg

Kimley»Horn
KIMLEY-HORN AND ASSOCIATES, INC.
6200 SOUTH SYRACUSE WAY
SUITE 300
GREENWOOD VILLAGE, COLORADO 80111
(303) 228-2300

Sheet Revisions		
Date:	Comments:	Init.
(R-X)		
(R-X)		
(R-X)		
(R-X)		

EL PASO COUNTY
DEPARTMENT OF PUBLIC WORKS
3275 AKERS DRIVE
COLORADO SPRINGS, CO
80922


FOR REVIEW ONLY
NOT FOR CONSTRUCTION
Kimley»Horn
Kimley-Horn and Associates, Inc.

60% PLANS
No Revisions:
Revised:
Void:


EL PASO COUNTY TRAVEL CENTER
PREPARED FOR
BUC-EE'S, LTD.
TYPICAL SECTIONS

Designer: APW
Detailer: DJC
Checked By: MPF
Structure Numbers
Subset Sheet: 1 of 4


Project No./Code
KH 196094002
Sheet Number 4

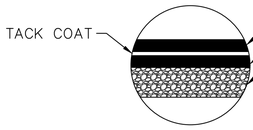


PROPOSED PAVEMENT
STRUCTURAL SECTION
(COUNTY LINE ROAD)

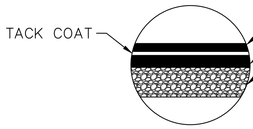


PROPOSED PAVEMENT
STRUCTURAL SECTION
(BEACON LITE ROAD)

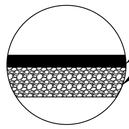


PROPOSED PAVEMENT
STRUCTURAL SECTION
(DRIVEWAYS)

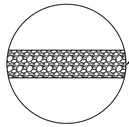

PROPOSED PAVEMENT
STRUCTURAL SECTION
(ACCESS ROAD)

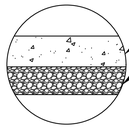


PROPOSED PAVEMENT
STRUCTURAL SECTION
(TRUCK APRON)

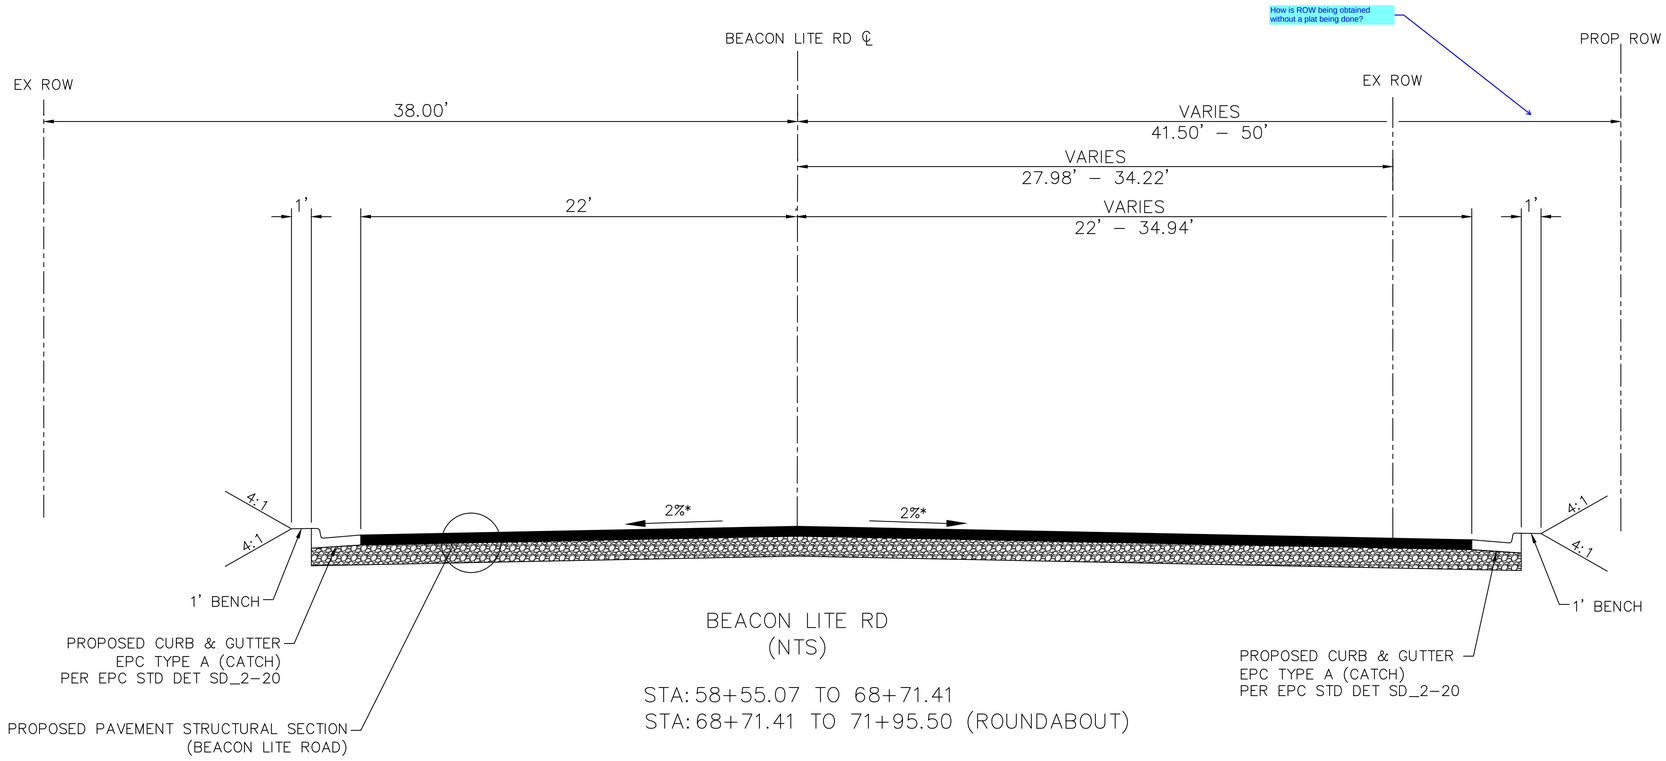

BEACON LITE RD
(NTS)

STA: 58+55.07 TO 68+71.41
STA: 68+71.41 TO 71+95.50 (ROUNDABOUT)

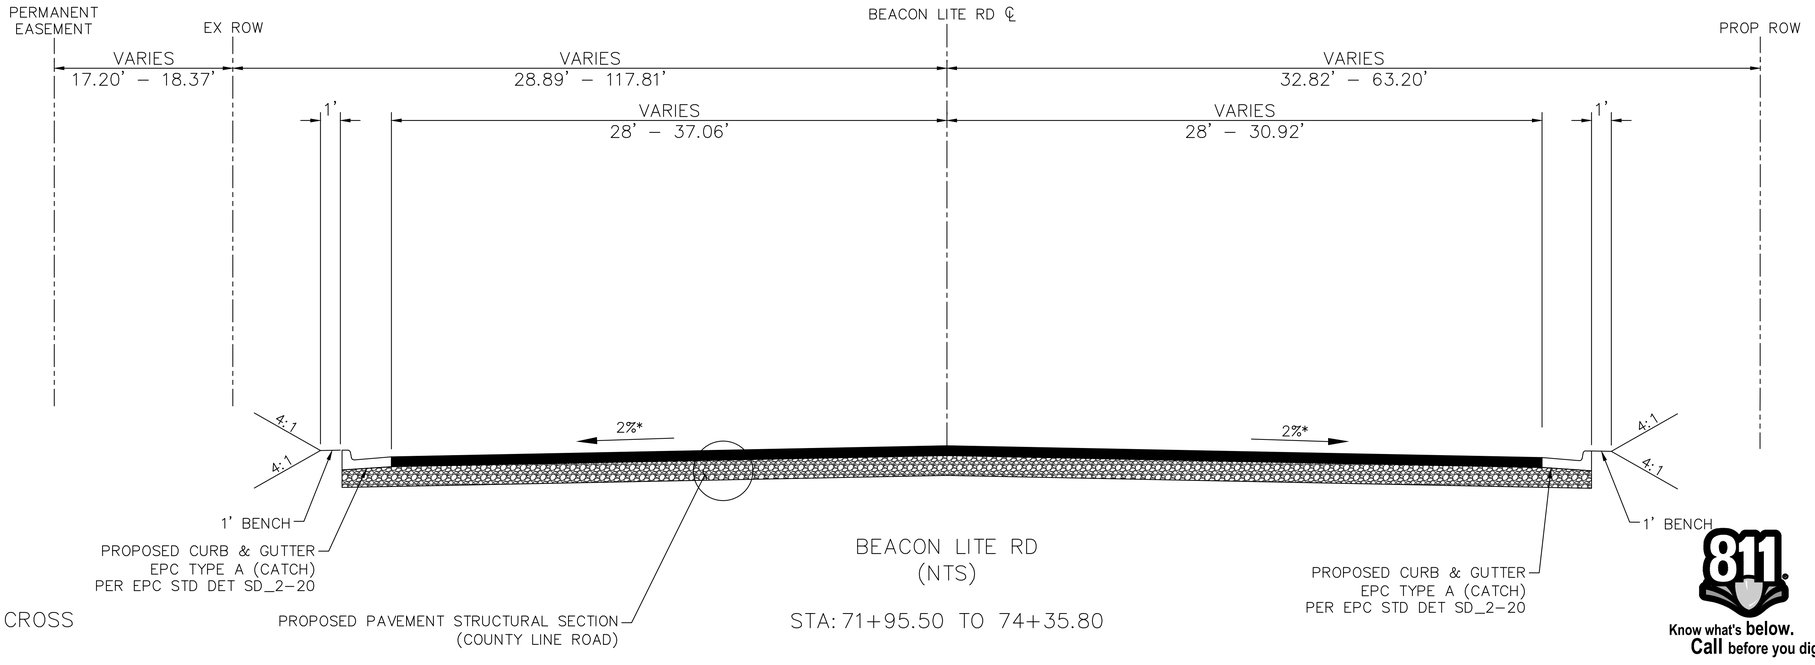

BEACON LITE RD
(NTS)

STA: 71+95.50 TO 74+35.80

*SEE ROADWAY DETAIL SHEETS AND PROFILES FOR CROSS SLOPE TRANSITION INFORMATION.

Know what's **below.**
Call before you dig.

This document, together with the concepts and designs presented herein, as an instrument of service, is intended only for the specific purpose and client for which it was prepared. Reuse of and improper reliance on this document without written authorization and adaptation by Kimley-Horn and Associates, Inc. shall be without liability to Kimley-Horn and Associates, Inc.

Print Date: 5/19/26
Drawing File Name: epc-03_typical sections.dwg

Kimley»Horn
KIMLEY-HORN AND ASSOCIATES, INC.
6200 SOUTH SYRACUSE WAY
SUITE 300
GREENWOOD VILLAGE, COLORADO 80111
(303) 228-2300

	Sheet Revisions		
	Date:	Comments:	Init.
R-X			
R-X			
R-X			
R-X			

EL PASO COUNTY
DEPARTMENT OF PUBLIC WORKS
3275 AKERS DRIVE
COLORADO SPRINGS, CO
80922

FOR REVIEW ONLY
NOT FOR CONSTRUCTION
Kimley»Horn
Kimley-Horn and Associates, Inc.

60% PLANS

No Revisions:
Revised:
Void:


EL PASO COUNTY TRAVEL CENTER
PREPARED FOR
BUC-EE'S, LTD.
TYPICAL SECTIONS

Designer:	APW	Structure Numbers	
Detailer:	DJC		
Checked By:	MPF	Subset Sheet:	2 of 4


Project No./Code

KH 196094002


Sheet Number 5

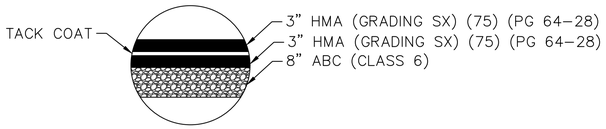


PROPOSED PAVEMENT STRUCTURAL SECTION (COUNTY LINE ROAD)

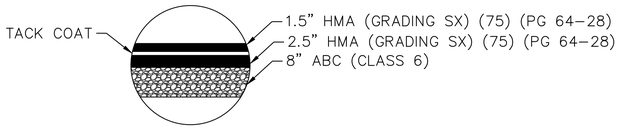


PROPOSED PAVEMENT STRUCTURAL SECTION (BEACON LITE ROAD)

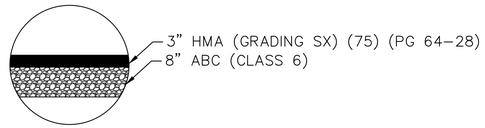


PROPOSED PAVEMENT STRUCTURAL SECTION (DRIVEWAYS)

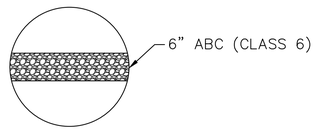

PROPOSED PAVEMENT STRUCTURAL SECTION (ACCESS ROAD)

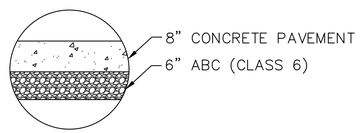


PROPOSED PAVEMENT STRUCTURAL SECTION (TRUCK APRON)

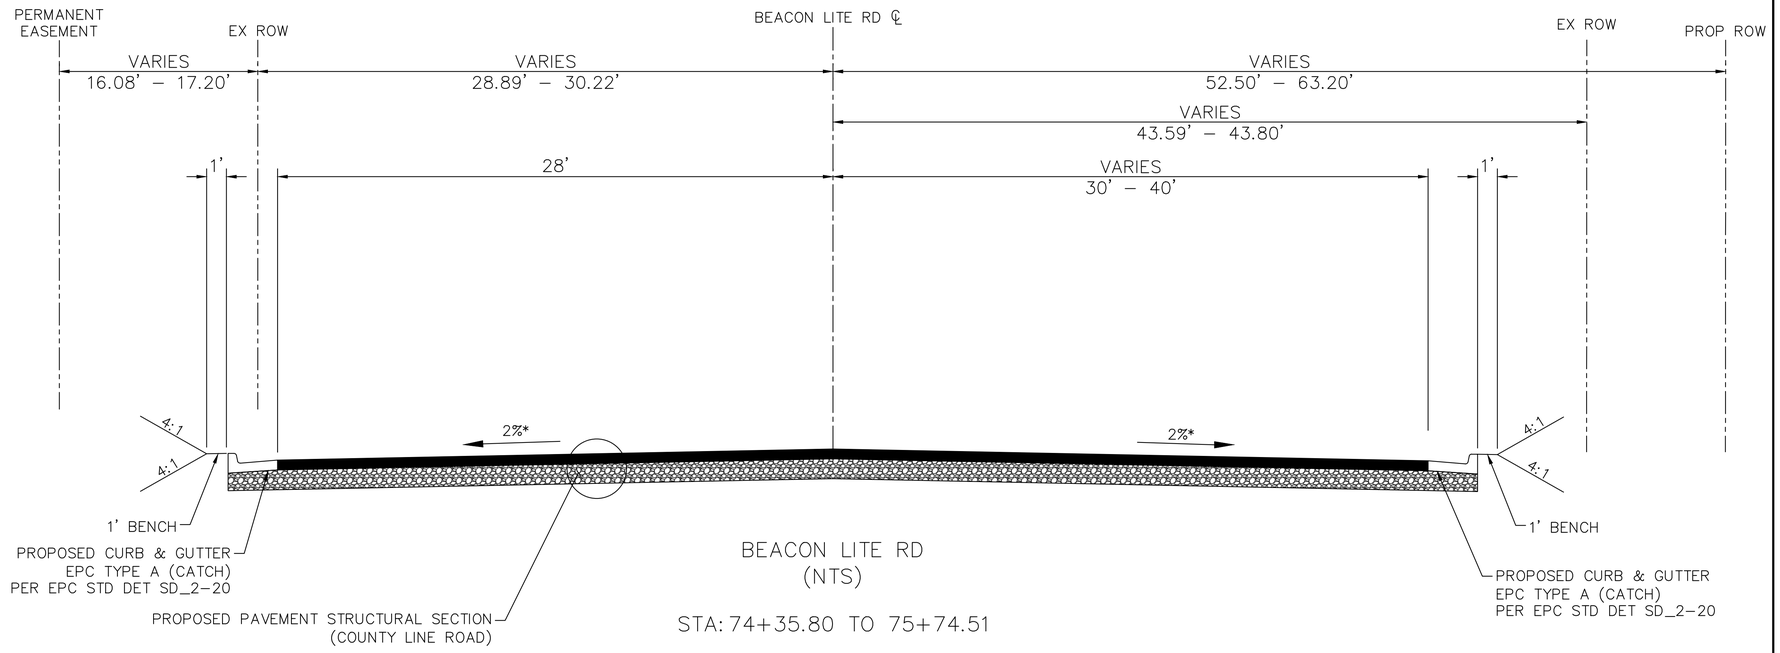

BEACON LITE RD
(NTS)

STA: 74+35.80 TO 75+74.51

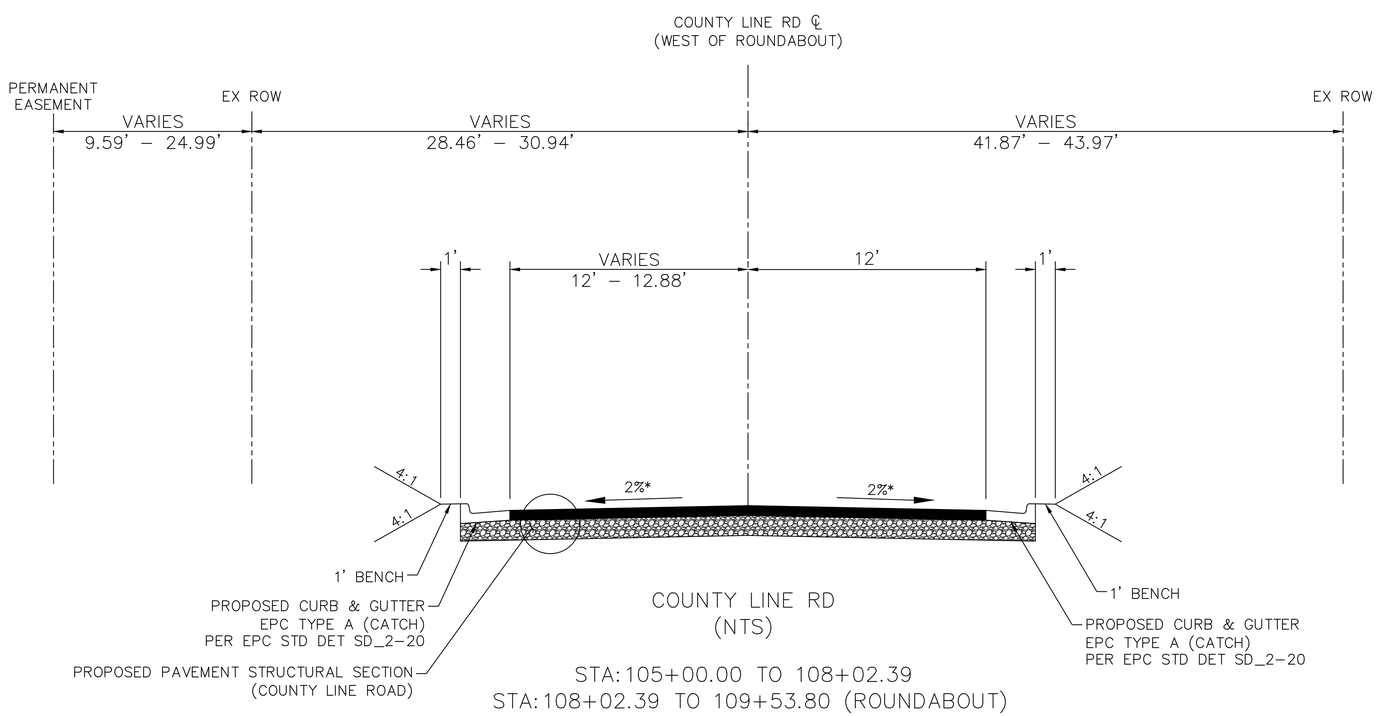

COUNTY LINE RD
(NTS)

STA: 105+00.00 TO 108+02.39
STA: 108+02.39 TO 109+53.80 (ROUNDABOUT)

*SEE ROADWAY DETAIL SHEETS AND PROFILES FOR CROSS SLOPE TRANSITION INFORMATION.

Know what's **below.** **Call** before you dig.

This document, together with the concepts and designs presented herein, as an instrument of service, is intended only for the specific purpose and client for which it was prepared. Reuse of and improper reliance on this document without written authorization and adaptation by Kimley-Horn and Associates, Inc. shall be without liability to Kimley-Horn and Associates, Inc.

Print Date: 5/19/26
Drawing File Name: epc-03_typical sections.dwg

Sheet Revisions		
Date:	Comments:	Init.

(R-X) (R-X) (R-X) (R-X)

Kimley»Horn
KIMLEY-HORN AND ASSOCIATES, INC.
6200 SOUTH SYRACUSE WAY
SUITE 300
GREENWOOD VILLAGE, COLORADO 80111
(303) 228-2300

EL PASO COUNTY
DEPARTMENT OF PUBLIC WORKS
3275 AKERS DRIVE
COLORADO SPRINGS, CO
80922

FOR REVIEW ONLY
NOT FOR CONSTRUCTION
Kimley»Horn
Kimley-Horn and Associates, Inc.

60% PLANS
No Revisions:
Revised:
Void:

EL PASO COUNTY TRAVEL CENTER


PREPARED FOR
BUC-EE'S, LTD.
TYPICAL SECTIONS

Designer:	APW	Structure Numbers	
Detailer:	DJC		
Checked By:	MPF	Subset Sheet:	3 of 4

Project No./Code


KH 196094002

Sheet Number 6

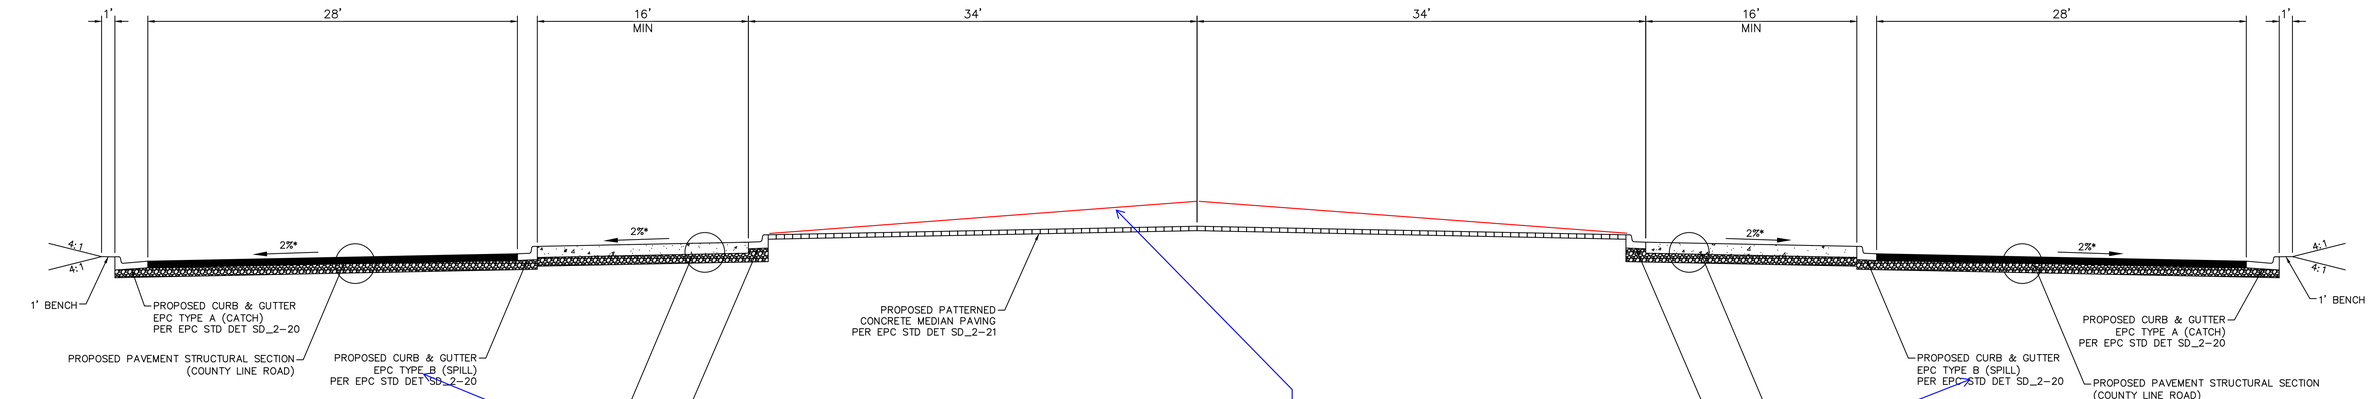

ROUNDABOUT
(NTS)


revise to ramp curb at the truck apron

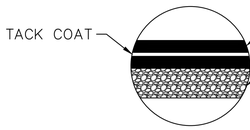


PROPOSED PAVEMENT STRUCTURAL SECTION (COUNTY LINE ROAD)

Are these section for estimating purposes? If so, you should not as such and also include a footnote that final pavement section will be based on the pavement report recommendation.

See ECM Appendix D for Pavement Design Criteria and report requirements.

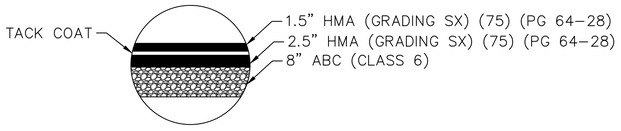

PROPOSED PAVEMENT STRUCTURAL SECTION (BEACON LITE ROAD)

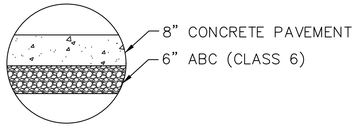

PROPOSED PAVEMENT STRUCTURAL SECTION (TRUCK APRON)

*SEE ROADWAY DETAIL SHEETS AND PROFILES FOR CROSS SLOPE TRANSITION INFORMATION.

Know what's **below.** **Call** before you dig.

This document, together with the concepts and designs presented herein, as an instrument of service, is intended only for the specific purpose and client for which it was prepared. Reuse of and improper reliance on this document without written authorization and adaptation by Kimley-Horn and Associates, Inc. shall be without liability to Kimley-Horn and Associates, Inc.

Print Date: 5/19/26

Drawing File Name: epc-03_typical sections.dwg

Kimley»Horn
KIMLEY-HORN AND ASSOCIATES, INC.
6200 SOUTH SYRACUSE WAY
SUITE 300
GREENWOOD VILLAGE, COLORADO 80111
(303) 228-2300

Sheet Revisions		
Date:	Comments:	Init.
R-X		
R-X		
R-X		
R-X		

EL PASO COUNTY
DEPARTMENT OF PUBLIC WORKS
3275 AKERS DRIVE
COLORADO SPRINGS, CO
80922

R-- FINAL
FOR REVIEW ONLY
NOT FOR CONSTRUCTION
Kimley»Horn
Kimley-Horn and Associates, Inc.

60% PLANS

No Revisions:

Revised:

Void:

EL PASO COUNTY TRAVEL CENTER
PREPARED FOR
BUC-EE'S, LTD.
TYPICAL SECTIONS


Designer:	APW	Structure Numbers	
Detailer:	DJC		
Checked By:	MPF	Subset Sheet:	4 of 4

Project No./Code

KH 196094002

Sheet Number 7

This document, together with the concepts and designs presented herein, as an instrument of service, is intended only for the specific purpose and client for which it was prepared. Reuse of and improper reliance on this document without written authorization and adaptation by Kimley-Horn and Associates, Inc. shall be without liability to Kimley-Horn and Associates, Inc.

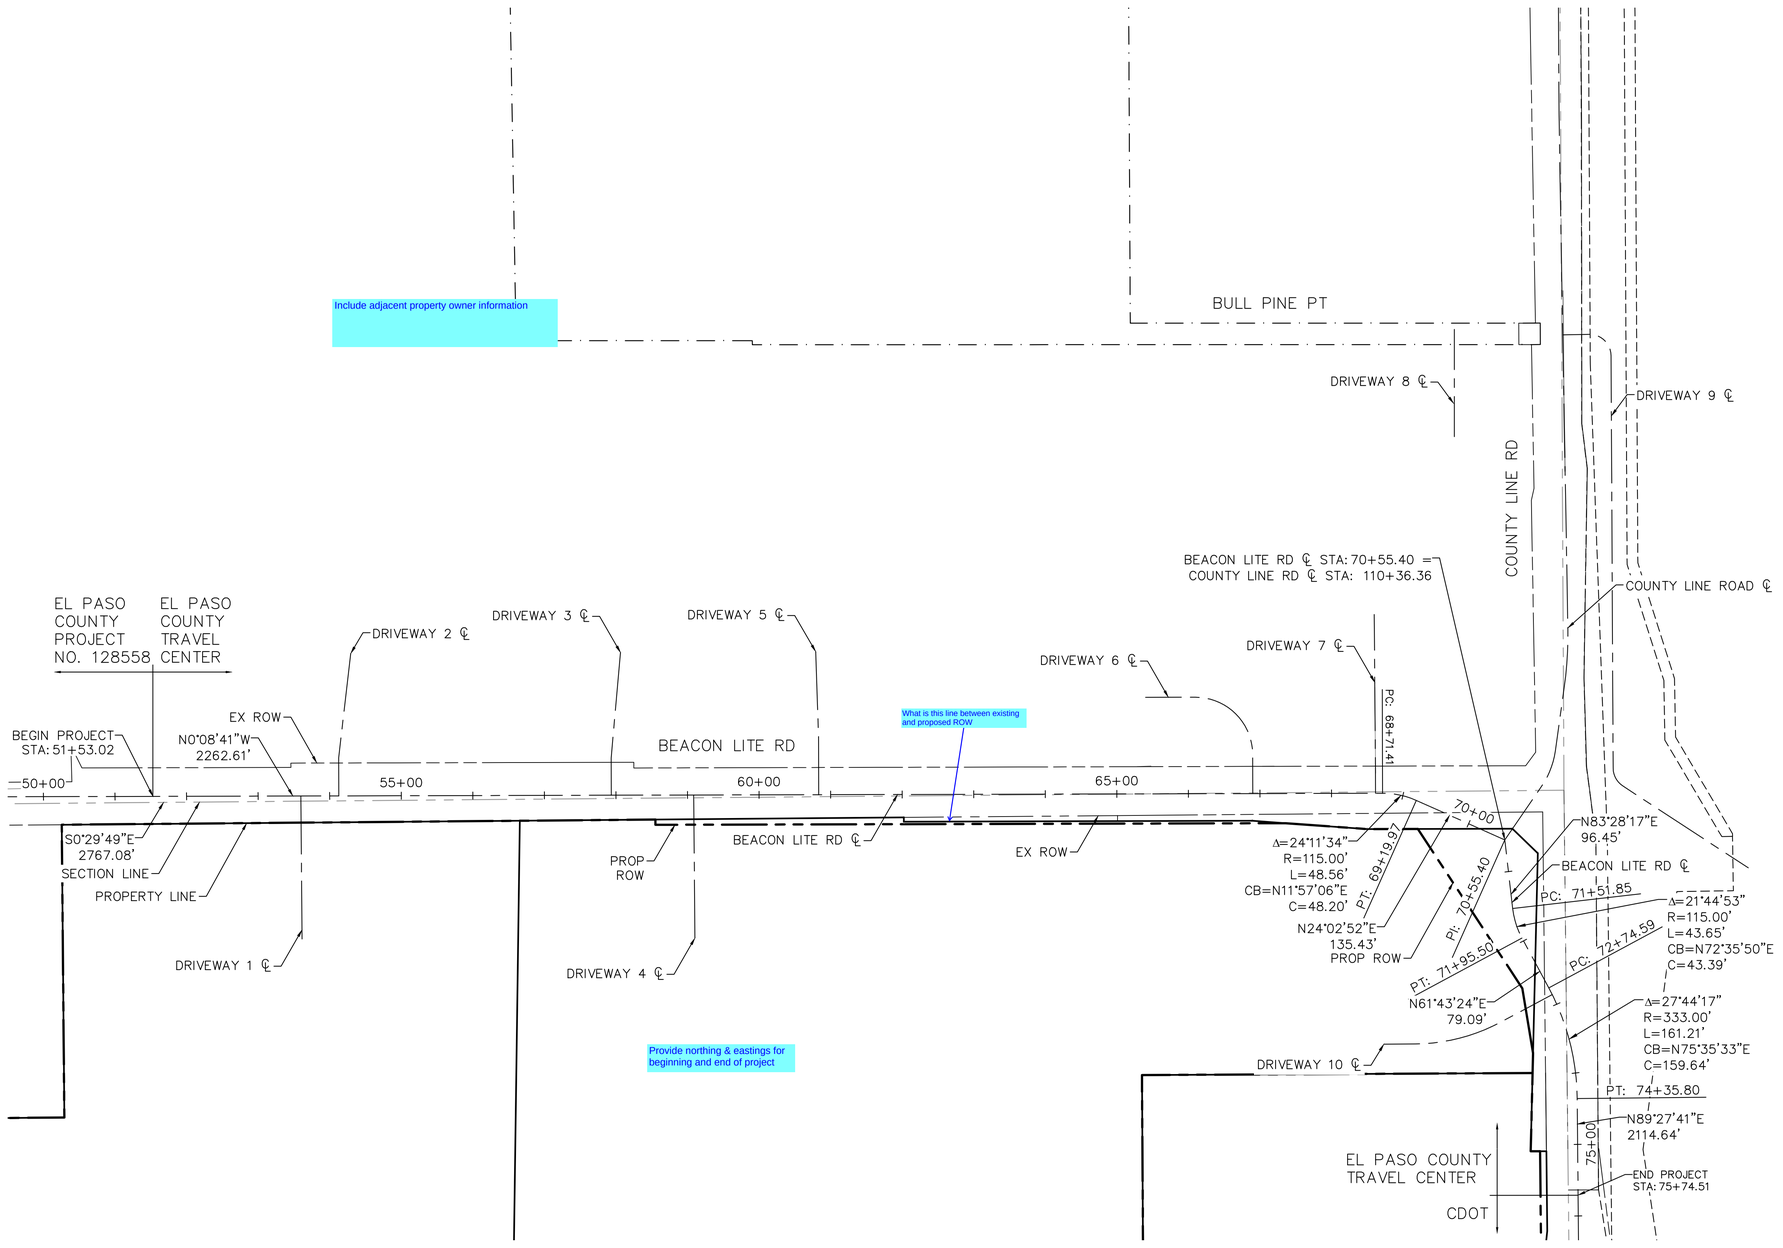

811 Know what's **below.** **Call** before you dig.

Print Date: 5/19/26	Sheet Revisions		
Drawing File Name: epc-04_horizontal control.dwg	Date:	Comments:	Init.
(R-X)			
(R-X)			
(R-X)			
(R-X)			

Kimley»Horn
KIMLEY-HORN AND ASSOCIATES, INC.
6200 SOUTH SYRACUSE WAY
SUITE 300
GREENWOOD VILLAGE, COLORADO 80111
(303) 228-2300

EL PASO COUNTY
DEPARTMENT OF PUBLIC WORKS
3275 AKERS DRIVE
COLORADO SPRINGS, CO
80922

FOR REVIEW ONLY
NOT FOR CONSTRUCTION
Kimley»Horn
Kimley-Horn and Associates, Inc.

60% PLANS

No Revisions:

Revised:

Void:

EL PASO COUNTY TRAVEL CENTER

PREPARED FOR
BUC-EE'S, LTD.


HORIZONTAL CONTROL

Designer:	APW	Structure Numbers	
Detailer:	DJC		
Checked By:	MPF	Subset Sheet:	1 of 3

Project No./Code

KH 196094002

Sheet Number 8

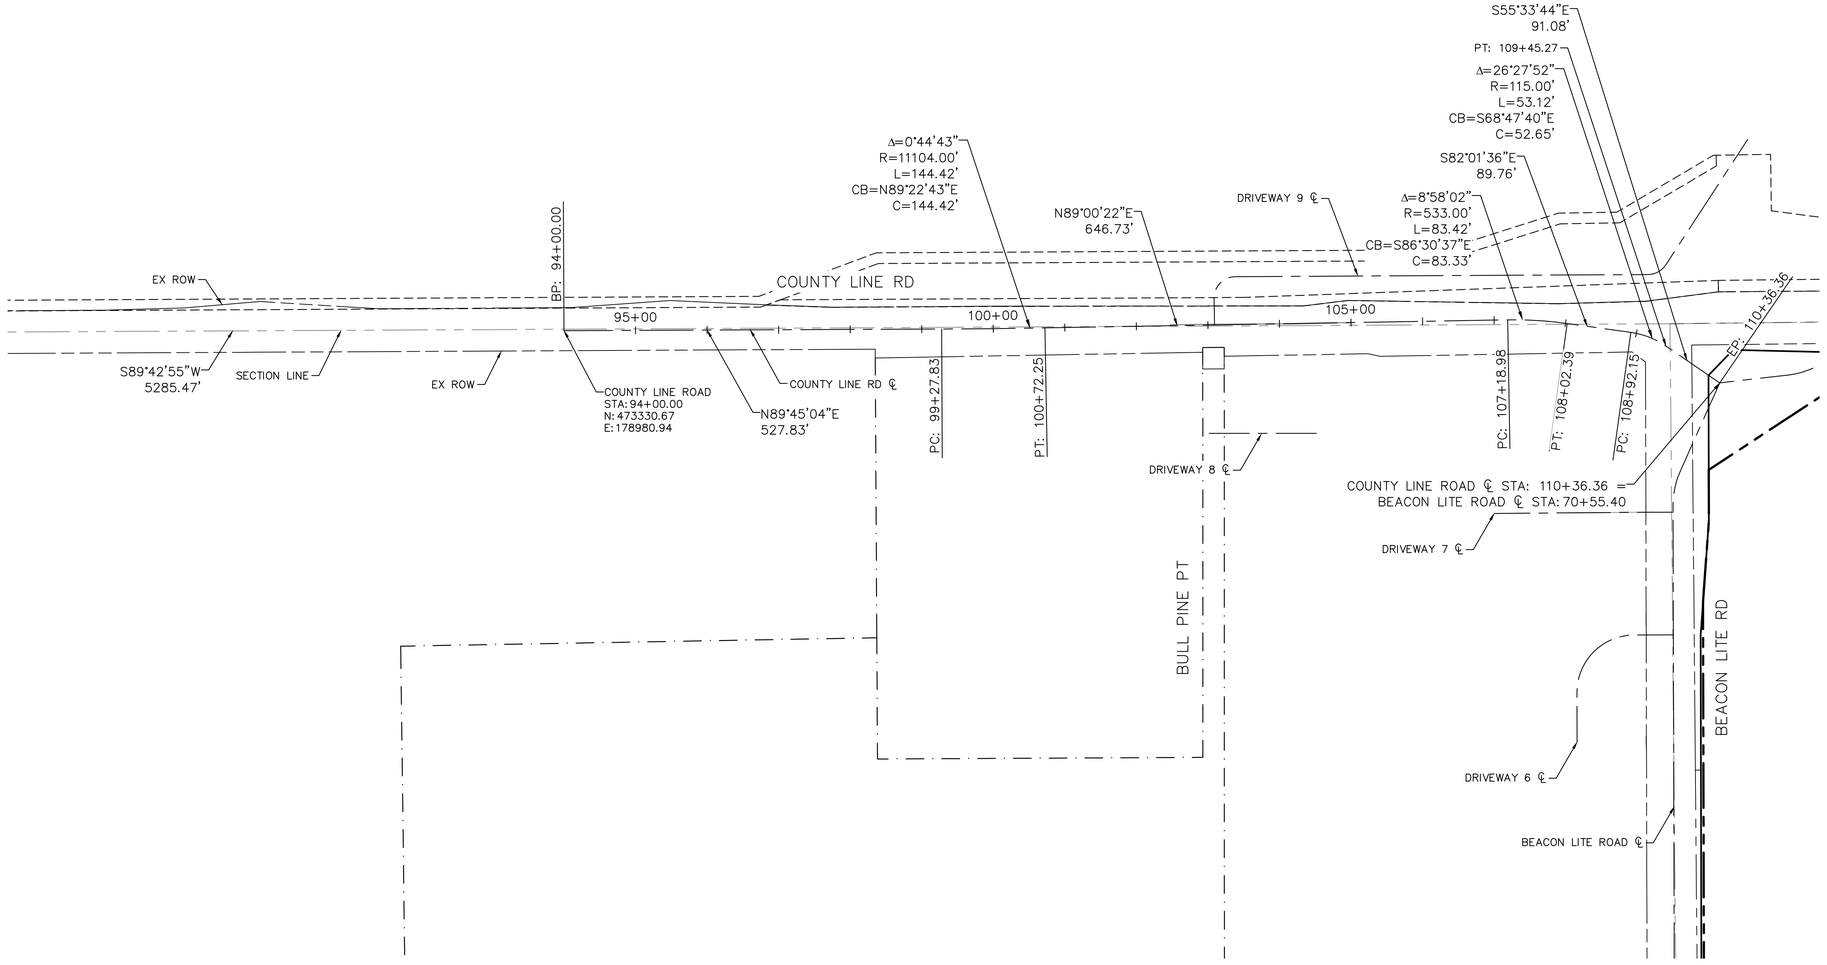

Know what's **below.**
Call before you dig.

This document, together with the concepts and designs presented herein, as an instrument of service, is intended only for the specific purpose and client for which it was prepared. Reuse of and improper reliance on this document without written authorization and adaptation by Kimley-Horn and Associates, Inc. shall be without liability to Kimley-Horn and Associates, Inc.

Print Date: 5/19/26
Drawing File Name: epc-04_horizontal control.dwg

Kimley»Horn
KIMLEY-HORN AND ASSOCIATES, INC.
6200 SOUTH SYRACUSE WAY
SUITE 300
GREENWOOD VILLAGE, COLORADO 80111
(303) 228-2300

	Sheet Revisions		
	Date:	Comments:	Init.
R-X			
R-X			
R-X			
R-X			

EL PASO COUNTY
DEPARTMENT OF PUBLIC WORKS
3275 AKERS DRIVE
COLORADO SPRINGS, CO
80922

FOR REVIEW ONLY
NOT FOR CONSTRUCTION
Kimley»Horn
Kimley-Horn and Associates, Inc.

60% PLANS

No Revisions:
Revised:
Void:

EL PASO COUNTY TRAVEL CENTER

PREPARED FOR
BUC-EE'S, LTD.

HORIZONTAL CONTROL

Designer:	APW	Structure Numbers	
Detailer:	DJC		
Checked By:	MPF	Subset Sheet:	2 of 3

Project No./Code

KH 196094002

Sheet Number 9

This document, together with the concepts and designs presented herein, as an instrument of service, is intended only for the specific purpose and client for which it was prepared. Reuse of and improper reliance on this document without written authorization and adaptation by Kimley-Horn and Associates, Inc. shall be without liability to Kimley-Horn and Associates, Inc.

COUNTY LINE ROAD STA: 108+19.35= WB_LT STA: 0+00.00
COUNTY LINE ROAD STA: 108+19.98= WB_RT_2 STA: 0+00.00
COUNTY LINE ROAD STA: 108+20.01= EB_LT STA: 0+00.00
COUNTY LINE ROAD STA: 108+20.00= EB_RT STA: 0+00.00
COUNTY LINE ROAD STA: 109+65.68= WB_RT_2 STA: 1+54.05
WB_LT
WB_RT_2
S82°25'06"E 135.33'
S82°25'06"E 18.72'
S84°56'03"E 201.01'
S82°01'36"E 58.66'
S71°44'43"E 52.74'
PI: 1+35.33
PC: 2+01.01
PCC: 2+10.32
PT: 2+18.89
PC: 2+71.63
PC: 0+58.86
PCC: 0+70.02
PT: 109+45.27
Δ=7°41'59" R=521.00' L=70.02' CB=S76°14'25"E C=69.96'
Per ECM 2.5.6 the min. raised median width shall be 4 feet. Revise accordingly.
Δ=6°20'02" R=86.00' L=9.51' CB=S81°46'02"E C=9.50'
Δ=6°51'18" R=70.00' L=8.38' CB=S75°10'22"E C=8.37'
Δ=44°34'10" R=3.00' L=2.33' CB=N47°39'48"W C=2.28'
COUNTY LINE RD STA: 109+81.96 NB_RAB STA: 2+59.79
N69°56'53"W 36.19'
PCC: 1+52.10
PC: 1+30.62
PT: 1+54.43
PI: 71+51.85
PI: 71+95.50
PI: 3+29.64
PI: 0+83.44
Δ=41°32'44" R=80.00' L=58.01' CB=N83°51'22"E C=81.38'
Δ=44°15'57" R=108.00' L=83.44' CB=N87°28'55"E C=56.75'
N66°42'33"E 74.15'
N61°43'24"E 61.04'
BEACON LITE ROAD STA: 72+80.00= WB_LT STA: 4+03.79
PC: 1+44.48
Δ=0°55'51" R=340.00' L=5.52' CB=N62°11'20"E C=5.52'
BEACON LITE ROAD STA: 72+80.00= WB_RT_1 STA: 1+50.00
WB_RT_1
COUNTY LINE RD
BEACON LITE ROAD STA: 72+79.78= NB_RT_2 STA: 1+64.79
Δ=0°27'55" R=326.00' L=2.65' CB=N62°25'18"E C=2.65'
PC: 1+62.35
PC: 4+47.12
BEACON LITE ROAD STA: 72+80.00= NB_RT STA: 4+64.24
Δ=3°13'03" R=305.00' L=17.13' CB=N61°02'44"E C=17.12'
N62°11'20"E 162.35'
N59°26'13"E 173.42'
BEACON LITE ROAD STA: 71+27.26= WB_RT_1 STA: 0+00.00
NB_LT_2
BEACON LITE RD STA: 71+15.36 NB_RAB STA: 1+25.39
BEACON LITE ROAD STA: 71+21.70= NB_RT_2 STA: 0+00.00
extend concrete pan as far as possible (all splitter islands facing the roundabout)
Δ=81°55'52" R=58.00' L=82.94' CB=N15°35'12"E C=76.05'
ROUNDABOUT
PI: 2+73.70
PC: 2+47.96
PT: 2+02.58
Δ=5°53'57" R=250.00' L=25.74' CB=N56°29'14"E C=25.73'
N55°07'11"E 43.47'
N53°32'15"E 45.38'
Δ=7°21'01" R=74.00' L=9.49' CB=S81°57'18"E C=9.49'
BEACON LITE ROAD STA: 69+76.56= NB_LT_1 STA: 2+25.00
Δ=53°14'23" R=80.00' L=74.34' CB=N26°55'04"E C=71.69'
Δ=46°49'37" R=108.00' L=88.27' CB=N28°00'04"E C=85.83'
Additional review of the roundabout design including fastest path, autoturn exhibits etc. will be provided. Refer to the TIS for comments that affect the design of the roundabout.
Δ=73°19'50" R=60.00' L=76.79' CB=S35°43'31"E C=71.66'
Δ=59°06'29" R=78.00' L=80.47' CB=S52°28'22"E C=76.95'
COUNTY LINE ROAD STA: 109+59.23= EB_LT STA: 1+39.13
PRC: 1+46.81
PT: 1+48.44
EB_LT
COUNTY LINE RD ℄
BEACON LITE RD ℄
PI: 70+55.40
EP: 110+36.36
PI: 1+54.43
PC: 0+69.16
Δ=39°15'00" R=3.00' L=2.06' CB=N74°44'41"E C=2.02'
Δ=174°16'22" R=58.00' L=176.42' CB=S22°54'56"W C=115.86'
BEACON LITE RD STA: 69+89.64 NB_RAB STA: 3+67.04
BEACON LITE RD ℄ STA: 70+55.40 COUNTY LINE RD ℄ STA: 110+36.36
BEACON LITE RD ℄
EB_RT
PCC: 0+14.14
PCC: 0+23.64
NB_RT
S0°08'41"E 282.83'
BEACON LITE ROAD STA: 69+84.76= SB_RT STA: 2+40.15
SB_RT
NB_LT_1
PI: 0+25.69
N0°08'41"W 120.00'
BEACON LITE RD
PI: 69+19.97
PC: 1+36.73
PC: 1+28.24
PC: 68+71.41
PI: 1+20.15
N4°35'16"E 16.58'
N0°17'52"E 128.24'
N2°43'03"E 120.15'
BEACON LITE ROAD STA: 67+51.41= SB_RT STA: 0+00.00
BEACON LITE ROAD STA: 67+51.41= EB_RT STA: 4+31.26
BEACON LITE ROAD STA: 67+51.41= NB_LT_1 STA: 0+00.00
BEACON LITE ROAD STA: 67+51.41= NB_RT STA: 0+00.00
EP: 4+31.26
BP: 0+00.00
BP: 0+00.00

COUNTY LINE RD
BEACON LITE RD
I-25
NORTH


Will be reviewed when full roundabout design report has been provided

NORTH
GRAPHIC SCALE IN FEET 0 10 20 40

811 Know what's below. Call before you dig.

Print Date: 5/19/26		Sheet Revisions			EL PASO COUNTY COLORADO EST. 1861 EL PASO COUNTY DEPARTMENT OF PUBLIC WORKS 3275 AKERS DRIVE COLORADO SPRINGS, CO 80922	FOR REVIEW ONLY NOT FOR CONSTRUCTION Kimley»Horn Kimley-Horn and Associates, Inc.	60% PLANS
Drawing File Name: epc-06_roundabout detail 1.dwg		Date:	Comments:	Init.			No Revisions:
Kimley»Horn KIMLEY-HORN AND ASSOCIATES, INC. 6200 SOUTH SYRACUSE WAY SUITE 300 GREENWOOD VILLAGE, COLORADO 80111 (303) 228-2300	R-X						Revised:
	R-X						Void:
	R-X						
	R-X						

EL PASO COUNTY TRAVEL CENTER PREPARED FOR BUC-EE'S, LTD. ROUNDABOUT HORIZONTAL CONTROL			Project No./Code
Designer: APW	Structure Numbers		KH 196094002
Detailer: DJC			
Checked By: MPF	Subset Sheet:	3 of 3	Sheet Number 10

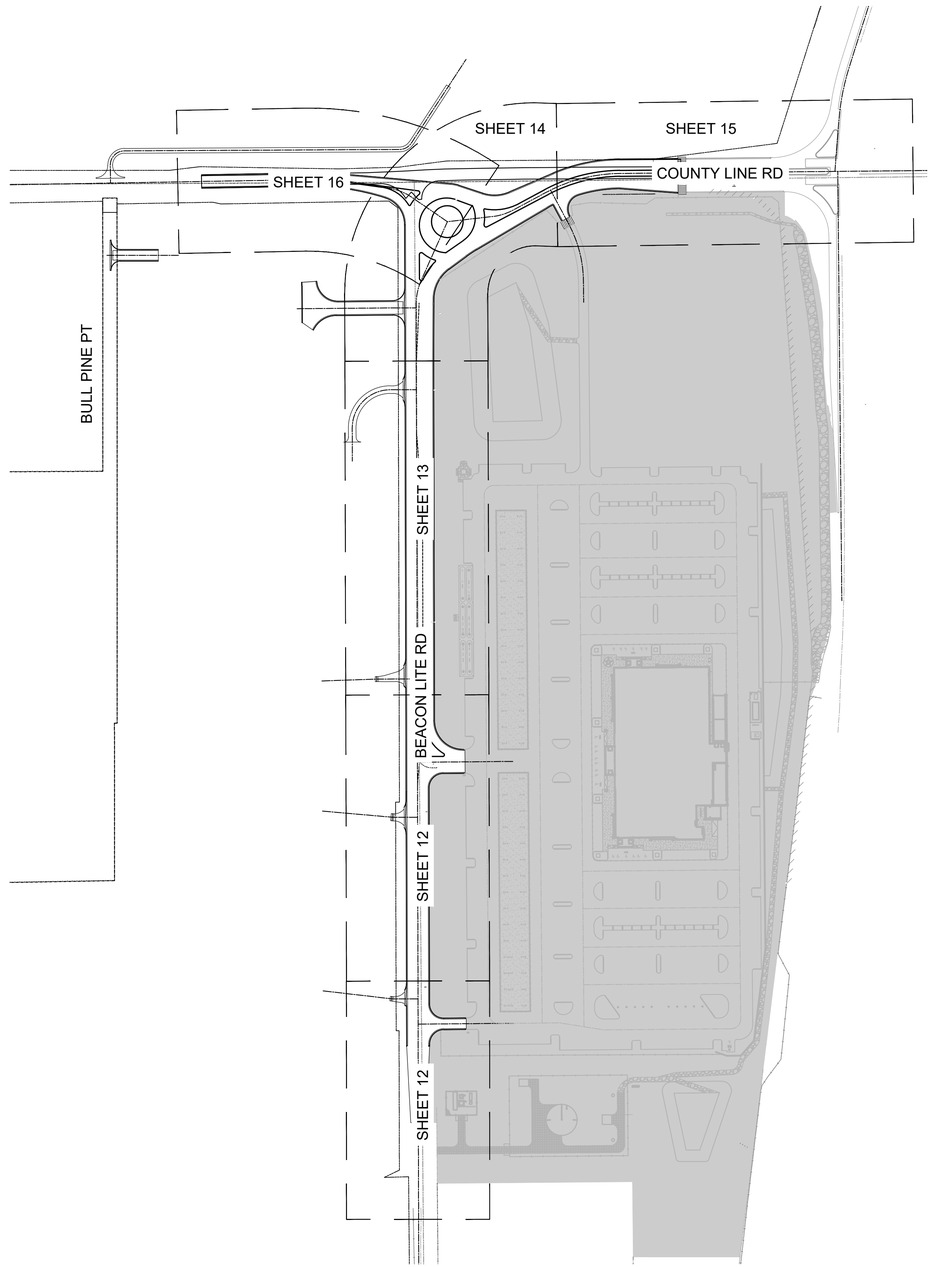

LEGEND:

ONSITE HATCH

NORTH

GRAPHIC SCALE IN FEET
0 75 150 300

811
Know what's **below.**
Call before you dig.

This document, together with the concepts and designs presented herein, as an instrument of service, is intended only for the specific purpose and client for which it was prepared. Reuse of and improper reliance on this document without written authorization and adaptation by Kimley-Horn and Associates, Inc. shall be without liability to Kimley-Horn and Associates, Inc.

Print Date: 5/19/26

Drawing File Name: epc-05_ removals (km).dwg

Kimley»Horn
KIMLEY-HORN AND ASSOCIATES, INC.
6200 SOUTH SYRACUSE WAY
SUITE 300
GREENWOOD VILLAGE, COLORADO 80111
(303) 228-2300

	Sheet Revisions		
	Date:	Comments:	Init.
R-X			
R-X			
R-X			
R-X			

EL PASO COUNTY
DEPARTMENT OF PUBLIC WORKS
3275 AKERS DRIVE
COLORADO SPRINGS, CO
80922

FOR REVIEW ONLY
NOT FOR CONSTRUCTION
Kimley»Horn
Kimley-Horn and Associates, Inc.

60% PLANS

No Revisions:

Revised:

Void:

EL PASO COUNTY TRAVEL CENTER
PREPARED FOR
BUC-EE'S, LTD.
REMOVALS

Designer:	APW	Structure Numbers	
Detailer:	DJC		
Checked By:	MPF	Subset Sheet:	1 of 6


Project No./Code


KH 196094002


Sheet Number 11

Show the Town of Monument City Limits.

Removal plans should not include proposed items.
Removed items should be easliy discernible

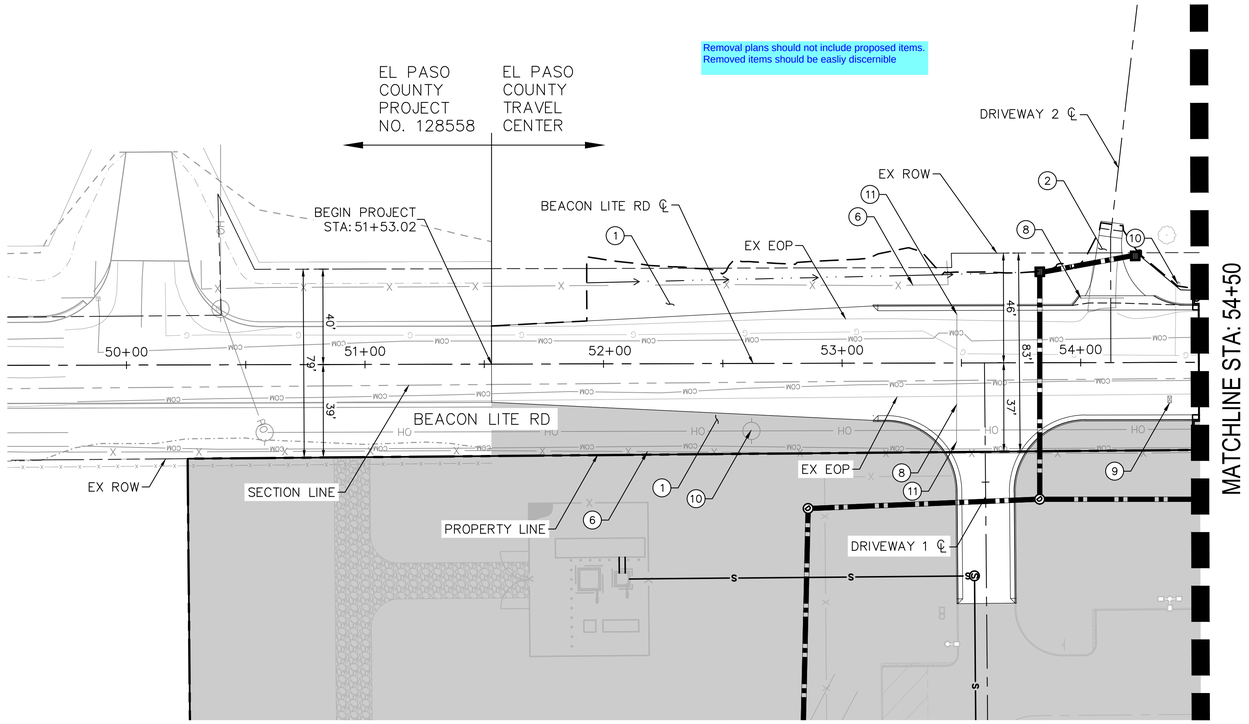

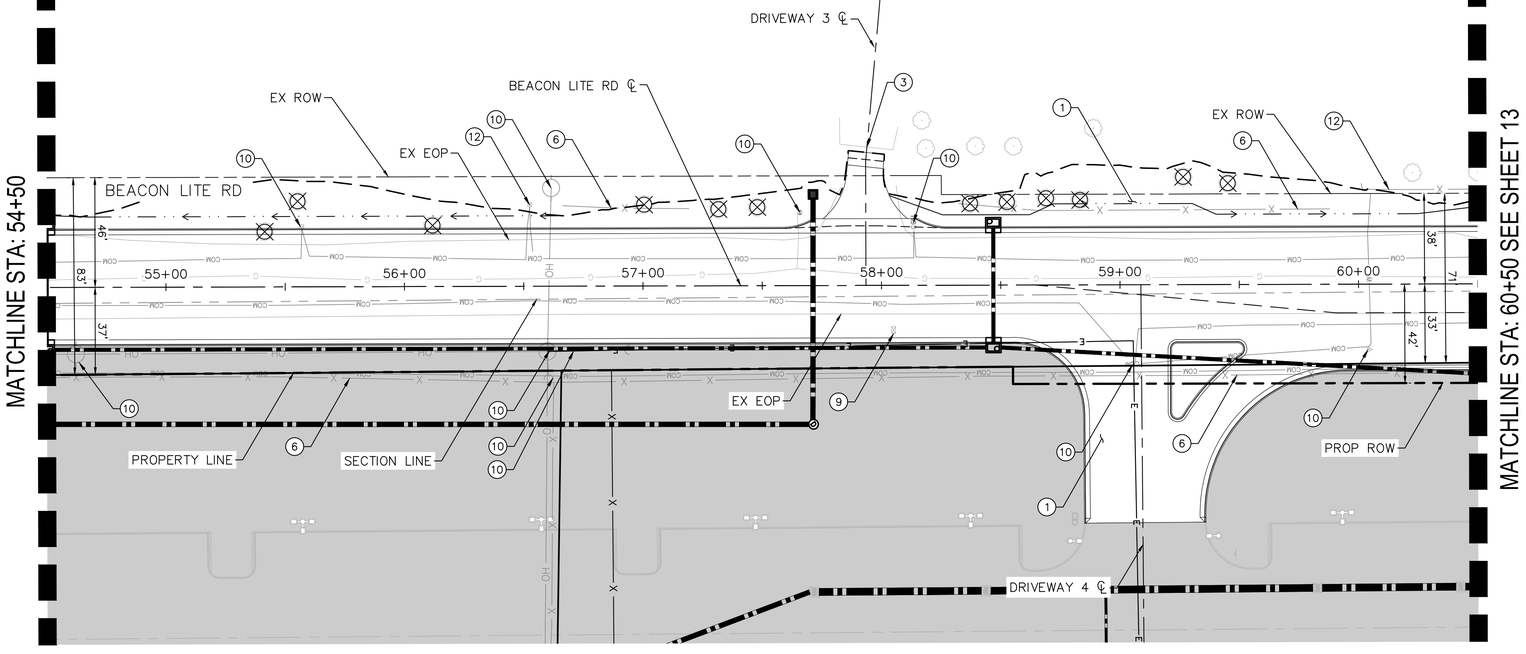

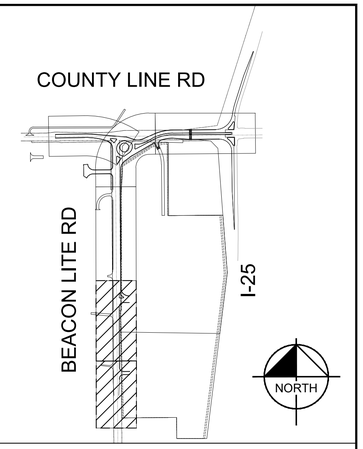

LEGEND:

- GRADING LIMIT
- ASPHALT REMOVAL
- ONSITE HATCH
- CROWN TRANSITION LINE

REMOVAL NOTES:

1. CLEARING AND GRUBBING
2. REMOVE ASPHALT
3. REMOVE GATE, REPLACE IN KIND
4. REMOVE CURB AND GUTTER
5. REMOVE SIGN
6. REMOVE FENCE, REPLACE IN KIND
7. REMOVE RIPRAP
8. REMOVE STORM DRAIN
9. REMOVE MAILBOX
10. PRIVATE UTILITY, RELOCATE BY OTHERS
11. REMOVE END SECTION
12. PROTECT IN PLACE
13. REMOVE TREE ⊗
14. RESET SIGN
15. RESET LIGHT POLE

NORTH

GRAPHIC SCALE IN FEET
0 15 30 60

811 Know what's below. Call before you dig.

This document, together with the concepts and designs presented herein, as an instrument of service, is intended only for the specific purpose and client for which it was prepared. Reuse of and improper reliance on this document without written authorization and adaptation by Kimley-Horn and Associates, Inc. shall be without liability to Kimley-Horn and Associates, Inc.

Print Date: 5/19/26
Drawing File Name: epc-05_removals.dwg

Kimley»Horn
KIMLEY-HORN AND ASSOCIATES, INC.
6200 SOUTH SYRACUSE WAY
SUITE 300
GREENWOOD VILLAGE, COLORADO 80111
(303) 228-2300

	Sheet Revisions		
	Date:	Comments:	Init.
R-X			
R-X			
R-X			
R-X			

EL PASO COUNTY
DEPARTMENT OF PUBLIC WORKS
3275 AKERS DRIVE
COLORADO SPRINGS, CO
80922


R-- FINAL
FOR REVIEW ONLY
NOT FOR CONSTRUCTION
Kimley»Horn
Kimley-Horn and Associates, Inc.


60% PLANS
No Revisions:
Revised:
Void:

EL PASO COUNTY TRAVEL CENTER
PREPARED FOR
BUC-EE'S, LTD.
REMOVALS

Designer:	APW	Structure Numbers	
Detailer:	DJC		
Checked By:	MPF	Subset Sheet:	2 of 6

Project No./Code
KH 196094002
Sheet Number 12

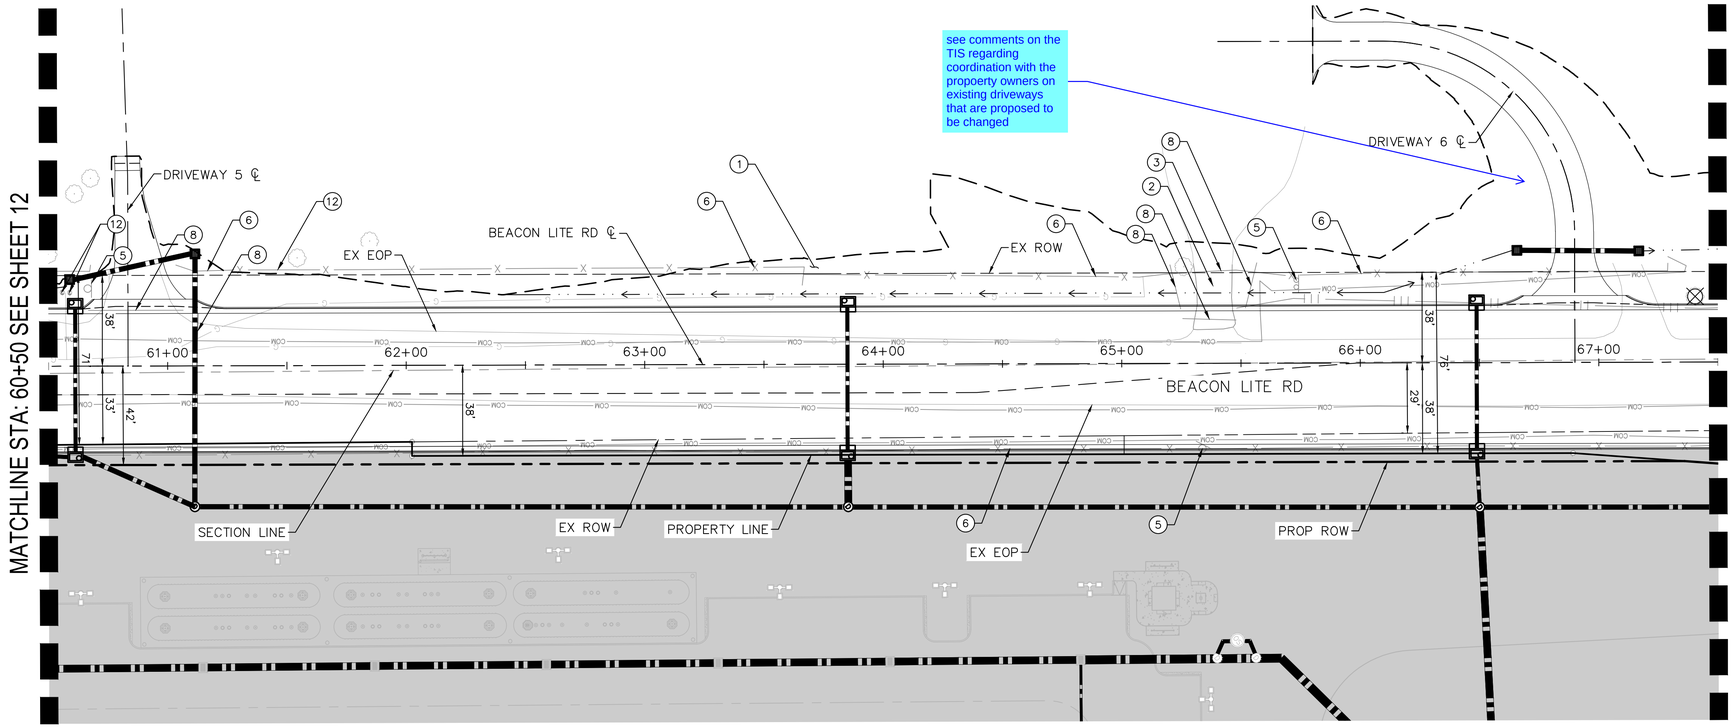

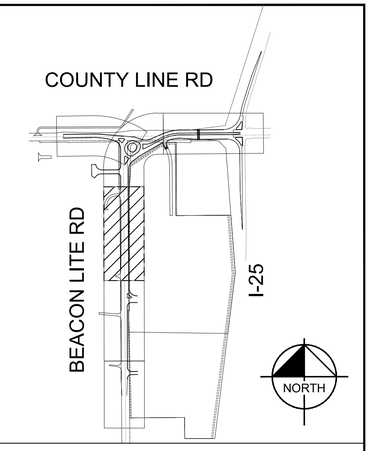

LEGEND:

- GRADING LIMIT
- ASPHALT REMOVAL
- ONSITE HATCH
- CROWN TRANSITION LINE

REMOVAL NOTES:

1. CLEARING AND GRUBBING
2. REMOVE ASPHALT
3. REMOVE GATE, REPLACE IN KIND
4. REMOVE CURB AND GUTTER
5. REMOVE SIGN
6. REMOVE FENCE, REPLACE IN KIND
7. REMOVE RIPRAP
8. REMOVE STORM DRAIN
9. REMOVE MAILBOX
10. PRIVATE UTILITY, RELOCATE BY OTHERS
11. REMOVE END SECTION
12. PROTECT IN PLACE
13. REMOVE TREE
14. RESET SIGN
15. RESET LIGHT POLE

NORTH

GRAPHIC SCALE IN FEET
0 15 30 60

811 Know what's **below.** **Call** before you dig.

This document, together with the concepts and designs presented herein, as an instrument of service, is intended only for the specific purpose and client for which it was prepared. Reuse of and improper reliance on this document without written authorization and adaptation by Kimley-Horn and Associates, Inc. shall be without liability to Kimley-Horn and Associates, Inc.

Print Date: 5/19/26
Drawing File Name: epc-05_removals.dwg

Kimley»Horn
KIMLEY-HORN AND ASSOCIATES, INC.
6200 SOUTH SYRACUSE WAY
SUITE 300
GREENWOOD VILLAGE, COLORADO 80111
(303) 228-2300

	Sheet Revisions		
	Date:	Comments:	Init.
R-X			
R-X			
R-X			
R-X			

EL PASO COUNTY
DEPARTMENT OF PUBLIC WORKS
3275 AKERS DRIVE
COLORADO SPRINGS, CO
80922

FOR REVIEW ONLY
NOT FOR CONSTRUCTION
Kimley»Horn
Kimley-Horn and Associates, Inc.

60% PLANS

No Revisions:
Revised:
Void:


EL PASO COUNTY TRAVEL CENTER
PREPARED FOR
BUC-EE'S, LTD.
REMOVALS


Designer:	APW	Structure Numbers	
Detailer:	DJC		
Checked By:	MPF	Subset Sheet:	3 of 6

Project No./Code

KH 196094002

Sheet Number 13

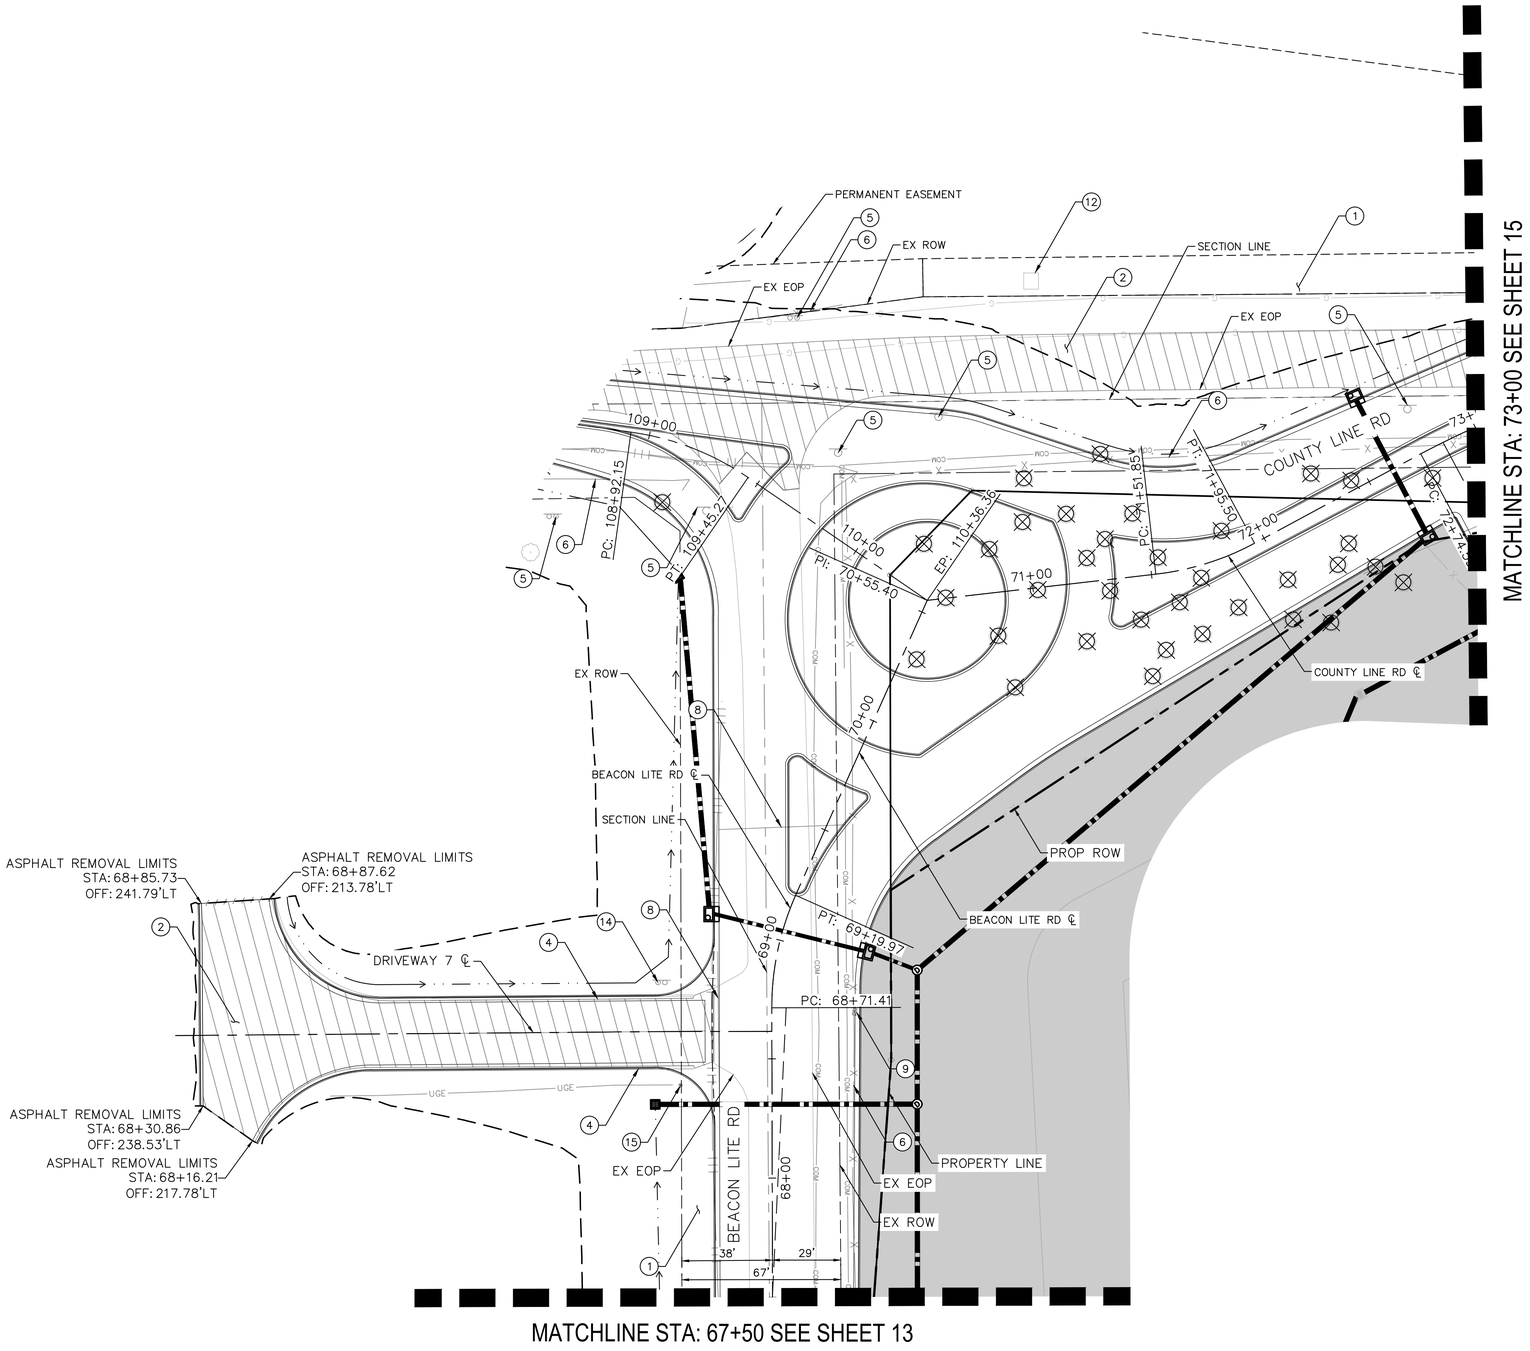

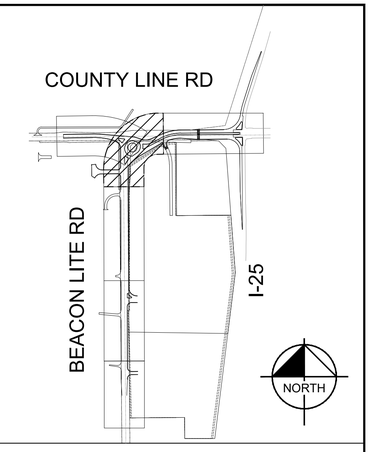

LEGEND:

- GRADING LIMIT
- ASPHALT REMOVAL
- ONSITE HATCH
- CROWN TRANSITION LINE

REMOVAL NOTES:

1. CLEARING AND GRUBBING
2. REMOVE ASPHALT
3. REMOVE GATE, REPLACE IN KIND
4. REMOVE CURB AND GUTTER
5. REMOVE SIGN
6. REMOVE FENCE, REPLACE IN KIND
7. REMOVE RIPRAP
8. REMOVE STORM DRAIN
9. REMOVE MAILBOX
10. PRIVATE UTILITY, RELOCATE BY OTHERS
11. REMOVE END SECTION
12. PROTECT IN PLACE
13. REMOVE TREE
14. RESET SIGN
15. RESET LIGHT POLE

NORTH

GRAPHIC SCALE IN FEET
0 15 30 60

811 Know what's **below.** **Call** before you dig.

This document, together with the concepts and designs presented herein, as an instrument of service, is intended only for the specific purpose and client for which it was prepared. Reuse of and improper reliance on this document without written authorization and adaptation by Kimley-Horn and Associates, Inc. shall be without liability to Kimley-Horn and Associates, Inc.

Print Date: 5/19/26

Drawing File Name: epc-05_removals.dwg

Kimley»Horn
KIMLEY-HORN AND ASSOCIATES, INC.
6200 SOUTH SYRACUSE WAY
SUITE 300
GREENWOOD VILLAGE, COLORADO 80111
(303) 228-2300

	Sheet Revisions		
	Date:	Comments:	Init.
R-X			
R-X			
R-X			
R-X			

EL PASO COUNTY
DEPARTMENT OF PUBLIC WORKS
3275 AKERS DRIVE
COLORADO SPRINGS, CO
80922

R-- FINAL
FOR REVIEW ONLY
NOT FOR
CONSTRUCTION
Kimley»Horn
Kimley-Horn and Associates, Inc.

60% PLANS

No Revisions:

Revised:

Void:

EL PASO COUNTY TRAVEL CENTER
PREPARED FOR
BUC-EE'S, LTD.
REMOVALS

Designer: APW
Detailer: DJC
Checked By: MPF


Structure Numbers:


Subset Sheet: 4 of 6

Project No./Code

KH 196094002

Sheet Number 14

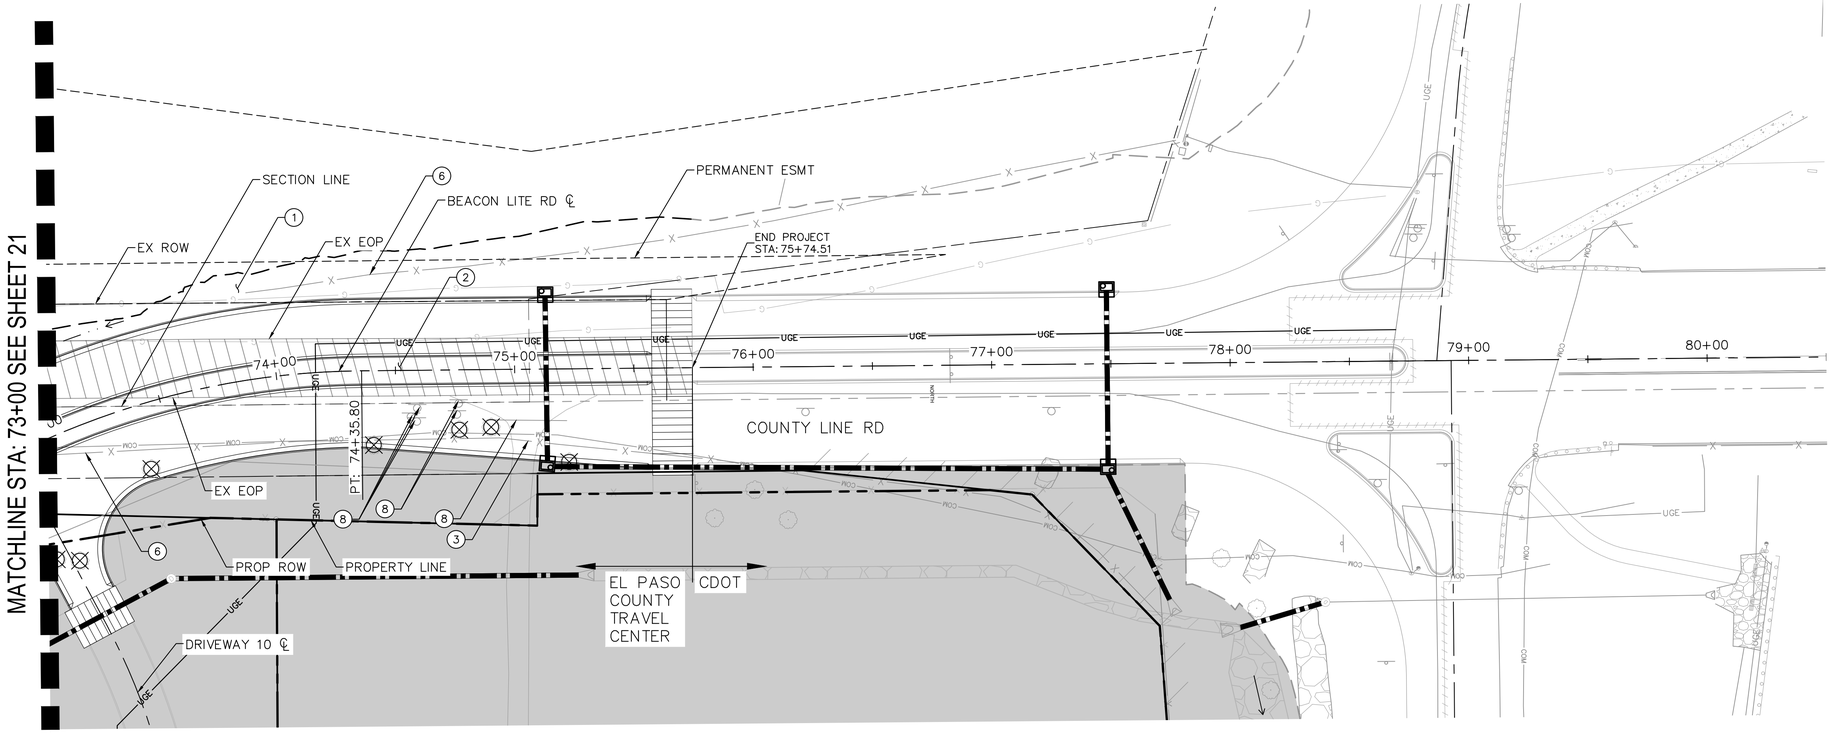

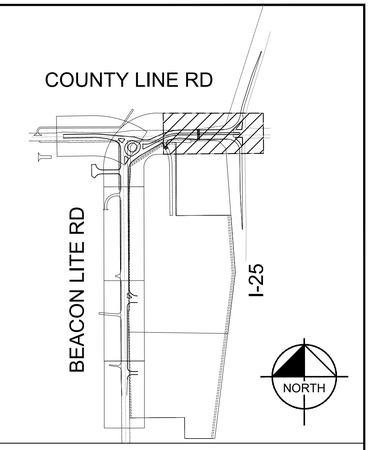

LEGEND:

- GRADING LIMIT
- ASPHALT REMOVAL
- ONSITE HATCH
- CROWN TRANSITION LINE

REMOVAL NOTES:

1. CLEARING AND GRUBBING
2. REMOVE ASPHALT
3. REMOVE GATE, REPLACE IN KIND
4. REMOVE CURB AND GUTTER
5. REMOVE SIGN
6. REMOVE FENCE, REPLACE IN KIND
7. REMOVE RIPRAP
8. REMOVE STORM DRAIN
9. REMOVE MAILBOX
10. PRIVATE UTILITY, RELOCATE BY OTHERS
11. REMOVE END SECTION
12. PROTECT IN PLACE
13. REMOVE TREE ⊠
14. RESET SIGN
15. RESET LIGHT POLE

NORTH

GRAPHIC SCALE IN FEET
0 15 30 60

811 Know what's **below.** **Call** before you dig.

This document, together with the concepts and designs presented herein, as an instrument of service, is intended only for the specific purpose and client for which it was prepared. Reuse of and improper reliance on this document without written authorization and adaptation by Kimley-Horn and Associates, Inc. shall be without liability to Kimley-Horn and Associates, Inc.

Print Date: 5/19/26

Drawing File Name: epc-05_removals.dwg

Kimley»Horn
KIMLEY-HORN AND ASSOCIATES, INC.
6200 SOUTH SYRACUSE WAY
SUITE 300
GREENWOOD VILLAGE, COLORADO 80111
(303) 228-2300

	Sheet Revisions		
	Date:	Comments:	Init.
R-X			
R-X			
R-X			
R-X			

EL PASO COUNTY
DEPARTMENT OF PUBLIC WORKS
3275 AKERS DRIVE
COLORADO Ssprings, CO
80922

FOR REVIEW ONLY
NOT FOR CONSTRUCTION
Kimley»Horn
Kimley-Horn and Associates, Inc.

60% PLANS

No Revisions:

Revised:

Void:


EL PASO COUNTY TRAVEL CENTER
PREPARED FOR
BUC-EE'S, LTD.
REMOVALS


Designer:	APW	Structure Numbers	
Detailer:	DJC		
Checked By:	MPF	Subset Sheet:	5 of 6

Project No./Code

KH 196094002

Sheet Number 15

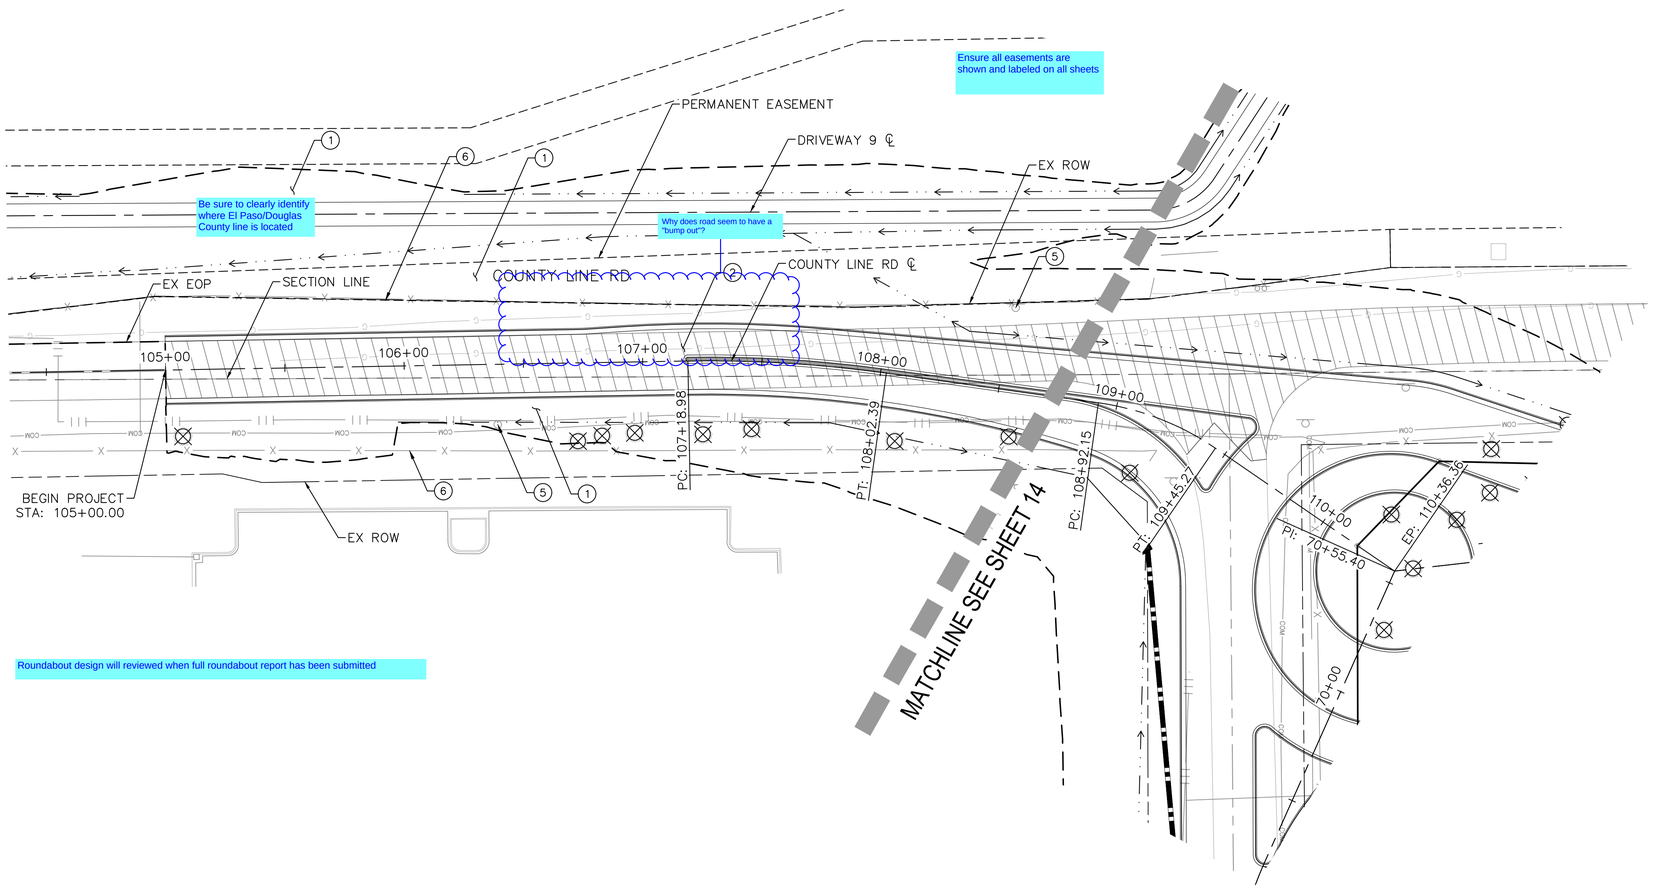

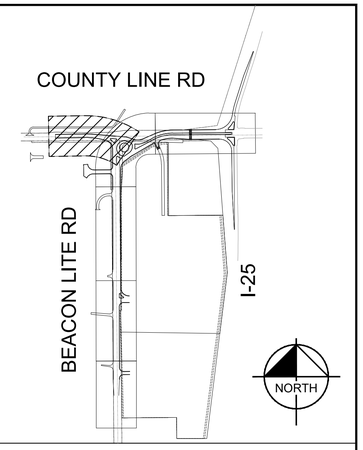

LEGEND:

- GRADING LIMIT
- ASPHALT REMOVAL
- ONSITE HATCH
- CROWN TRANSITION LINE

REMOVAL NOTES:

1. CLEARING AND GRUBBING
2. REMOVE ASPHALT
3. REMOVE GATE, REPLACE IN KIND
4. REMOVE CURB AND GUTTER
5. REMOVE SIGN
6. REMOVE FENCE, REPLACE IN KIND
7. REMOVE RIPRAP
8. REMOVE STORM DRAIN
9. REMOVE MAILBOX
10. PRIVATE UTILITY, RELOCATE BY OTHERS
11. REMOVE END SECTION
12. PROTECT IN PLACE
13. REMOVE TREE ⊠
14. RESET SIGN
15. RESET LIGHT POLE

NORTH

GRAPHIC SCALE IN FEET
0 15 30 60

811 Know what's **below.** **Call** before you dig.

This document, together with the concepts and designs presented herein, as an instrument of service, is intended only for the specific purpose and client for which it was prepared. Reuse of and improper reliance on this document without written authorization and adaptation by Kimley-Horn and Associates, Inc. shall be without liability to Kimley-Horn and Associates, Inc.

Print Date: 5/19/26

Drawing File Name: epc-05_removals.dwg

Kimley»Horn
KIMLEY-HORN AND ASSOCIATES, INC.
6200 SOUTH SYRACUSE WAY
SUITE 300
GREENWOOD VILLAGE, COLORADO 80111
(303) 228-2300

	Sheet Revisions		
	Date:	Comments:	Init.
R-X			
R-X			
R-X			
R-X			

EL PASO COUNTY
DEPARTMENT OF PUBLIC WORKS
3275 AKERS DRIVE
COLORADO SPRINGS, CO
80922

FOR REVIEW ONLY
NOT FOR CONSTRUCTION
Kimley»Horn
Kimley-Horn and Associates, Inc.

60% PLANS

No Revisions:

Revised:

Void:


EL PASO COUNTY TRAVEL CENTER
PREPARED FOR
BUC-EE'S, LTD.
REMOVALS

Designer:	APW	Structure Numbers	
Detailer:	DJC		
Checked By:	MPF	Subset Sheet:	6 of 6

Project No./Code

KH 196094002

Sheet Number 16

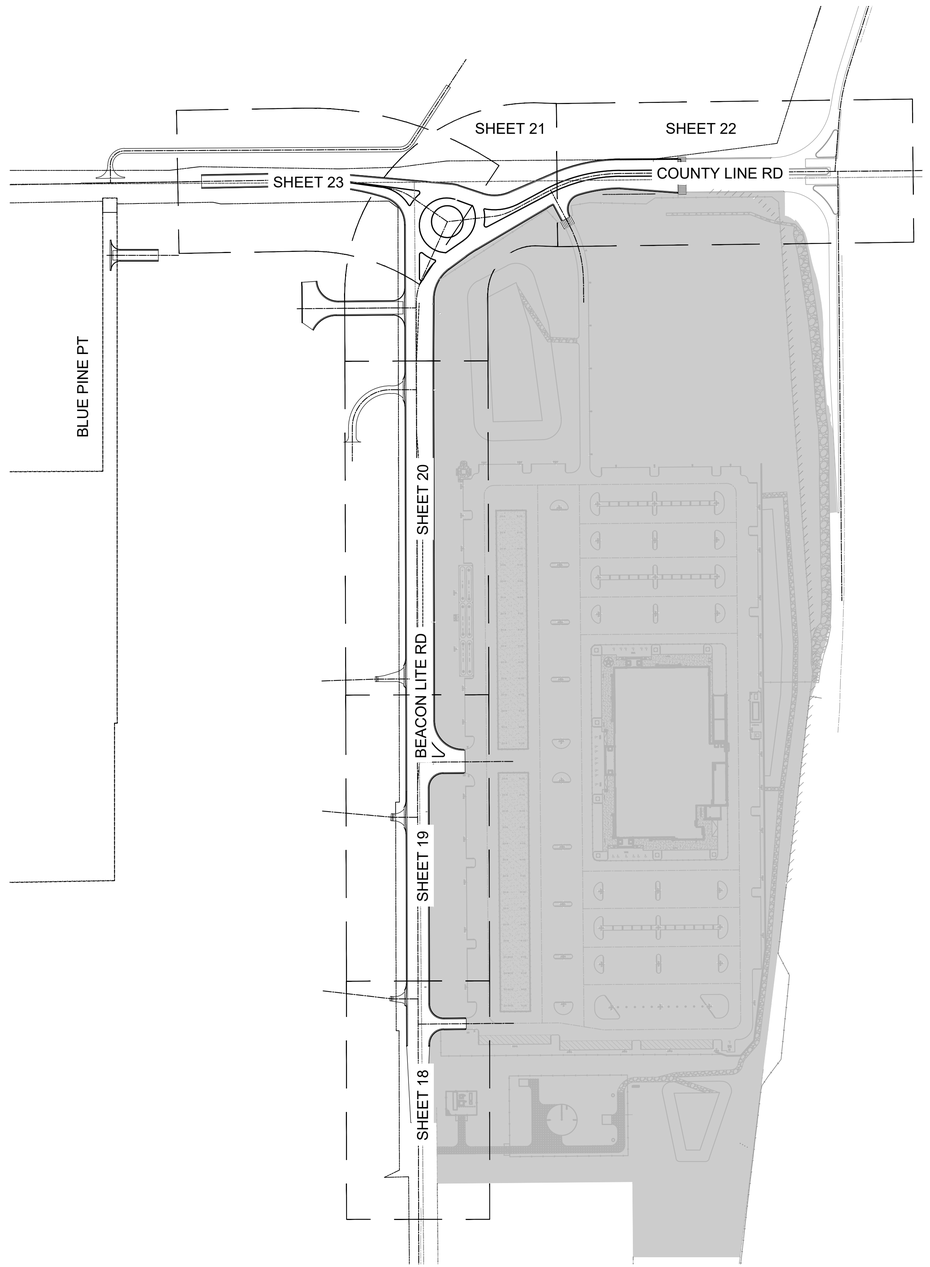

LEGEND:

ONSITE HATCH

NORTH

GRAPHIC SCALE IN FEET
0 75 150 300

811
Know what's **below.**
Call before you dig.

This document, together with the concepts and designs presented herein, as an instrument of service, is intended only for the specific purpose and client for which it was prepared. Reuse of and improper reliance on this document without written authorization and adaptation by Kimley-Horn and Associates, Inc. shall be without liability to Kimley-Horn and Associates, Inc.

Print Date: 5/19/26

Drawing File Name: epc-06_ plan and profiles (km).dwg

Kimley»Horn
KIMLEY-HORN AND ASSOCIATES, INC.
6200 SOUTH SYRACUSE WAY
SUITE 300
GREENWOOD VILLAGE, COLORADO 80111
(303) 228-2300

	Sheet Revisions		
	Date:	Comments:	Init.
R-X			
R-X			
R-X			
R-X			

EL PASO COUNTY
DEPARTMENT OF PUBLIC WORKS
3275 AKERS DRIVE
COLORADO SPRINGS, CO
80922

FOR REVIEW ONLY
NOT FOR CONSTRUCTION
Kimley»Horn
Kimley-Horn and Associates, Inc.

60% PLANS

No Revisions:

Revised:

Void:

EL PASO COUNTY TRAVEL CENTER

PREPARED FOR
BUC-EE'S, LTD.


PLAN AND PROFILES


Designer:	APW	Structure Numbers	
Detailer:	DJC		
Checked By:	MPF	Subset Sheet:	1 of 7


Project No./Code

KH 196094002

Sheet Number 17

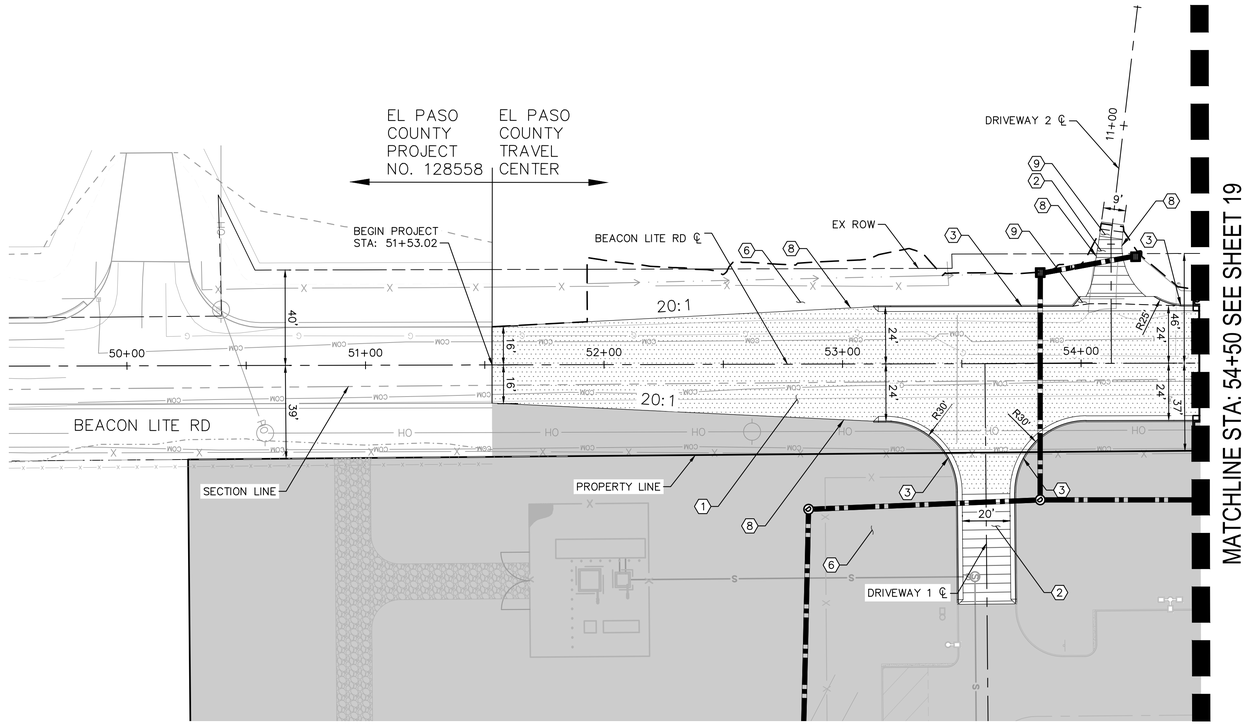

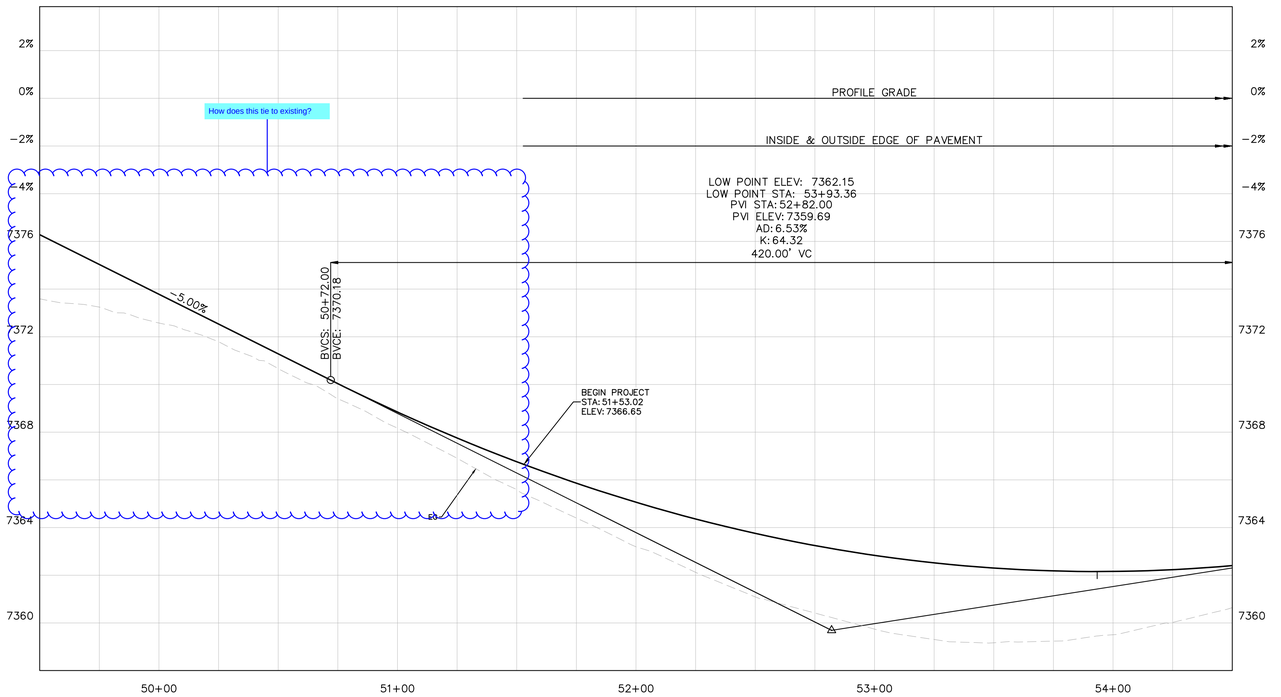

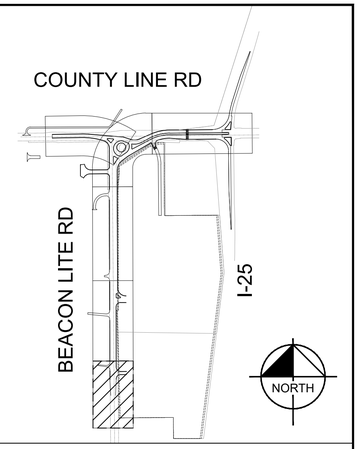

LEGEND:

- GRADING LIMIT
- CROWN TRANSITION LINE
- PROPOSED ASPHALT (COUNTY LINE ROAD)
- PROPOSED ASPHALT (BEACON LITE ROAD)
- PROPOSED ASPHALT (DRIVEWAYS)
- PROPOSED ABC (ACCESS ROAD)
- PROPOSED CONCRETE PAVEMENT (TRUCK APRON)
- PROPOSED CONCRETE MEDIAN

CONSTRUCTION NOTES:

1. PROPOSED PAVEMENT STRUCTURAL SECTION (BEACON LITE ROAD) SEE SHEETS 4-7
2. PROPOSED PAVEMENT STRUCTURAL SECTION (DRIVEWAYS) SEE SHEETS 4-7
3. PROPOSED CURB & GUTTER EPC TYPE A (CATCH) PER EPC STD DET SD_2-20
4. PROPOSED CURB & GUTTER EPC TYPE B (SPILL) PER EPC STD DET SD_2-20
5. PROPOSED PATTERNED CONCRETE MEDIAN PAVING PER EPC STD DET SD_2-21
6. PROPOSED SEEDING
7. PROPOSED PAVEMENT STRUCTURAL SECTION (TRUCK APRON) SEE SHEETS 4-7
8. PROPOSED SAFETY EDGE PER CDOT STD M-400-1
9. PROPOSED CROSS PAN PER EPC STD DET SD_2-26

GRAPHIC SCALE IN FEET
0 15 30 60
HORIZONTAL
VERTICAL 6 3 1.5 0

NORTH

Know what's below. Call before you dig.

This document, together with the concepts and designs presented herein, as an instrument of service, is intended only for the specific purpose and client for which it was prepared. Reuse of and improper reliance on this document without written authorization and adaptation by Kimley-Horn and Associates, Inc. shall be without liability to Kimley-Horn and Associates, Inc.

Print Date: 5/19/26

Drawing File Name: epc-06_plan and profiles.dwg

Kimley»Horn
KIMLEY-HORN AND ASSOCIATES, INC.
6200 SOUTH SYRACUSE WAY
SUITE 300
GREENWOOD VILLAGE, COLORADO 80111
(303) 228-2300

Sheet Revisions

	Date:	Comments:	Init.
R-X			
R-X			
R-X			
R-X			

EL PASO COUNTY
DEPARTMENT OF PUBLIC WORKS
3275 AKERS DRIVE
COLORADO SPRINGS, CO
80922

FOR REVIEW ONLY
NOT FOR CONSTRUCTION
Kimley»Horn
Kimley-Horn and Associates, Inc.

60% PLANS

No Revisions:

Revised:

Void:

EL PASO COUNTY TRAVEL CENTER
PREPARED FOR
BUC-EE'S, LTD.
PLAN AND PROFILES

Designer: APW
Detailer: DJC
Checked By: MPF


Structure Numbers:


Subset Sheet: 2 of 7


Project No./Code

KH 196094002

Sheet Number 18

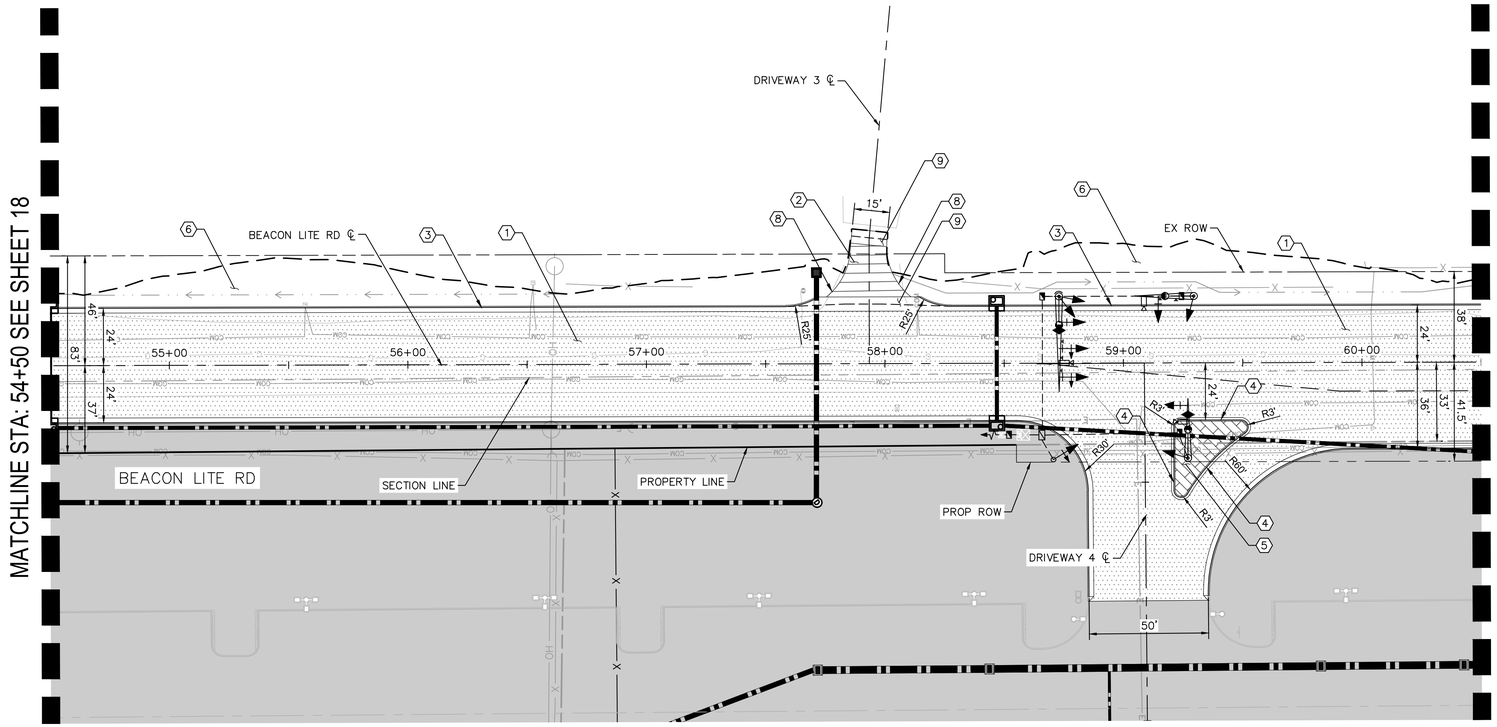

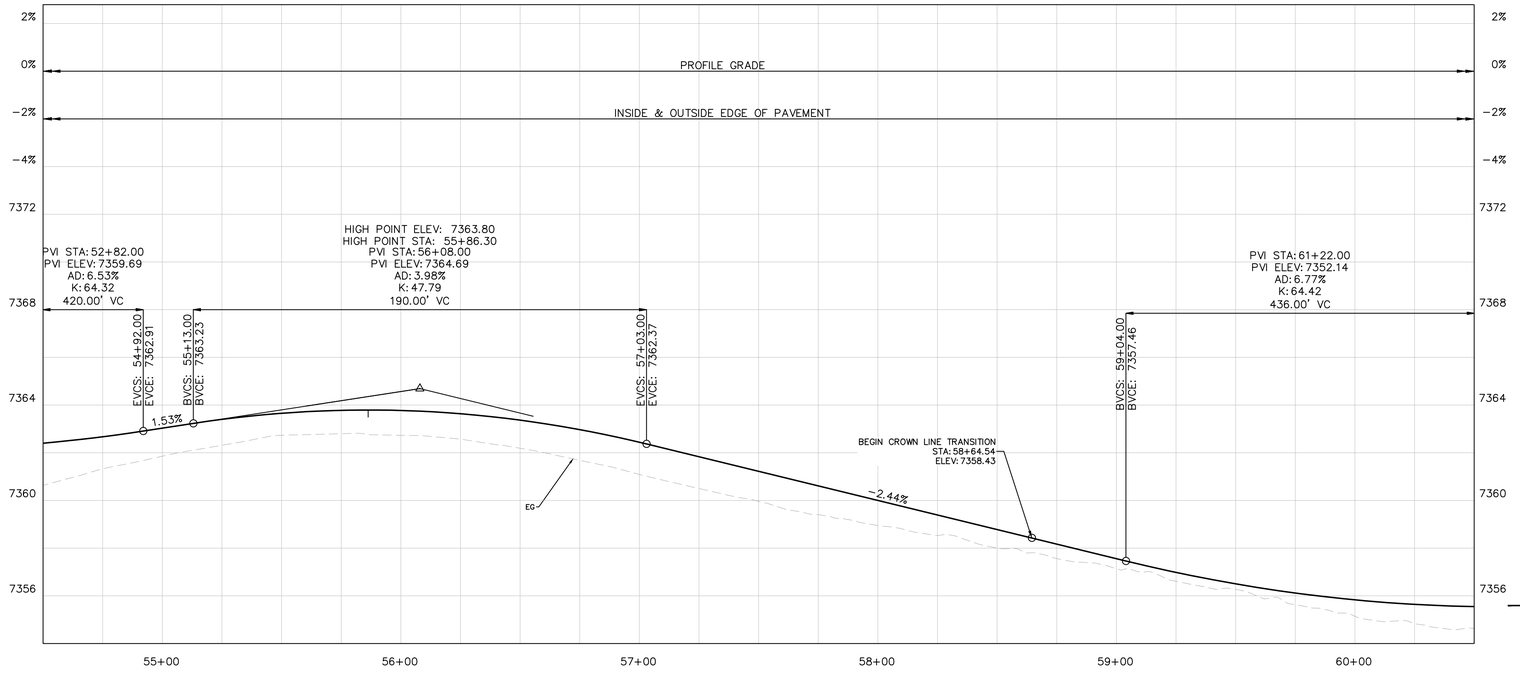

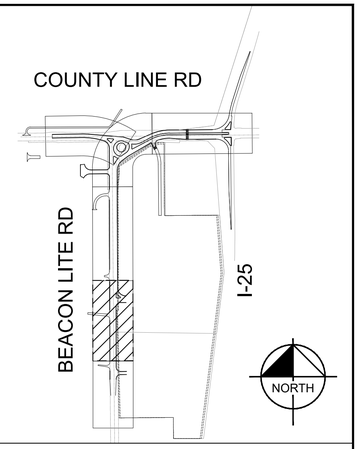



LEGEND:

- GRADING LIMIT
- CROWN TRANSITION LINE
- PROPOSED ASPHALT (COUNTY LINE ROAD)
- PROPOSED ASPHALT (BEACON LITE ROAD)
- PROPOSED ASPHALT (DRIVEWAYS)
- PROPOSED ABC (ACCESS ROAD)
- PROPOSED CONCRETE PAVEMENT (TRUCK APRON)
- PROPOSED CONCRETE MEDIAN

CONSTRUCTION NOTES:

1. PROPOSED PAVEMENT STRUCTURAL SECTION (BEACON LITE ROAD) SEE SHEETS 4-7
2. PROPOSED PAVEMENT STRUCTURAL SECTION (DRIVEWAYS) SEE SHEETS 4-7
3. PROPOSED CURB & GUTTER EPC TYPE A (CATCH) PER EPC STD DET SD_2-20
4. PROPOSED CURB & GUTTER EPC TYPE B (SPILL) PER EPC STD DET SD_2-20
5. PROPOSED PATTERNED CONCRETE MEDIAN PAVING PER EPC STD DET SD_2-21
6. PROPOSED SEEDING
7. PROPOSED PAVEMENT STRUCTURAL SECTION (TRUCK APRON) SEE SHEETS 4-7
8. PROPOSED SAFETY EDGE PER CDOT STD M-400-1
9. PROPOSED CROSS PAN PER EPC STD DET SD_2-26

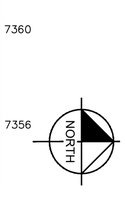

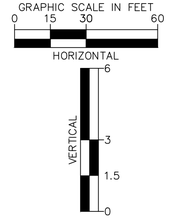

Know what's below. Call before you dig.

This document, together with the concepts and designs presented herein, as an instrument of service, is intended only for the specific purpose and client for which it was prepared. Reuse of and improper reliance on this document without written authorization and adaptation by Kimley-Horn and Associates, Inc. shall be without liability to Kimley-Horn and Associates, Inc.

Print Date: 5/19/26

Drawing File Name: epc-06_plan and profiles.dwg

Kimley»Horn
KIMLEY-HORN AND ASSOCIATES, INC.
6200 SOUTH SYRACUSE WAY
SUITE 300
GREENWOOD VILLAGE, COLORADO 80111
(303) 228-2300

Sheet Revisions

	Date:	Comments:	Init.
R-X			
R-X			
R-X			
R-X			

EL PASO COUNTY
DEPARTMENT OF PUBLIC WORKS
3275 AKERS DRIVE
COLORADO SPRINGS, CO
80922

R-- FINAL
FOR REVIEW ONLY
NOT FOR CONSTRUCTION
Kimley»Horn
Kimley-Horn and Associates, Inc.

60% PLANS

No Revisions:

Revised:

Void:


EL PASO COUNTY TRAVEL CENTER
PREPARED FOR
BUC-EE'S, LTD.
PLAN AND PROFILES


Designer:	APW	Structure Numbers	
Detailer:	DJC		
Checked By:	MPF	Subset Sheet:	3 of 7


Project No./Code

KH 196094002

Sheet Number 19

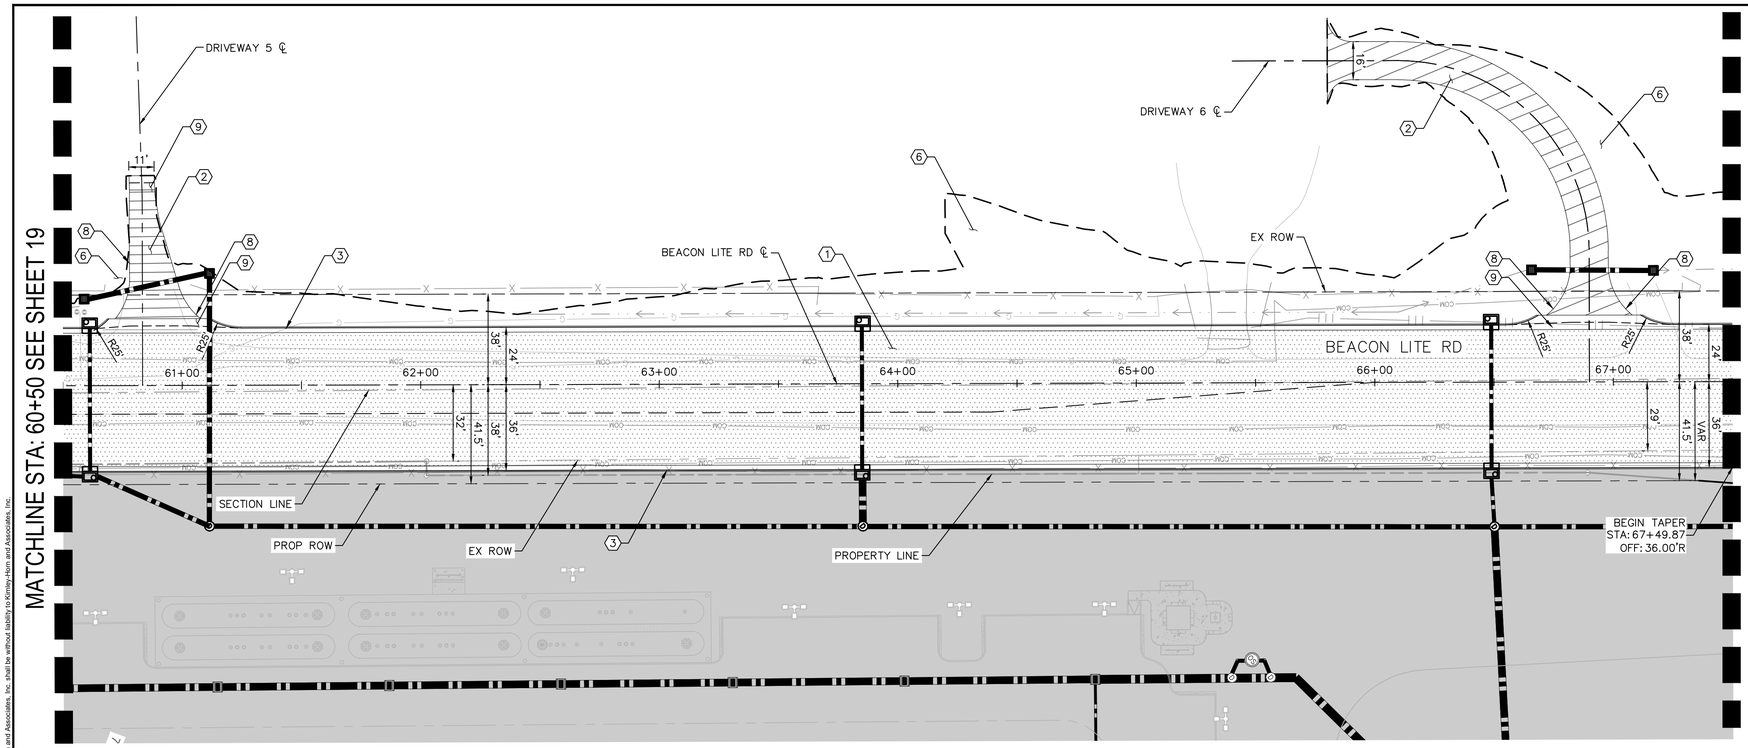

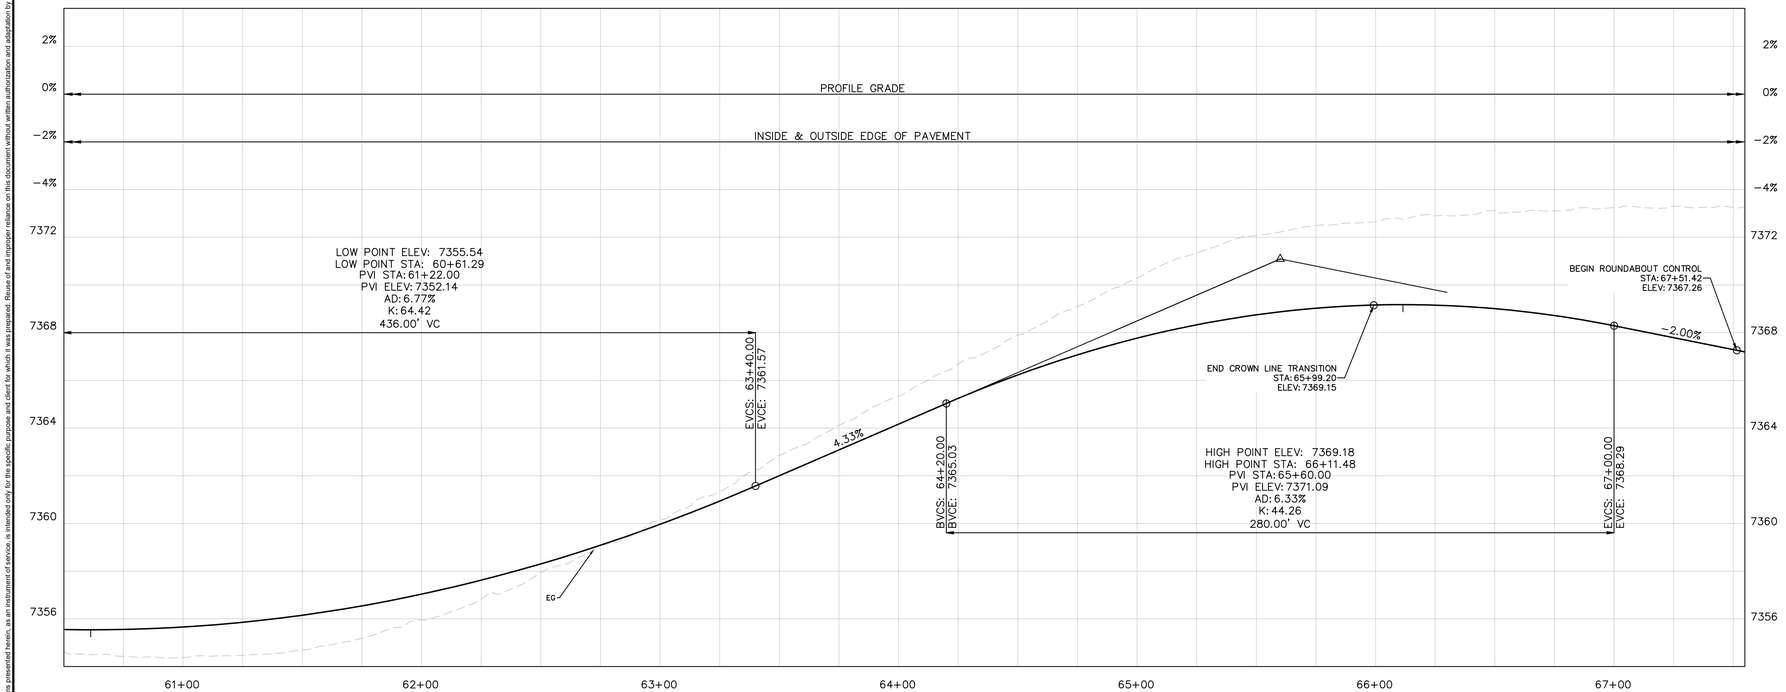

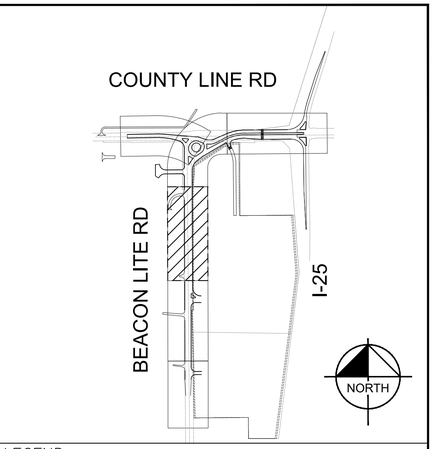


LEGEND:

- GRADING LIMIT
- CROWN TRANSITION LINE
- PROPOSED ASPHALT (COUNTY LINE ROAD)
- PROPOSED ASPHALT (BEACON LITE ROAD)
- PROPOSED ASPHALT (DRIVEWAYS)
- PROPOSED ABC (ACCESS ROAD)
- PROPOSED CONCRETE PAVEMENT (TRUCK APRON)
- PROPOSED CONCRETE MEDIAN

CONSTRUCTION NOTES:

1. PROPOSED PAVEMENT STRUCTURAL SECTION (BEACON LITE ROAD) SEE SHEETS 4–7
2. PROPOSED PAVEMENT STRUCTURAL SECTION (DRIVEWAYS) SEE SHEETS 4–7
3. PROPOSED CURB & GUTTER EPC TYPE A (CATCH) PER EPC STD DET SD_2–20
4. PROPOSED CURB & GUTTER EPC TYPE B (SPILL) PER EPC STD DET SD_2–20
5. PROPOSED PATTERNED CONCRETE MEDIAN PAVING PER EPC STD DET SD_2–21
6. PROPOSED SEEDING
7. PROPOSED PAVEMENT STRUCTURAL SECTION (TRUCK APRON) SEE SHEETS 4–7
8. PROPOSED SAFETY EDGE PER CDOT STD M–400–1
9. PROPOSED CROSS PAN PER EPC STD DET SD_2–26

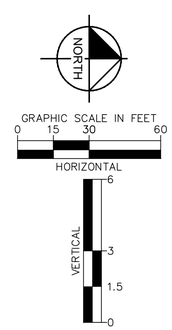

Know what's below. Call before you dig.

This document, together with the concepts and designs presented herein, as an instrument of service, is intended only for the specific purpose and client for which it was prepared. Reuse of and improper reliance on this document without written authorization and adaptation by Kimley-Horn and Associates, Inc. shall be without liability to Kimley-Horn and Associates, Inc.

Print Date: 5/19/26

Drawing File Name: epc-06_plan and profiles.dwg

Kimley»Horn
KIMLEY-HORN AND ASSOCIATES, INC.
6200 SOUTH SYRACUSE WAY
SUITE 300
GREENWOOD VILLAGE, COLORADO 80111
(303) 228-2300

Sheet Revisions

	Date:	Comments:	Init.
R–X			
R–X			
R–X			
R–X			

EL PASO COUNTY
DEPARTMENT OF PUBLIC WORKS
3275 AKERS DRIVE
COLORADO SPRINGS, CO
80922

FOR REVIEW ONLY
NOT FOR CONSTRUCTION
Kimley»Horn
Kimley-Horn and Associates, Inc.

60% PLANS

No Revisions:

Revised:

Void:

EL PASO COUNTY TRAVEL CENTER
PREPARED FOR
BUC-EE'S, LTD.
PLAN AND PROFILES

Designer: APW
Detailer: DJC
Checked By: MPF


Structure Numbers


Subset Sheet: 4 of 7

Project No./Code

KH 196094002

Sheet Number 20

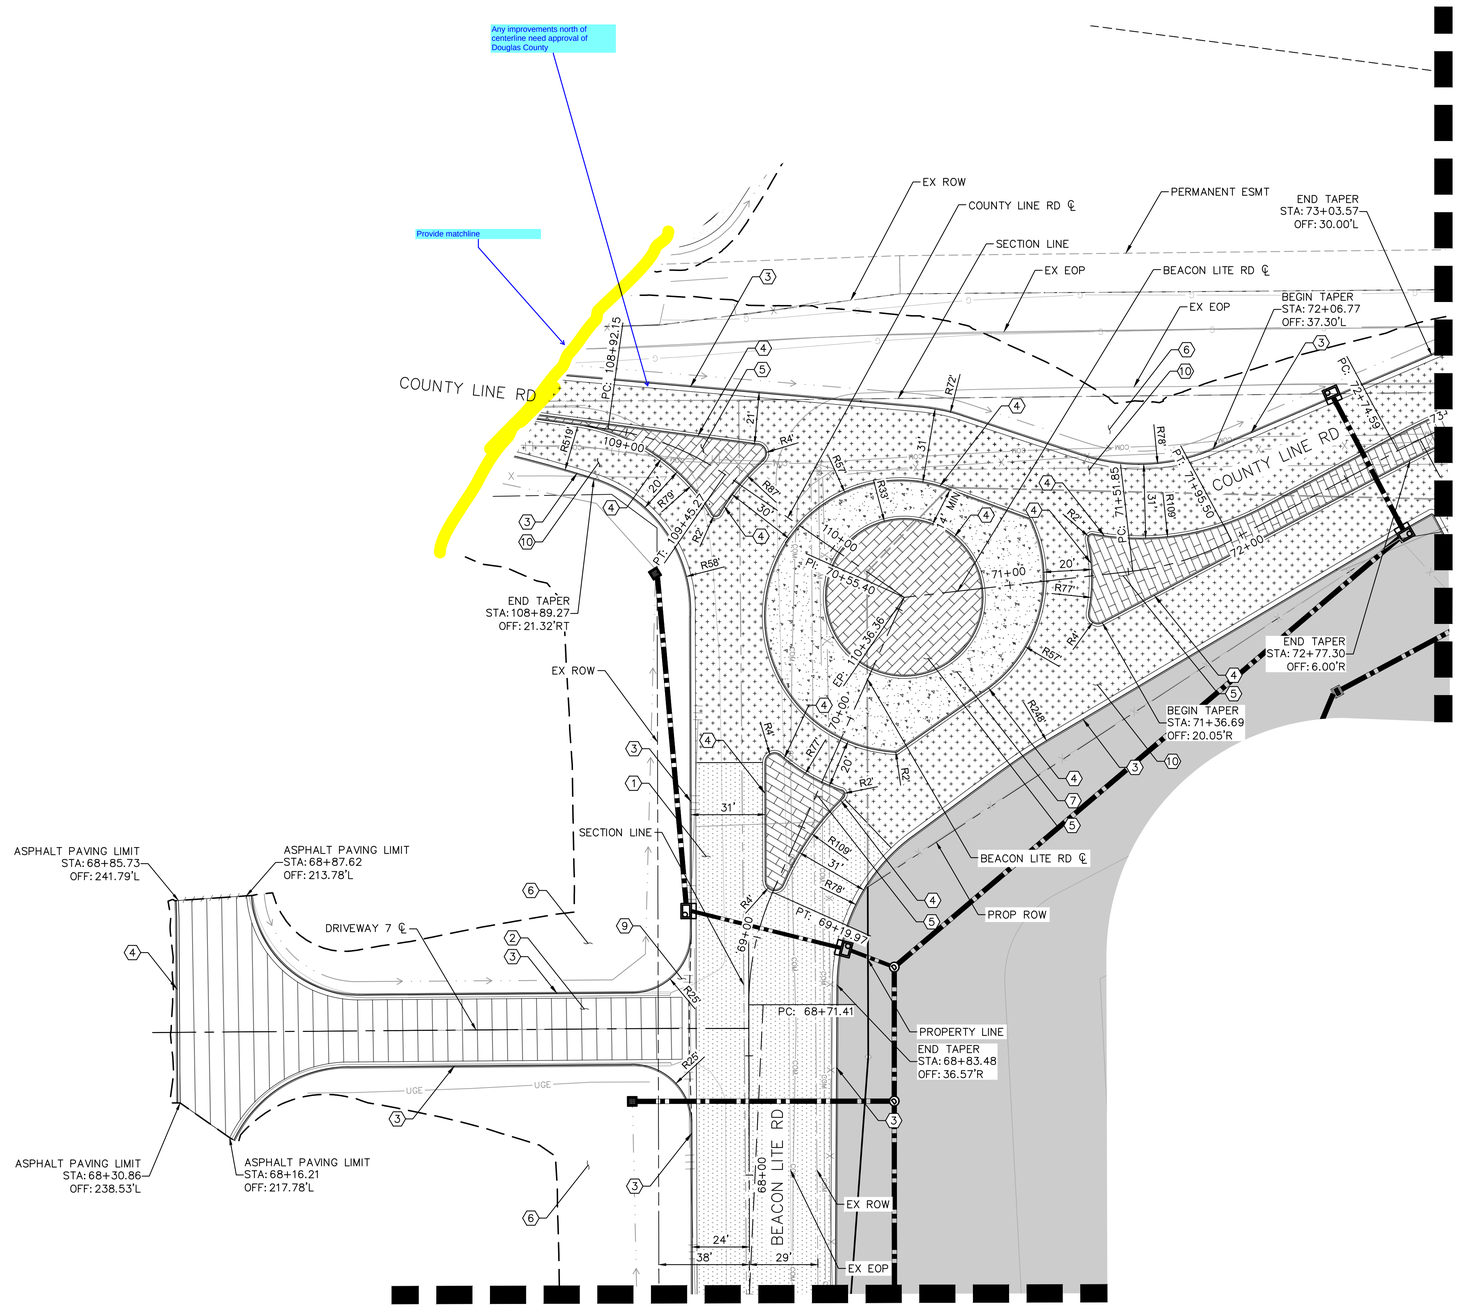

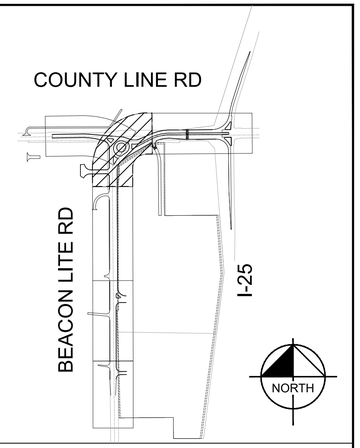

CONSTRUCTION NOTES (CONTINUED):

10 PROPOSED PAVEMENT STRUCTURAL SECTION (COUNTY LINE ROAD) SEE SHEETS 4–7

11 PROPOSED CATTLE GUARD PER CDOT STD DET M–611–1

12 PROPOSED PAVEMENT STRUCTURAL SECTION (ACCESS ROAD) SEE SHEET 4–7

LEGEND:

- GRADING LIMIT
- CROWN TRANSITION LINE
- PROPOSED ASPHALT (COUNTY LINE ROAD)
- PROPOSED ASPHALT (BEACON LITE ROAD)
- PROPOSED ASPHALT (DRIVEWAYS)
- PROPOSED ABC (ACCESS ROAD)
- PROPOSED CONCRETE PAVEMENT (TRUCK APRON)
- PROPOSED CONCRETE MEDIAN

CONSTRUCTION NOTES:

1 PROPOSED PAVEMENT STRUCTURAL SECTION (BEACON LITE ROAD) SEE SHEETS 4–7

2 PROPOSED PAVEMENT STRUCTURAL SECTION (DRIVEWAYS) SEE SHEETS 4–7

3 PROPOSED CURB & GUTTER EPC TYPE A (CATCH) PER EPC STD DET SD_2–20

4 PROPOSED CURB & GUTTER EPC TYPE B (SPILL) PER EPC STD DET SD_2–20

5 PROPOSED PATTERNED CONCRETE MEDIAN PAVING PER EPC STD DET SD_2–21

6 PROPOSED SEEDING

7 PROPOSED PAVEMENT STRUCTURAL SECTION (TRUCK APRON) SEE SHEETS 4–7

8 PROPOSED SAFETY EDGE PER CDOT STD M–400–1

9 PROPOSED CROSS PAN PER EPC STD DET SD_2–26

NORTH

GRAPHIC SCALE IN FEET
0 15 30 60

Know what's below. Call before you dig.

This document, together with the concepts and designs presented herein, as an instrument of service, is intended only for the specific purpose and client for which it was prepared. Reuse of and improper reliance on this document without written authorization and adaptation by Kimley-Horn and Associates, Inc. shall be without liability to Kimley-Horn and Associates, Inc.

Print Date: 5/19/26
Drawing File Name: epc-06_plan and profiles.dwg

Kimley»Horn
KIMLEY-HORN AND ASSOCIATES, INC.
6200 SOUTH SYRACUSE WAY
SUITE 300
GREENWOOD VILLAGE, COLORADO 80111
(303) 228-2300

	Sheet Revisions		
	Date:	Comments:	Init.
R-X			
R-X			
R-X			
R-X			

EL PASO COUNTY
DEPARTMENT OF PUBLIC WORKS
3275 AKERS DRIVE
COLORADO SPRINGS, CO
80922


R-- FINAL
FOR REVIEW ONLY
NOT FOR CONSTRUCTION
Kimley»Horn
Kimley-Horn and Associates, Inc.


60% PLANS
No Revisions:
Revised:
Void:


EL PASO COUNTY TRAVEL CENTER
PREPARED FOR
BUC-EE'S, LTD.
PLAN AND PROFILES

Designer:	APW	Structure Numbers	
Detailer:	DJC		
Checked By:	MPF	Subset Sheet:	5 of 7

Project No./Code
KH 196094002
Sheet Number 21

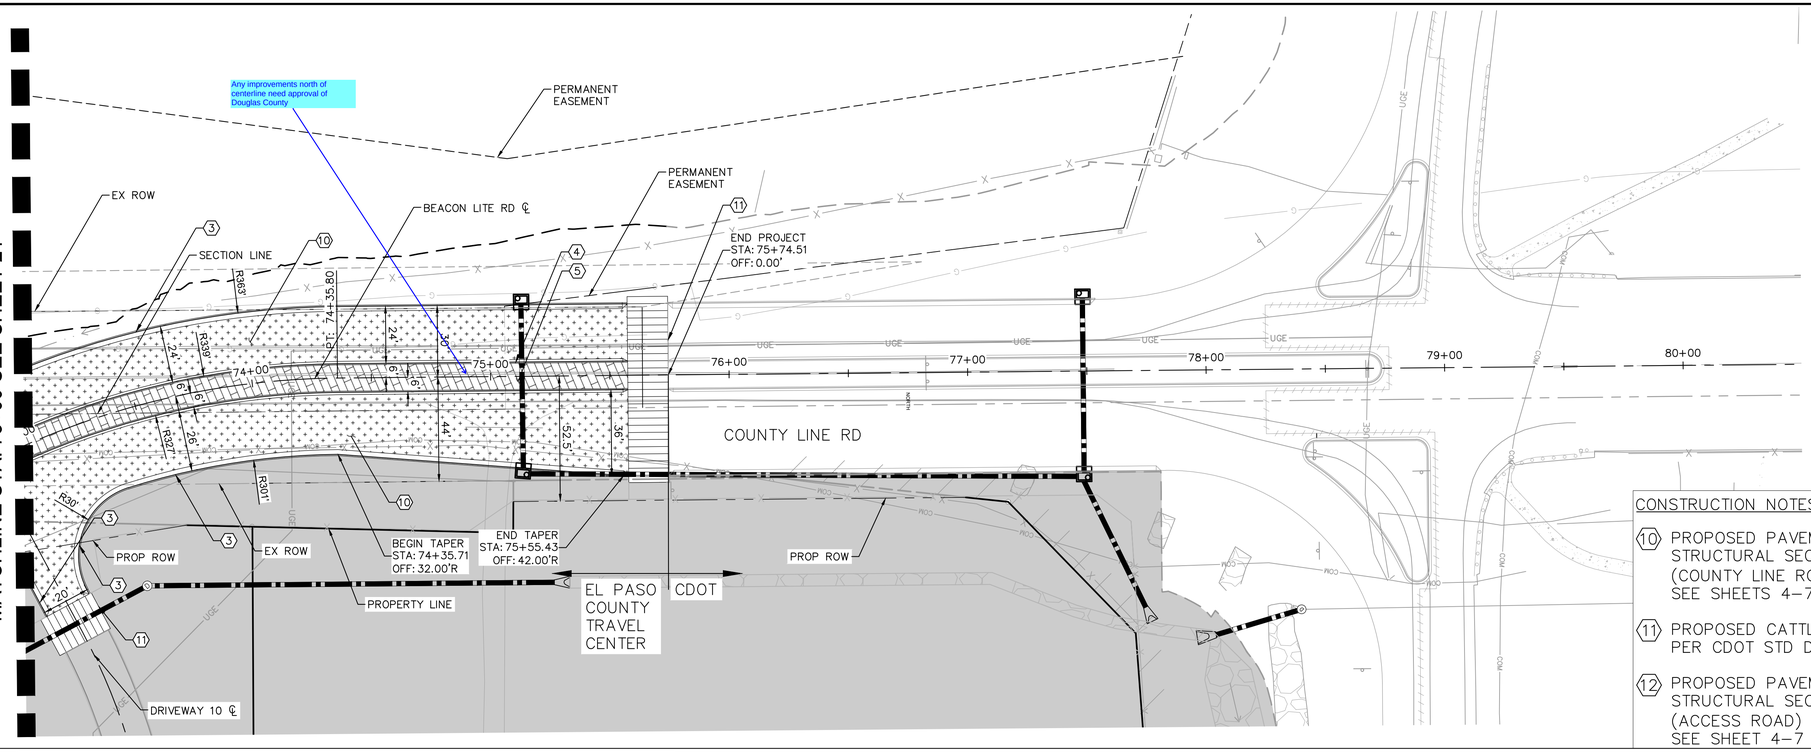

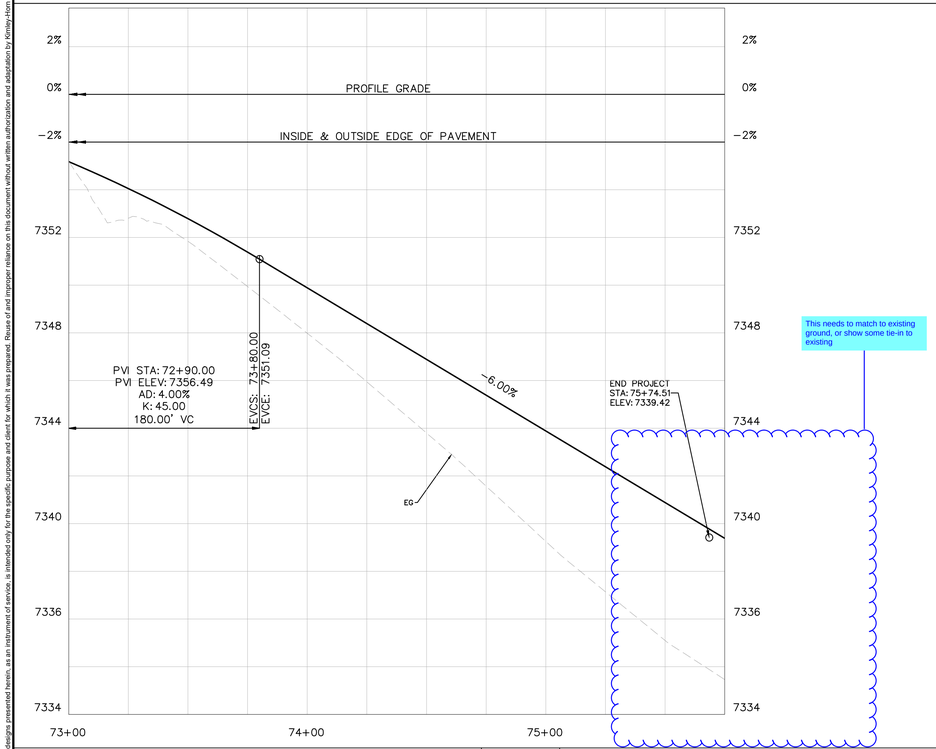

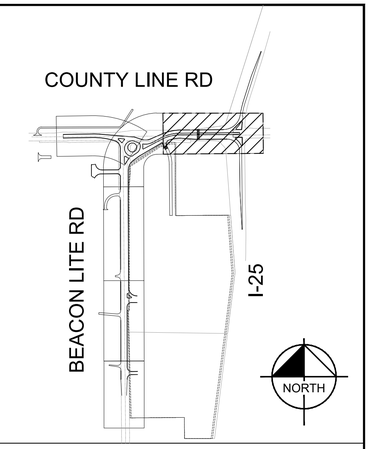

CONSTRUCTION NOTES (CONTINUED):

10 PROPOSED PAVEMENT STRUCTURAL SECTION (COUNTY LINE ROAD) SEE SHEETS 4–7

11 PROPOSED CATTLE GUARD PER CDOT STD DET M–611–1

12 PROPOSED PAVEMENT STRUCTURAL SECTION (ACCESS ROAD) SEE SHEET 4–7

LEGEND:

- GRADING LIMIT
- CROWN TRANSITION LINE
- PROPOSED ASPHALT (COUNTY LINE ROAD)
- PROPOSED ASPHALT (BEACON LITE ROAD)
- PROPOSED ASPHALT (DRIVEWAYS)
- PROPOSED ABC (ACCESS ROAD)
- PROPOSED CONCRETE PAVEMENT (TRUCK APRON)
- PROPOSED CONCRETE MEDIAN

CONSTRUCTION NOTES:

1 PROPOSED PAVEMENT STRUCTURAL SECTION (BEACON LITE ROAD) SEE SHEETS 4–7

2 PROPOSED PAVEMENT STRUCTURAL SECTION (DRIVEWAYS) SEE SHEETS 4–7

3 PROPOSED CURB & GUTTER EPC TYPE A (CATCH) PER EPC STD DET SD_2–20

4 PROPOSED CURB & GUTTER EPC TYPE B (SPILL) PER EPC STD DET SD_2–20


5 PROPOSED PATTERNED CONCRETE MEDIAN PAVING PER EPC STD DET SD_2–21


6 PROPOSED SEEDING

7 PROPOSED PAVEMENT STRUCTURAL SECTION (TRUCK APRON) SEE SHEETS 4–7

8 PROPOSED SAFETY EDGE PER CDOT STD M–400–1

9 PROPOSED CROSS PAN PER EPC STD DET SD_2–26

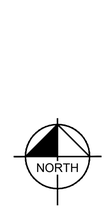

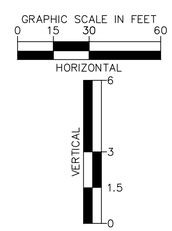

Know what's **below.** **Call** before you dig.

This document, together with the concepts and designs presented herein, as an instrument of service, is intended only for the specific purpose and client for which it was prepared. Reuse of and improper reliance on this document without written authorization and adaptation by Kimley-Horn and Associates, Inc. shall be without liability to Kimley-Horn and Associates, Inc.

Print Date: 5/19/26

Drawing File Name: epc-06_plan and profiles.dwg

Kimley»Horn
KIMLEY-HORN AND ASSOCIATES, INC.
6200 SOUTH SYRACUSE WAY
SUITE 300
GREENWOOD VILLAGE, COLORADO 80111
(303) 228-2300

Sheet Revisions

	Date:	Comments:	Init.
R–X			
R–X			
R–X			
R–X			

EL PASO COUNTY
DEPARTMENT OF PUBLIC WORKS
3275 AKERS DRIVE
COLORADO SPRINGS, CO
80922

FOR REVIEW ONLY
NOT FOR CONSTRUCTION
Kimley»Horn
Kimley-Horn and Associates, Inc.

60% PLANS

No Revisions:

Revised:

Void:

EL PASO COUNTY TRAVEL CENTER
PREPARED FOR
BUC-EE'S, LTD.
PLAN AND PROFILES

Designer: APW
Detailer: DJC
Checked By: MPF


Structure Numbers:


Subset Sheet: 6 of 7

Project No./Code

KH 196094002

Sheet Number 22

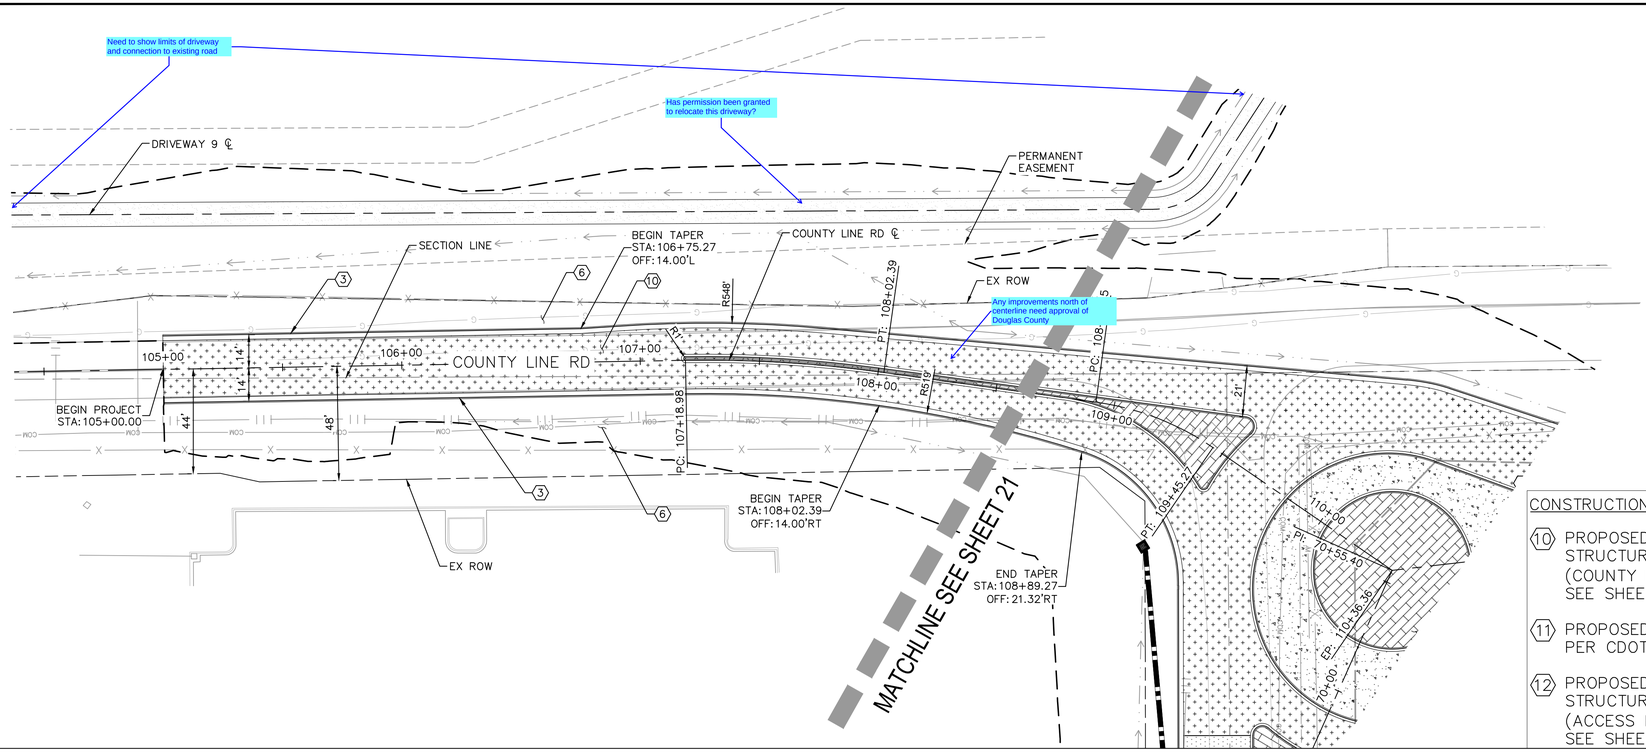

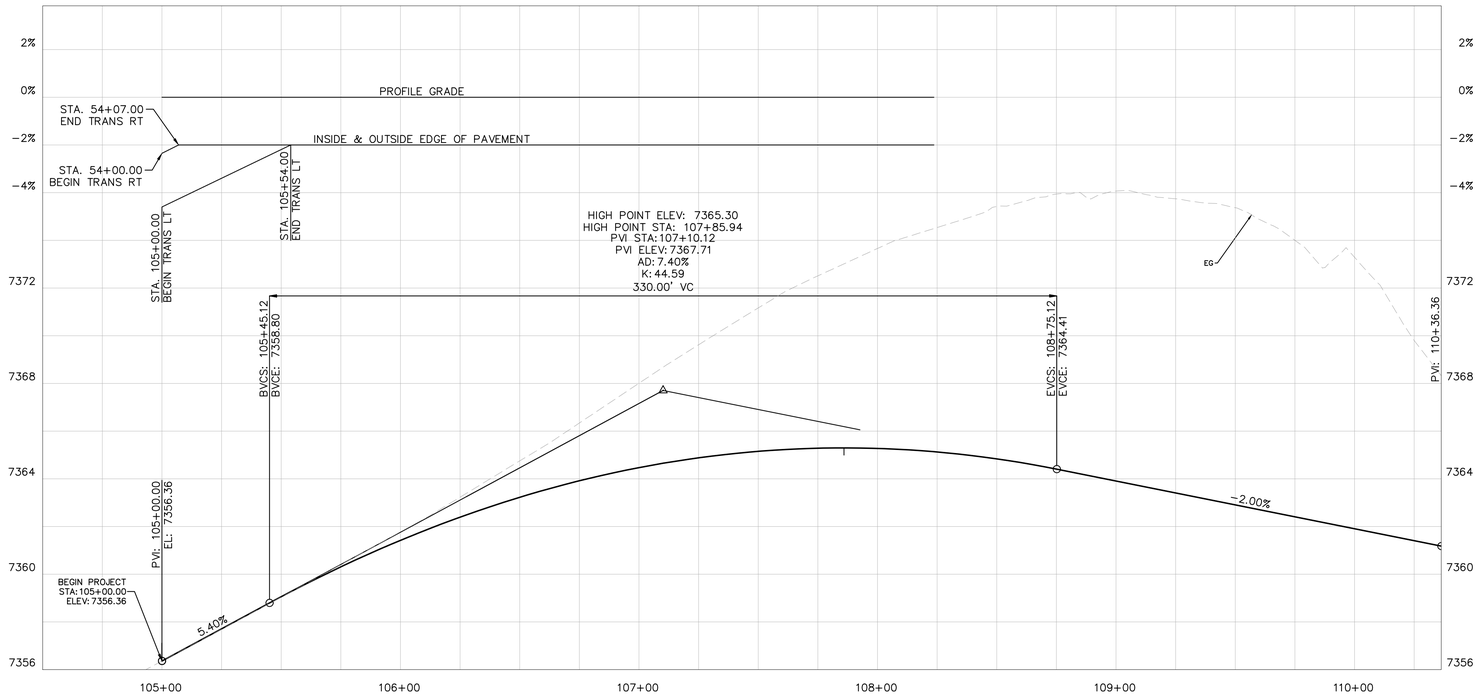


CONSTRUCTION NOTES (CONTINUED):

10 PROPOSED PAVEMENT STRUCTURAL SECTION (COUNTY LINE ROAD) SEE SHEETS 4–7

11 PROPOSED CATTLE GUARD PER CDOT STD DET M–611–1

12 PROPOSED PAVEMENT STRUCTURAL SECTION (ACCESS ROAD) SEE SHEET 4–7

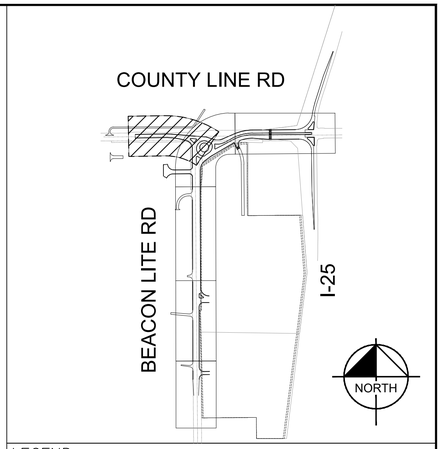

LEGEND:

- GRADING LIMIT
- CROWN TRANSITION LINE
- PROPOSED ASPHALT (COUNTY LINE ROAD)
- PROPOSED ASPHALT (BEACON LITE ROAD)
- PROPOSED ASPHALT (DRIVEWAYS)
- PROPOSED ABC (ACCESS ROAD)
- PROPOSED CONCRETE PAVEMENT (TRUCK APRON)
- PROPOSED CONCRETE MEDIAN

CONSTRUCTION NOTES:

1 PROPOSED PAVEMENT STRUCTURAL SECTION (BEACON LITE ROAD) SEE SHEETS 4–7

2 PROPOSED PAVEMENT STRUCTURAL SECTION (DRIVEWAYS) SEE SHEETS 4–7

3 PROPOSED CURB & GUTTER EPC TYPE A (CATCH) PER EPC STD DET SD_2–20

4 PROPOSED CURB & GUTTER EPC TYPE B (SPILL) PER EPC STD DET SD_2–20


5 PROPOSED PATTERNED CONCRETE MEDIAN PAVING PER EPC STD DET SD_2–21

6 PROPOSED SEEDING

7 PROPOSED PAVEMENT STRUCTURAL SECTION (TRUCK APRON) SEE SHEETS 4–7

8 PROPOSED SAFETY EDGE PER CDOT STD M–400–1

9 PROPOSED CROSS PAN PER EPC STD DET SD_2–26

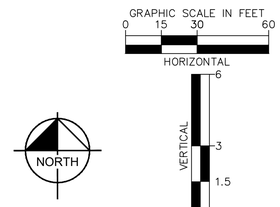

Know what's below. Call before you dig.

This document, together with the concepts and designs presented herein, as an instrument of service, is intended only for the specific purpose and client for which it was prepared. Reuse of and improper reliance on this document without written authorization and adaptation by Kimley-Horn and Associates, Inc. shall be without liability to Kimley-Horn and Associates, Inc.

Print Date: 5/19/26

Drawing File Name: epc-06_plan and profiles.dwg

Sheet Revisions		
Date:	Comments:	Init.
R–X		
R–X		
R–X		
R–X		

Kimley»Horn
KIMLEY–HORN AND ASSOCIATES, INC.
6200 SOUTH SYRACUSE WAY
SUITE 300
GREENWOOD VILLAGE, COLORADO 80111
(303) 228–2300

EL PASO COUNTY
DEPARTMENT OF PUBLIC WORKS
3275 AKERS DRIVE
COLORADO SPRINGS, CO
80922

FOR REVIEW ONLY
NOT FOR CONSTRUCTION
Kimley»Horn
Kimley-Horn and Associates, Inc.

60% PLANS

No Revisions:

Revised:

Void:

EL PASO COUNTY TRAVEL CENTER

PREPARED FOR
BUC-EE'S, LTD.

PLAN AND PROFILES


Designer:	APW	Structure Numbers	
Detailer:	DJC		
Checked By:	MPF	Subset Sheet:	7 of 7

Project No./Code

KH 196094002

Sheet Number 23

COUNTY LINE RD
EASTBOUND RIGHT EOP (EB_RT)

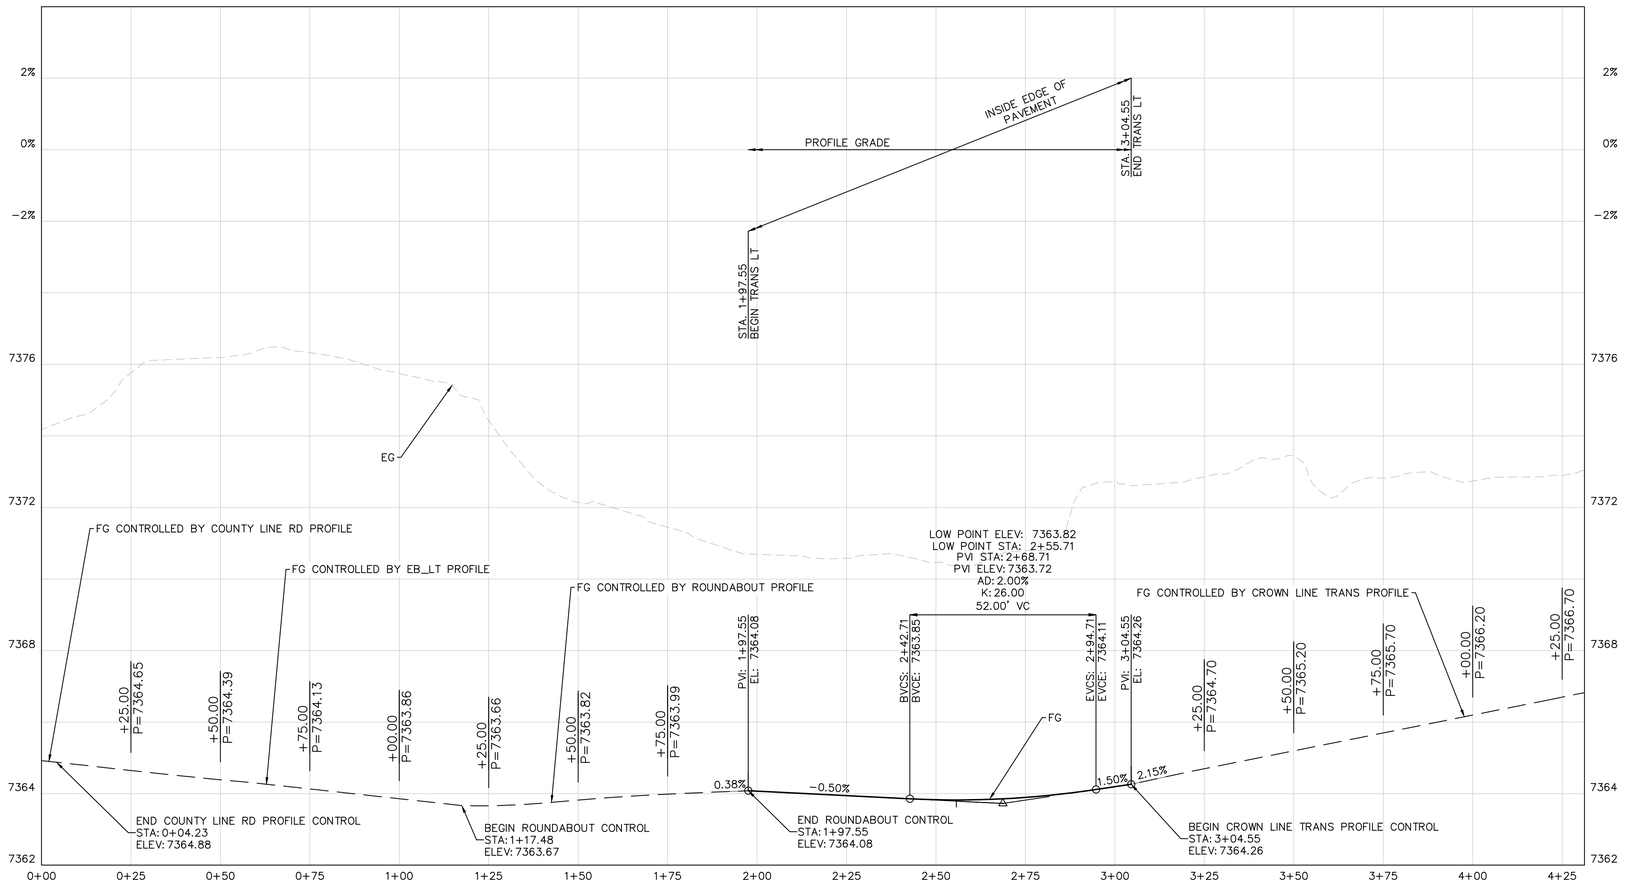

GRAPHIC SCALE IN FEET
0 10 20 40
HORIZONTAL

0 1 2 4
VERTICAL

811 Know what's below. Call before you dig.

This document, together with the concepts and designs presented herein, as an instrument of service, is intended only for the specific purpose and client for which it was prepared. Reuse of and improper reliance on this document without written authorization and adaptation by Kimley-Horn and Associates, Inc. shall be without liability to Kimley-Horn and Associates, Inc.

Print Date: 5/19/26
Drawing File Name: epc-06_roundabout detail 1.dwg

Kimley»Horn
KIMLEY-HORN AND ASSOCIATES, INC.
6200 SOUTH SYRACUSE WAY
SUITE 300
GREENWOOD VILLAGE, COLORADO 80111
(303) 228-2300

Sheet Revisions

	Date:	Comments:	Init.
R-X			
R-X			
R-X			
R-X			

EL PASO COUNTY
DEPARTMENT OF PUBLIC WORKS
3275 AKERS DRIVE
COLORADO SPRINGS, CO
80922

FOR REVIEW ONLY
NOT FOR CONSTRUCTION
Kimley»Horn
Kimley-Horn and Associates, Inc.

60% PLANS
No Revisions:
Revised:
Void:


EL PASO COUNTY TRAVEL CENTER
PREPARED FOR
BUC-EE'S, LTD.
ROUNDABOUT PROFILES

Designer: APW
Detailer: DJC
Checked By: MPF
Structure Numbers:
Subset Sheet: 1 of 7


Project No./Code
KH 196094002
Sheet Number 24

This document, together with the concepts and designs presented herein, as an instrument of service, is intended only for the specific purpose and client for which it was prepared. Reuse of and improper reliance on this document without written authorization and adaptation by Kimley-Horn and Associates, Inc. shall be without liability to Kimley-Horn and Associates, Inc.

COUNTY LINE RD
EASTBOUND LEFT MEDIAN (EB_LT)

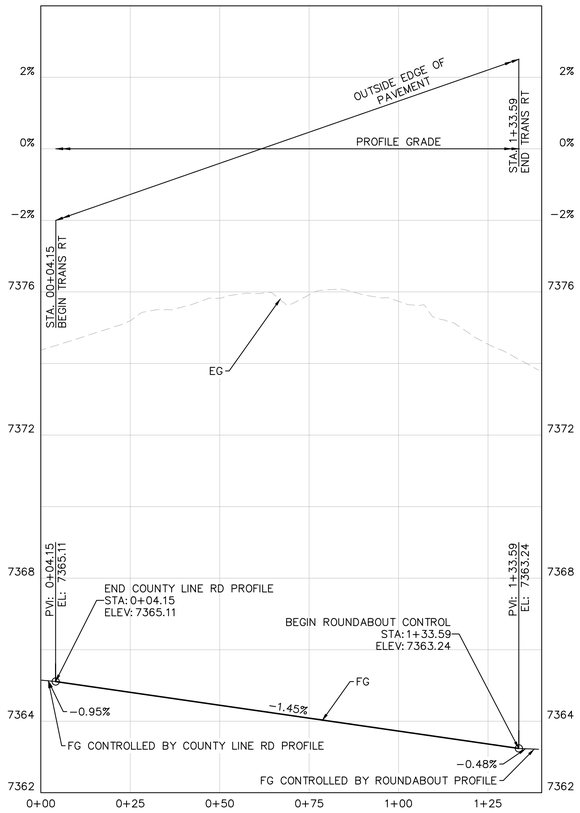

BEACON LITE RD
CROWN LINE TRANSITION (SB_RT)

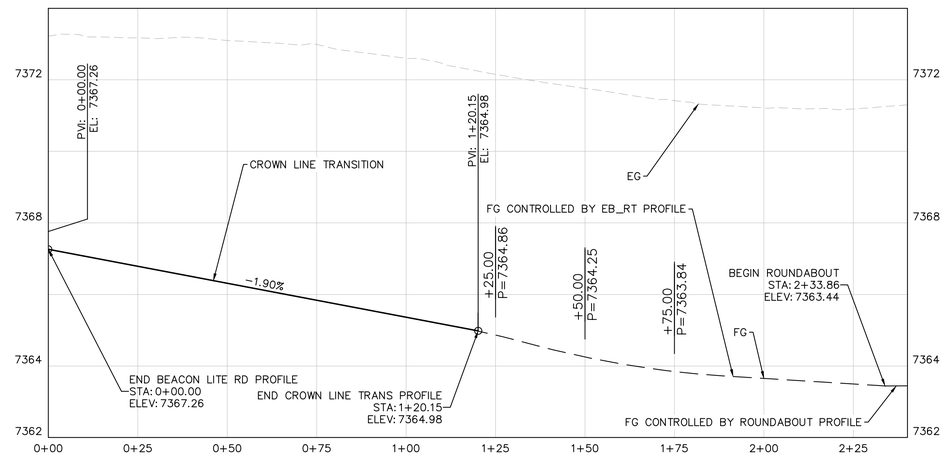

GRAPHIC SCALE IN FEET
0 10 20 40
HORIZONTAL

0 1 2 4
VERTICAL

811
Know what's **below.**
Call before you dig.

Print Date: 5/19/26
Drawing File Name: epc-06_roundabout detail 1.dwg

Kimley»Horn
KIMLEY-HORN AND ASSOCIATES, INC.
6200 SOUTH SYRACUSE WAY
SUITE 300
GREENWOOD VILLAGE, COLORADO 80111
(303) 228-2300

Sheet Revisions

	Date:	Comments:	Init.
R-X			
R-X			
R-X			
R-X			

EL PASO COUNTY
DEPARTMENT OF PUBLIC WORKS
3275 AKERS DRIVE
COLORADO SPRINGS, CO
80922

FOR REVIEW ONLY
NOT FOR CONSTRUCTION
Kimley»Horn
Kimley-Horn and Associates, Inc.


60% PLANS
No Revisions:
Revised:
Void:

EL PASO COUNTY TRAVEL CENTER
PREPARED FOR
BUC-EE'S, LTD.
ROUNDABOUT PROFILES

Designer: APW
Detailer: DJC
Checked By: MPF
Structure Numbers:
Subset Sheet: 2 of 7

Project No./Code
KH 196094002
Sheet Number 25

COUNTY LINE RD
WESTBOUND LEFT EOP (WB_LT)

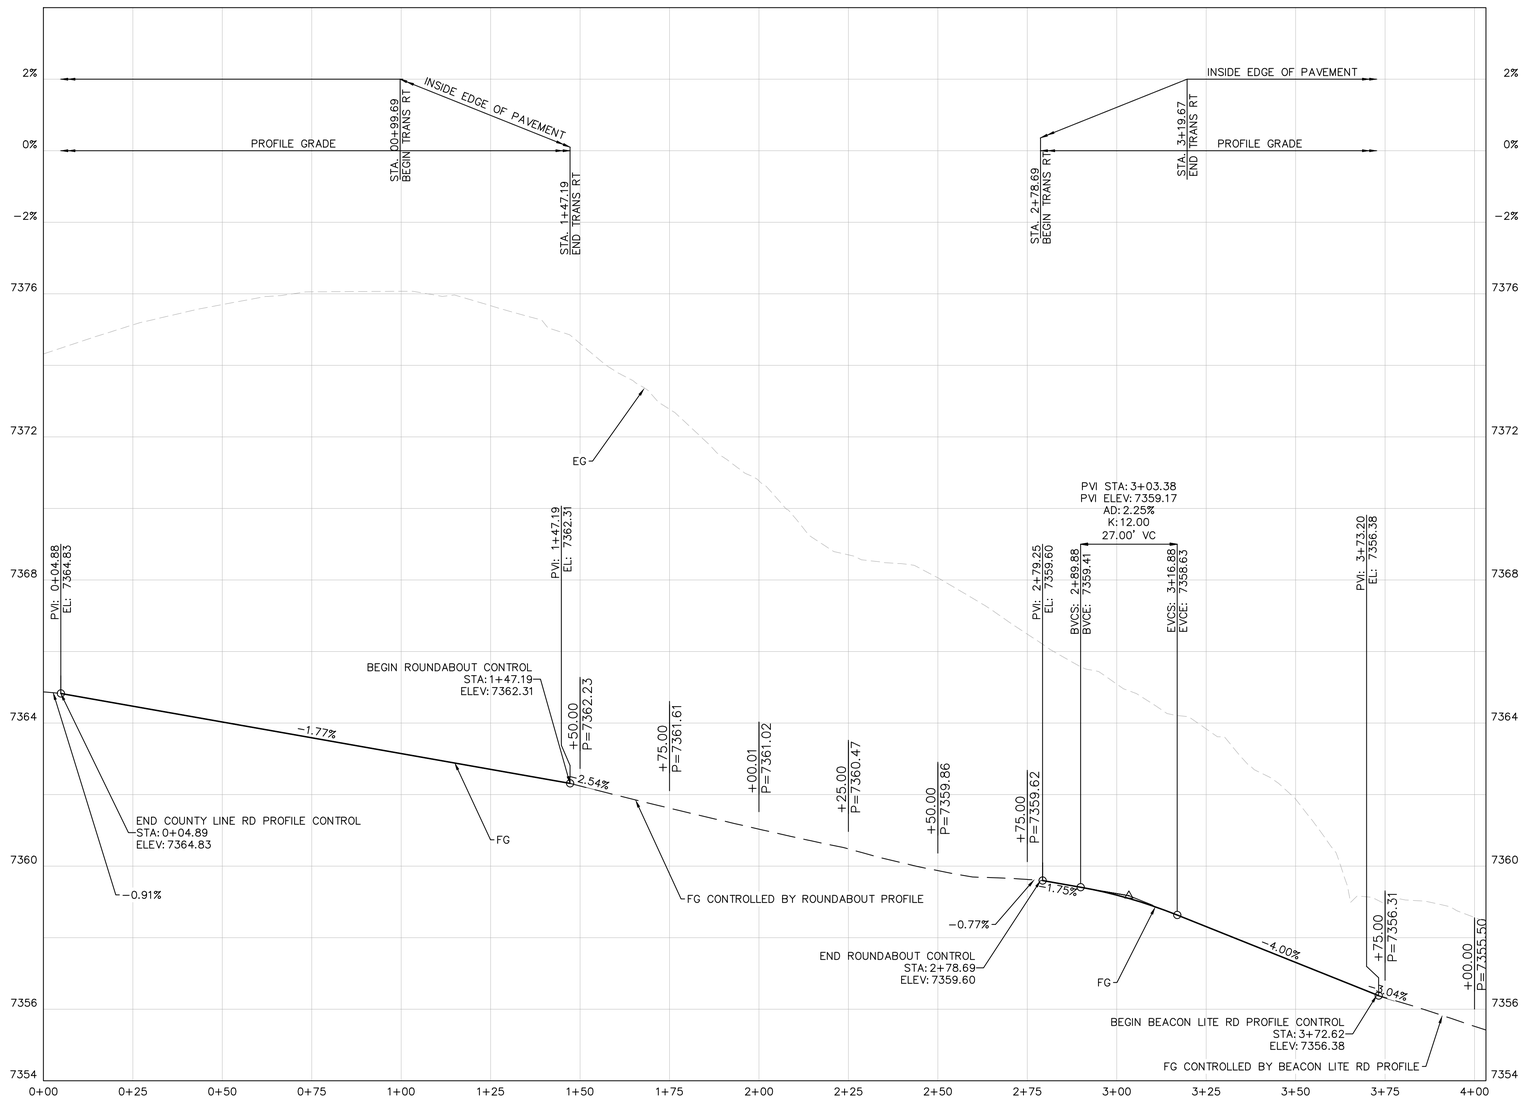

GRAPHIC SCALE IN FEET
0 10 20 40
HORIZONTAL

0 1 2 4
VERTICAL

811 Know what's below. Call before you dig.

This document, together with the concepts and designs presented herein, as an instrument of service, is intended only for the specific purpose and client for which it was prepared. Reuse of and improper reliance on this document without written authorization and adaptation by Kimley-Horn and Associates, Inc. shall be without liability to Kimley-Horn and Associates, Inc.

Print Date: 5/19/26
Drawing File Name: epc-06_roundabout detail 1.dwg

Kimley»Horn
KIMLEY-HORN AND ASSOCIATES, INC.
6200 SOUTH SYRACUSE WAY
SUITE 300
GREENWOOD VILLAGE, COLORADO 80111
(303) 228-2300

	Sheet Revisions		
	Date:	Comments:	Init.
R-X			
R-X			
R-X			
R-X			

EL PASO COUNTY
DEPARTMENT OF PUBLIC WORKS
3275 AKERS DRIVE
COLORADO SPRINGS, CO
80922

"R" - FINAL
FOR REVIEW ONLY
NOT FOR CONSTRUCTION
Kimley»Horn
Kimley-Horn and Associates, Inc.


60% PLANS
No Revisions:
Revised:
Void:

EL PASO COUNTY TRAVEL CENTER
PREPARED FOR
BUC-EE'S, LTD.
ROUNDABOUT PROFILES


Designer:	APW	Structure Numbers	
Detailer:	DJC		
Checked By:	MPF	Subset Sheet:	3 of 7

Project No./Code
KH 196094002
Sheet Number 26

COUNTY LINE RD
WESTBOUND RIGHT 1 MEDIAN (WB_RT_1)

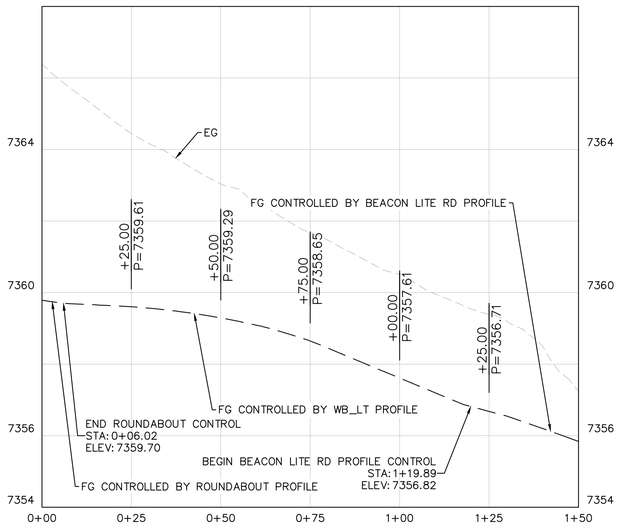

COUNTY LINE RD
WESTBOUND RIGHT 2 MEDIAN (WB_RT_2)

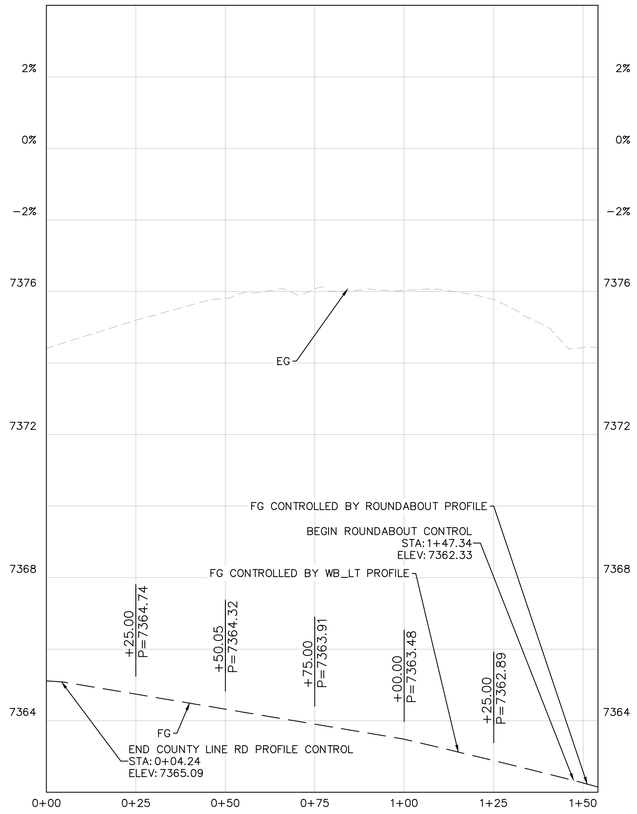

GRAPHIC SCALE IN FEET
0 10 20 40
HORIZONTAL

0 1 2 4
VERTICAL

Know what's **below.**
Call before you dig.

This document, together with the concepts and designs presented herein, as an instrument of service, is intended only for the specific purpose and client for which it was prepared. Reuse of and improper reliance on this document without written authorization and adaptation by Kimley-Horn and Associates, Inc. shall be without liability to Kimley-Horn and Associates, Inc.

Print Date: 5/19/26
Drawing File Name: epc-06_roundabout detail 1.dwg

Kimley»Horn
KIMLEY-HORN AND ASSOCIATES, INC.
6200 SOUTH SYRACUSE WAY
SUITE 300
GREENWOOD VILLAGE, COLORADO 80111
(303) 228-2300

	Sheet Revisions		
	Date:	Comments:	Init.
R-X			
R-X			
R-X			
R-X			

EL PASO COUNTY
DEPARTMENT OF PUBLIC WORKS
3275 AKERS DRIVE
COLORADO SPRINGS, CO
80922

FOR REVIEW ONLY
NOT FOR CONSTRUCTION
Kimley»Horn
Kimley-Horn and Associates, Inc.

60% PLANS

No Revisions:
Revised:
Void:

EL PASO COUNTY TRAVEL CENTER
PREPARED FOR
BUC-EE'S, LTD.
ROUNDABOUT PROFILES


Designer:	APW	Structure Numbers	
Detailer:	DJC		
Checked By:	MPF	Subset Sheet:	4 of 7

Project No./Code

KH 196094002

Sheet Number 27

BEACON LITE RD
NORTHBOUND RIGHT EOP (NB_RT)

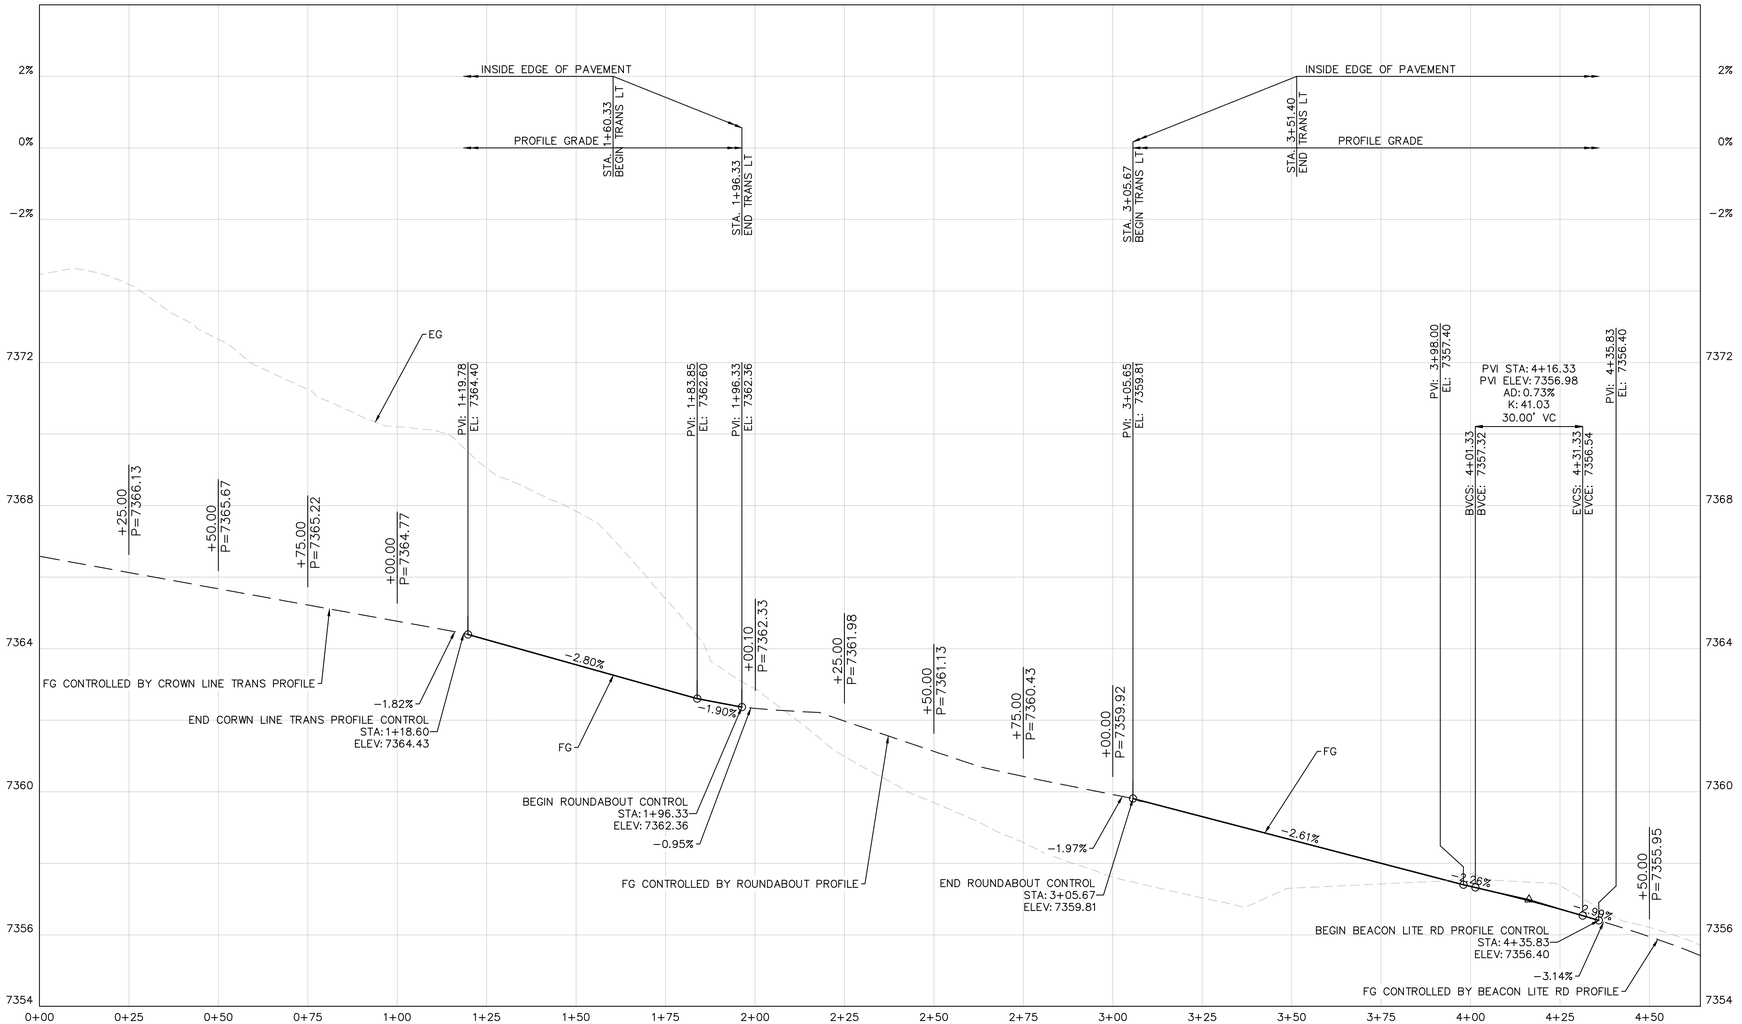

GRAPHIC SCALE IN FEET
0 10 20 40
HORIZONTAL

0 1 2 4
VERTICAL

Know what's **below.**
Call before you dig.

This document, together with the concepts and designs presented herein, as an instrument of service, is intended only for the specific purpose and client for which it was prepared. Reuse of and improper reliance on this document without written authorization and adaptation by Kimley-Horn and Associates, Inc. shall be without liability to Kimley-Horn and Associates, Inc.

Print Date: 5/19/26
Drawing File Name: epc-06_roundabout detail 1.dwg

Kimley»Horn
KIMLEY-HORN AND ASSOCIATES, INC.
6200 SOUTH SYRACUSE WAY
SUITE 300
GREENWOOD VILLAGE, COLORADO 80111
(303) 228-2300

Sheet Revisions

	Date:	Comments:	Init.
R-X			
R-X			
R-X			
R-X			

EL PASO COUNTY
DEPARTMENT OF PUBLIC WORKS
3275 AKERS DRIVE
COLORADO SPRINGS, CO
80922

FOR REVIEW ONLY
NOT FOR CONSTRUCTION
Kimley»Horn
Kimley-Horn and Associates, Inc.

60% PLANS

No Revisions:
Revised:
Void:


EL PASO COUNTY TRAVEL CENTER
PREPARED FOR
BUC-EE'S, LTD.
ROUNDABOUT PROFILES


Designer: APW
Detailer: DJC
Checked By: MPF
Structure Numbers:
Subset Sheet: 5 of 7

Project No./Code

KH 196094002

Sheet Number 28

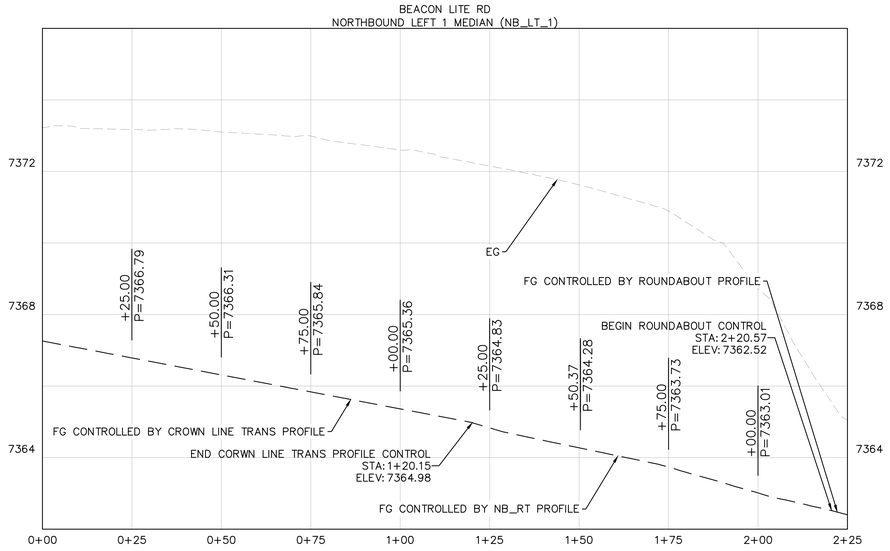

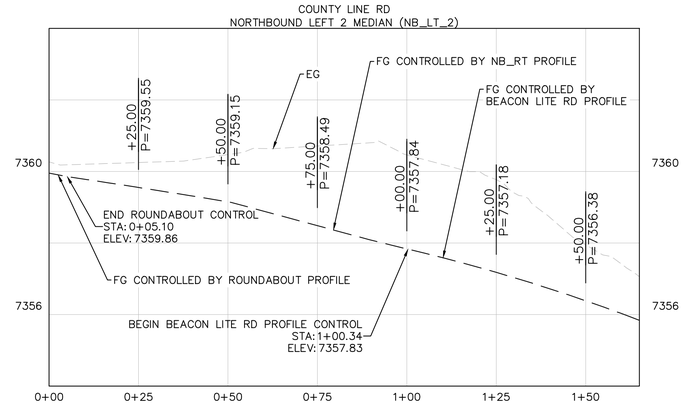

GRAPHIC SCALE IN FEET
0 10 20 40
HORIZONTAL

0 1 2 4
VERTICAL

811
Know what's **below.**
Call before you dig.

This document, together with the concepts and designs presented herein, as an instrument of service, is intended only for the specific purpose and client for which it was prepared. Reuse of and improper reliance on this document without written authorization and adaptation by Kimley-Horn and Associates, Inc. shall be without liability to Kimley-Horn and Associates, Inc.

Print Date: 5/19/26
Drawing File Name: epc-06_roundabout detail 1.dwg

Kimley»Horn
KIMLEY-HORN AND ASSOCIATES, INC.
6200 SOUTH SYRACUSE WAY
SUITE 300
GREENWOOD VILLAGE, COLORADO 80111
(303) 228-2300

Sheet Revisions

	Date:	Comments:	Init.
R-X			
R-X			
R-X			
R-X			

EL PASO COUNTY
DEPARTMENT OF PUBLIC WORKS
3275 AKERS DRIVE
COLORADO SPRINGS, CO
80922

FOR REVIEW ONLY
NOT FOR CONSTRUCTION
Kimley»Horn
Kimley-Horn and Associates, Inc.

60% PLANS

No Revisions:
Revised:
Void:


EL PASO COUNTY TRAVEL CENTER
PREPARED FOR
BUC-EE'S, LTD.
ROUNDABOUT PROFILES

Designer: APW
Detailer: DJC
Checked By: MPF
Structure Numbers:
Subset Sheet: 6 of 7

Project No./Code
KH 196094002
Sheet Number 29

This document, together with the concepts and designs presented herein, as an instrument of service, is intended only for this specific purpose and client for which it was prepared. Reuse of and improper reliance on this document without written authorization and adaptation by Kimley-Horn and Associates, Inc. shall be without liability to Kimley-Horn and Associates, Inc.

BEACON LITE RD AND COUNTY LINE RD
ROUNDABOUT

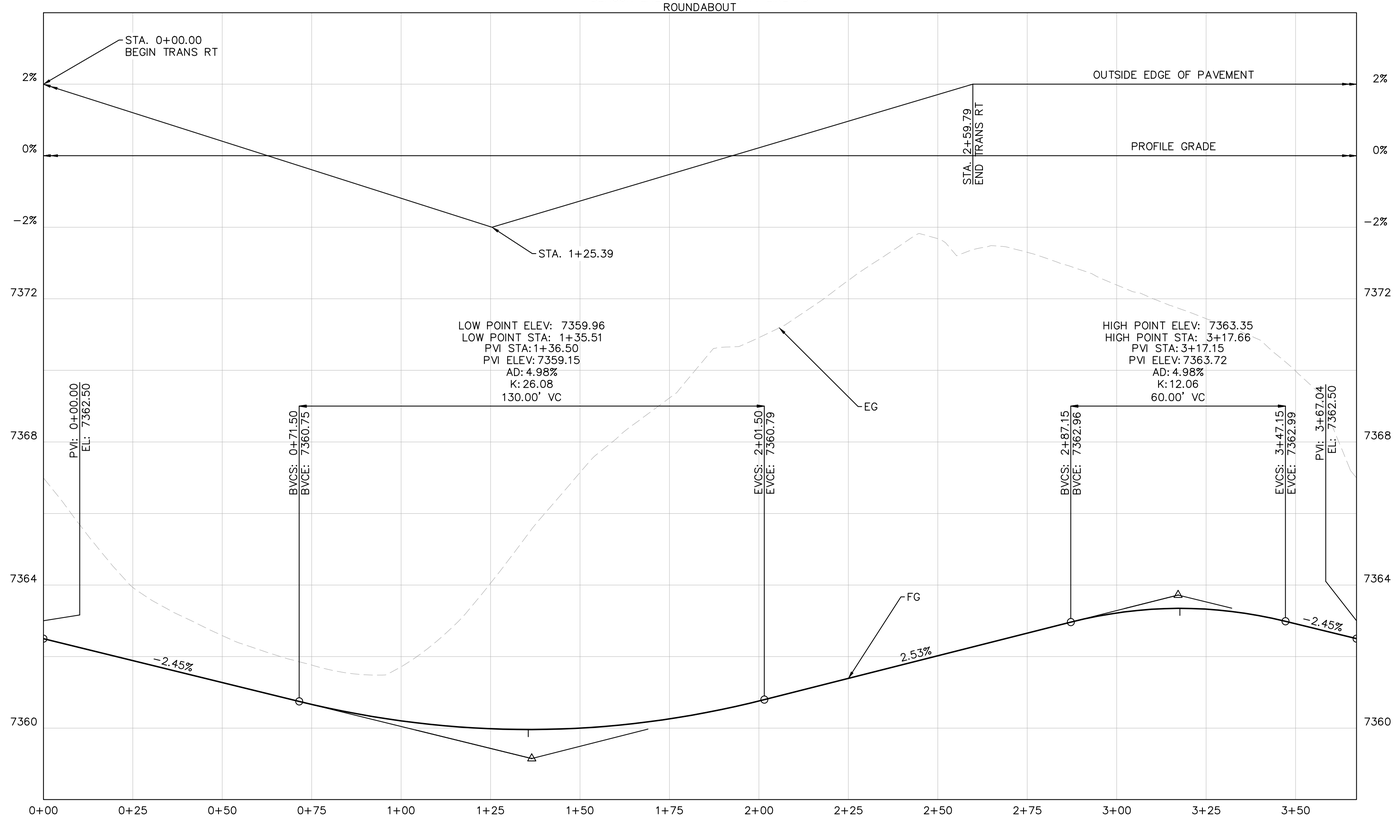

GRAPHIC SCALE IN FEET
0 10 20 40
HORIZONTAL

0 1 2 4
VERTICAL

811 Know what's **below.** **Call** before you dig.

Print Date: 5/19/26
Drawing File Name: epc-06_roundabout detail 1.dwg

Kimley»Horn
KIMLEY-HORN AND ASSOCIATES, INC.
6200 SOUTH SYRACUSE WAY
SUITE 300
GREENWOOD VILLAGE, COLORADO 80111
(303) 228-2300

	Sheet Revisions		
	Date:	Comments:	Init.
R-X			
R-X			
R-X			
R-X			

EL PASO COUNTY
DEPARTMENT OF PUBLIC WORKS
3275 AKERS DRIVE
COLORADO SPRINGS, CO
80922

FOR REVIEW ONLY
NOT FOR CONSTRUCTION
Kimley»Horn
Kimley-Horn and Associates, Inc.

60% PLANS
No Revisions:
Revised:
Void:


EL PASO COUNTY TRAVEL CENTER
PREPARED FOR
BUC-EE'S, LTD.
ROUNDABOUT PROFILES

Designer:	APW	Structure Numbers	
Detailer:	DJC		
Checked By:	MPF	Subset Sheet:	7 of 7

Project No./Code

KH 196094002

Sheet Number 30

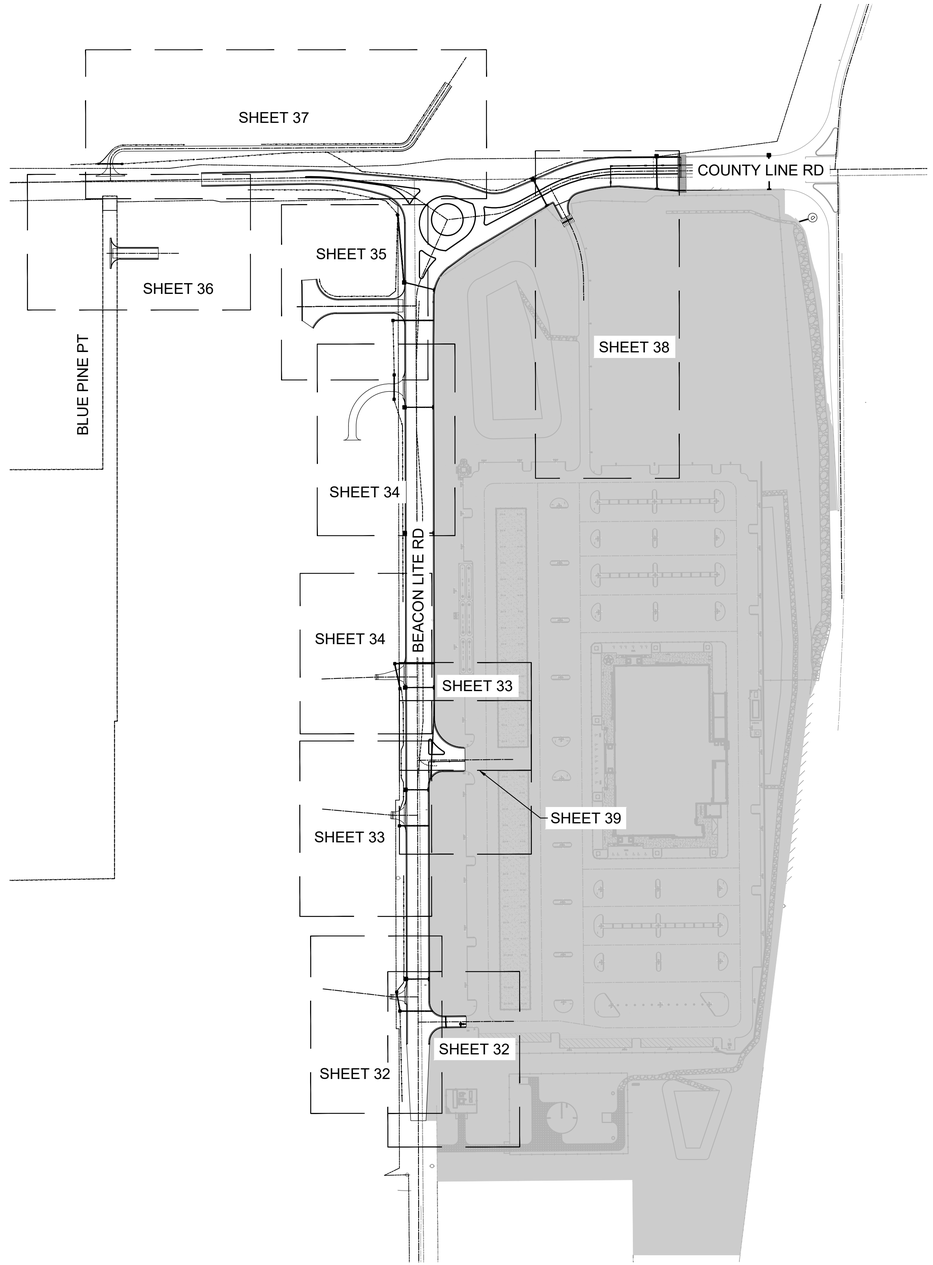

LEGEND:

ONSITE HATCH

NORTH

GRAPHIC SCALE IN FEET
0 75 150 300

811
Know what's **below.**
Call before you dig.

This document, together with the concepts and designs presented herein, as an instrument of service, is intended only for the specific purpose and client for which it was prepared. Reuse of and improper reliance on this document without written authorization and adaptation by Kimley-Horn and Associates, Inc. shall be without liability to Kimley-Horn and Associates, Inc.

Print Date: 5/19/26

Drawing File Name: epc-06.5_ driveway plan and profiles (km).dwg

Kimley»Horn
KIMLEY-HORN AND ASSOCIATES, INC.
6200 SOUTH SYRACUSE WAY
SUITE 300
GREENWOOD VILLAGE, COLORADO 80111
(303) 228-2300

	Sheet Revisions		
	Date:	Comments:	Init.
R-X			
R-X			
R-X			
R-X			

EL PASO COUNTY
DEPARTMENT OF PUBLIC WORKS
3275 AKERS DRIVE
COLORADO SPRINGS, CO
80922

FOR REVIEW ONLY
NOT FOR CONSTRUCTION
Kimley»Horn
Kimley-Horn and Associates, Inc.

60% PLANS

No Revisions:

Revised:

Void:


EL PASO COUNTY TRAVEL CENTER
PREPARED FOR
BUC-EE'S, LTD.
ROADWAY DETAIL SHEETS

Designer:	APW	Structure Numbers	
Detailer:	DJC		
Checked By:	MPF	Subset Sheet:	1 of 9


Project No./Code

KH 196094002


Sheet Number 31

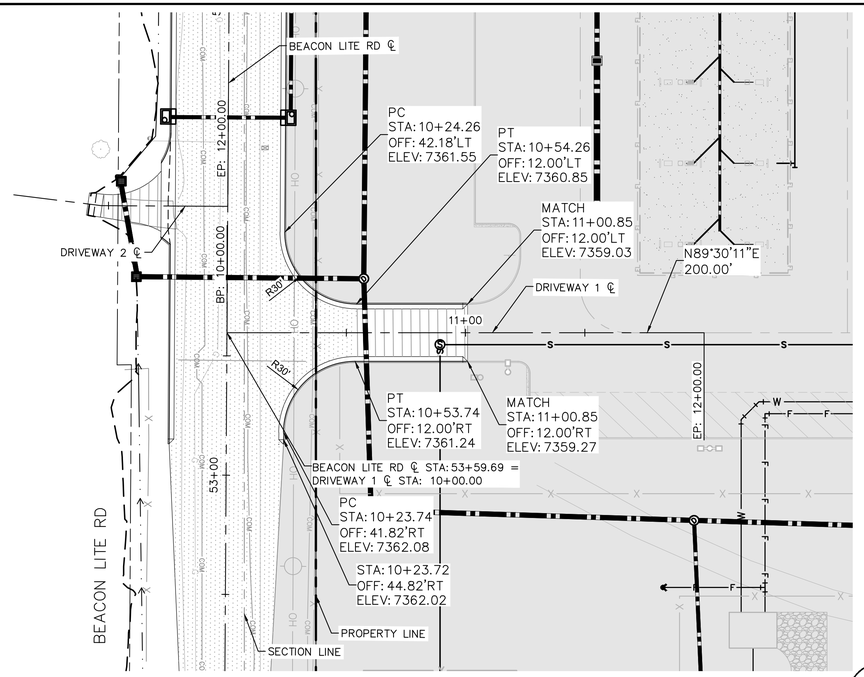

DRIVEWAY 1 PLAN

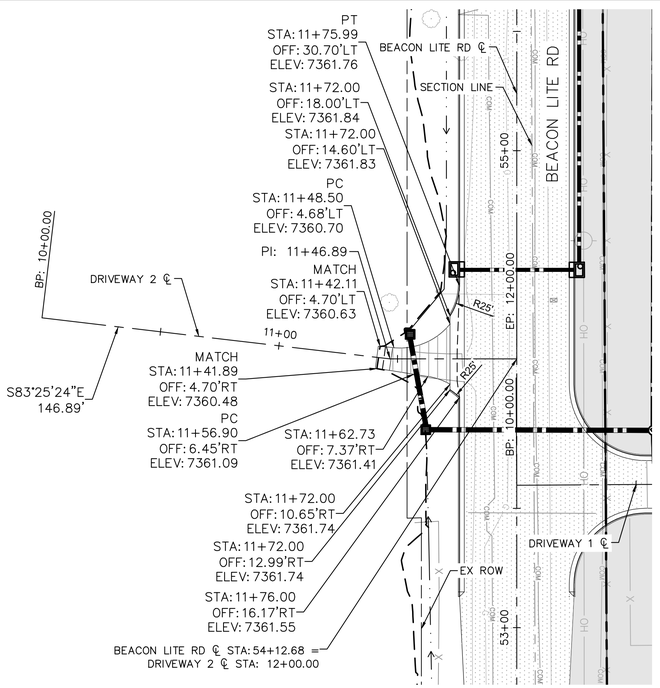


DRIVEWAY 2 PLAN

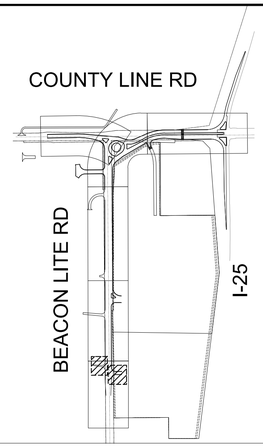


LEGEND:

- GRADING LIMIT
- CROWN TRANSITION LINE
- ONSITE HATCH
- PROPOSED ASPHALT (COUNTY LINE ROAD
- PROPOSED ASPHALT (BEACON LITE ROAD)
- PROPOSED ASPHALT (DRIVEWAYS)
- PROPOSED ABC (ACCESS ROAD)
- PROPOSED CONCRETE PAVEMENT (TRUCK APRON)
- PROPOSED SOD
- PROPOSED CONCRETE MEDIAN

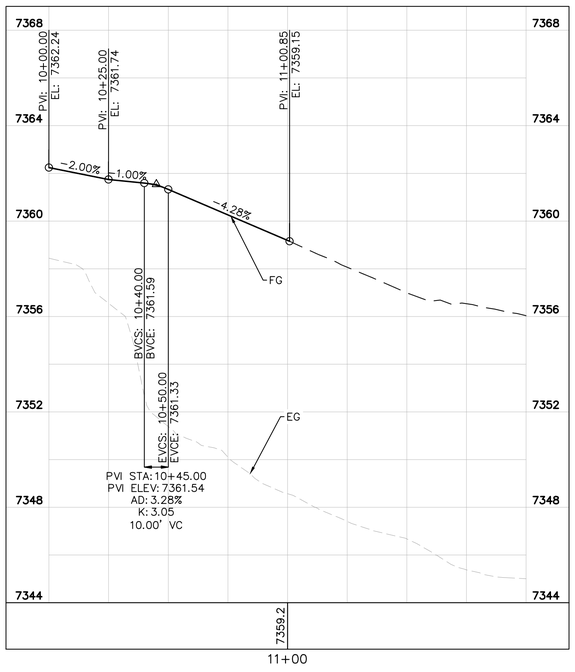

DRIVEWAY 1 PROFILE

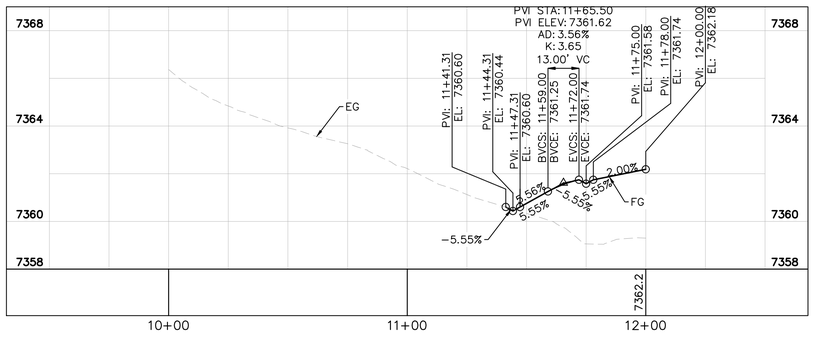

DRIVEWAY 2 PROFILE

GRAPHIC SCALE IN FEET
0 15 30 60
HORIZONTAL
VERTICAL
6
3
1.5
0

Know what's below. Call before you dig.

This document, together with the concepts and designs presented herein, as an instrument of service, is intended only for the specific purpose and client for which it was prepared. Reuse of and improper reliance on this document without written authorization and adaptation by Kimley-Horn and Associates, Inc. shall be without liability to Kimley-Horn and Associates, Inc.

Print Date: 5/19/26

Drawing File Name: epc-06.5_driveway plan and profiles.dwg

Kimley»Horn
KIMLEY-HORN AND ASSOCIATES, INC.
6200 SOUTH SYRACUSE WAY
SUITE 300
GREENWOOD VILLAGE, COLORADO 80111
(303) 228-2300

Sheet Revisions		
Date:	Comments:	Init.

EL PASO COUNTY
DEPARTMENT OF PUBLIC WORKS
3275 AKERS DRIVE
COLORADO SPRINGS, CO
80922

FOR REVIEW ONLY
NOT FOR CONSTRUCTION
Kimley»Horn
Kimley-Horn and Associates, Inc.

60% PLANS

No Revisions:

Revised:

Void:


EL PASO COUNTY TRAVEL CENTER
PREPARED FOR
BUC-EE'S, LTD.
ROADWAY DETAIL SHEETS

Designer:	APW	Structure Numbers	
Detailer:	DJC		
Checked By:	MPF	Subset Sheet:	2 of 9


Project No./Code

KH 196094002


Sheet Number 32

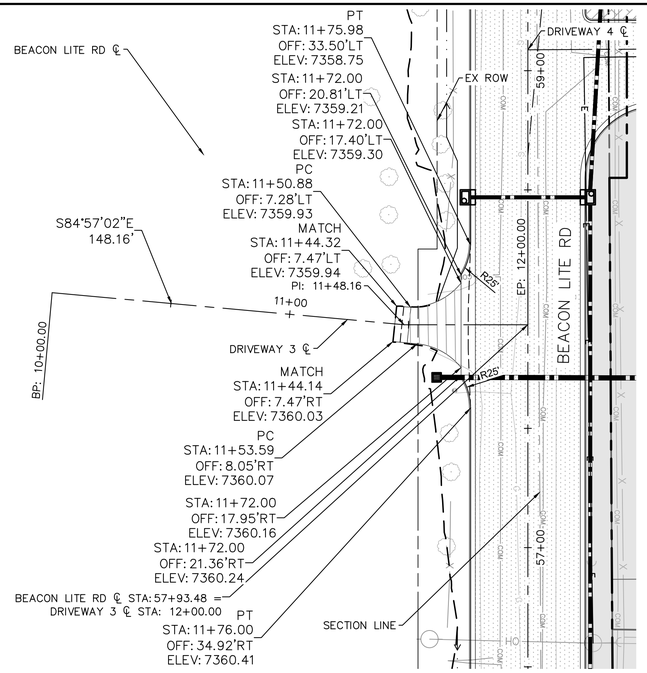

DRIVEWAY 3 PLAN

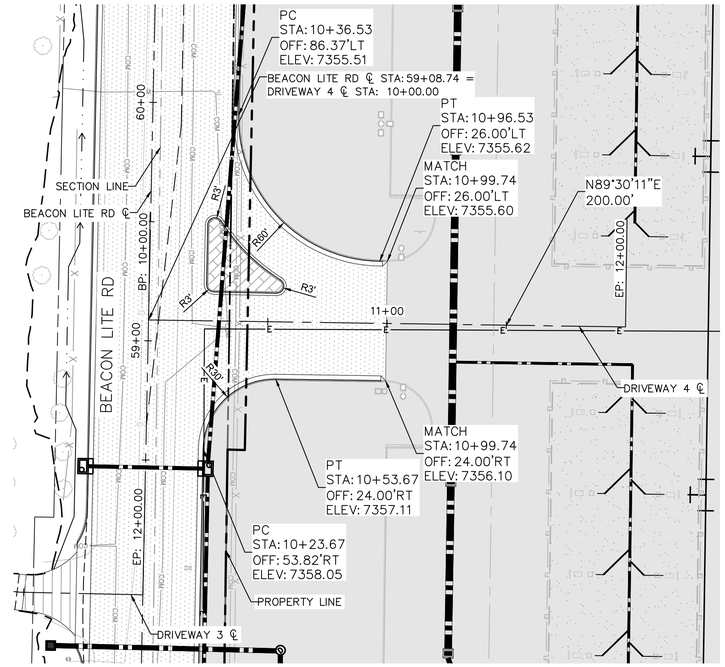


DRIVEWAY 4 PLAN

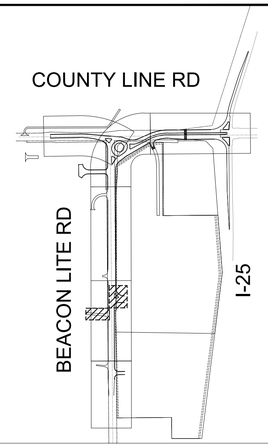


LEGEND:

- GRADING LIMIT
- CROWN TRANSITION LINE
- ONSITE HATCH
- PROPOSED ASPHALT (COUNTY LINE ROAD
- PROPOSED ASPHALT (BEACON LITE ROAD)
- PROPOSED ASPHALT (DRIVEWAYS)
- PROPOSED ABC (ACCESS ROAD)
- PROPOSED CONCRETE PAVEMENT (TRUCK APRON)
- PROPOSED SOD
- PROPOSED CONCRETE MEDIAN

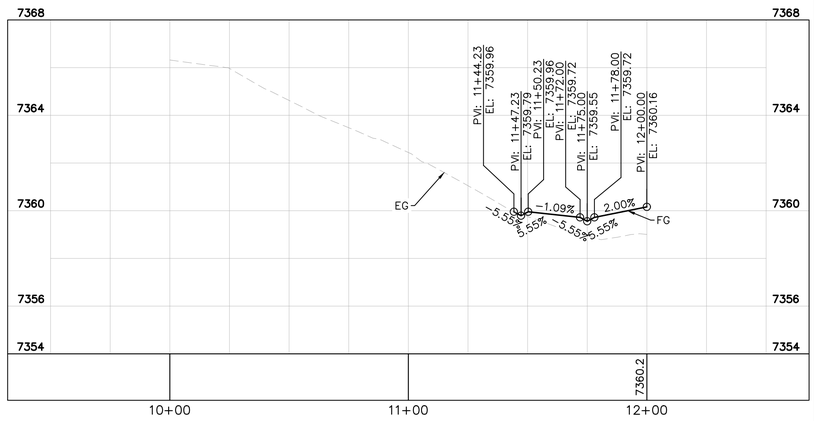

DRIVEWAY 3 PROFILE

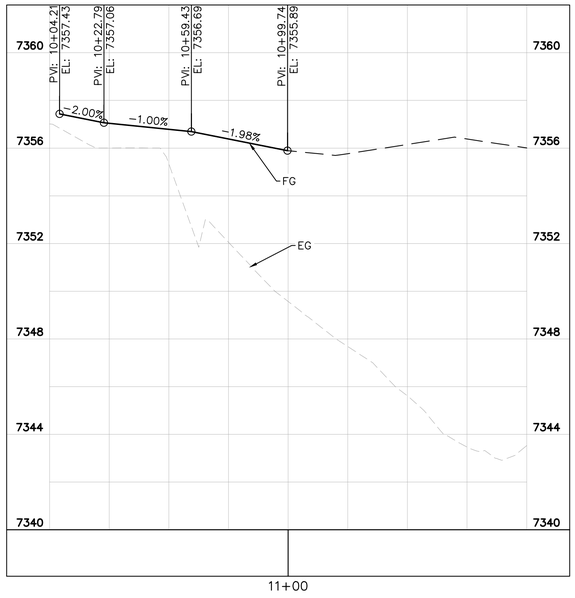

DRIVEWAY 4 PROFILE

GRAPHIC SCALE IN FEET
0 15 30 60
HORIZONTAL
VERTICAL 6 3 1.5 0

811 Know what's below. Call before you dig.

This document, together with the concepts and designs presented herein, as an instrument of service, is intended only for the specific purpose and client for which it was prepared. Reuse of and improper reliance on this document without written authorization and adaptation by Kimley-Horn and Associates, Inc. shall be without liability to Kimley-Horn and Associates, Inc.

Print Date: 5/19/26
Drawing File Name: epc-06.5_driveway plan and profiles.dwg

Kimley»Horn
KIMLEY-HORN AND ASSOCIATES, INC.
6200 SOUTH SYRACUSE WAY
SUITE 300
GREENWOOD VILLAGE, COLORADO 80111
(303) 228-2300

Sheet Revisions

	Date:	Comments:	Init.
R-X			
R-X			
R-X			
R-X			

EL PASO COUNTY
DEPARTMENT OF PUBLIC WORKS
3275 AKERS DRIVE
COLORADO SPRINGS, CO
80922


R**-FINAL
FOR REVIEW ONLY
NOT FOR CONSTRUCTION
Kimley»Horn
Kimley-Horn and Associates, Inc.

60% PLANS
No Revisions:
Revised:
Void:

EL PASO COUNTY TRAVEL CENTER
PREPARED FOR
BUC-EE'S, LTD.
ROADWAY DETAIL SHEETS

Designer:	APW	Structure Numbers	
Detailer:	DJC		
Checked By:	MPF	Subset Sheet:	3 of 9


Project No./Code
KH 196094002
Sheet Number 33

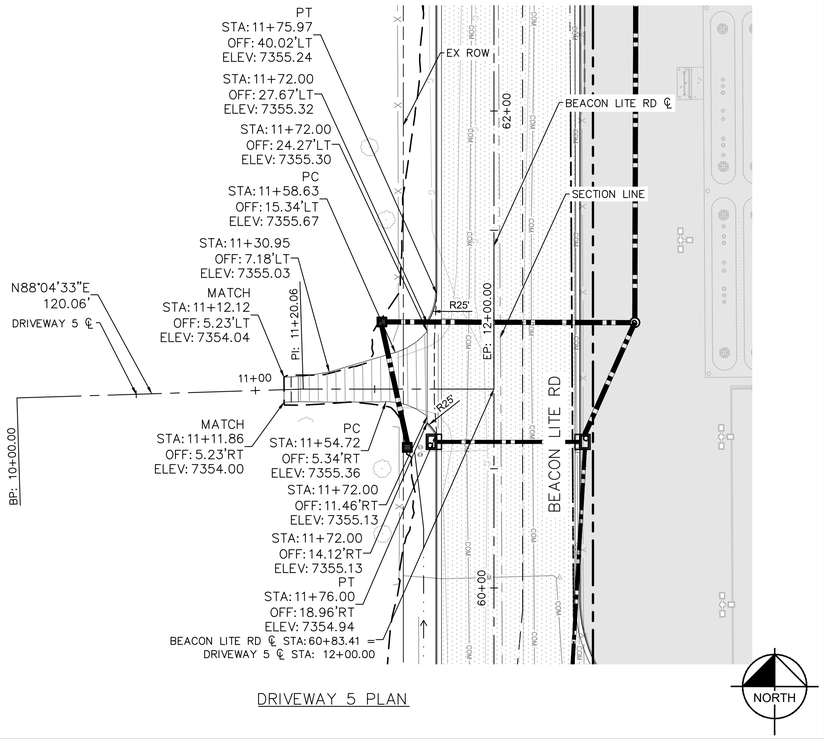

DRIVEWAY 5 PLAN


NORTH

POINT	STA	OFF	ELEV
1	12+22.00	22.38'LT	7368.09
2	12+22.00	18.03'LT	7367.68
3	12+22.00	18.03'RT	7368.29
4	12+22.00	22.38'RT	7368.83

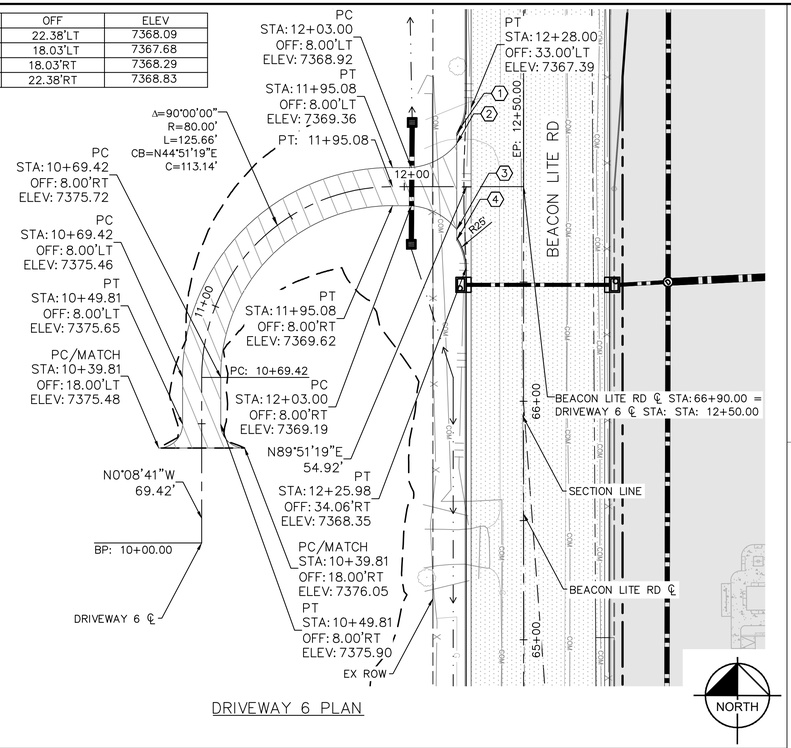


DRIVEWAY 6 PLAN


NORTH

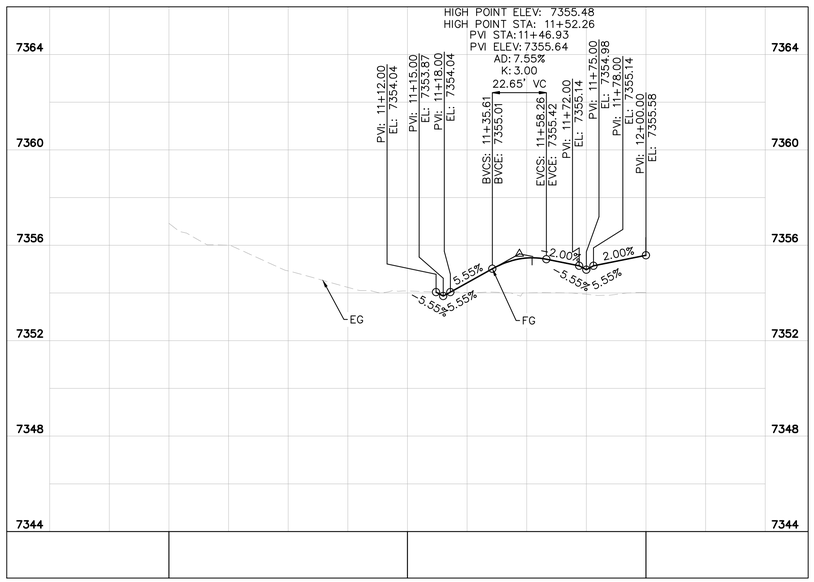

DRIVEWAY 5 PROFILE

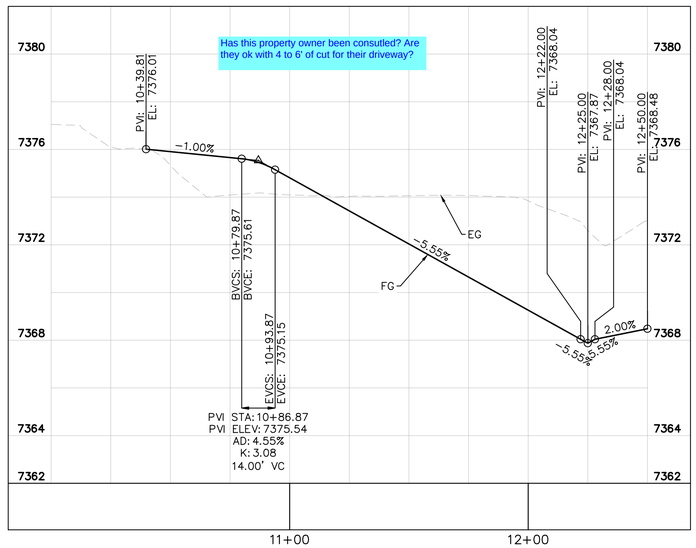

DRIVEWAY 6 PROFILE

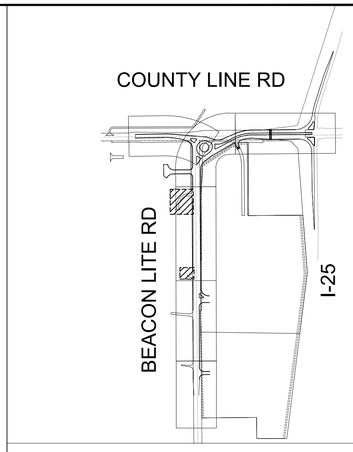

LEGEND:

- GRADING LIMIT
- CROWN TRANSITION LINE
- ONSITE HATCH
- PROPOSED ASPHALT (COUNTY LINE ROAD
- PROPOSED ASPHALT (BEACON LITE ROAD)
- PROPOSED ASPHALT (DRIVEWAYS)
- PROPOSED ABC (ACCESS ROAD)
- PROPOSED CONCRETE PAVEMENT (TRUCK APRON)
- PROPOSED SOD
- PROPOSED CONCRETE MEDIAN

GRAPHIC SCALE IN FEET
0 15 30 60
HORIZONTAL
VERTICAL 6 3 1.5 0

811 Know what's below. Call before you dig.

This document, together with the concepts and designs presented herein, as an instrument of service, is intended only for the specific purpose and client for which it was prepared. Reuse of and improper reliance on this document without written authorization and adaptation by Kimley-Horn and Associates, Inc. shall be without liability to Kimley-Horn and Associates, Inc.

Print Date: 5/19/26
Drawing File Name: epc-06.5_driveway plan and profiles.dwg

Kimley»Horn
KIMLEY-HORN AND ASSOCIATES, INC.
6200 SOUTH SYRACUSE WAY
SUITE 300
GREENWOOD VILLAGE, COLORADO 80111
(303) 228-2300

Sheet Revisions

	Date:	Comments:	Init.
R-X			
R-X			
R-X			
R-X			

EL PASO COUNTY
DEPARTMENT OF PUBLIC WORKS
3275 AKERS DRIVE
COLORADO SPRINGS, CO
80922


R-# - FINAL
FOR REVIEW ONLY
NOT FOR CONSTRUCTION
Kimley»Horn
Kimley-Horn and Associates, Inc.

60% PLANS
No Revisions:
Revised:
Void:


EL PASO COUNTY TRAVEL CENTER
PREPARED FOR
BUC-EE'S, LTD.
ROADWAY DETAIL SHEETS

Designer: APW
Detailer: DJC
Checked By: MPF
Structure Numbers
Subset Sheet: 4 of 9


Project No./Code
KH 196094002
Sheet Number 34

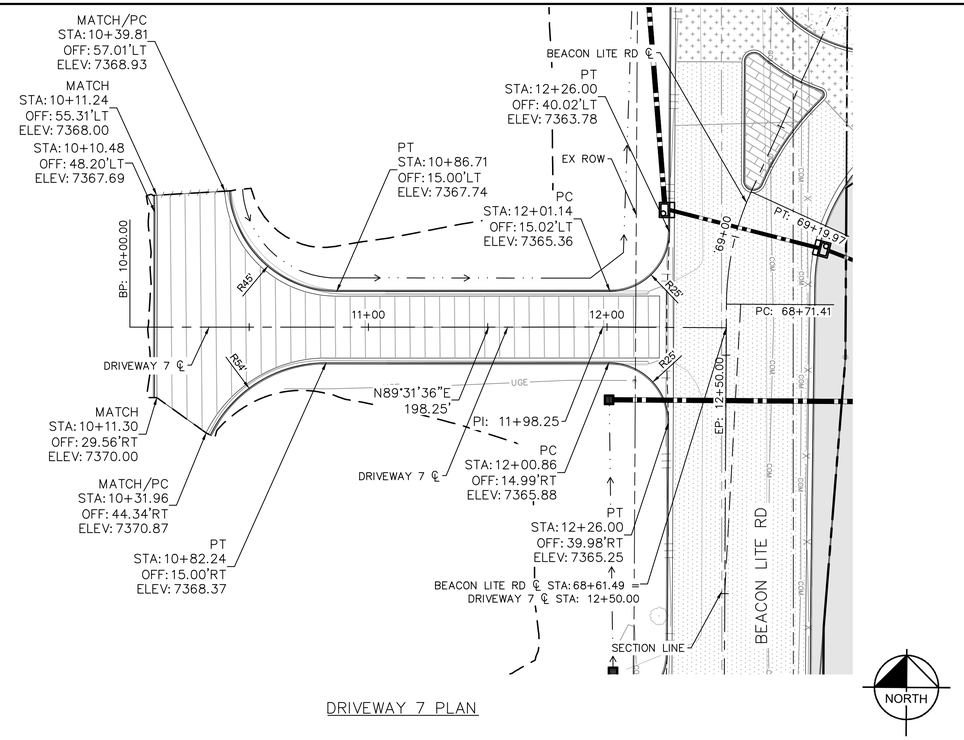

DRIVEWAY 7 PLAN

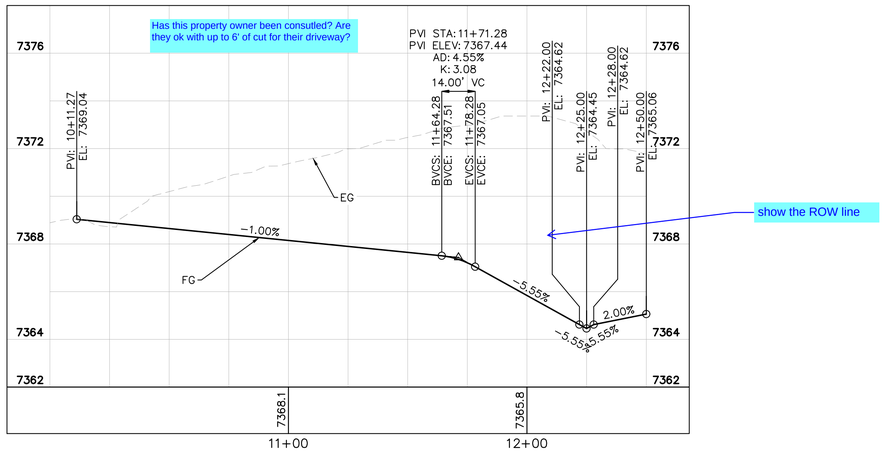

DRIVEWAY 7 PROFILE

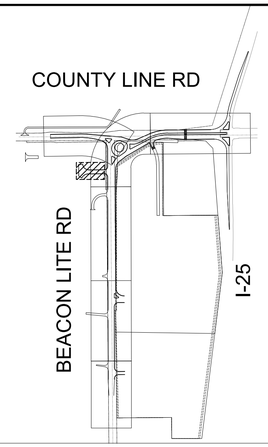

LEGEND:

- GRADING LIMIT
- CROWN TRANSITION LINE
- ONSITE HATCH
- PROPOSED ASPHALT (COUNTY LINE ROAD
- PROPOSED ASPHALT (BEACON LITE ROAD)
- PROPOSED ASPHALT (DRIVEWAYS)
- PROPOSED ABC (ACCESS ROAD)
- PROPOSED CONCRETE PAVEMENT (TRUCK APRON)
- PROPOSED SOD
- PROPOSED CONCRETE MEDIAN

GRAPHIC SCALE IN FEET
0 15 30 60
HORIZONTAL
VERTICAL 6 3 1.5 0

811 Know what's below. Call before you dig.

This document, together with the concepts and designs presented herein, as an instrument of service, is intended only for the specific purpose and client for which it was prepared. Reuse of and improper reliance on this document without written authorization and adaptation by Kimley-Horn and Associates, Inc. shall be without liability to Kimley-Horn and Associates, Inc.

Print Date: 5/19/26
Drawing File Name: epc-06.5_driveway plan and profiles.dwg

Kimley»Horn
KIMLEY-HORN AND ASSOCIATES, INC.
6200 SOUTH SYRACUSE WAY
SUITE 300
GREENWOOD VILLAGE, COLORADO 80111
(303) 228-2300

Sheet Revisions

	Date:	Comments:	Init.
R-X			
R-X			
R-X			
R-X			

EL PASO COUNTY
DEPARTMENT OF PUBLIC WORKS
3275 AKERS DRIVE
COLORADO SPRINGS, CO
80922


FOR REVIEW ONLY
NOT FOR CONSTRUCTION
Kimley»Horn
Kimley-Horn and Associates, Inc.

60% PLANS
No Revisions:
Revised:
Void:


EL PASO COUNTY TRAVEL CENTER
PREPARED FOR
BUC-EE'S, LTD.
ROADWAY DETAIL SHEETS

Designer: APW
Detailer: DJC
Checked By: MPF
Structure Numbers
Subset Sheet: 5 of 9

Project No./Code
KH 196094002
Sheet Number 35

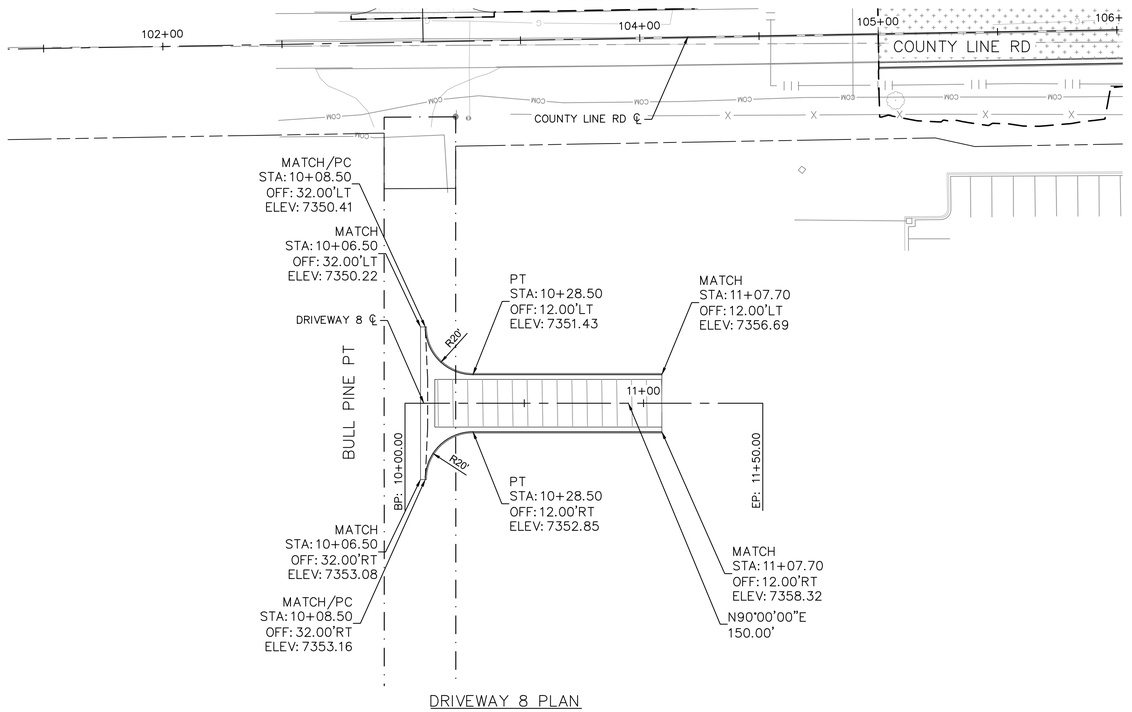


DRIVEWAY 8 PLAN

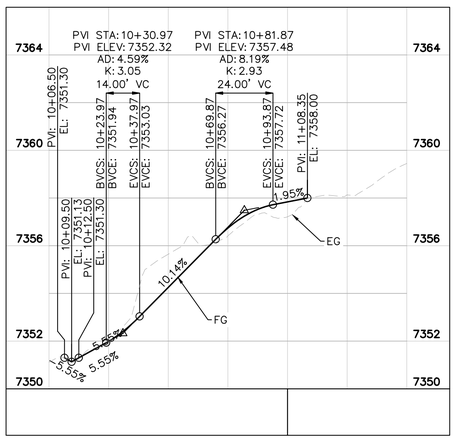

DRIVEWAY 8 PROFILE

NOTE:
THIS DRIVEWAY PROFILE IS BASED ON AVAILABLE GIS SURFACE DATA. THE CONTRACTOR SHALL FIELD VERIFY EXISTING CONDITIONS PRIOR TO CONSTRUCTION. IF ACTUAL SITE CONDITIONS DIFFER SIGNIFICANTLY FROM THOSE SHOWN, OR IF THE INTENDED VERTICAL GEOMETRY CANNOT BE ACHIEVED, THE CONTRACTOR SHALL NOTIFY THE ENGINEER FOR FURTHER DIRECTION.

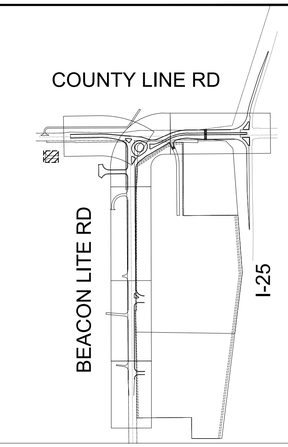

LEGEND:

- GRADING LIMIT
- CROWN TRANSITION LINE
- ONSITE HATCH
- PROPOSED ASPHALT (COUNTY LINE ROAD
- PROPOSED ASPHALT (BEACON LITE ROAD)
- PROPOSED ASPHALT (DRIVEWAYS)
- PROPOSED ABC (ACCESS ROAD)
- PROPOSED CONCRETE PAVEMENT (TRUCK APRON)
- PROPOSED SOD
- PROPOSED CONCRETE MEDIAN

NORTH

GRAPHIC SCALE IN FEET
0 15 30 60
HORIZONTAL
VERTICAL 6 3 1.5 0

Know what's **below.** **Call** before you dig.

This document, together with the concepts and designs presented herein, as an instrument of service, is intended only for the specific purpose and client for which it was prepared. Reuse of and improper reliance on this document without written authorization and adaptation by Kimley-Horn and Associates, Inc. shall be without liability to Kimley-Horn and Associates, Inc.

Print Date: 5/19/26
Drawing File Name: epc-06.5_driveway plan and profiles.dwg

Kimley»Horn
KIMLEY-HORN AND ASSOCIATES, INC.
6200 SOUTH SYRACUSE WAY
SUITE 300
GREENWOOD VILLAGE, COLORADO 80111
(303) 228-2300

Sheet Revisions

	Date:	Comments:	Init.
R-X			
R-X			
R-X			
R-X			

EL PASO COUNTY
DEPARTMENT OF PUBLIC WORKS
3275 AKERS DRIVE
COLORADO SPRINGS, CO
80922

FOR REVIEW ONLY
NOT FOR CONSTRUCTION
Kimley»Horn
Kimley-Horn and Associates, Inc.


60% PLANS
No Revisions:
Revised:
Void:

EL PASO COUNTY TRAVEL CENTER
PREPARED FOR
BUC-EE'S, LTD.
ROADWAY DETAIL SHEETS


Designer: APW
Detailer: DJC
Checked By: MPF
Structure Numbers:
Subset Sheet: 6 of 9

Project No./Code
KH 196094002
Sheet Number 36


NOTE:
THIS DRIVEWAY PROFILE IS BASED ON AVAILABLE GIS SURFACE DATA. THE CONTRACTOR SHALL FIELD VERIFY EXISTING CONDITIONS PRIOR TO CONSTRUCTION. IF ACTUAL SITE CONDITIONS DIFFER SIGNIFICANTLY FROM THOSE SHOWN, OR IF THE INTENDED VERTICAL GEOMETRY CANNOT BE ACHIEVED, THE CONTRACTOR SHALL NOTIFY THE ENGINEER FOR FURTHER DIRECTION.

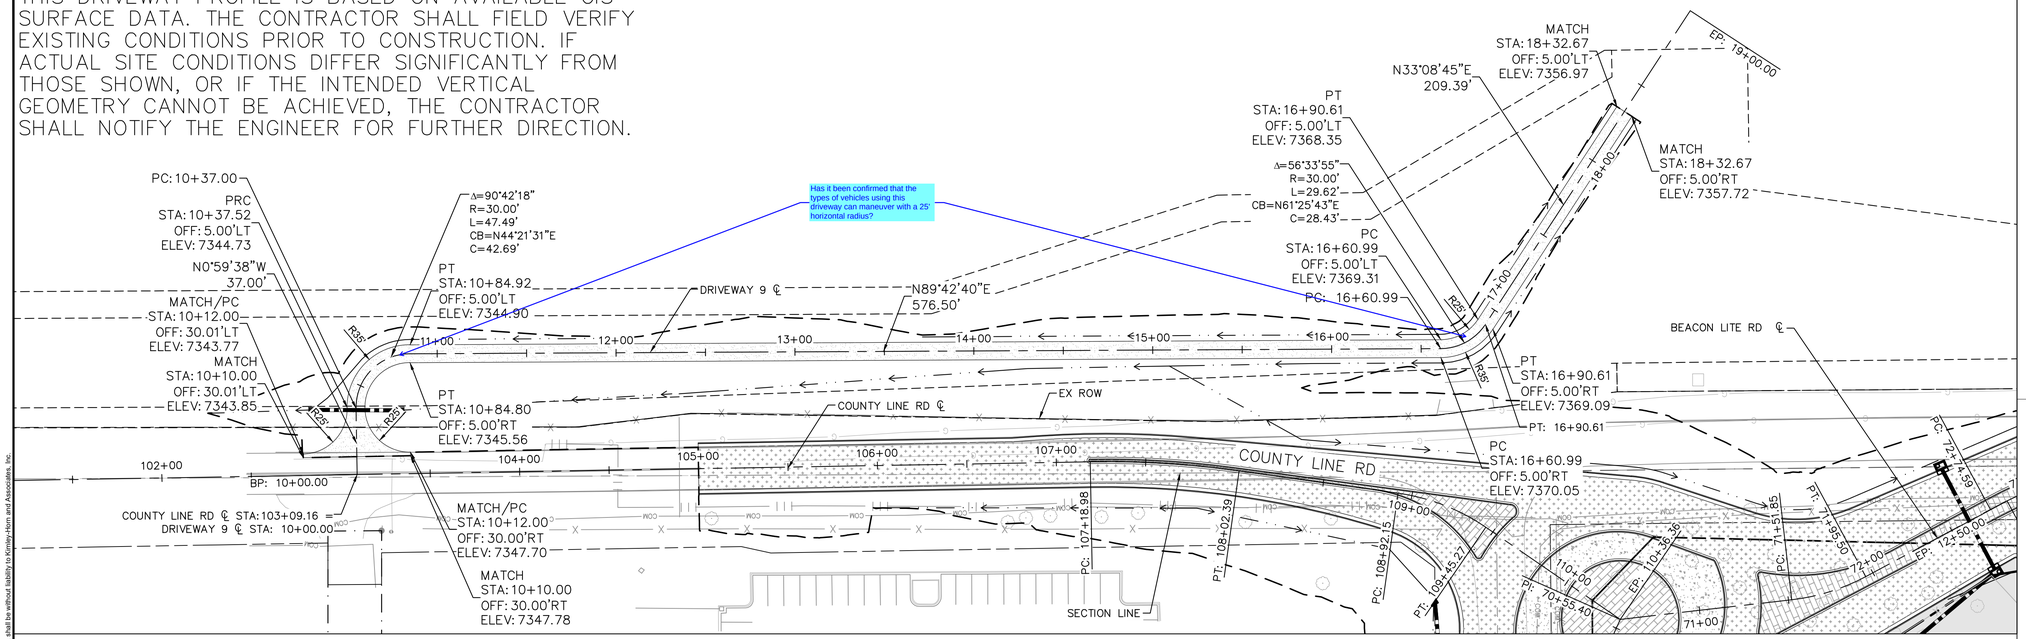

DRIVEWAY 9 PLAN

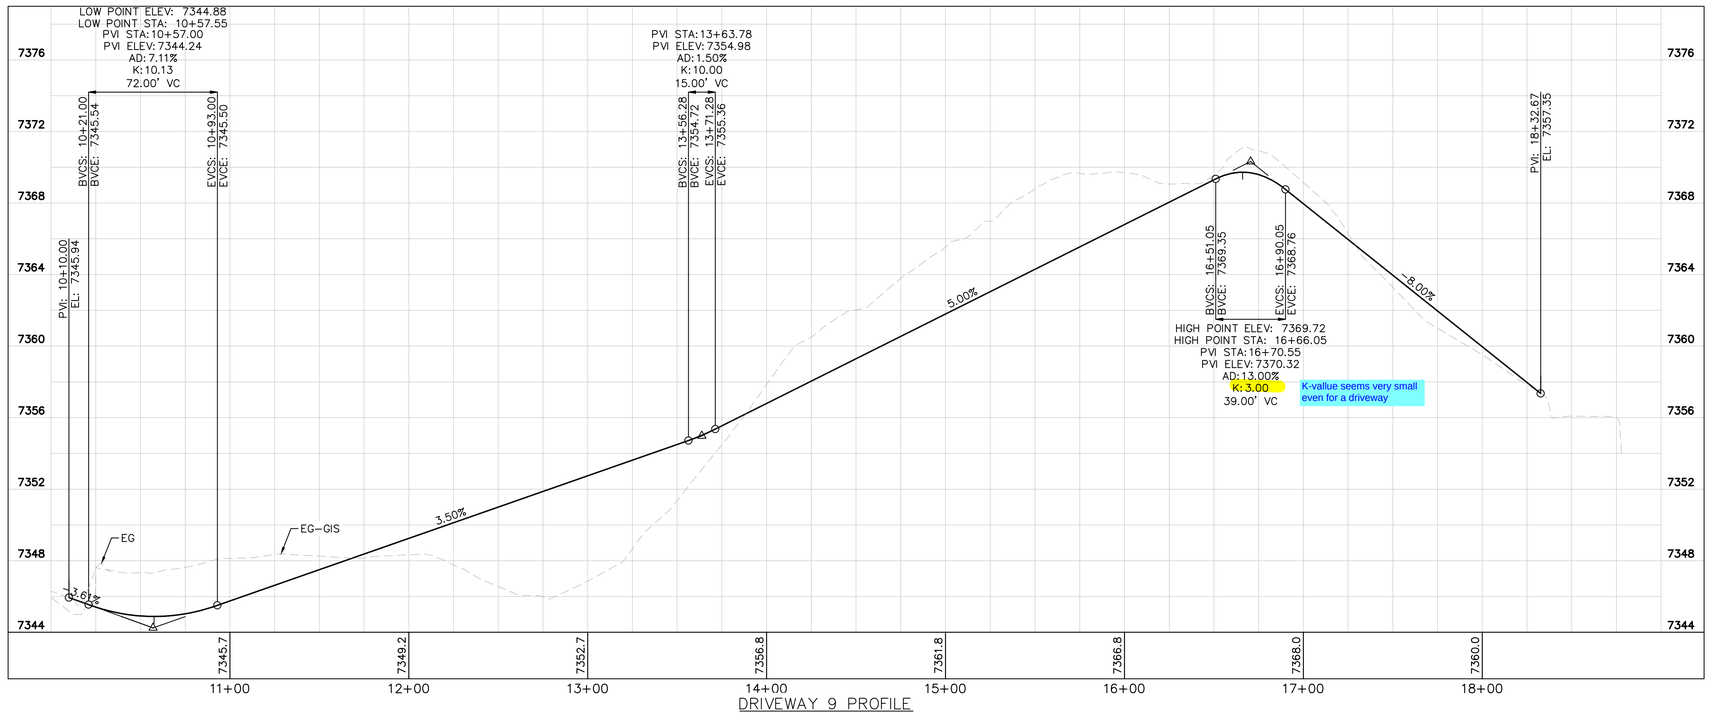

DRIVEWAY 9 PROFILE

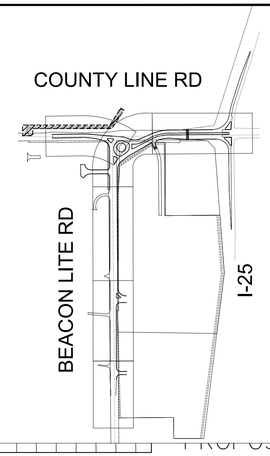

(DRIVEWAYS)
PROPOSED AB
(ACCESS ROA
PROPOSED CO
PAVEMENT (TR
PROPOSED SO
PROPOSED CO

GRAPHIC SCALE IN FEET
0 20 40 80
HORIZONTAL
8 4 2 0
VERTICAL

NORTH

811
Know what's below.
Call before you dig.

This document, together with the concepts and designs presented herein, as an instrument of service, is intended only for the specific purpose and client for which it was prepared. Reuse of and improper reliance on this document without written authorization and adaptation by Kimley-Horn and Associates, Inc. shall be without liability to Kimley-Horn and Associates, Inc.

Print Date: 5/19/26
Drawing File Name: epc-06.5_driveway plan and profiles.dwg

Kimley»Horn
KIMLEY-HORN AND ASSOCIATES, INC.
6200 SOUTH SYRACUSE WAY
SUITE 300
GREENWOOD VILLAGE, COLORADO 80111
(303) 228-2300

Sheet Revisions		
Date:	Comments:	Init.
R-X		
R-X		
R-X		
R-X		

EL PASO COUNTY
DEPARTMENT OF PUBLIC WORKS
3275 AKERS DRIVE
COLORADO SPRINGS, CO
80922


FOR REVIEW ONLY
NOT FOR CONSTRUCTION
Kimley»Horn
Kimley-Horn and Associates, Inc.

60% PLANS
No Revisions:
Revised:
Void:


EL PASO COUNTY TRAVEL CENTER
PREPARED FOR
BUC-EE'S, LTD.
ROADWAY DETAIL SHEETS

Designer:	APW	Structure Numbers	
Detailer:	DJC		
Checked By:	MPF	Subset Sheet:	7 of 9


Project No./Code
KH 196094002
Sheet Number 37

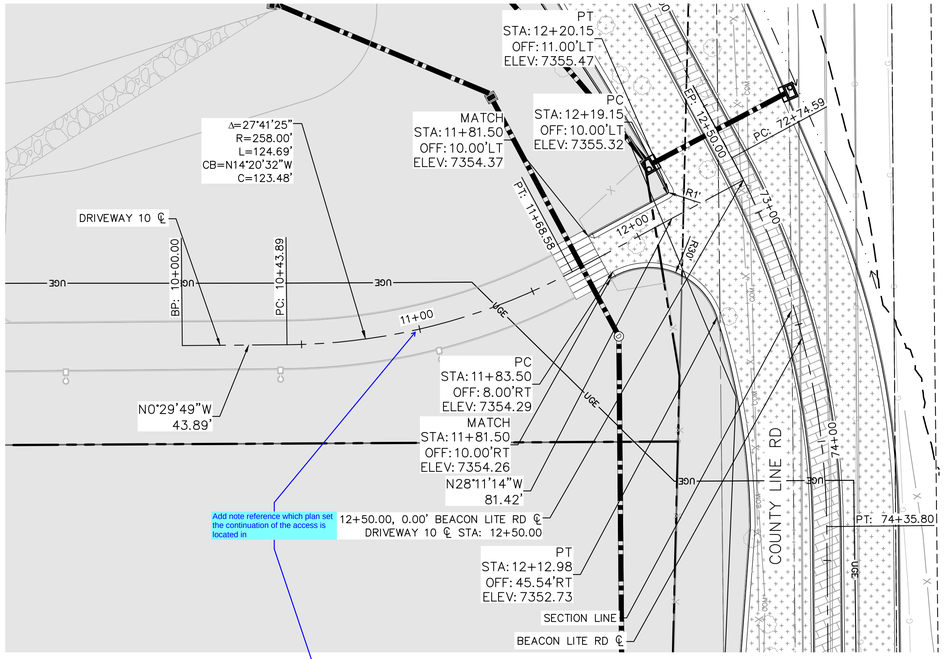

DRIVEWAY 10 PLAN

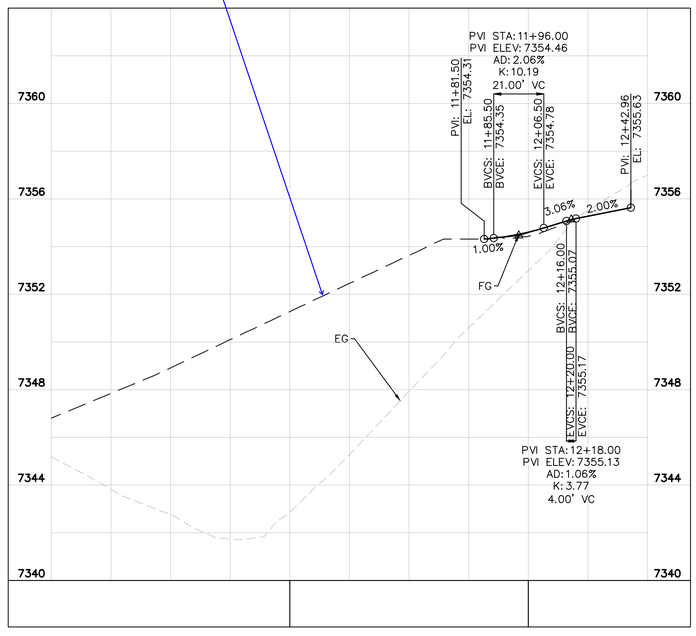

DRIVEWAY 10 PROFILE

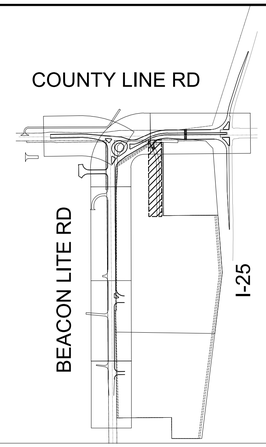

LEGEND:

- GRADING LIMIT
- CROWN TRANSITION LINE
- ONSITE HATCH
- PROPOSED ASPHALT (COUNTY LINE ROAD
- PROPOSED ASPHALT (BEACON LITE ROAD)
- PROPOSED ASPHALT (DRIVEWAYS)
- PROPOSED ABC (ACCESS ROAD)
- PROPOSED CONCRETE PAVEMENT (TRUCK APRON)
- PROPOSED SOD
- PROPOSED CONCRETE MEDIAN

NORTH

GRAPHIC SCALE IN FEET
0 15 30 60
HORIZONTAL
VERTICAL 6 3 1.5 0

Know what's below. Call before you dig.

This document, together with the concepts and designs presented herein, as an instrument of service, is intended only for the specific purpose and client for which it was prepared. Reuse of and improper reliance on this document without written authorization and adaptation by Kimley-Horn and Associates, Inc. shall be without liability to Kimley-Horn and Associates, Inc.

Print Date: 5/19/26
Drawing File Name: epc-06.5_driveway plan and profiles.dwg

Kimley»Horn
KIMLEY-HORN AND ASSOCIATES, INC.
6200 SOUTH SYRACUSE WAY
SUITE 300
GREENWOOD VILLAGE, COLORADO 80111
(303) 228-2300

	Sheet Revisions		
	Date:	Comments:	Init.
R-X			
R-X			
R-X			
R-X			

EL PASO COUNTY
DEPARTMENT OF PUBLIC WORKS
3275 AKERS DRIVE
COLORADO SPRINGS, CO
80922

FOR REVIEW ONLY
NOT FOR CONSTRUCTION
Kimley»Horn
Kimley-Horn and Associates, Inc.

60% PLANS

No Revisions:

Revised:

Void:


EL PASO COUNTY TRAVEL CENTER
PREPARED FOR
BUC-EE'S, LTD.
ROADWAY DETAIL SHEETS

Designer:	APW	Structure Numbers	
Detailer:	DJC		
Checked By:	MPF	Subset Sheet:	8 of 9

Project No./Code


KH 196094002

Sheet Number 38

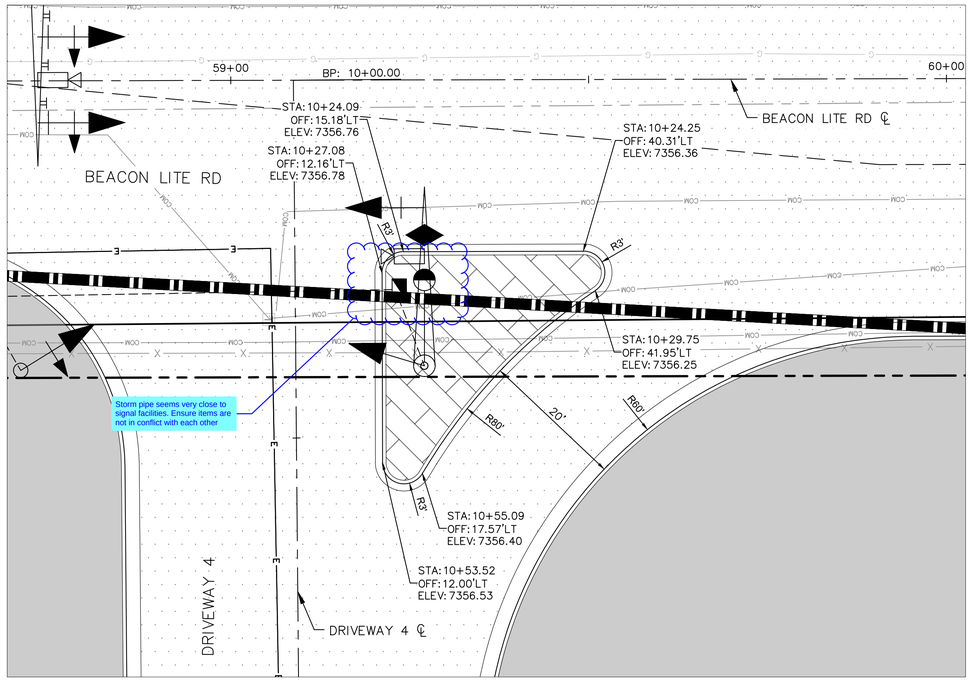

DRIVEWAY 4 – MEDIAN DETAIL

NOTE:
STATIONS AND OFFSETS ARE REFERENCED TO THE DRIVEWAY 4 CENTERLINE (CL), UNLESS NOTED OTHERWISE.

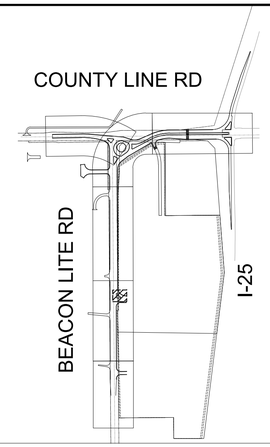

LEGEND:

- GRADING LIMIT
- CROWN TRANSITION LINE
- ONSITE HATCH
- PROPOSED ASPHALT (COUNTY LINE ROAD
- PROPOSED ASPHALT (BEACON LITE ROAD)
- PROPOSED ASPHALT (DRIVEWAYS)
- PROPOSED ABC (ACCESS ROAD)
- PROPOSED CONCRETE PAVEMENT (TRUCK APRON)
- PROPOSED SOD
- PROPOSED CONCRETE MEDIAN

NORTH

GRAPHIC SCALE IN FEET
0 5 10 20

Know what's **below.**
Call before you dig.

This document, together with the concepts and designs presented herein, as an instrument of service, is intended only for the specific purpose and client for which it was prepared. Reuse of and improper reliance on this document without written authorization and adaptation by Kimley-Horn and Associates, Inc. shall be without liability to Kimley-Horn and Associates, Inc.

Print Date: 5/19/26
Drawing File Name: epc-06.8_median detail sheet.dwg

Kimley»Horn
KIMLEY-HORN AND ASSOCIATES, INC.
6200 SOUTH SYRACUSE WAY
SUITE 300
GREENWOOD VILLAGE, COLORADO 80111
(303) 228-2300

Sheet Revisions			
	Date:	Comments:	Init.
R-X			
R-X			
R-X			
R-X			

EL PASO COUNTY
DEPARTMENT OF PUBLIC WORKS
3275 AKERS DRIVE
COLORADO SPRINGS, CO
80922

FOR REVIEW ONLY
NOT FOR CONSTRUCTION
Kimley»Horn
Kimley-Horn and Associates, Inc.

60% PLANS

No Revisions:
Revised:
Void:


EL PASO COUNTY TRAVEL CENTER
PREPARED FOR
BUC-EE'S, LTD.
ROADWAY DETAIL SHEETS


Designer:	APW	Structure Numbers	
Detailer:	DJC		
Checked By:	MPF	Subset Sheet:	9 of 9

Project No./Code

KH 196094002

Sheet Number 39

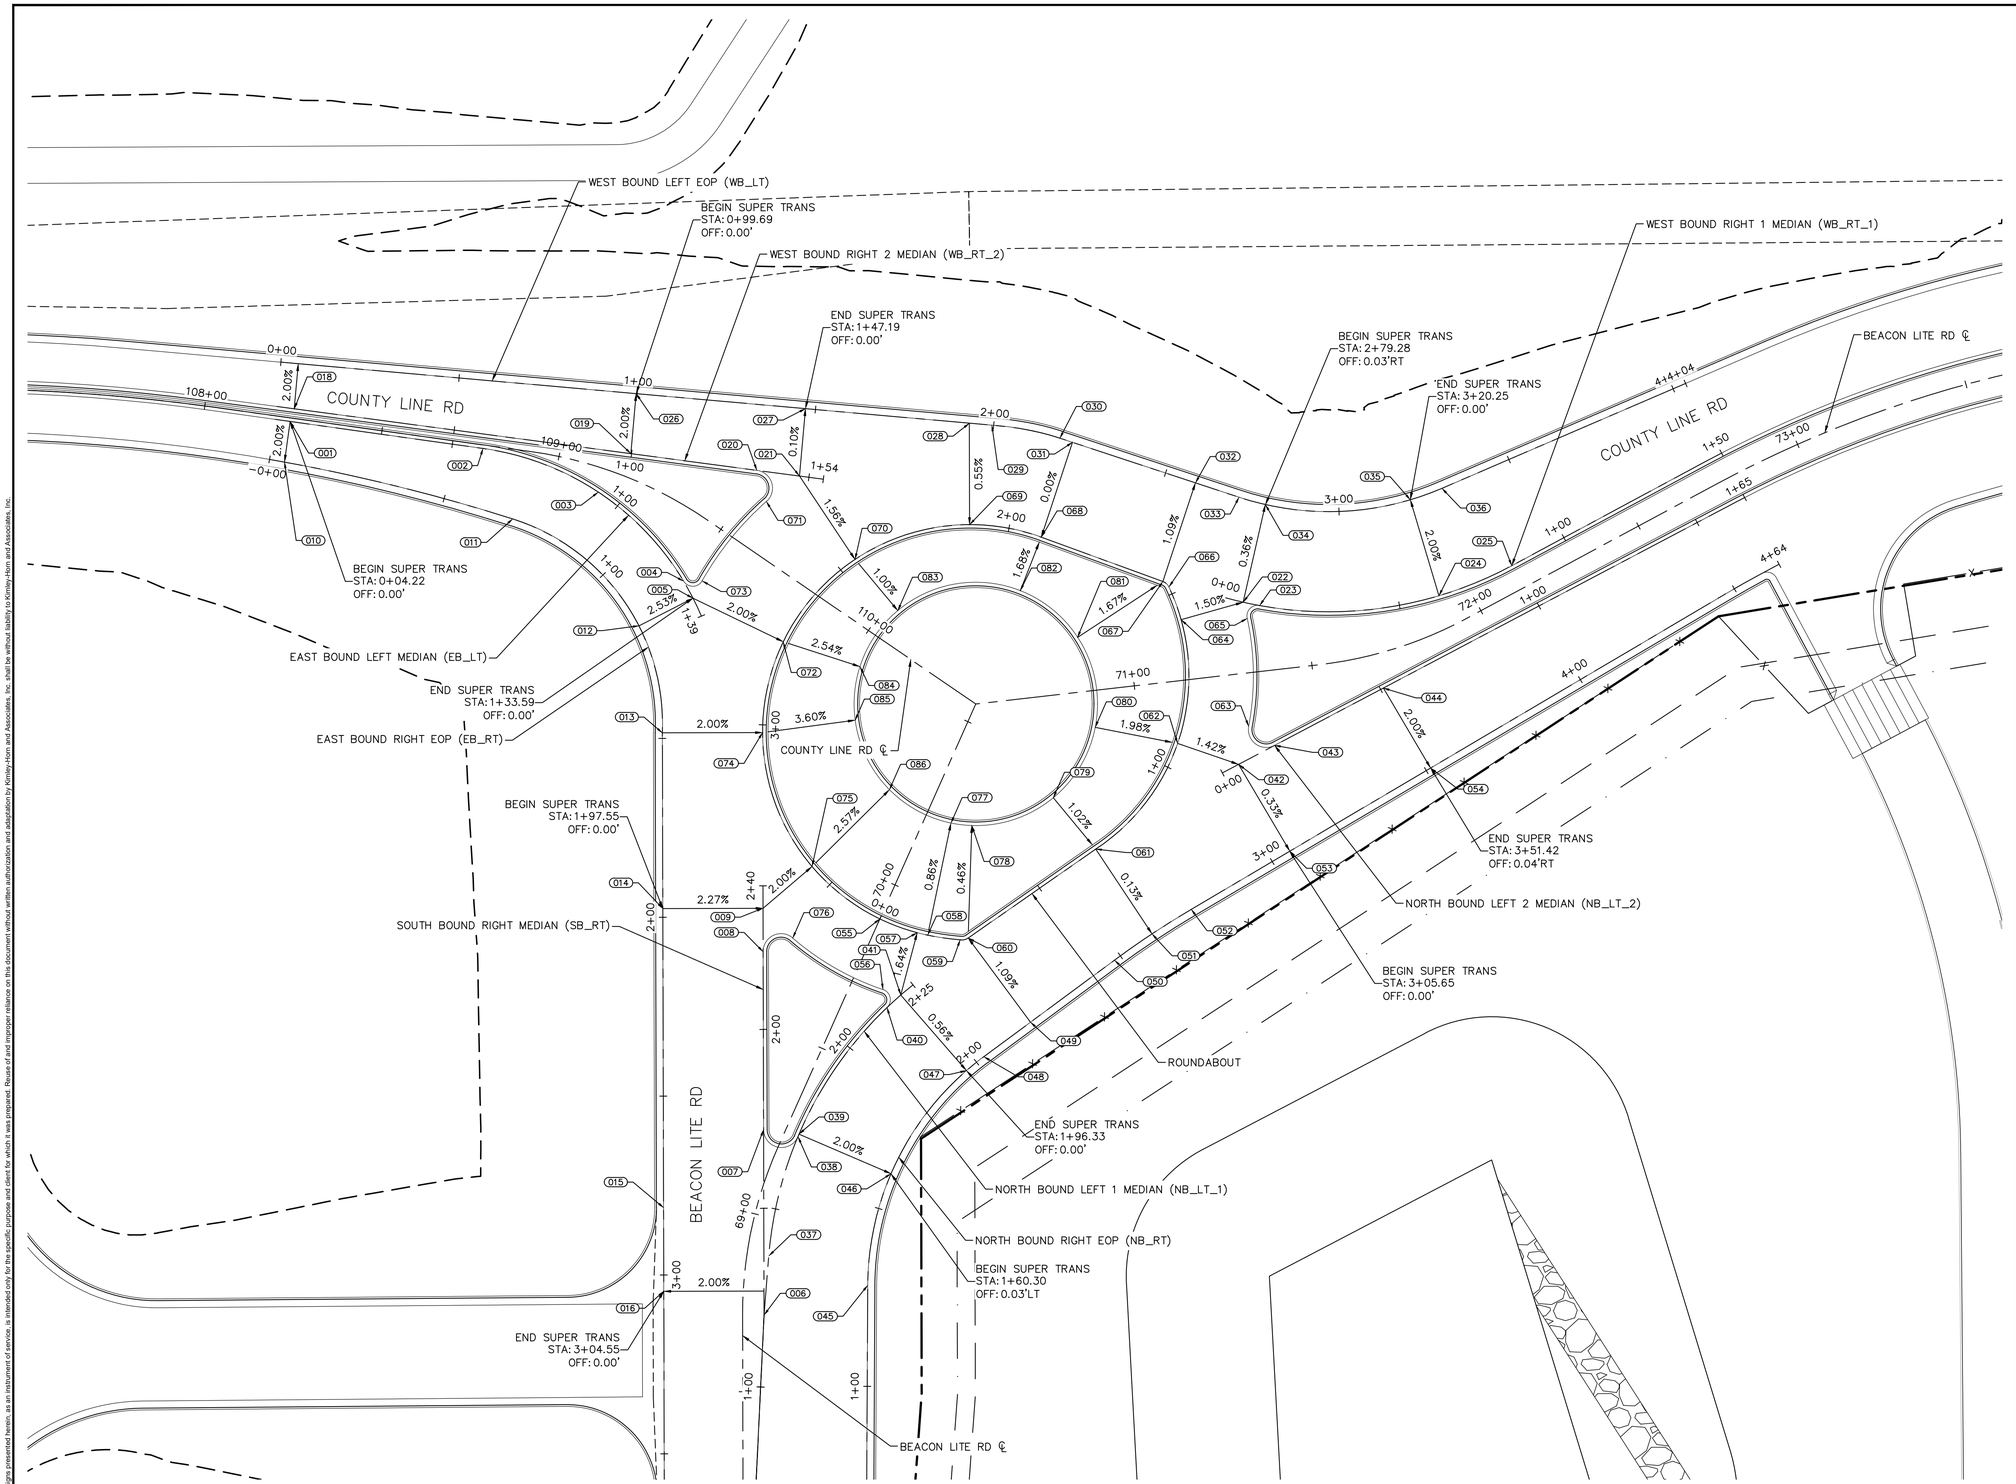

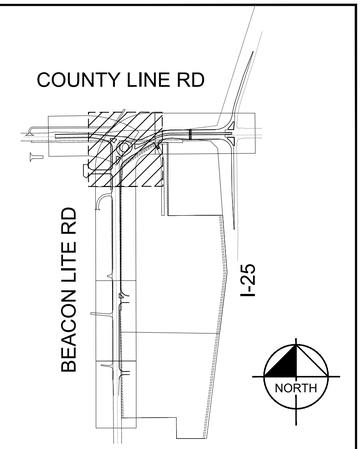

NORTH

GRAPHIC SCALE IN FEET
0 10 20 40

811 Know what's below. Call before you dig.

This document, together with the concepts and designs presented herein, as an instrument of service, is intended only for the specific purpose and client for which it was prepared. Reuse of and improper reliance on this document without written authorization and adaptation by Kimley-Horn and Associates, Inc. shall be without liability to Kimley-Horn and Associates, Inc.

Print Date: 5/19/26

Drawing File Name: epc-06_roundabout detail 2.dwg

Kimley»Horn
KIMLEY-HORN AND ASSOCIATES, INC.
6200 SOUTH SYRACUSE WAY
SUITE 300
GREENWOOD VILLAGE, COLORADO 80111
(303) 228-2300

Sheet Revisions

	Date:	Comments:	Init.
R-X			
R-X			
R-X			
R-X			

EL PASO COUNTY
DEPARTMENT OF PUBLIC WORKS
3275 AKERS DRIVE
COLORADO SPRINGS, CO
80922

FOR REVIEW ONLY
NOT FOR CONSTRUCTION
Kimley»Horn
Kimley-Horn and Associates, Inc.

60% PLANS

No Revisions:

Revised:

Void:

EL PASO COUNTY TRAVEL CENTER

PREPARED FOR
BUC-EE'S, LTD.
ROUNDABOUT GRADING

Designer: APW
Detailer: DJC
Checked By: MPF

Structure Numbers:

Subset Sheet: 1 of 2

Project No./Code

KH 196094002

Sheet Number 40

POINT TABLE					
POINT #	ALIGNMENT	STA.	NORTHING	EASTING	ELEVATION
001	EB_LT	0+04.22	473336.66	180404.47	7365.11
002	EB_LT	0+58.66	473329.11	180458.38	7364.32
003	EB_LT	0+93.38	473316.92	180490.59	7363.83
004	EB_LT	1+28.12	473292.04	180514.42	7363.32
005	EB_LT	1+33.59	473287.26	180517.07	7363.24

POINT TABLE					
POINT #	ALIGNMENT	STA.	NORTHING	EASTING	ELEVATION
006	SB_RT	1+20.15	473086.86	180536.91	7364.98
007	SB_RT	1+71.96	473138.67	180536.78	7363.88
008	SB_RT	2+21.72	473188.43	180536.65	7363.52
009	SB_RT	2+33.86	473200.57	180536.62	7363.44

POINT TABLE					
POINT #	ALIGNMENT	STA.	NORTHING	EASTING	ELEVATION
010	EB_RT	0+04.23	473325.31	180402.88	7364.88
011	EB_RT	0+70.02	473309.41	180466.67	7364.19
012	EB_RT	1+17.48	473279.53	180501.94	7363.67
013	EB_RT	1+48.44	473249.61	180508.50	7363.81
014	EB_RT	1+97.55	473200.50	180508.62	7364.08
015	EB_RT	2+81.16	473116.89	180508.83	7363.95
016	EB_RT	3+04.55	473093.50	180508.89	7364.26
017	EB_RT	3+61.16	473036.89	180509.03	7365.42

POINT TABLE					
POINT #	ALIGNMENT	STA.	NORTHING	EASTING	ELEVATION
018	WB_RT-2	0+04.88	473340.20	180405.61	7365.08
019	WB_RT-2	0+99.79	473327.68	180499.68	7363.49
020	WB_RT-2	1+35.33	473322.99	180534.91	7362.63
021	WB_RT-2	1+47.34	473321.40	180546.81	7362.33

POINT TABLE					
POINT #	ALIGNMENT	STA.	NORTHING	EASTING	ELEVATION
022	WB_RT-1	0+06.02	473286.13	180670.81	7359.70
023	WB_RT-1	0+10.71	473285.19	180675.40	7359.68
024	WB_RT-1	0+61.37	473287.93	180725.52	7359.06
025	WB_RT-1	0+83.44	473296.34	180745.89	7358.30


POINT TABLE					
POINT #	ALIGNMENT	STA.	NORTHING	EASTING	ELEVATION
026	WB_LT	0+99.69	473344.44	180501.17	7363.15
027	WB_LT	1+47.19	473340.25	180548.48	7362.31
028	WB_LT	1+93.18	473336.14	180594.29	7361.19
029	WB_LT	1+99.49	473335.62	180600.57	7361.05
030	WB_LT	2+18.89	473331.99	180619.58	7360.62
031	WB_LT	2+22.62	473330.82	180623.13	7360.54
032	WB_LT	2+58.79	473319.49	180657.48	7359.71
033	WB_LT	2+71.63	473315.47	180669.67	7359.65
034	WB_LT	2+79.25	473313.43	180677.01	7359.60
035	WB_LT	3+20.25	473314.77	180717.54	7358.50
036	WB_LT	3+29.64	473317.97	180726.36	7358.12

POINT TABLE					
POINT #	ALIGNMENT	STA.	NORTHING	EASTING	ELEVATION
037	NB_LT-1	1+36.73	473103.39	180538.23	7364.55
038	NB_LT-1	1+71.21	473136.74	180546.38	7363.84
039	NB_LT-1	1+71.97	473137.44	180546.68	7363.82
040	NB_LT-1	2+15.35	473172.82	180571.26	7362.64
041	NB_LT-1	2+20.57	473176.34	180575.13	7362.52

POINT TABLE					
POINT #	ALIGNMENT	STA.	NORTHING	EASTING	ELEVATION
042	NB_LT-2	0+05.10	473240.80	180669.53	7359.86
043	NB_LT-2	0+16.48	473246.11	180679.59	7359.68
044	NB_LT-2	0+50.85	473262.15	180709.99	7359.14

POINT TABLE					
POINT #	ALIGNMENT	STA.	NORTHING	EASTING	ELEVATION
045	NB_RT	1+28.24	473095.17	180565.89	7364.16
046	NB_RT	1+60.33	473126.37	180572.40	7363.26
047	NB_RT	1+96.33	473155.19	180593.47	7362.37
048	NB_RT	2+02.58	473159.09	180598.34	7362.31
049	NB_RT	2+18.77	473168.71	180611.36	7362.19
050	NB_RT	2+47.96	473186.06	180634.84	7361.20
051	NB_RT	2+60.77	473193.41	180645.34	7360.77
052	NB_RT	2+73.70	473200.27	180656.29	7360.46
053	NB_RT	3+05.70	473216.54	180683.85	7359.77
054	NB_RT	3+51.40	473239.78	180723.20	7358.62

POINT TABLE					
POINT #	ALIGNMENT	STA.	NORTHING	EASTING	ELEVATION
055	ROUNDABOUT	0+00.00	473197.60	180569.27	7362.50
056	ROUNDABOUT	0+07.19	473177.83	180570.15	7362.63
057	ROUNDABOUT	0+11.15	473193.75	180579.71	7362.23
058	ROUNDABOUT	0+14.14	473193.06	180582.63	7362.15
059	ROUNDABOUT	0+23.36	473191.75	180591.75	7361.93
060	ROUNDABOUT	0+25.69	473192.26	180593.96	7361.87
061	ROUNDABOUT	0+69.16	473217.12	180629.63	7360.80
062	ROUNDABOUT	1+07.20	473246.65	180652.50	7360.11
063	ROUNDABOUT	1+15.62	473251.46	180672.35	7359.73
064	ROUNDABOUT	1+42.34	473281.25	180653.48	7359.97
065	ROUNDABOUT	1+38.78	473281.60	180671.94	7359.67
066	ROUNDABOUT	1+52.10	473290.37	180650.06	7360.01
067	ROUNDABOUT	1+54.43	473291.91	180648.38	7360.03
068	ROUNDABOUT	1+90.62	473304.32	180614.38	7360.54
069	ROUNDABOUT	2+11.06	473307.83	180594.35	7361.04
070	ROUNDABOUT	2+45.01	473298.10	180562.34	7361.90
071	ROUNDABOUT	2+52.89	473314.29	180537.56	7362.60
072	ROUNDABOUT	2+75.91	473275.07	180542.28	7362.68
073	ROUNDABOUT	2+72.22	473292.11	180519.60	7363.14
074	ROUNDABOUT	3+02.18	473249.68	180536.49	7363.25
075	ROUNDABOUT	3+42.93	473212.24	180550.33	7363.08
076	ROUNDABOUT	3+51.91	473192.23	180544.91	7363.21
077	ROUNDABOUT	0+40.11	473224.39	180589.15	7362.47
078	ROUNDABOUT	0+44.50	473223.69	180594.98	7362.29
079	ROUNDABOUT	0+67.63	473231.48	180617.75	7361.56
080	ROUNDABOUT	1+01.80	473251.16	180629.45	7361.13
081	ROUNDABOUT	1+71.49	473276.29	180624.52	7361.07
082	ROUNDABOUT	1+91.16	473289.32	180608.50	7361.37
083	ROUNDABOUT	2+42.06	473283.78	180574.29	7362.29
084	ROUNDABOUT	2+70.90	473268.14	180563.73	7362.71
085	ROUNDABOUT	2+96.05	473253.16	180562.38	7362.94
086	ROUNDABOUT	3+38.03	473233.71	180571.95	7362.92

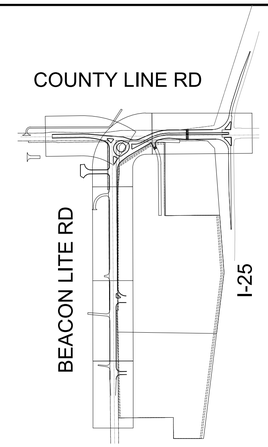

This document, together with the concepts and designs presented herein, as an instrument of service, is intended only for the specific purpose and client for which it was prepared. Reuse of and improper reliance on this document without written authorization and adaptation by Kimley-Horn and Associates, Inc. shall be without liability to Kimley-Horn and Associates, Inc.

Know what's **below.**
Call before you dig.

Print Date: 5/19/26
Drawing File Name: epc-06_roundabout detail 2.dwg

Kimley»Horn
KIMLEY-HORN AND ASSOCIATES, INC.
6200 SOUTH SYRACUSE WAY
SUITE 300
GREENWOOD VILLAGE, COLORADO 80111
(303) 228-2300

Sheet Revisions		
Date:	Comments:	Init.
(R-X)		
(R-X)		
(R-X)		
(R-X)		

EL PASO COUNTY
DEPARTMENT OF PUBLIC WORKS
3275 AKERS DRIVE
COLORADO SPRINGS, CO
80922

FOR REVIEW ONLY
NOT FOR CONSTRUCTION
Kimley»Horn
Kimley-Horn and Associates, Inc.

60% PLANS

No Revisions:

Revised:

Void:


EL PASO COUNTY TRAVEL CENTER
PREPARED FOR
BUC-EE'S, LTD.
ROUNDABOUT POINT TABLES

Designer:	APW	Structure Numbers	
Detailer:	DJC		
Checked By:	MPF	Subset Sheet:	2 of 2

Project No./Code

KH 196094002

Sheet Number 41

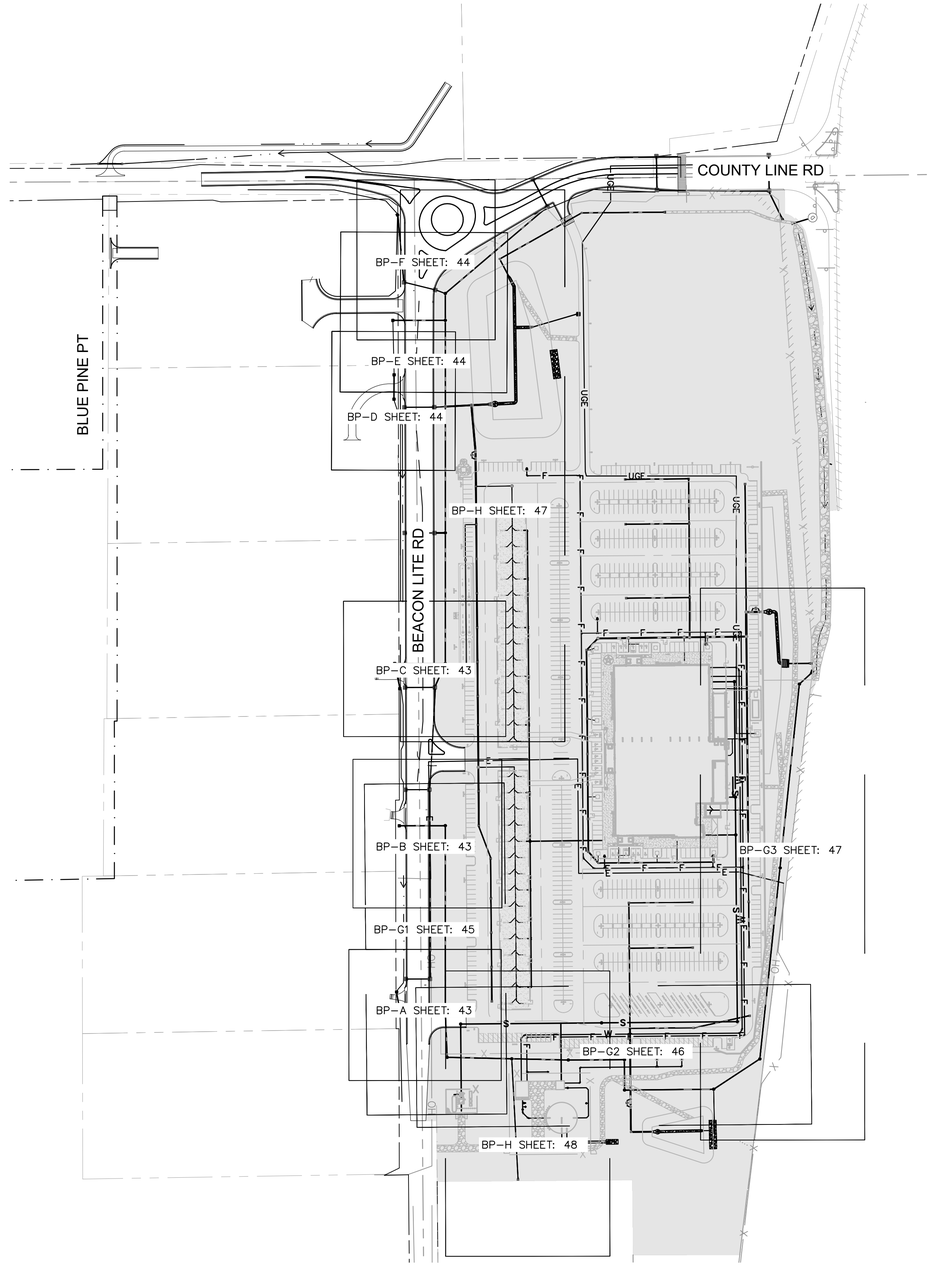

LEGEND:

ONSITE HATCH

NORTH

GRAPHIC SCALE IN FEET
0 75 150 300

Know what's below. Call before you dig.

This document, together with the concepts and designs presented herein, as an instrument of service, is intended only for the specific purpose and client for which it was prepared. Reuse of and improper reliance on this document without written authorization and adaptation by Kimley-Horn and Associates, Inc. shall be without liability to Kimley-Horn and Associates, Inc.

Print Date: 9/11/26

Drawing File Name: epc-06.8_ offsite storm (km).dwg

Kimley»Horn
KIMLEY-HORN AND ASSOCIATES, INC.
6200 SOUTH SYRACUSE WAY
SUITE 300
GREENWOOD VILLAGE, COLORADO 80111
(303) 228-2300

	Sheet Revisions		
	Date:	Comments:	Init.
R-X			
R-X			
R-X			
R-X			

EL PASO COUNTY
DEPARTMENT OF PUBLIC WORKS
3275 AKERS DRIVE
COLORADO SPRINGS, CO
80922

1 R" - FINAL
FOR REVIEW ONLY
NOT FOR CONSTRUCTION
Kimley»Horn
Kimley-Horn and Associates, Inc.

60% PLANS

No Revisions:

Revised:

Void:

EL PASO COUNTY TRAVEL CENTER
PREPARED FOR
BUC-EE'S, LTD.
BYPASS STORM (KM)


Designer: APW
Detailer: DJC
Checked By: MPF
Structure Numbers

Subset Sheet: 1 of 14


Project No./Code

KH 196094002


Sheet Number 42

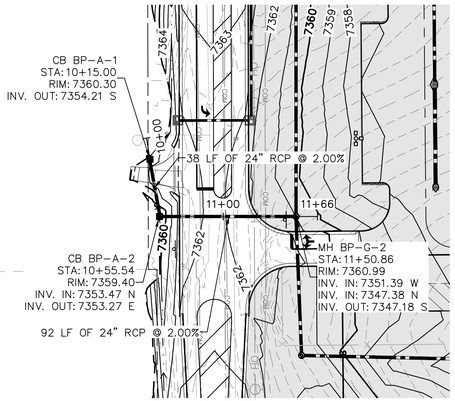

BP-A PLAN VIEW

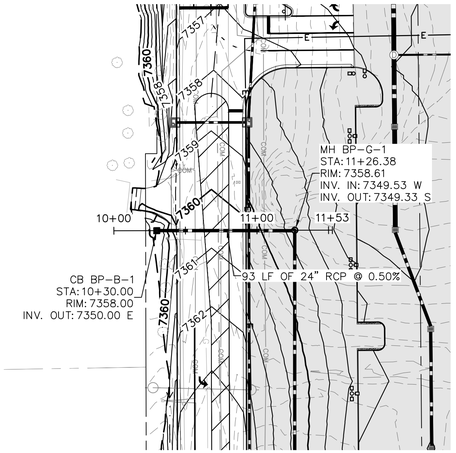


BP-B PLAN VIEW

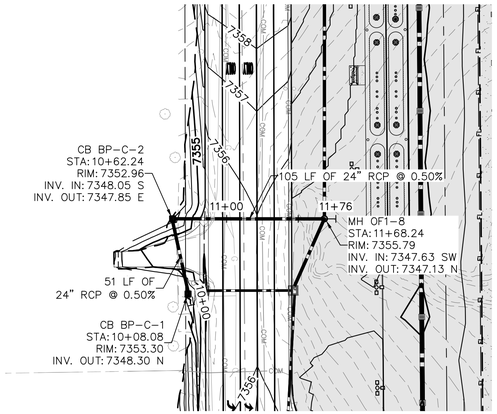


BP-C PLAN VIEW

These sheets will be reviewed when final design of storm facilities are included with FDR


Ensure all utility crossings are show and labeled in plan & profile views

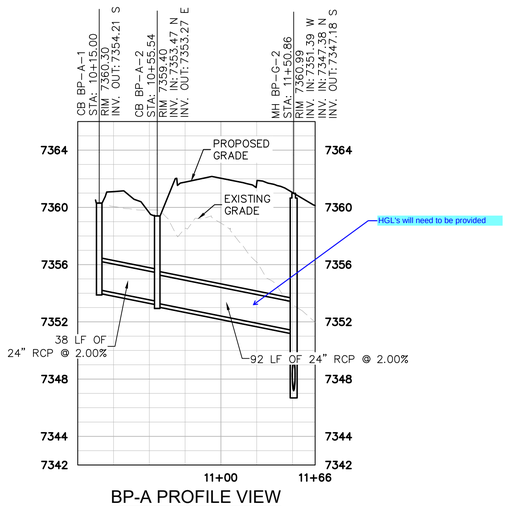


BP-A PROFILE VIEW

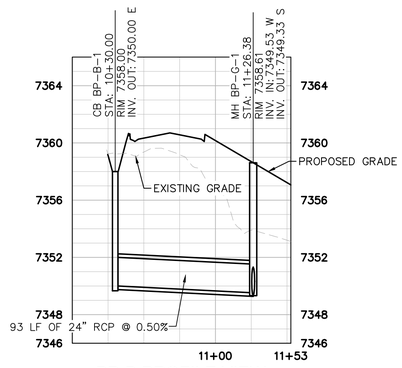

BP-B PROFILE VIEW

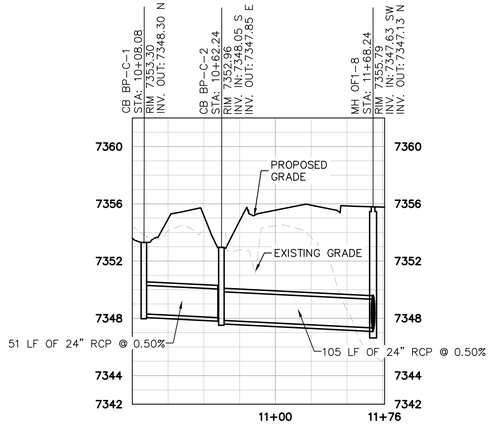


BP-C PROFILE VIEW

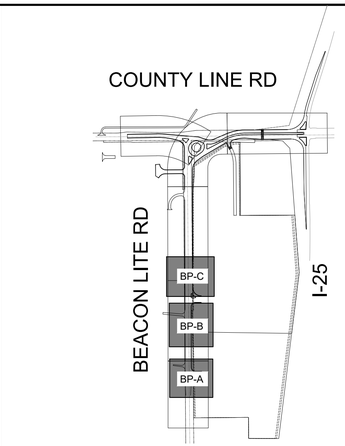

LEGEND:

- RIGHT OF WAY/ PROPERTY LINE
- PROPOSED EASEMENT
- EXISTING EASEMENT
- EXISTING CULINARY WATER LINE
- EXISTING SANITARY LINE
- EXISTING STORM LINE
- EXISTING ELECTRICAL LINE
- EXISTING GAS LINE
- PROPOSED STORM PIPE
- PROPOSED AREA INLET
- PROPOSED CURB INLET
- PROPOSED STORM MANHOLE
- PROPOSED FLARED END SECTION

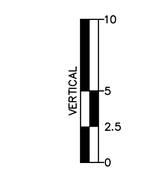



Know what's **below.**
Call before you dig.

This document, together with the concepts and designs presented herein, as an instrument of service, is intended only for the specific purpose and client for which it was prepared. Reuse of and improper reliance on this document without written authorization and adaptation by Kimley-Horn and Associates, Inc. shall be without liability to Kimley-Horn and Associates, Inc.

Print Date: 9/11/26

Drawing File Name: epc offsite storm bypass.dwg

	Sheet Revisions		
	Date:	Comments:	Init.
R-X			
R-X			
R-X			
R-X			

Kimley»Horn
KIMLEY-HORN AND ASSOCIATES, INC.
6200 SOUTH SYRACUSE WAY
SUITE 300
GREENWOOD VILLAGE, COLORADO 80111
(303) 228-2300

EL PASO COUNTY
DEPARTMENT OF PUBLIC WORKS
3275 AKERS DRIVE
COLORADO SPRINGS, CO
80922

FOR REVIEW ONLY
NOT FOR CONSTRUCTION
Kimley»Horn
Kimley-Horn and Associates, Inc.

60% PLANS

No Revisions:

Revised:

Void:

EL PASO COUNTY TRAVEL CENTER
PREPARED FOR
BUC-EE'S, LTD.
BYPASS STORM P&P ABC


Designer:	APW	Structure Numbers	
Detailer:	DJC		
Checked By:	MPF	Subset Sheet:	2 of 14

Project No./Code


KH 196094002

Sheet Number 43


This document, together with the concepts and designs presented herein, as an instrument of service, is intended only for the specific purpose and client for which it was prepared. Reuse of and improper reliance on this document without written authorization and adaptation by Kimley-Horn and Associates, Inc. shall be without liability to Kimley-Horn and Associates, Inc.

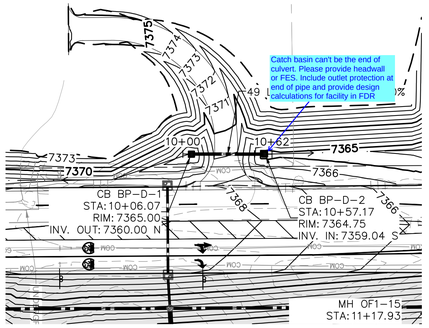


BP-D PLAN VIEW

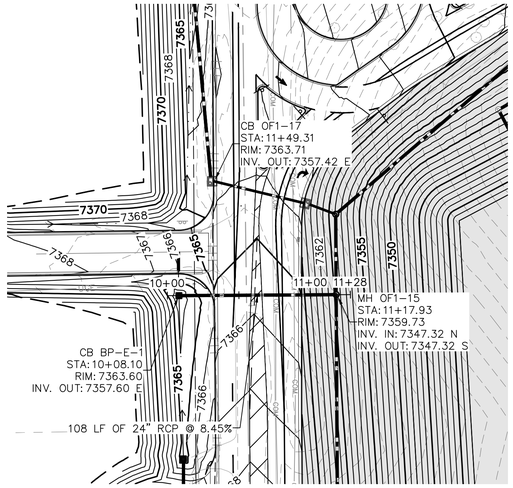


BP-E PLAN VIEW

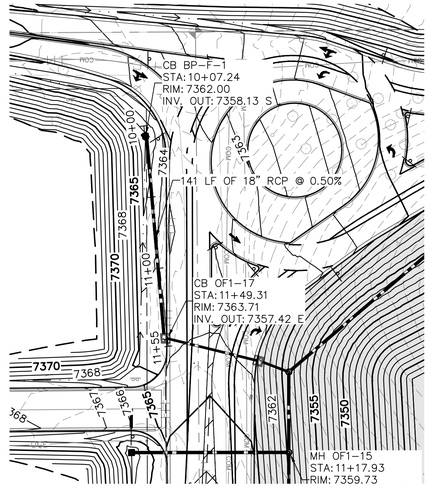


BP-F PLAN VIEW

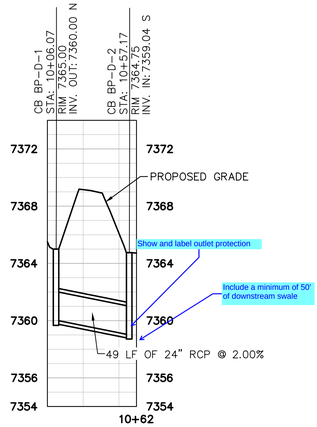


BP-D PROFILE VIEW

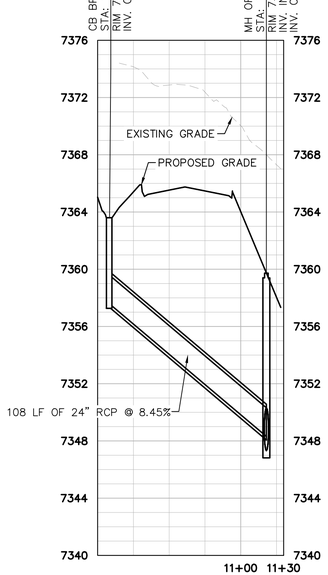

BP-E PROFILE VIEW

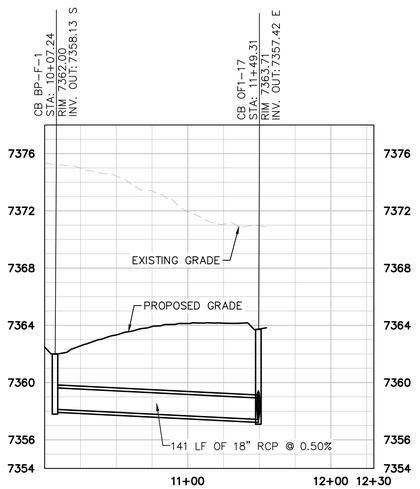

BP-F PROFILE VIEW

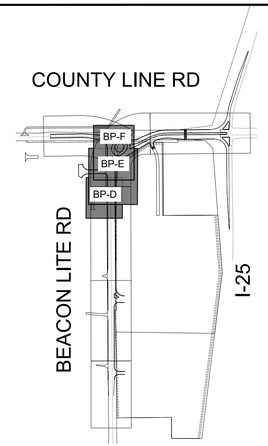

LEGEND:

- RIGHT OF WAY/ PROPERTY LINE
- PROPOSED EASEMENT
- EXISTING EASEMENT
- W — EXISTING CULINARY WATER LINE
- S — EXISTING SANITARY LINE
- ST — EXISTING STORM LINE
- E — EXISTING ELECTRICAL LINE
- G — EXISTING GAS LINE
- PROPOSED STORM PIPE
- PROPOSED AREA INLET
- PROPOSED CURB INLET
- (D) PROPOSED STORM MANHOLE
- PROPOSED FLARED END SECTION

VERTICAL: 0, 2.5, 5, 10

GRAPHIC SCALE IN FEET
0 25 50 100
HORIZONTAL

NORTH

Know what's **below.**
Call before you dig.

Print Date: 9/11/26	Sheet Revisions		
Drawing File Name: epc offsite storm bypass.dwg	Date:	Comments:	Init.
R-X			
R-X			
R-X			
R-X			

Kimley»Horn
KIMLEY-HORN AND ASSOCIATES, INC.
6200 SOUTH SYRACUSE WAY
SUITE 300
GREENWOOD VILLAGE, COLORADO 80111
(303) 228-2300

EL PASO COUNTY
DEPARTMENT OF PUBLIC WORKS
3275 AKERS DRIVE
COLORADO SPRINGS, CO
80922

FOR REVIEW ONLY
NOT FOR CONSTRUCTION
Kimley»Horn
Kimley-Horn and Associates, Inc.

60% PLANS

No Revisions:

Revised:

Void:


EL PASO COUNTY TRAVEL CENTER
PREPARED FOR
BUC-EE'S, LTD.
BYPASS STORM P&P DEF

Designer:	APW	Structure Numbers	
Detailer:	DJC		
Checked By:	MPF	Subset Sheet:	3 of 14


Project No./Code

KH 196094002

Sheet Number 44

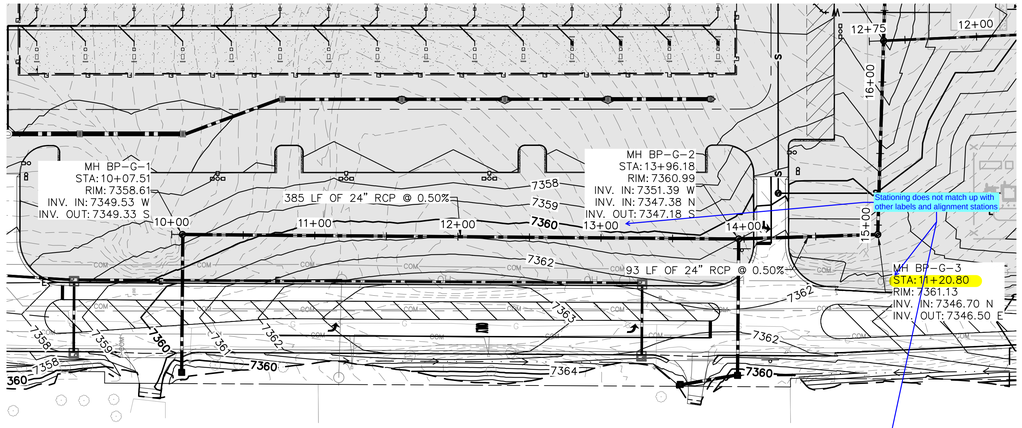


BP-G1 PLAN VIEW

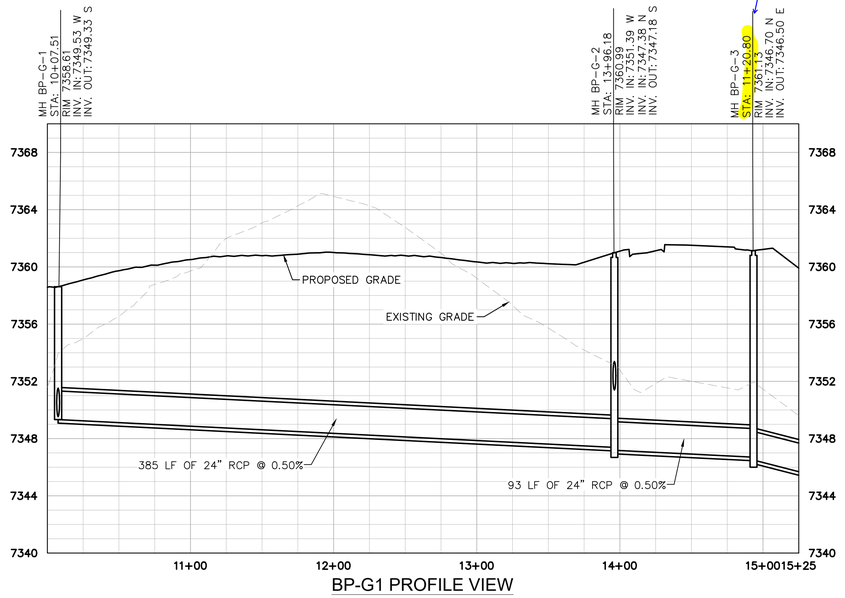

BP-G1 PROFILE VIEW

COUNTY LINE RD

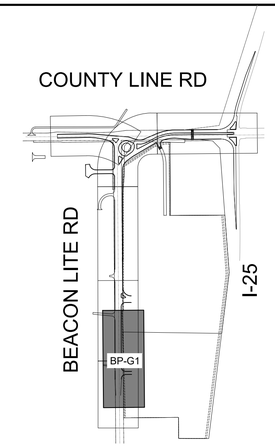

LEGEND:

- RIGHT OF WAY/ PROPERTY LINE
- PROPOSED EASEMENT
- EXISTING EASEMENT
- W — EXISTING CULINARY WATER LINE
- S — EXISTING SANITARY LINE
- ST — EXISTING STORM LINE
- E — EXISTING ELECTRICAL LINE
- G — EXISTING GAS LINE
- PROPOSED STORM PIPE
- PROPOSED AREA INLET
- PROPOSED CURB INLET
- D — PROPOSED STORM MANHOLE
- PROPOSED FLARED END SECTION

VERTICAL: 10, 5, 2.5, 0

GRAPHIC SCALE IN FEET
0 25 50 100
HORIZONTAL

NORTH

Know what's below. Call before you dig.

This document, together with the concepts and designs presented herein, as an instrument of service, is intended only for the specific purpose and client for which it was prepared. Reuse of and improper reliance on this document without written authorization and adaptation by Kimley-Horn and Associates, Inc. shall be without liability to Kimley-Horn and Associates, Inc.

Print Date: 9/11/26
Drawing File Name: epc offsite storm bypass.dwg

Kimley»Horn
KIMLEY-HORN AND ASSOCIATES, INC.
6200 SOUTH SYRACUSE WAY
SUITE 300
GREENWOOD VILLAGE, COLORADO 80111
(303) 228-2300

Sheet Revisions

	Date:	Comments:	Init.
R-X			
R-X			
R-X			
R-X			

EL PASO COUNTY
DEPARTMENT OF PUBLIC WORKS
3275 AKERS DRIVE
COLORADO SPRINGS, CO
80922


R-- FINAL
FOR REVIEW ONLY
NOT FOR CONSTRUCTION
Kimley»Horn
Kimley-Horn and Associates, Inc.

60% PLANS
No Revisions:
Revised:
Void:

EL PASO COUNTY TRAVEL CENTER
PREPARED FOR
BUC-EE'S, LTD.
BYPASS STORM P&P G1


Designer: APW
Detailer: DJC
Checked By: MPF
Structure Numbers
Subset Sheet: 4 of 14

Project No./Code
KH 196094002
Sheet Number 45

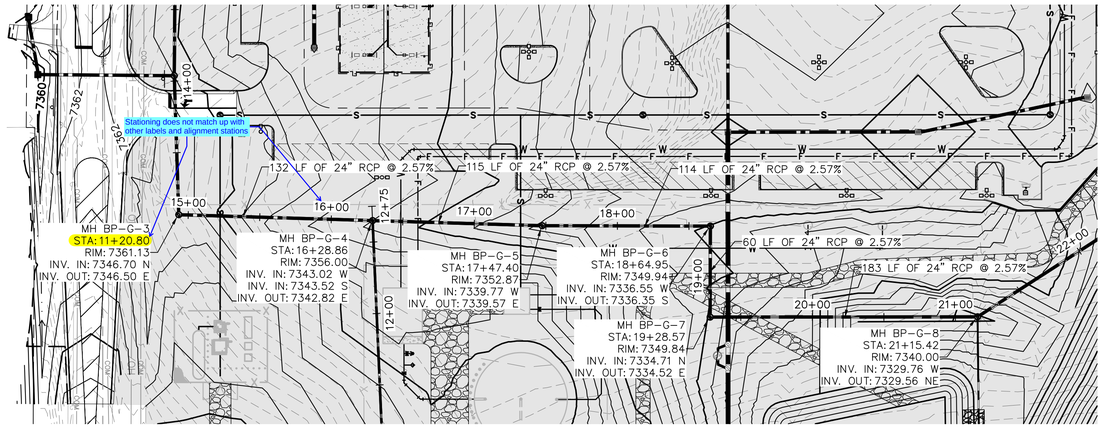


BP-G2 PLAN VIEW

BP-G2 PROFILE VIEW

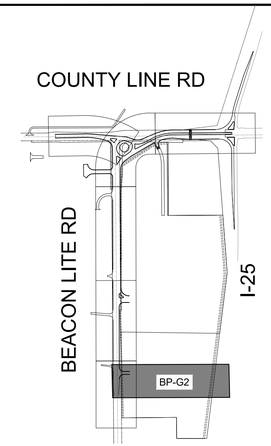

LEGEND:

- RIGHT OF WAY/ PROPERTY LINE
- PROPOSED EASEMENT
- EXISTING EASEMENT
- EXISTING CULINARY WATER LINE
- EXISTING SANITARY LINE
- EXISTING STORM LINE
- EXISTING ELECTRICAL LINE
- EXISTING GAS LINE
- PROPOSED STORM PIPE
- PROPOSED AREA INLET
- PROPOSED CURB INLET
- PROPOSED STORM MANHOLE
- PROPOSED FLARED END SECTION

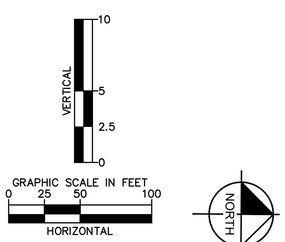

Know what's below. Call before you dig.

This document, together with the concepts and designs presented herein, as an instrument of service, is intended only for the specific purpose and client for which it was prepared. Reuse of and improper reliance on this document without written authorization and adaptation by Kimley-Horn and Associates, Inc. shall be without liability to Kimley-Horn and Associates, Inc.

Print Date: 9/11/26

Drawing File Name: epc offsite storm bypass.dwg

Kimley»Horn

KIMLEY-HORN AND ASSOCIATES, INC.
6200 SOUTH SYRACUSE WAY
SUITE 300
GREENWOOD VILLAGE, COLORADO 80111
(303) 228-2300

Sheet Revisions

	Date:	Comments:	Init.
R-X			
R-X			
R-X			
R-X			

EL PASO COUNTY
DEPARTMENT OF PUBLIC WORKS
3275 AKERS DRIVE
COLORADO SPRINGS, CO
80922

FOR REVIEW ONLY
NOT FOR CONSTRUCTION
Kimley»Horn
Kimley-Horn and Associates, Inc.

60% PLANS

No Revisions:

Revised:

Void:

EL PASO COUNTY TRAVEL CENTER
PREPARED FOR
BUC-EE'S, LTD.
BYPASS STORM P&P G2

Designer: APW
Detailer: DJC
Checked By: MPF


Structure Numbers

Subset Sheet: 5 of 14


Project No./Code

KH 196094002


Sheet Number 46

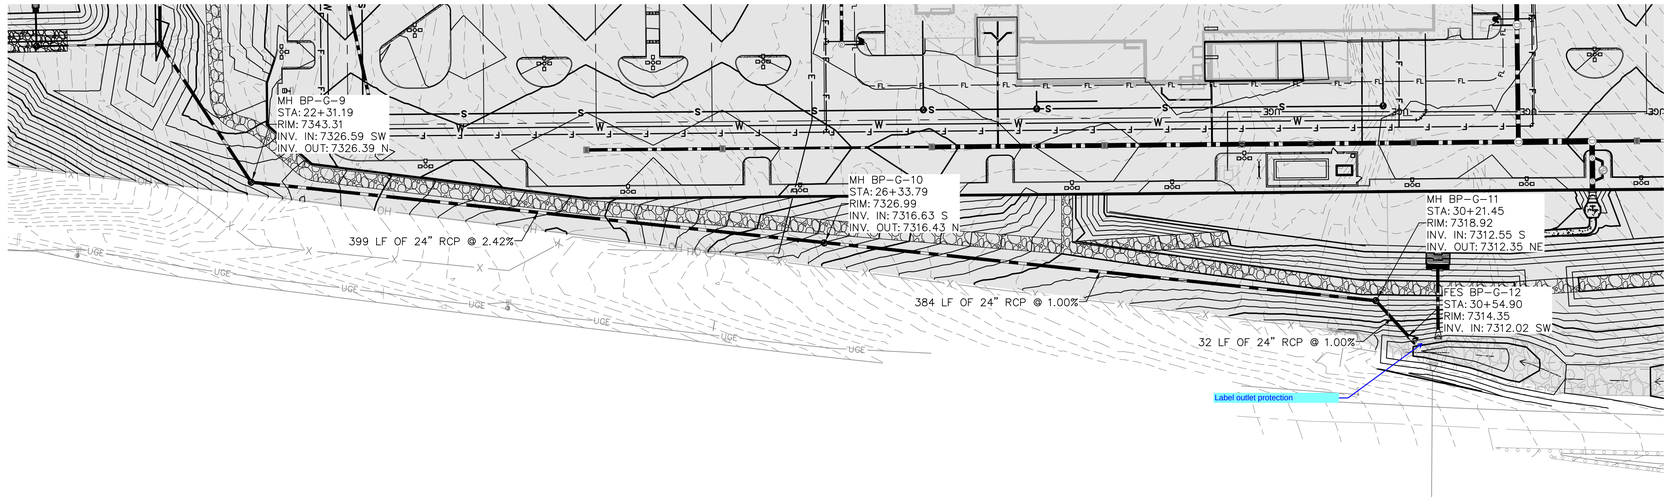

BP-G3 PLAN VIEW

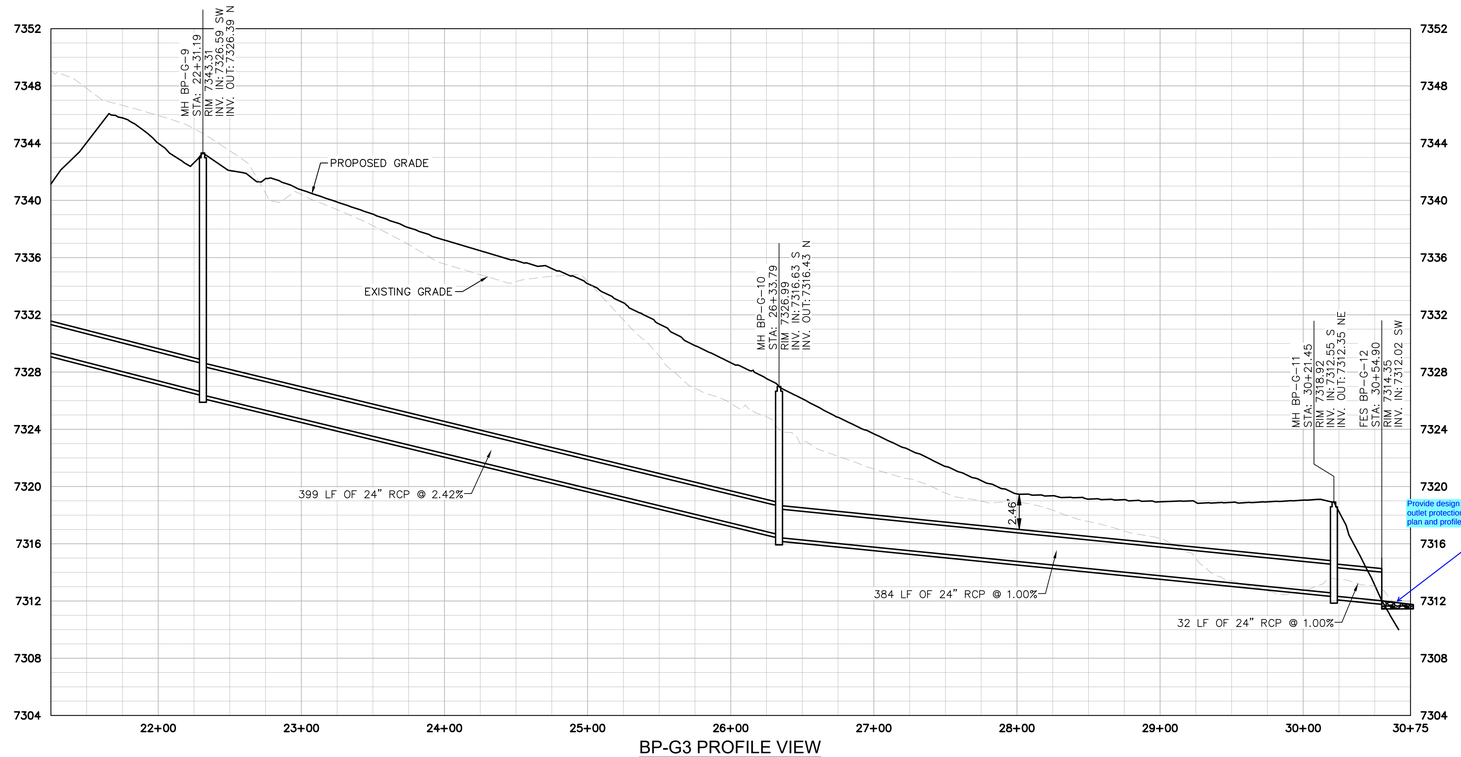


BP-G3 PROFILE VIEW

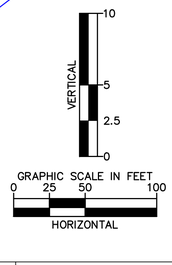

GRAPHIC SCALE IN FEET
0 25 50 100
HORIZONTAL



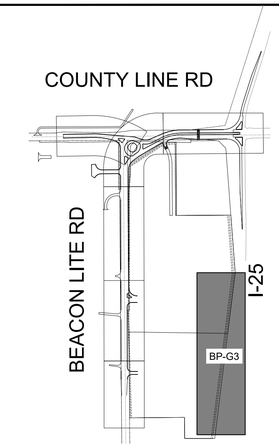

LEGEND:

- RIGHT OF WAY/ PROPERTY LINE
- PROPOSED EASEMENT
- EXISTING EASEMENT
- EXISTING CULINARY WATER LINE
- EXISTING SANITARY LINE
- EXISTING STORM LINE
- EXISTING ELECTRICAL LINE
- EXISTING GAS LINE
- PROPOSED STORM PIPE
- PROPOSED AREA INLET
- PROPOSED CURB INLET
- PROPOSED STORM MANHOLE
- PROPOSED FLARED END SECTION

811 Know what's **below.** **Call** before you dig.

This document, together with the concepts and designs presented herein, as an instrument of service, is intended only for the specific purpose and client for which it was prepared. Reuse of and improper reliance on this document without written authorization and adaptation by Kimley-Horn and Associates, Inc. shall be without liability to Kimley-Horn and Associates, Inc.

Print Date: 9/11/26

Drawing File Name: epc offsite storm bypass.dwg

Kimley»Horn
KIMLEY-HORN AND ASSOCIATES, INC.
6200 SOUTH SYRACUSE WAY
SUITE 300
GREENWOOD VILLAGE, COLORADO 80111
(303) 228-2300

	Sheet Revisions		
	Date:	Comments:	Init.
R-X			
R-X			
R-X			
R-X			

EL PASO COUNTY
DEPARTMENT OF PUBLIC WORKS
3275 AKERS DRIVE
COLORADO SPRINGS, CO
80922

R-- FINAL
FOR REVIEW ONLY
NOT FOR CONSTRUCTION
Kimley»Horn
Kimley-Horn and Associates, Inc.

60% PLANS

No Revisions:

Revised:

Void:


EL PASO COUNTY TRAVEL CENTER
PREPARED FOR
BUC-EE'S, LTD.
BYPASS STORM P&P G3

Designer:	APW	Structure Numbers	
Detailer:	DJC		
Checked By:	MPF	Subset Sheet:	6 of 14


Project No./Code

KH 196094002


Sheet Number 47

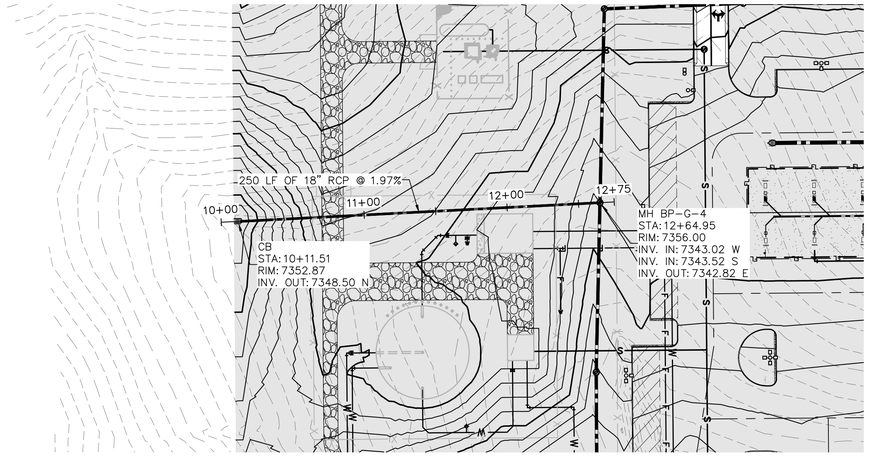

BP-H PLAN VIEW

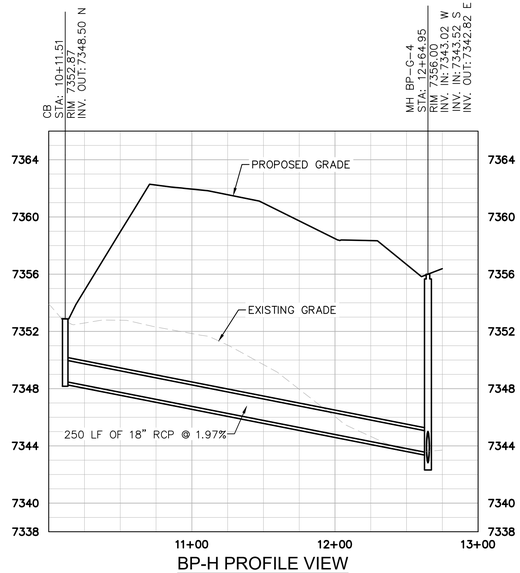

BP-H PROFILE VIEW

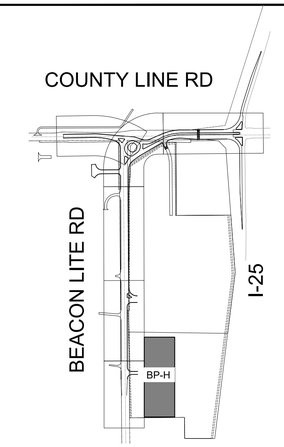

LEGEND:

- RIGHT OF WAY/ PROPERTY LINE
- PROPOSED EASEMENT
- EXISTING EASEMENT
- EXISTING CULINARY WATER LINE
- EXISTING SANITARY LINE
- EXISTING STORM LINE
- EXISTING ELECTRICAL LINE
- EXISTING GAS LINE
- PROPOSED STORM PIPE
- PROPOSED AREA INLET
- PROPOSED CURB INLET
- PROPOSED STORM MANHOLE
- PROPOSED FLARED END SECTION

VERTICAL: 10, 5, 2.5, 0

GRAPHIC SCALE IN FEET
0 25 50 100
HORIZONTAL

NORTH

811 Know what's below. Call before you dig.

This document, together with the concepts and designs presented herein, as an instrument of service, is intended only for the specific purpose and client for which it was prepared. Reuse of and improper reliance on this document without written authorization and adaptation by Kimley-Horn and Associates, Inc. shall be without liability to Kimley-Horn and Associates, Inc.

Print Date: 9/11/26

Drawing File Name: epc offsite storm bypass.dwg

Kimley»Horn
KIMLEY-HORN AND ASSOCIATES, INC.
6200 SOUTH SYRACUSE WAY
SUITE 300
GREENWOOD VILLAGE, COLORADO 80111
(303) 228-2300

Sheet Revisions

	Date:	Comments:	Init.
R-X			
R-X			
R-X			
R-X			

EL PASO COUNTY
DEPARTMENT OF PUBLIC WORKS
3275 AKERS DRIVE
COLORADO SPRINGS, CO
80922

R-- FINAL
FOR REVIEW ONLY
NOT FOR CONSTRUCTION
Kimley»Horn
Kimley-Horn and Associates, Inc.

60% PLANS

No Revisions:

Revised:

Void:


EL PASO COUNTY TRAVEL CENTER
PREPARED FOR
BUC-EE'S, LTD.
BYPASS STORM P&P H

Designer: APW
Detailer: DJC
Checked By: MPF
Structure Numbers
Subset Sheet: 7 of 14

Project No./Code

KH 196094002

Sheet Number 48

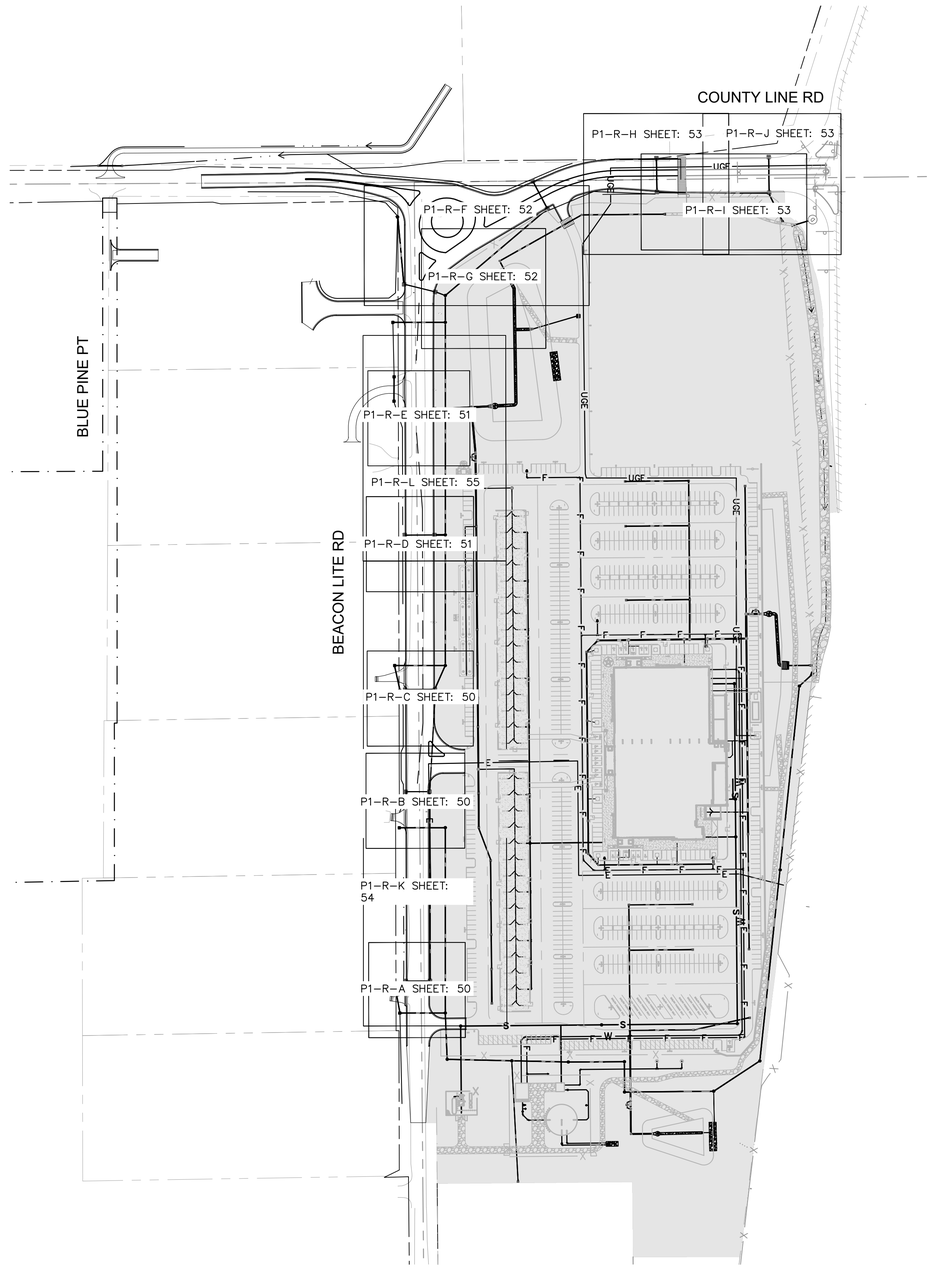

LEGEND:

ONSITE HATCH

NORTH

GRAPHIC SCALE IN FEET
0 75 150 300

811 Know what's below. Call before you dig.

This document, together with the concepts and designs presented herein, as an instrument of service, is intended only for the specific purpose and client for which it was prepared. Reuse of and improper reliance on this document without written authorization and adaptation by Kimley-Horn and Associates, Inc. shall be without liability to Kimley-Horn and Associates, Inc.

Print Date: 9/11/26

Drawing File Name: epc-06.8_ offsite storm (km)(2).dwg

Kimley»Horn
KIMLEY-HORN AND ASSOCIATES, INC.
6200 SOUTH SYRACUSE WAY
SUITE 300
GREENWOOD VILLAGE, COLORADO 80111
(303) 228-2300

Sheet Revisions

	Date:	Comments:	Init.
R-X			
R-X			
R-X			
R-X			

EL PASO COUNTY COLORADO EST. 1861

EL PASO COUNTY
DEPARTMENT OF PUBLIC WORKS
3275 AKERS DRIVE
COLORADO SPRINGS, CO
80922

FOR REVIEW ONLY
NOT FOR CONSTRUCTION
Kimley»Horn
Kimley-Horn and Associates, Inc.

60% PLANS

No Revisions:

Revised:

Void:


EL PASO COUNTY TRAVEL CENTER
PREPARED FOR
BUC-EE'S, LTD.
OFFSITE STORM (KM)

Designer: APW
Detailer: DJC
Checked By: MPF
Structure Numbers
Subset Sheet: 8 of 14


Project No./Code

KH 196094002


Sheet Number 49

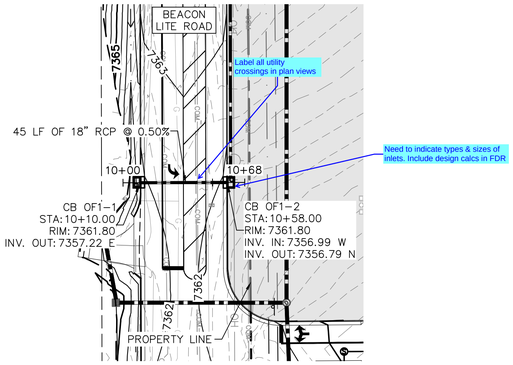


P1-R-A PLAN VIEW

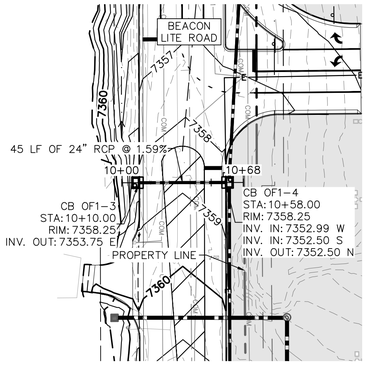


P1-R-B PLAN VIEW

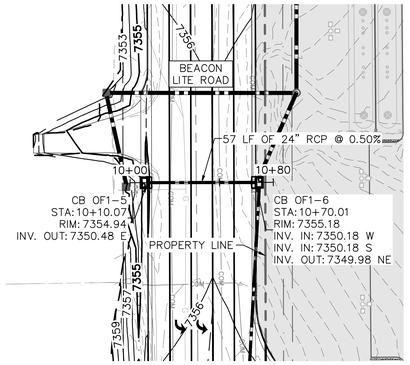


P1-R-C PLAN VIEW

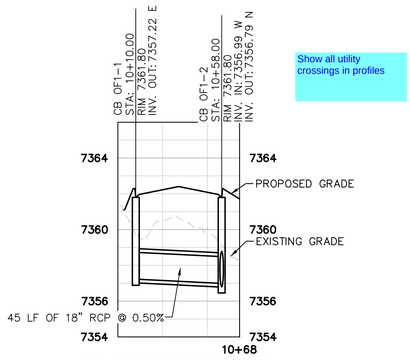


P1-R-A PROFILE VIEW

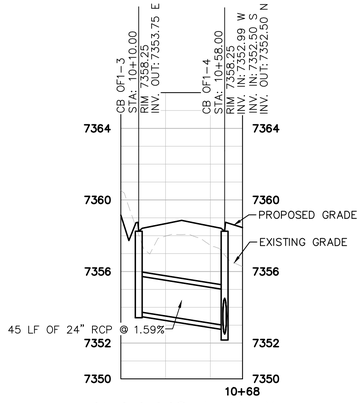

P1-R-B PROFILE VIEW

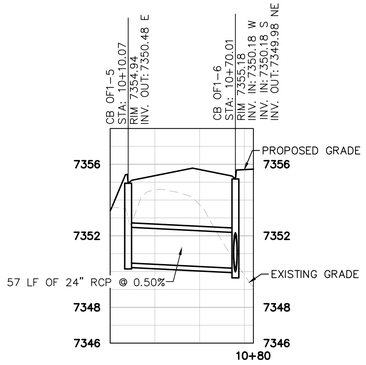


P1-R-C PROFILE VIEW

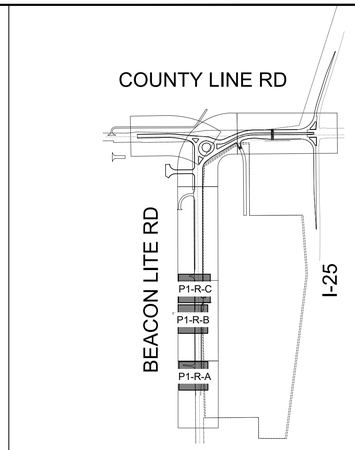

LEGEND:

- RIGHT OF WAY/ PROPERTY LINE
- PROPOSED EASEMENT
- EXISTING EASEMENT
- EXISTING CULINARY WATER LINE
- EXISTING SANITARY LINE
- EXISTING STORM LINE
- EXISTING ELECTRICAL LINE
- EXISTING GAS LINE
- PROPOSED STORM PIPE
- PROPOSED AREA INLET
- PROPOSED CURB INLET
- PROPOSED STORM MANHOLE
- PROPOSED FLARED END SECTION

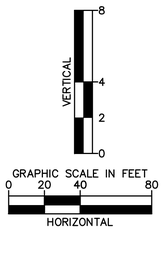



811 Know what's below. Call before you dig.

This document, together with the concepts and designs presented herein, as an instrument of service, is intended only for the specific purpose and client for which it was prepared. Reuse of and improper reliance on this document without written authorization and adaptation by Kimley-Horn and Associates, Inc. shall be without liability to Kimley-Horn and Associates, Inc.

Print Date: 9/11/26

Drawing File Name: epc offsite storm.dwg

Kimley»Horn
KIMLEY-HORN AND ASSOCIATES, INC.
6200 SOUTH SYRACUSE WAY
SUITE 300
GREENWOOD VILLAGE, COLORADO 80111
(303) 228-2300

Sheet Revisions

	Date:	Comments:	Init.
R-X			
R-X			
R-X			
R-X			

EL PASO COUNTY
DEPARTMENT OF PUBLIC WORKS
3275 AKERS DRIVE
COLORADO SPRINGS, CO
80922

FOR REVIEW ONLY
NOT FOR CONSTRUCTION
Kimley»Horn
Kimley-Horn and Associates, Inc.

60% PLANS

No Revisions:

Revised:

Void:

EL PASO COUNTY TRAVEL CENTER
PREPARED FOR
BUC-EE'S, LTD.
OFFSITE STORM P&P

Designer: APW
Detailer: DJC
Checked By: MPF


Structure Numbers

Subset Sheet: 9 of 14


Project No./Code

KH 196094002


Sheet Number 50

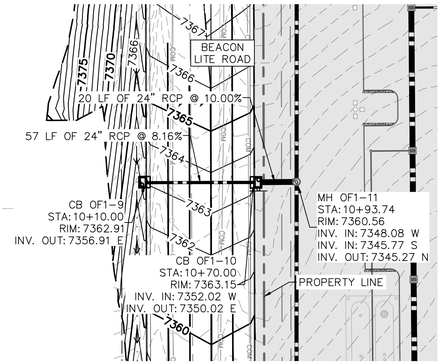


P1-R-D PLAN VIEW

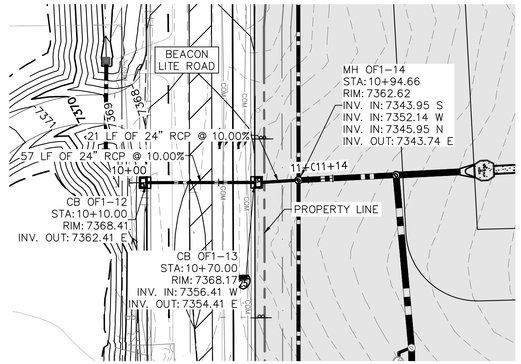


P1-R-E PLAN VIEW

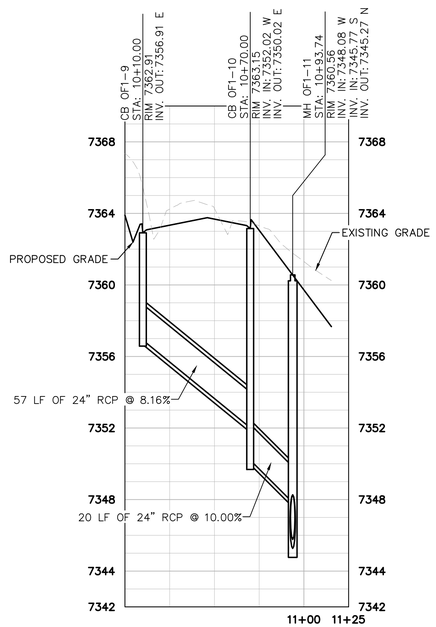

P1-R-D PROFILE VIEW

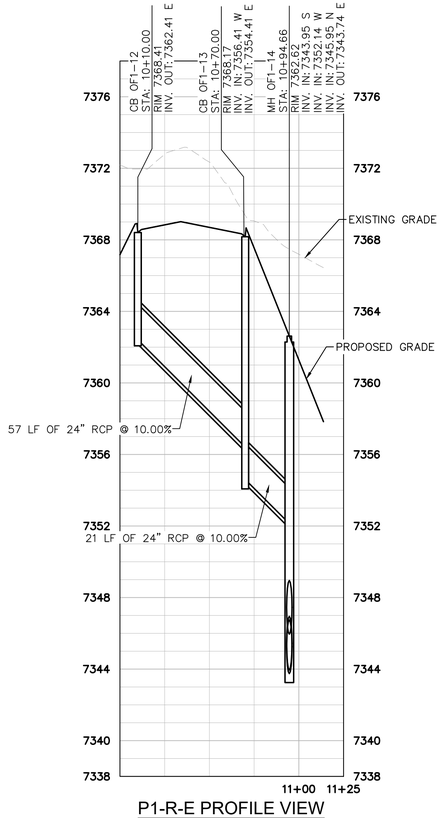


P1-R-E PROFILE VIEW

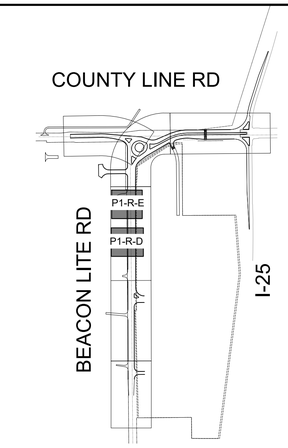

LEGEND:

- RIGHT OF WAY/ PROPERTY LINE
- PROPOSED EASEMENT
- EXISTING EASEMENT
- EXISTING CULINARY WATER LINE
- EXISTING SANITARY LINE
- EXISTING STORM LINE
- EXISTING ELECTRICAL LINE
- EXISTING GAS LINE
- PROPOSED STORM PIPE
- PROPOSED AREA INLET
- PROPOSED CURB INLET
- PROPOSED STORM MANHOLE
- PROPOSED FLARED END SECTION

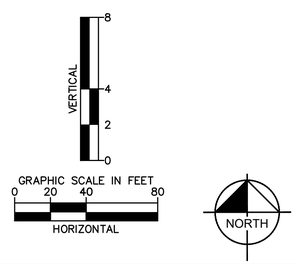

811 Know what's below. Call before you dig.

This document, together with the concepts and designs presented herein, as an instrument of service, is intended only for the specific purpose and client for which it was prepared. Reuse of and improper reliance on this document without written authorization and adaptation by Kimley-Horn and Associates, Inc. shall be without liability to Kimley-Horn and Associates, Inc.

Print Date: 9/11/26

Drawing File Name: epc offsite storm.dwg

Kimley»Horn
KIMLEY-HORN AND ASSOCIATES, INC.
6200 SOUTH SYRACUSE WAY
SUITE 300
GREENWOOD VILLAGE, COLORADO 80111
(303) 228-2300

Sheet Revisions

	Date:	Comments:	Init.
R-X			
R-X			
R-X			
R-X			

EL PASO COUNTY
DEPARTMENT OF PUBLIC WORKS
3275 AKERS DRIVE
COLORADO SPRINGS, CO
80922

FOR REVIEW ONLY
NOT FOR CONSTRUCTION
Kimley»Horn
Kimley-Horn and Associates, Inc.

60% PLANS

No Revisions:

Revised:

Void:

EL PASO COUNTY TRAVEL CENTER
PREPARED FOR
BUC-EE'S, LTD.
OFFSITE STORM P&P

Designer: APW
Detailer: DJC
Checked By: MPF


Structure Numbers:

Subset Sheet: 10 of 14


Project No./Code

KH 196094002


Sheet Number 51

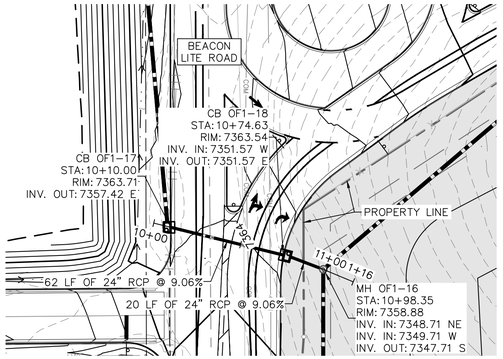


P1-R-F PLAN VIEW

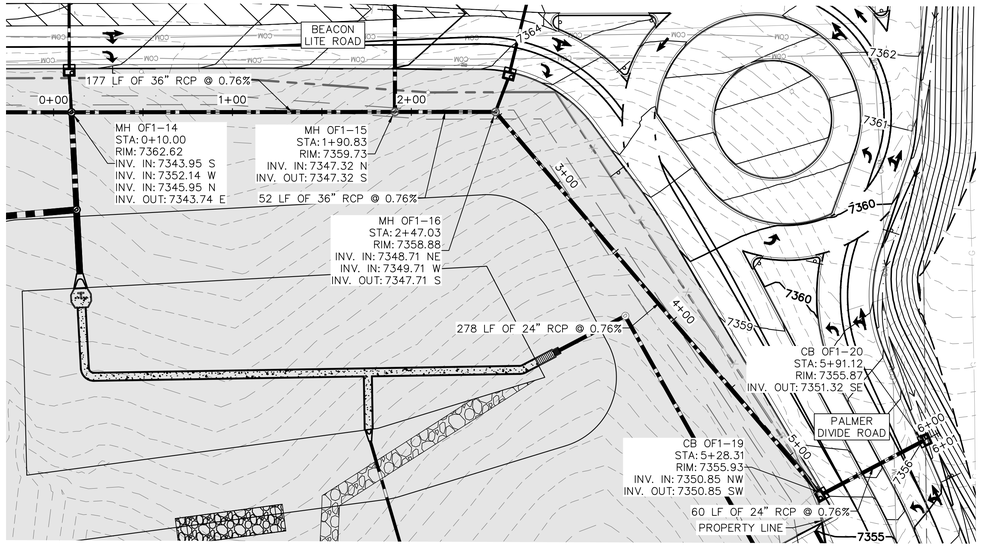


P1-R-G PLAN VIEW

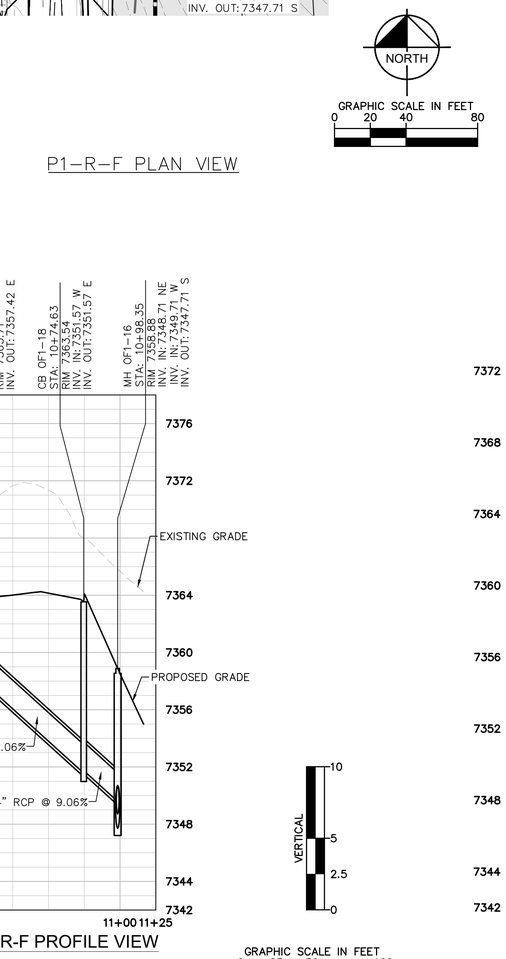

P1-R-F PROFILE VIEW

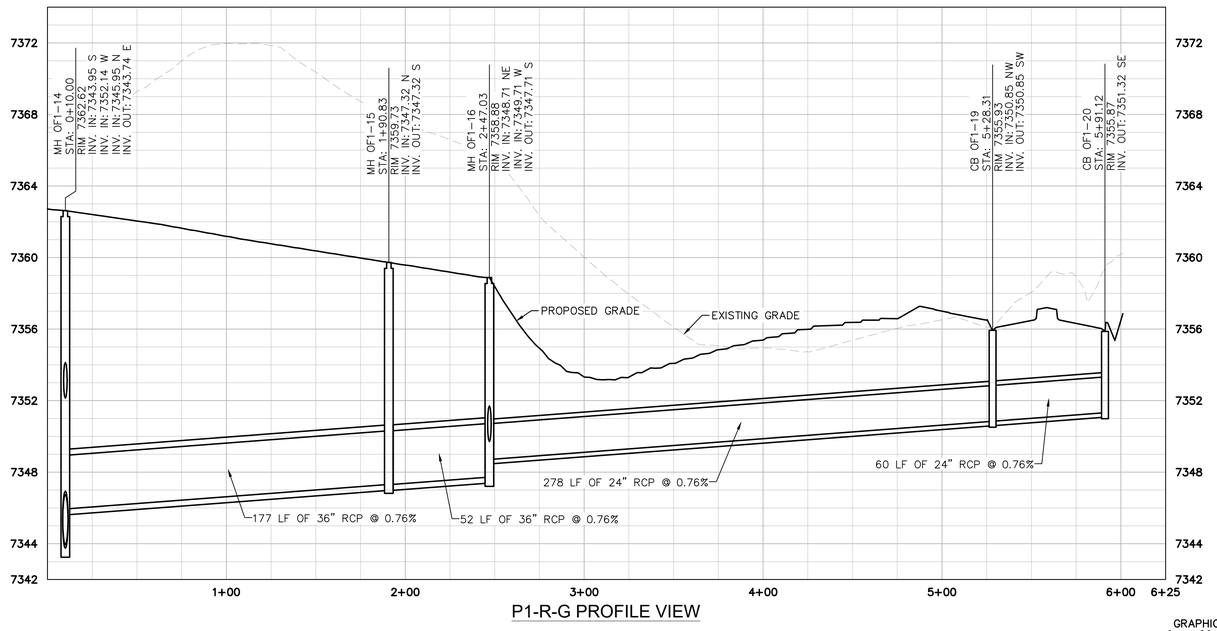

P1-R-G PROFILE VIEW

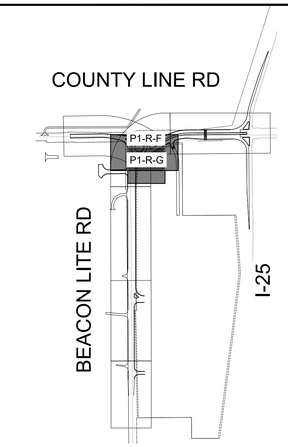

LEGEND:

- RIGHT OF WAY/ PROPERTY LINE
- PROPOSED EASEMENT
- EXISTING EASEMENT
- EXISTING CULINARY WATER LINE
- EXISTING SANITARY LINE
- EXISTING STORM LINE
- EXISTING ELECTRICAL LINE
- EXISTING GAS LINE
- PROPOSED STORM PIPE
- PROPOSED AREA INLET
- PROPOSED CURB INLET
- PROPOSED STORM MANHOLE
- PROPOSED FLARED END SECTION

Know what's below. Call before you dig.

This document, together with the concepts and designs presented herein, as an instrument of service, is intended only for the specific purpose and client for which it was prepared. Reuse of and improper reliance on this document without written authorization and adaptation by Kimley-Horn and Associates, Inc. shall be without liability to Kimley-Horn and Associates, Inc.

Print Date: 9/11/26

Drawing File Name: epc offsite storm.dwg

Kimley»Horn

KIMLEY-HORN AND ASSOCIATES, INC.
6200 SOUTH SYRACUSE WAY
SUITE 300
GREENWOOD VILLAGE, COLORADO 80111
(303) 228-2300

Sheet Revisions

	Date:	Comments:	Init.
R-X			
R-X			
R-X			
R-X			

EL PASO COUNTY
DEPARTMENT OF PUBLIC WORKS
3275 AKERS DRIVE
COLORADO SPRINGS, CO
80922

FOR REVIEW ONLY
NOT FOR CONSTRUCTION
Kimley»Horn
Kimley-Horn and Associates, Inc.

60% PLANS

No Revisions:

Revised:

Void:

EL PASO COUNTY TRAVEL CENTER
PREPARED FOR
BUC-EE'S, LTD.
OFFSITE STORM P&P

Designer: APW
Detailer: DJC
Checked By: MPF


Structure Numbers

Subset Sheet: 11 of 14


Project No./Code

KH 196094002


Sheet Number 52

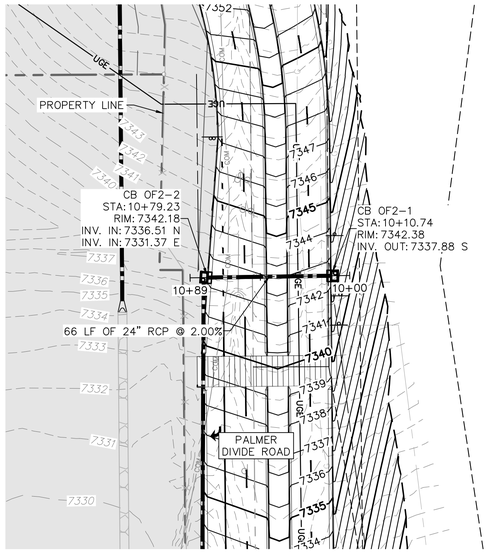


P1-R-H PLAN VIEW

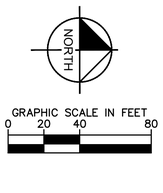


GRAPHIC SCALE IN FEET
0 20 40 80

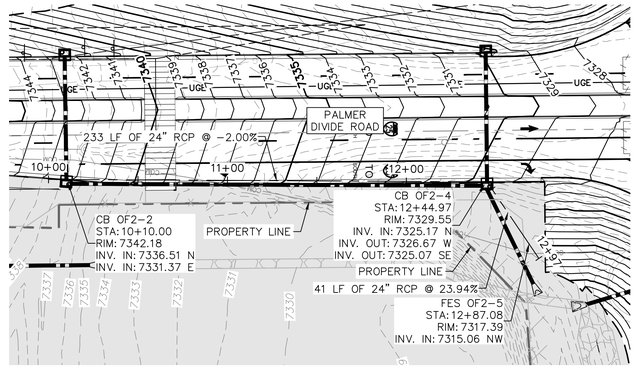


P1-R-I PLAN VIEW

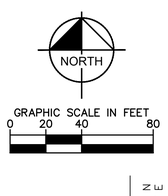


GRAPHIC SCALE IN FEET
0 20 40 80

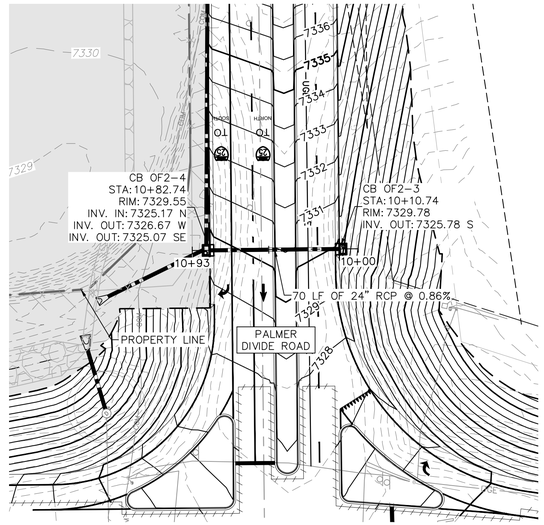


P1-R-J PLAN VIEW

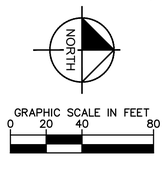


GRAPHIC SCALE IN FEET
0 20 40 80

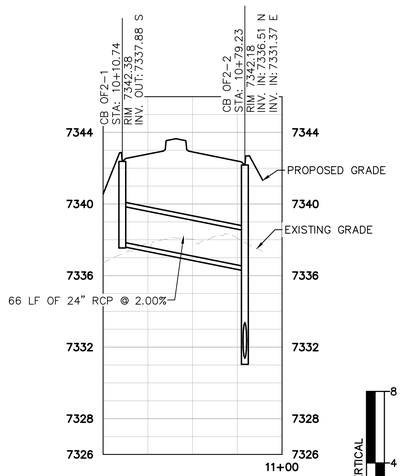

P1-R-H PROFILE VIEW

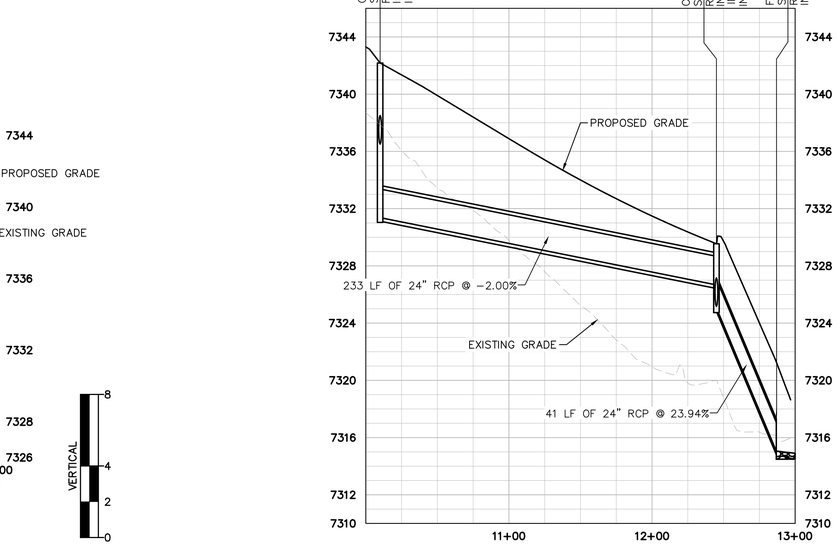

P1-R-I PROFILE VIEW

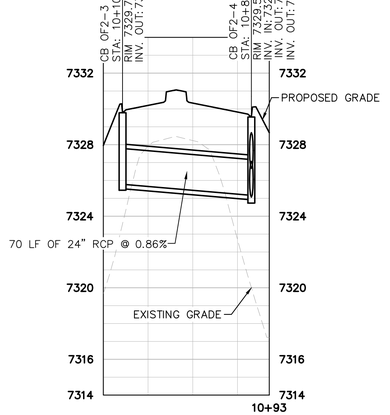


P1-R-J PROFILE VIEW

VERTICAL
0 2 4 8
GRAPHIC SCALE IN FEET
0 20 40 80
HORIZONTAL

VERTICAL
0 2.5 5 10
GRAPHIC SCALE IN FEET
0 25 50 100
HORIZONTAL

VERTICAL
0 2 4 8
GRAPHIC SCALE IN FEET
0 20 40 80
HORIZONTAL

COUNTY LINE RD

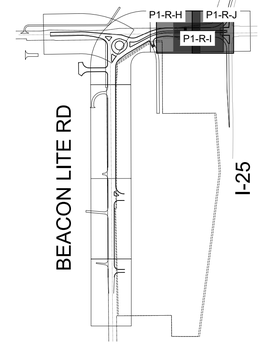

LEGEND:

- RIGHT OF WAY/ PROPERTY LINE
- PROPOSED EASEMENT
- EXISTING EASEMENT
- W — EXISTING CULINARY WATER LINE
- S — EXISTING SANITARY LINE
- ST — EXISTING STORM LINE
- E — EXISTING ELECTRICAL LINE
- G — EXISTING GAS LINE
- PROPOSED STORM PIPE
- PROPOSED AREA INLET
- PROPOSED CURB INLET
- D — PROPOSED STORM MANHOLE
- PROPOSED FLARED END SECTION

811 Know what's below. Call before you dig.

This document, together with the concepts and designs presented herein, as an instrument of service, is intended only for the specific purpose and client for which it was prepared. Reuse of and improper reliance on this document without written authorization and adaptation by Kimley-Horn and Associates, Inc. shall be without liability to Kimley-Horn and Associates, Inc.

Print Date: 9/11/26
Drawing File Name: epc offsite storm.dwg

Kimley»Horn
KIMLEY-HORN AND ASSOCIATES, INC.
6200 SOUTH SYRACUSE WAY
SUITE 300
GREENWOOD VILLAGE, COLORADO 80111
(303) 228-2300

	Sheet Revisions		
	Date:	Comments:	Init.
R-X			
R-X			
R-X			
R-X			

EL PASO COUNTY
DEPARTMENT OF PUBLIC WORKS
3275 AKERS DRIVE
COLORADO SPRINGS, CO
80922


FOR REVIEW ONLY
NOT FOR CONSTRUCTION
Kimley»Horn
Kimley-Horn and Associates, Inc.

60% PLANS
No Revisions:
Revised:
Void:

EL PASO COUNTY TRAVEL CENTER
PREPARED FOR
BUC-EE'S, LTD.
OFFSITE STORM P&P

Designer: APW
Detailer: DJC
Checked By: MPF
Structure Numbers
Subset Sheet: 12 of 14


Project No./Code
KH 196094002
Sheet Number 53

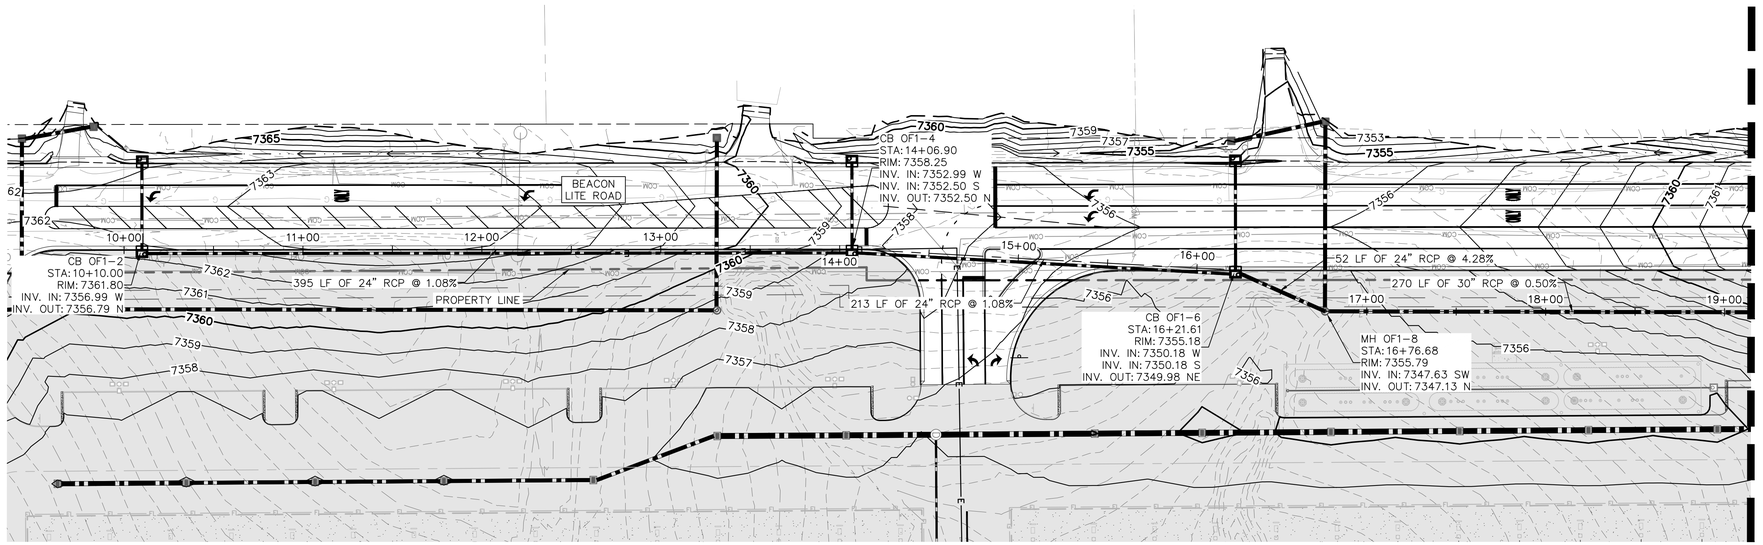

P1-R-K SOUTH PLAN VIEW

NORTH

GRAPHIC SCALE IN FEET
0 20 40 80

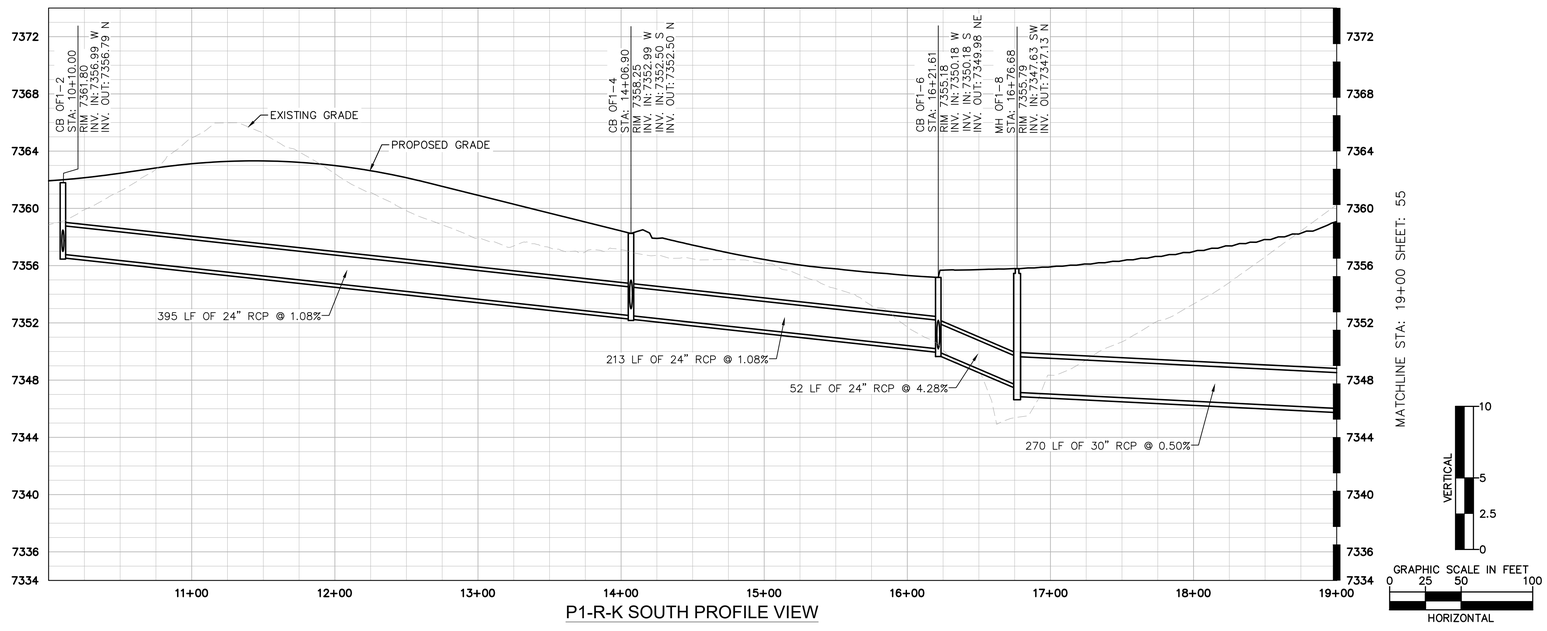


P1-R-K SOUTH PROFILE VIEW

VERTICAL
10
5
2.5
0

GRAPHIC SCALE IN FEET
0 25 50 100

HORIZONTAL

COUNTY LINE RD

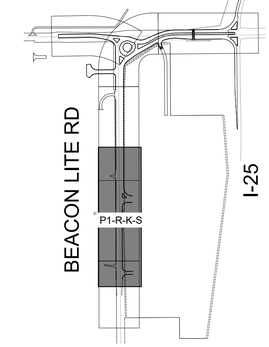

LEGEND:

- RIGHT OF WAY/ PROPERTY LINE
- PROPOSED EASEMENT
- EXISTING EASEMENT
- EXISTING CULINARY WATER LINE
- EXISTING SANITARY LINE
- EXISTING STORM LINE
- EXISTING ELECTRICAL LINE
- EXISTING GAS LINE
- PROPOSED STORM PIPE
- PROPOSED AREA INLET
- PROPOSED CURB INLET
- PROPOSED STORM MANHOLE
- PROPOSED FLARED END SECTION

811 Know what's below. Call before you dig.

This document, together with the concepts and designs presented herein, as an instrument of service, is intended only for the specific purpose and client for which it was prepared. Reuse of and improper reliance on this document without written authorization and adaptation by Kimley-Horn and Associates, Inc. shall be without liability to Kimley-Horn and Associates, Inc.

Print Date: 9/11/26

Drawing File Name: epc offsite storm.dwg

Kimley»Horn
KIMLEY-HORN AND ASSOCIATES, INC.
6200 SOUTH SYRACUSE WAY
SUITE 300
GREENWOOD VILLAGE, COLORADO 80111
(303) 228-2300

	Sheet Revisions		
	Date:	Comments:	Init.
R-X			
R-X			
R-X			
R-X			

EL PASO COUNTY
DEPARTMENT OF PUBLIC WORKS
3275 AKERS DRIVE
COLORADO SPRINGS, CO
80922

R-- FINAL
FOR REVIEW ONLY
NOT FOR CONSTRUCTION
Kimley»Horn
Kimley-Horn and Associates, Inc.

60% PLANS

No Revisions:

Revised:

Void:


EL PASO COUNTY TRAVEL CENTER
PREPARED FOR
BUC-EE'S, LTD.
OFFSITE STORM P&P

Designer:	APW	Structure Numbers	
Detailer:	DJC		
Checked By:	MPF	Subset Sheet:	13 of 14

Project No./Code

KH 196094002


Sheet Number 54

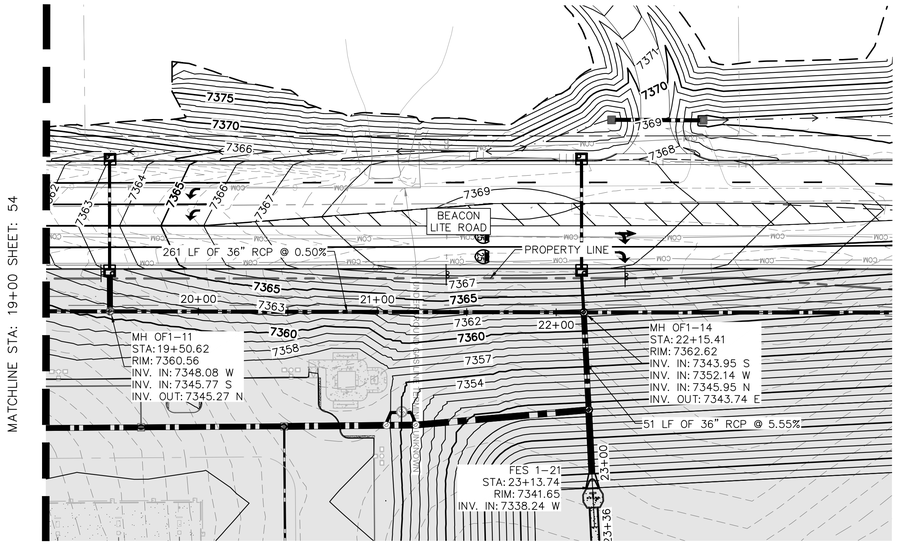

P1-R-K NORTH PLAN VIEW

NORTH

GRAPHIC SCALE IN FEET
0 20 40 80

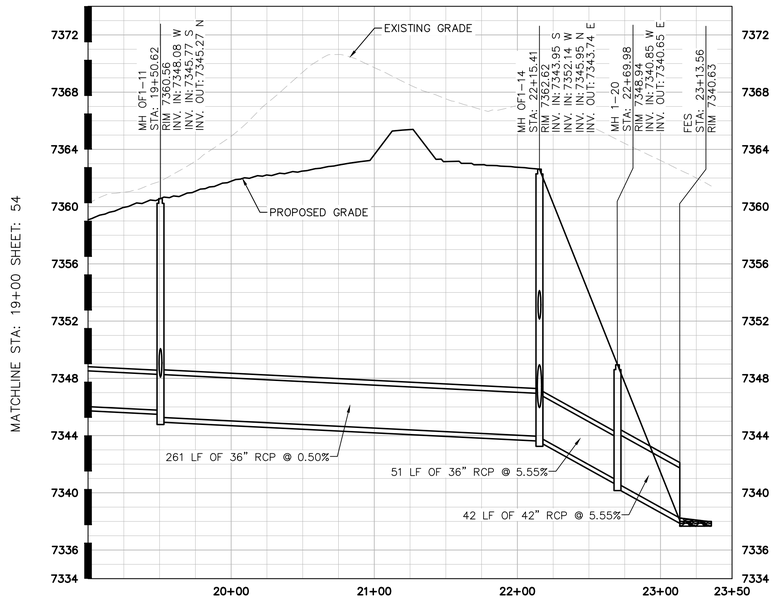


P1-R-K NORTH PROFILE VIEW

VERTICAL
10
5
2.5
0

GRAPHIC SCALE IN FEET
0 25 50 100
HORIZONTAL

NORTH

COUNTY LINE RD

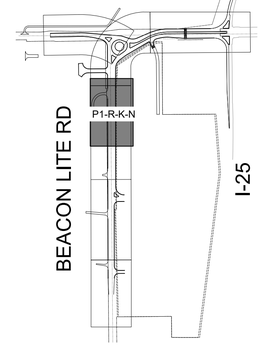

LEGEND:

- RIGHT OF WAY/ PROPERTY LINE
- PROPOSED EASEMENT
- EXISTING EASEMENT
- W — EXISTING CULINARY WATER LINE
- S — EXISTING SANITARY LINE
- ST — EXISTING STORM LINE
- E — EXISTING ELECTRICAL LINE
- G — EXISTING GAS LINE
- PROPOSED STORM PIPE
- PROPOSED AREA INLET
- PROPOSED CURB INLET
- D — PROPOSED STORM MANHOLE
- PROPOSED FLARED END SECTION

811 Know what's below. Call before you dig.

This document, together with the concepts and designs presented herein, as an instrument of service, is intended only for the specific purpose and client for which it was prepared. Reuse of and improper reliance on this document without written authorization and adaptation by Kimley-Horn and Associates, Inc. shall be without liability to Kimley-Horn and Associates, Inc.

Print Date: 9/11/26
Drawing File Name: epc offsite storm.dwg

Kimley»Horn
KIMLEY-HORN AND ASSOCIATES, INC.
6200 SOUTH SYRACUSE WAY
SUITE 300
GREENWOOD VILLAGE, COLORADO 80111
(303) 228-2300

Sheet Revisions

	Date:	Comments:	Init.
R-X			
R-X			
R-X			
R-X			

EL PASO COUNTY
DEPARTMENT OF PUBLIC WORKS
3275 AKERS DRIVE
COLORADO SPRINGS, CO
80922


R-- FINAL
FOR REVIEW ONLY
NOT FOR CONSTRUCTION
Kimley»Horn
Kimley-Horn and Associates, Inc.

60% PLANS
No Revisions:
Revised:
Void:

EL PASO COUNTY TRAVEL CENTER
PREPARED FOR
BUC-EE'S, LTD.
OFFSITE STORM P&P

Designer: APW
Detailer: DJC
Checked By: MPF
Structure Numbers
Subset Sheet: 14 of 14

Project No./Code
KH 196094002
Sheet Number 55

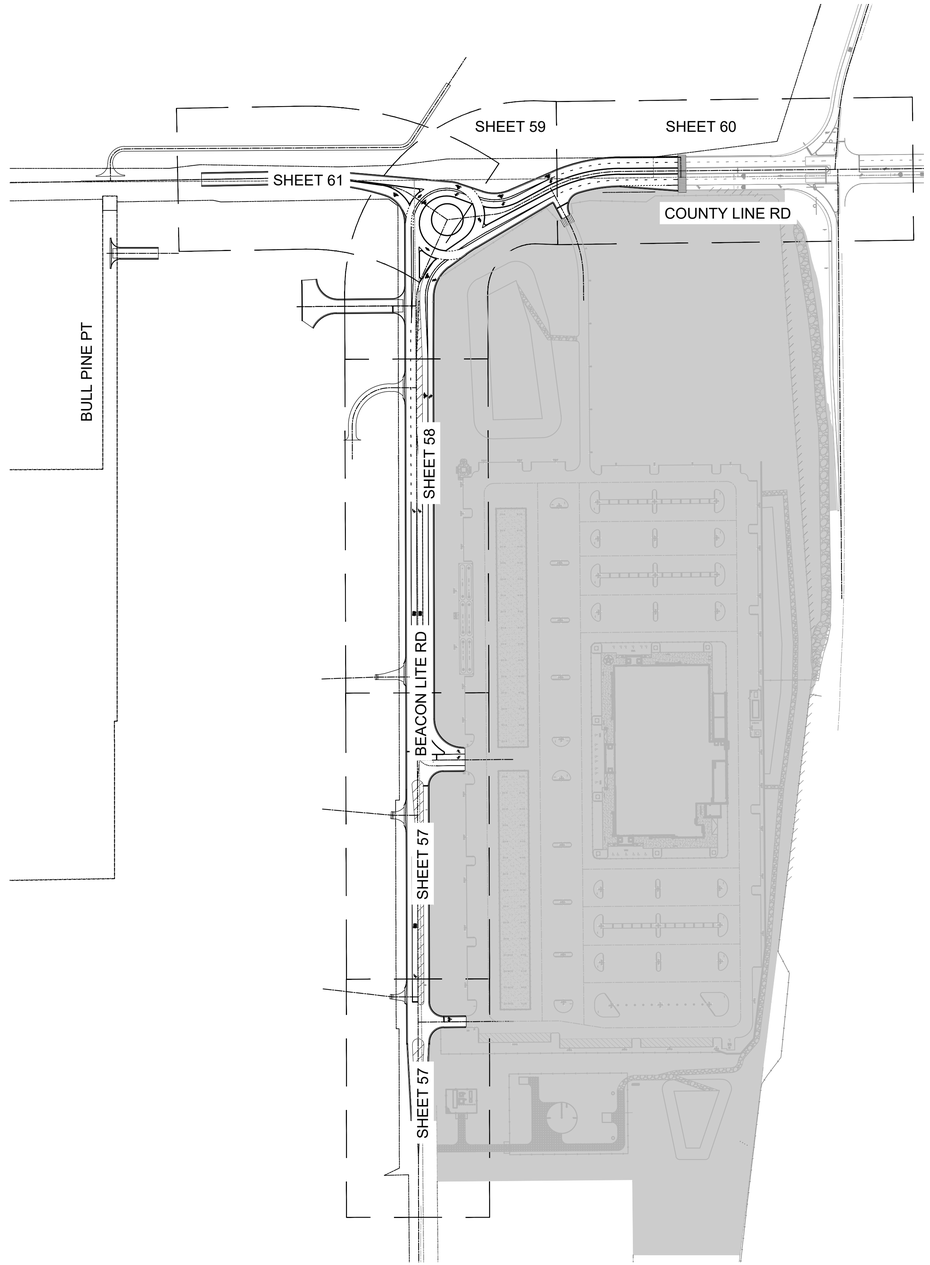

LEGEND:

ONSITE HATCH

NORTH

GRAPHIC SCALE IN FEET
0 75 150 300

811
Know what's **below.**
Call before you dig.

This document, together with the concepts and designs presented herein, as an instrument of service, is intended only for the specific purpose and client for which it was prepared. Reuse of and improper reliance on this document without written authorization and adaptation by Kimley-Horn and Associates, Inc. shall be without liability to Kimley-Horn and Associates, Inc.

Print Date: 5/19/26

Drawing File Name: epc-07_ signing and markings (km).dwg

Kimley»Horn
KIMLEY-HORN AND ASSOCIATES, INC.
6200 SOUTH SYRACUSE WAY
SUITE 300
GREENWOOD VILLAGE, COLORADO 80111
(303) 228-2300

	Sheet Revisions		
	Date:	Comments:	Init.
R-X			
R-X			
R-X			
R-X			

EL PASO COUNTY
DEPARTMENT OF PUBLIC WORKS
3275 AKERS DRIVE
COLORADO SPRINGS, CO
80922

FOR REVIEW ONLY
NOT FOR CONSTRUCTION
Kimley»Horn
Kimley-Horn and Associates, Inc.

60% PLANS

No Revisions:

Revised:

Void:

EL PASO COUNTY TRAVEL CENTER


PREPARED FOR
BUC-EE'S, LTD.
SIGNING AND MARKING


Designer:	APW	Structure Numbers	
Detailer:	DJC		
Checked By:	MPF	Subset Sheet:	1 of 6


Project No./Code

KH 196094002

Sheet Number 56

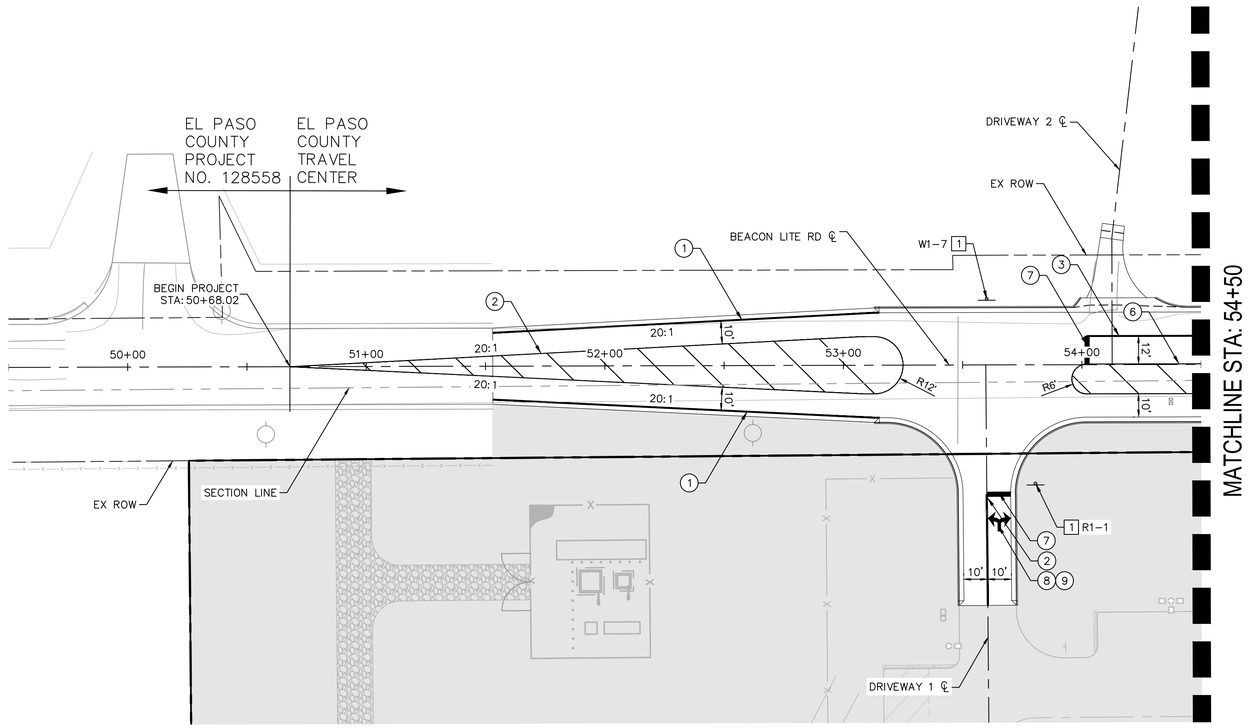

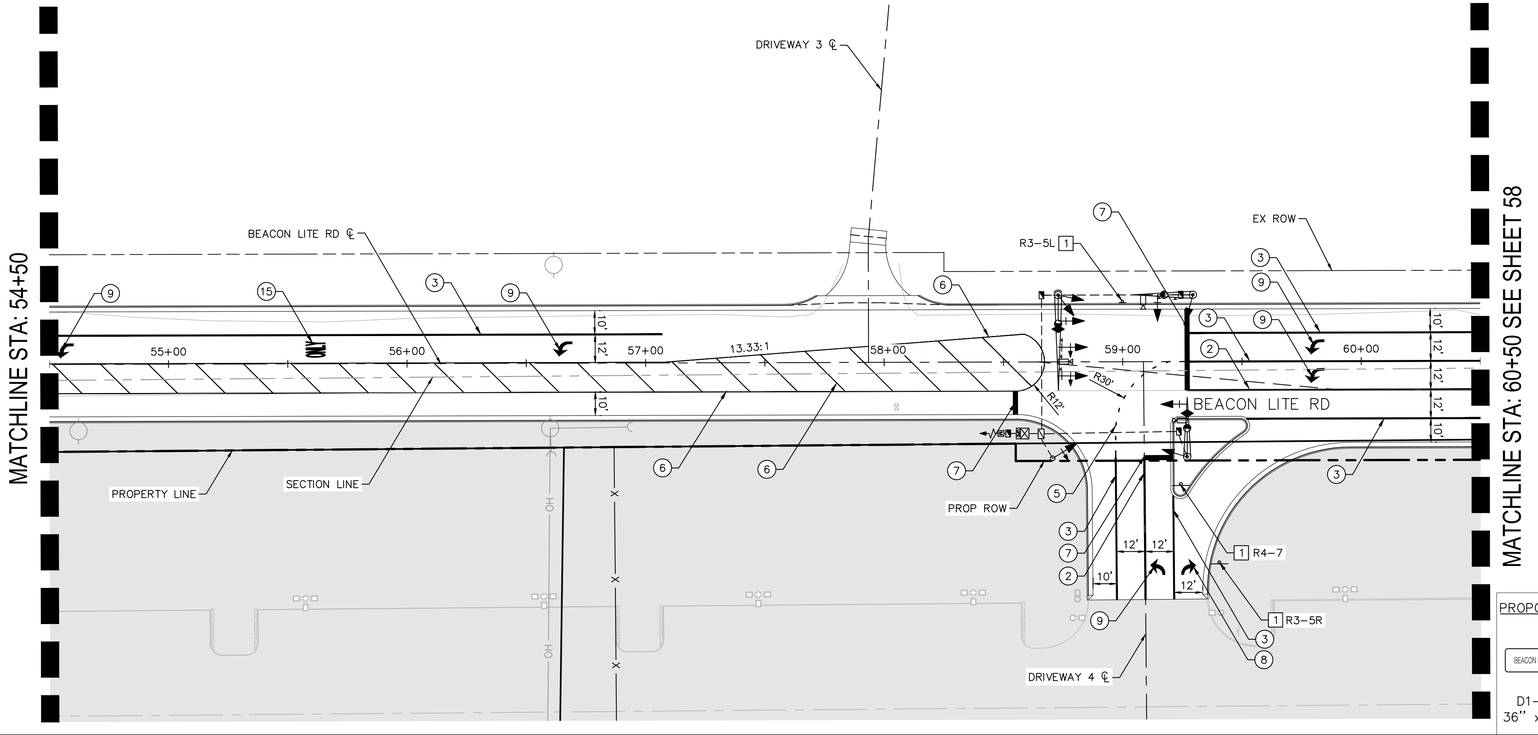

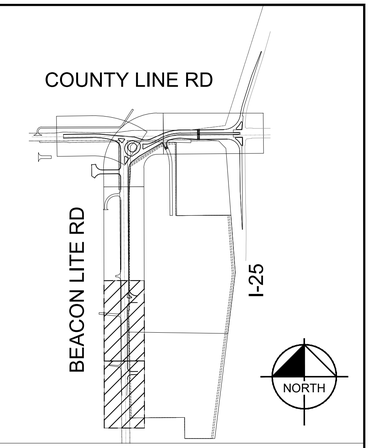


SIGNING NOTES

1 NEW SIGN PANEL WITH NEW POST

STRIPING NOTES

1. EDGE LINE: SOLID WHITE, 4" WIDE
2. SOLID DOUBLE YELLOW LINE: 4" WIDE
3. CHANNELIZING LINE: SOLID WHITE, 8" WIDE
4. LANE LINE: BROKEN WHITE, 4" WIDE – 10' SEGMENTS WITH 30' GAPS
5. LANE LINE: BROKEN WHITE, 4" WIDE – 2' SEGMENTS WITH 6' GAPS
6. LANE LINE: SOLID YELLOW, 4" WIDE
7. STOP BAR: SOLID WHITE, 2' WIDE
8. RIGHT TURN ARROW
9. LEFT TURN ARROW
10. RIGHT–THRU ARROW
11. LEFT–THRU ARROW
12. THRU ARROW
13. INTERSTATE ROUTE SHIELD
14. DIRECTIONAL MARKING
15. "ONLY" MARKING
16. YIELD ARROWS

PROPOSED SIGN LEGEND

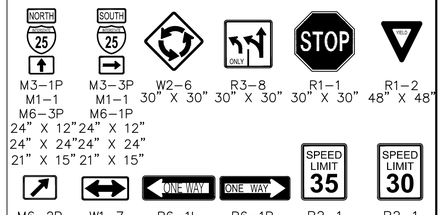

M3–1P, M1–1, M6–3P 24" X 12", 24" X 24", 21" X 15" | M3–3P, M1–1, M6–1P 24" X 12", 24" X 24", 21" X 15" | W2–6 30" X 30" | R3–8 30" X 30" | R1–1 30" X 30" | R1–2 48" X 48"


M6–2P 21" x 15" | W1–7 24" X 12" | R6–1L 36" x 12" | R6–1R 36" x 12" | R2–1 24" X 30" | R2–1 24" X 30"

CROWN LINE TRANSITION

PROPOSED SIGN LEGEND (CONTINUED)



D1–1d 36" x 18" | D1–1d 36" x 18" | R3–5L 30" x 36" | R3–5R 30" X 36"

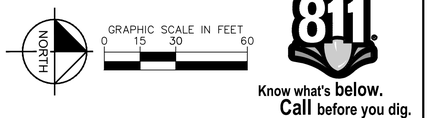

811 Know what's below. Call before you dig.

This document, together with the concepts and designs presented herein, as an instrument of service, is intended only for the specific purpose and client for which it was prepared. Reuse of and improper reliance on this document without written authorization and adaptation by Kimley-Horn and Associates, Inc. shall be without liability to Kimley-Horn and Associates, Inc.

Print Date: 5/19/26

Drawing File Name: epc-07_signing and markings.dwg

Kimley»Horn

KIMLEY-HORN AND ASSOCIATES, INC.
6200 SOUTH SYRACUSE WAY
SUITE 300
GREENWOOD VILLAGE, COLORADO 80111
(303) 228-2300

R-X
R-X
R-X
R-X

Sheet Revisions

Date:	Comments:	Init.

EL PASO COUNTY
DEPARTMENT OF PUBLIC WORKS
3275 AKERS DRIVE
COLORADO SPRINGS, CO
80922

R-- FINAL
FOR REVIEW ONLY
NOT FOR CONSTRUCTION
Kimley»Horn
Kimley-Horn and Associates, Inc.

60% PLANS

No Revisions:

Revised:

Void:


EL PASO COUNTY TRAVEL CENTER
PREPARED FOR
BUC-EE'S, LTD.
SIGNING AND MARKING


Designer:	APW	Structure Numbers	
Detailer:	DJC		
Checked By:	MPF	Subset Sheet:	2 of 6

Project No./Code

KH 196094002

Sheet Number 57

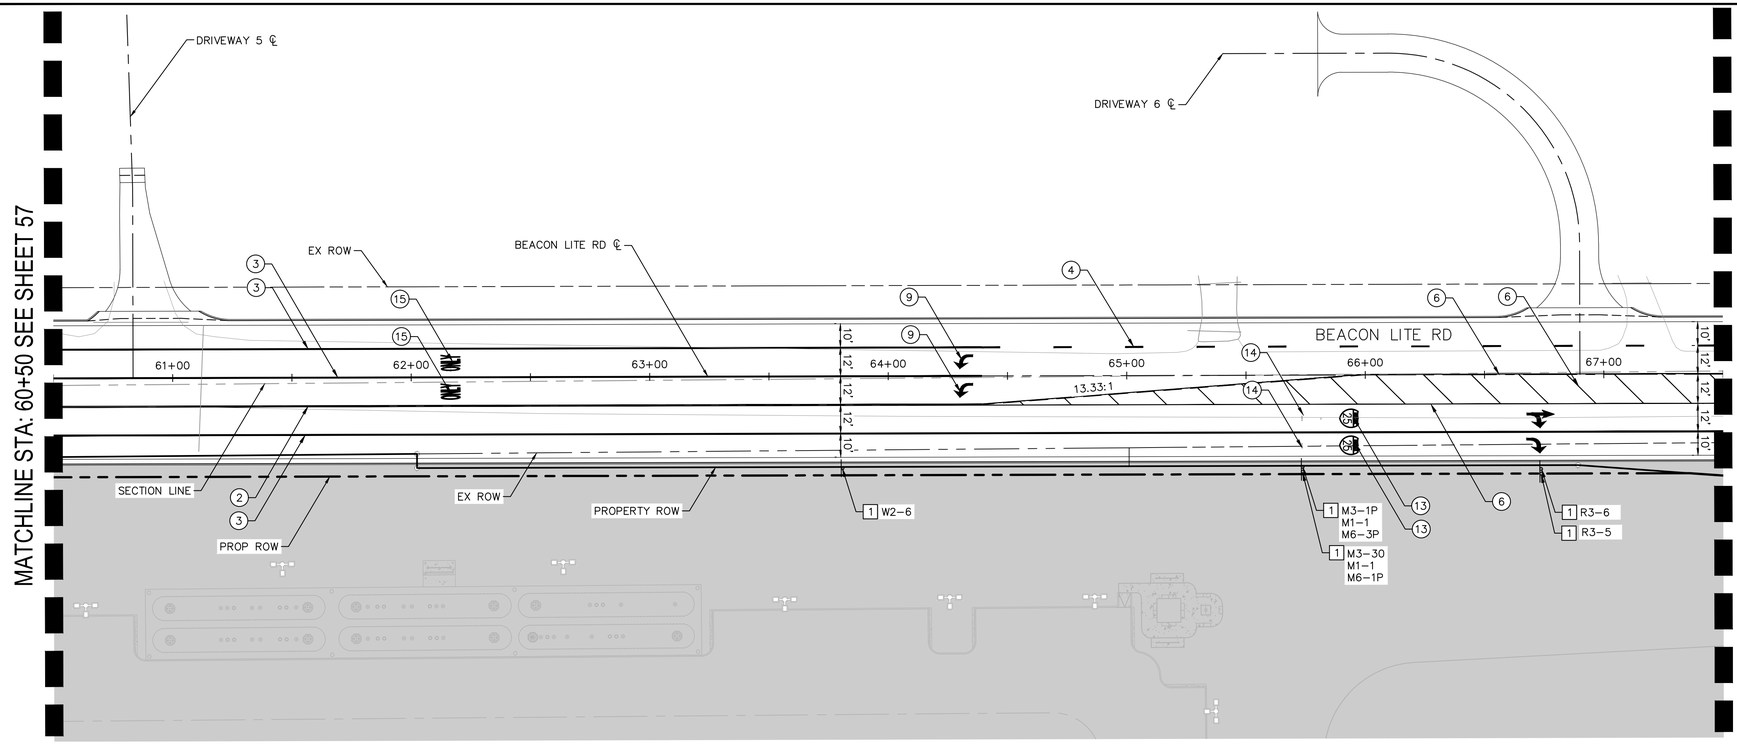

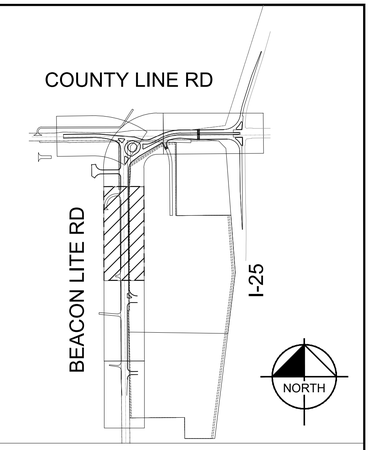


SIGNING NOTES

1. NEW SIGN PANEL WITH NEW POST

STRIPING NOTES

1. EDGE LINE: SOLID WHITE, 4" WIDE
2. SOLID DOUBLE YELLOW LINE: 4" WIDE
3. CHANNELIZING LINE: SOLID WHITE, 8" WIDE
4. LANE LINE: BROKEN WHITE, 4" WIDE – 10' SEGMENTS WITH 30' GAPS
5. LANE LINE: BROKEN WHITE, 4" WIDE – 2' SEGMENTS WITH 6' GAPS
6. LANE LINE: SOLID YELLOW, 4" WIDE
7. STOP BAR: SOLID WHITE, 2' WIDE
8. RIGHT TURN ARROW
9. LEFT TURN ARROW
10. RIGHT–THRU ARROW
11. LEFT–THRU ARROW
12. THRU ARROW
13. INTERSTATE ROUTE SHIELD
14. DIRECTIONAL MARKING
15. "ONLY" MARKING
16. YIELD ARROWS

PROPOSED SIGN LEGEND

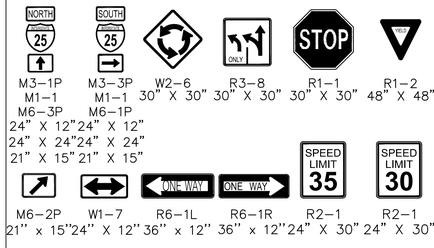


M3–1P, M1–1, M6–3P: 24" X 12", 24" X 24", 21" X 15"
M3–3P, M1–1, M6–1P: 24" X 12", 24" X 24", 21" X 15"
W2–6: 30" X 30"
R3–8: 30" X 30"
R1–1: 30" X 30"
R1–2: 48" X 48"
M6–2P: 21" x 15"
W1–7: 24" X 12"
R6–1L: 36" x 12"
R6–1R: 36" x 12"
R2–1: 24" X 30"
R2–1: 24" X 30"

PROPOSED SIGN LEGEND (CONTINUED)



D1–1d 36" x 18"
D1–1d 36" x 18"
R3–5L 30" X 36"
R3–5R 30" X 36"

CROWN LINE TRANSITION

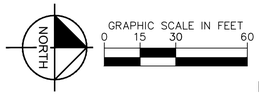

811 Know what's below. Call before you dig.

This document, together with the concepts and designs presented herein, as an instrument of service, is intended only for the specific purpose and client for which it was prepared. Reuse of and improper reliance on this document without written authorization and adaptation by Kimley-Horn and Associates, Inc. shall be without liability to Kimley-Horn and Associates, Inc.

Print Date: 5/19/26
Drawing File Name: epc-07_signing and markings.dwg

Kimley»Horn
KIMLEY-HORN AND ASSOCIATES, INC.
6200 SOUTH SYRACUSE WAY
SUITE 300
GREENWOOD VILLAGE, COLORADO 80111
(303) 228-2300

	Sheet Revisions		
	Date:	Comments:	Init.
R-X			
R-X			
R-X			
R-X			

EL PASO COUNTY
DEPARTMENT OF PUBLIC WORKS
3275 AKERS DRIVE
COLORADO SPRINGS, CO
80922

R-- FINAL
FOR REVIEW ONLY
NOT FOR CONSTRUCTION
Kimley»Horn
Kimley-Horn and Associates, Inc.

60% PLANS
No Revisions:
Revised:
Void:

EL PASO COUNTY TRAVEL CENTER
PREPARED FOR
BUC-EE'S, LTD.
SIGNING AND MARKING


Designer:	APW	Structure	
Detailer:	DJC	Numbers	
Checked By:	MPF	Subset Sheet:	3 of 6


Project No./Code

KH 196094002

Sheet Number 58

Will need a lighting plan for the roundabout

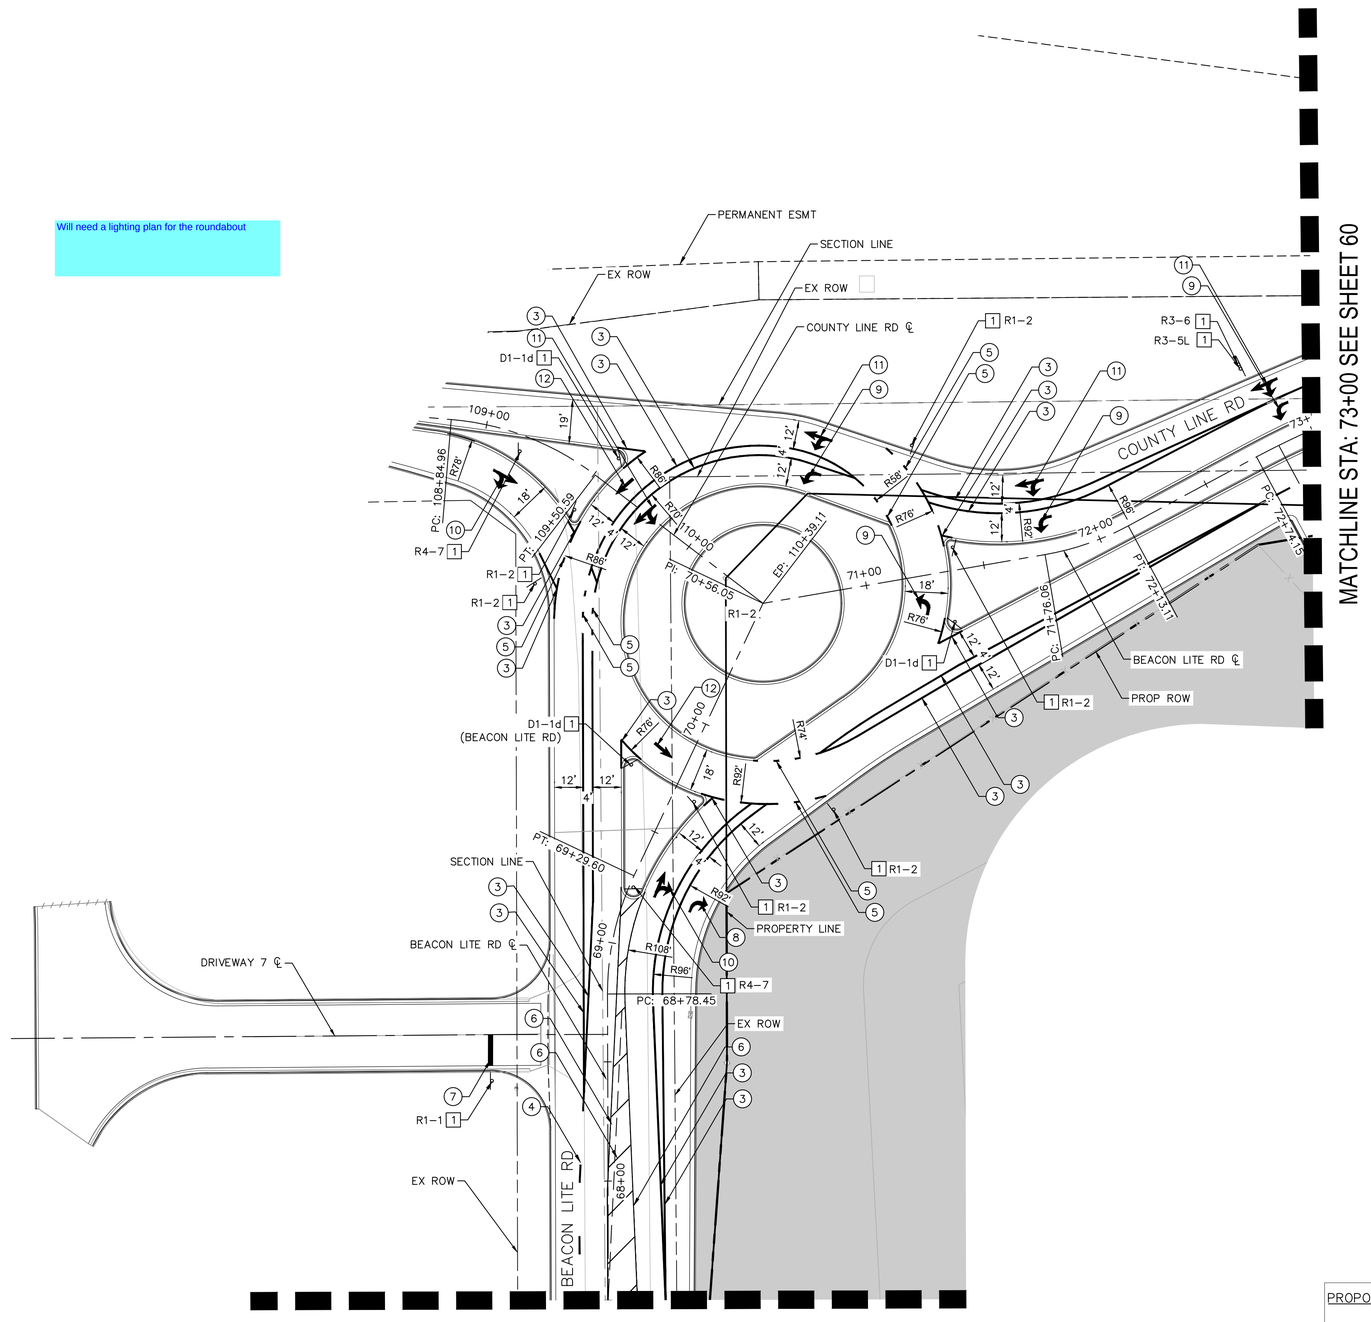

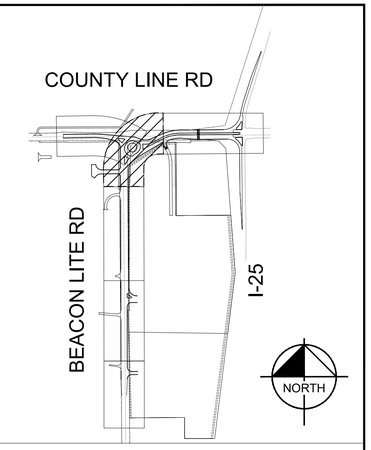


SIGNING NOTES

1. NEW SIGN PANEL WITH NEW POST

STRIPING NOTES

1. EDGE LINE: SOLID WHITE, 4" WIDE
2. SOLID DOUBLE YELLOW LINE: 4" WIDE
3. CHANNELIZING LINE: SOLID WHITE, 8" WIDE
4. LANE LINE: BROKEN WHITE, 4" WIDE – 10' SEGMENTS WITH 30' GAPS
5. LANE LINE: BROKEN WHITE, 4" WIDE – 2' SEGMENTS WITH 6' GAPS
6. LANE LINE: SOLID YELLOW, 4" WIDE
7. STOP BAR: SOLID WHITE, 2' WIDE
8. RIGHT TURN ARROW
9. LEFT TURN ARROW
10. RIGHT–THRU ARROW
11. LEFT–THRU ARROW
12. THRU ARROW
13. INTERSTATE ROUTE SHIELD
14. DIRECTIONAL MARKING
15. "ONLY" MARKING
16. YIELD ARROWS

PROPOSED SIGN LEGEND

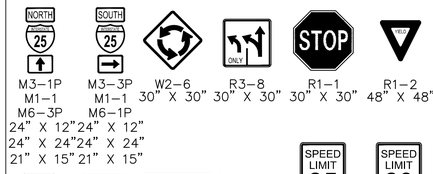


M3–1P, M1–1, M6–3P: 24" X 12" / 24" X 24" / 21" X 15"
M3–3P, M1–1, M6–1P: 24" X 12" / 24" X 24" / 21" X 15"
W2–6: 30" X 30"
R3–8: 30" X 30"
R1–1: 30" X 30"
R1–2: 48" X 48"
M6–2P: 21" x 15"
W1–7: 24" X 12"
R6–1L: 36" x 12"
R6–1R: 36" x 12"
R2–1: 24" X 30"
R2–1: 24" X 30"

PROPOSED SIGN LEGEND (CONTINUED)



D1–1d, 36" x 18"
D1–1d, 36" x 18"
R3–5L, 30" X 36"
R3–5R, 30" X 36"

CROWN LINE TRANSITION

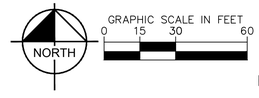

811 Know what's below. Call before you dig.

This document, together with the concepts and designs presented herein, as an instrument of service, is intended only for the specific purpose and client for which it was prepared. Reuse of and improper reliance on this document without written authorization and adaptation by Kimley-Horn and Associates, Inc. shall be without liability to Kimley-Horn and Associates, Inc.

Print Date: 5/19/26

Drawing File Name: epc-07_signing and markings.dwg

Kimley»Horn

KIMLEY-HORN AND ASSOCIATES, INC.
6200 SOUTH SYRACUSE WAY
SUITE 300
GREENWOOD VILLAGE, COLORADO 80111
(303) 228-2300

Sheet Revisions		
Date:	Comments:	Init.
R-X		
R-X		
R-X		
R-X		

EL PASO COUNTY
DEPARTMENT OF PUBLIC WORKS
3275 AKERS DRIVE
COLORADO SPRINGS, CO
80922

R-- FINAL
FOR REVIEW ONLY
NOT FOR CONSTRUCTION
Kimley»Horn
Kimley-Horn and Associates, Inc.

60% PLANS

No Revisions:

Revised:

Void:

EL PASO COUNTY TRAVEL CENTER
PREPARED FOR
BUC-EE'S, LTD.
SIGNING AND MARKING


Designer:	APW	Structure Numbers	
Detailer:	DJC		
Checked By:	MPF	Subset Sheet:	4 of 6


Project No./Code

KH 196094002

Sheet Number 59

This document, together with the concepts and designs presented herein, as an instrument of service, is intended only for the specific purpose and client for which it was prepared. Reuse of and improper reliance on this document without written authorization and adaptation by Kimley-Horn and Associates, Inc. shall be without liability to Kimley-Horn and Associates, Inc.

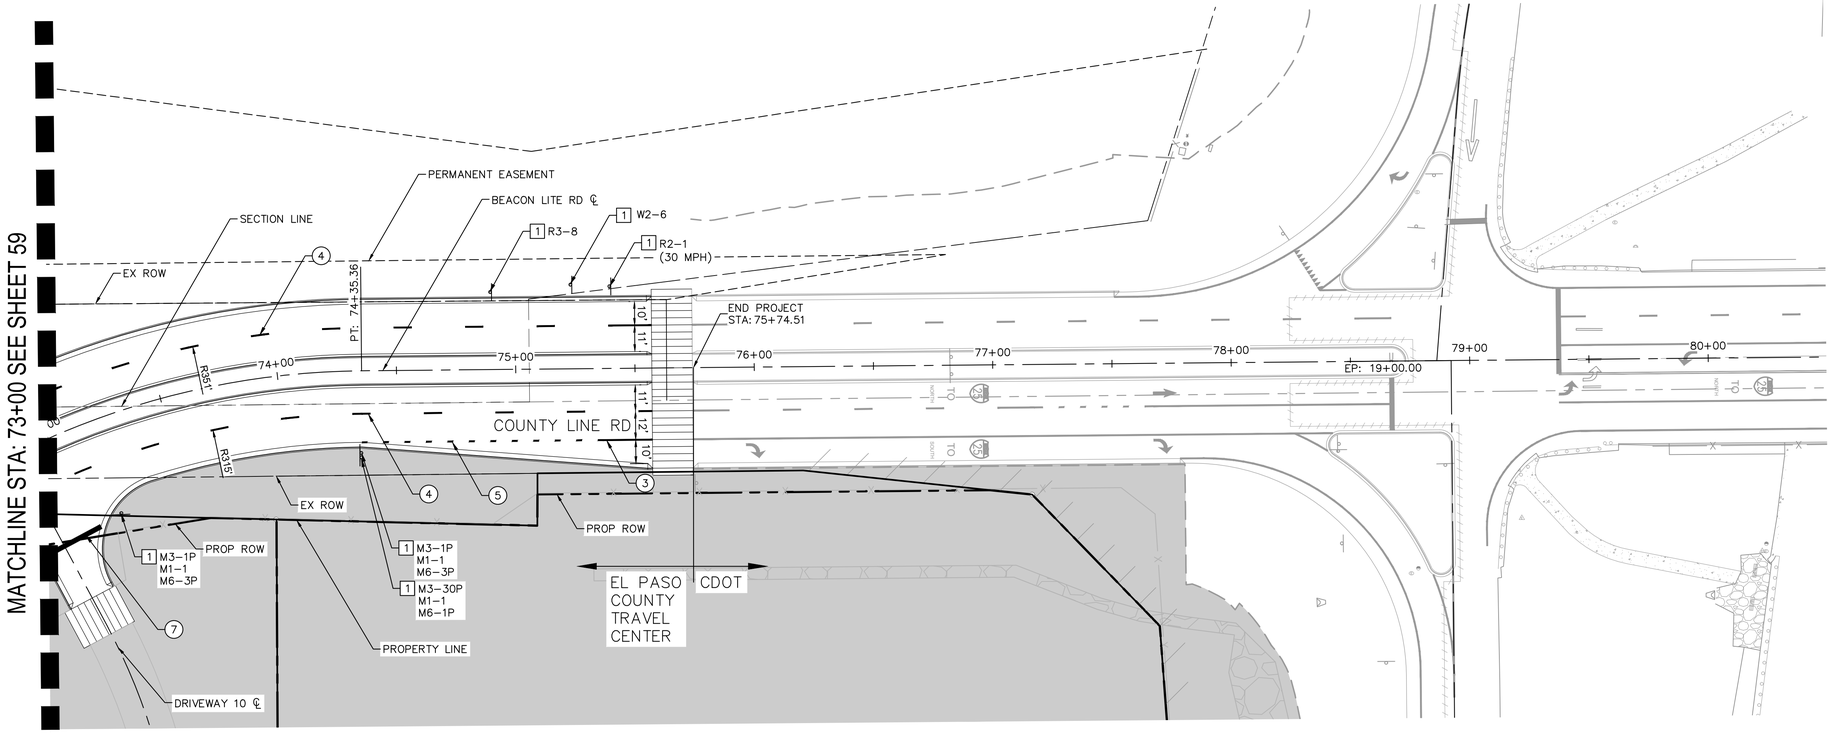

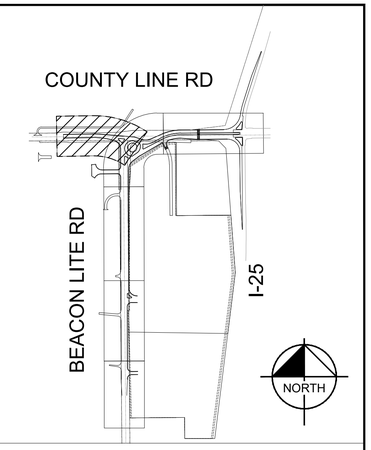


SIGNING NOTES

1. NEW SIGN PANEL WITH NEW POST

STRIPING NOTES

1. EDGE LINE: SOLID WHITE, 4" WIDE
2. SOLID DOUBLE YELLOW LINE: 4" WIDE
3. CHANNELIZING LINE: SOLID WHITE, 8" WIDE
4. LANE LINE: BROKEN WHITE, 4" WIDE – 10' SEGMENTS WITH 30' GAPS
5. LANE LINE: BROKEN WHITE, 4" WIDE – 2' SEGMENTS WITH 6' GAPS
6. LANE LINE: SOLID YELLOW, 4" WIDE
7. STOP BAR: SOLID WHITE, 2' WIDE
8. RIGHT TURN ARROW
9. LEFT TURN ARROW
10. RIGHT–THRU ARROW
11. LEFT–THRU ARROW
12. THRU ARROW
13. INTERSTATE ROUTE SHIELD
14. DIRECTIONAL MARKING
15. "ONLY" MARKING
16. YIELD ARROWS

PROPOSED SIGN LEGEND

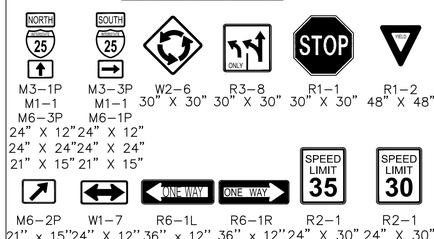

M3–1P, M1–1, M6–3P	M3–3P, M1–1, M6–1P	W2–6	R3–8	R1–1	R1–2
24" X 12" 24" X 12" 24" X 24" 21" X 15"	24" X 12" 24" X 12" 24" X 24" 21" X 15"	30" X 30"	30" X 30"	30" X 30"	48" X 48"

M6–2P	W1–7	R6–1L	R6–1R	R2–1	R2–1
21" x 15"	24" X 12"	36" x 12"	36" x 12"	24" X 30"	24" X 30"

PROPOSED SIGN LEGEND (CONTINUED)



D1–1d	D1–1d	R3–5L	R3–5R
36" x 18"	36" x 18"	30" x 36"	30" X 36"

CROWN LINE TRANSITION

NORTH

GRAPHIC SCALE IN FEET
0 15 30 60

811 Know what's below. Call before you dig.

Print Date: 5/19/26

Drawing File Name: epc-07_signing and markings.dwg

Kimley»Horn
KIMLEY–HORN AND ASSOCIATES, INC.
6200 SOUTH SYRACUSE WAY
SUITE 300
GREENWOOD VILLAGE, COLORADO 80111
(303) 228–2300

	Sheet Revisions		
	Date:	Comments:	Init.
R–X			
R–X			
R–X			
R–X			

EL PASO COUNTY COLORADO EST. 1861

EL PASO COUNTY
DEPARTMENT OF PUBLIC WORKS
3275 AKERS DRIVE
COLORADO SPRINGS, CO
80922

FOR REVIEW ONLY
NOT FOR CONSTRUCTION
Kimley»Horn
Kimley-Horn and Associates, Inc.

60% PLANS

No Revisions:

Revised:

Void:


EL PASO COUNTY TRAVEL CENTER
PREPARED FOR
BUC-EE'S, LTD.
SIGNING AND MARKING


Designer:	APW	Structure Numbers	
Detailer:	DJC		
Checked By:	MPF	Subset Sheet:	5 of 6

Project No./Code

KH 196094002

Sheet Number 60

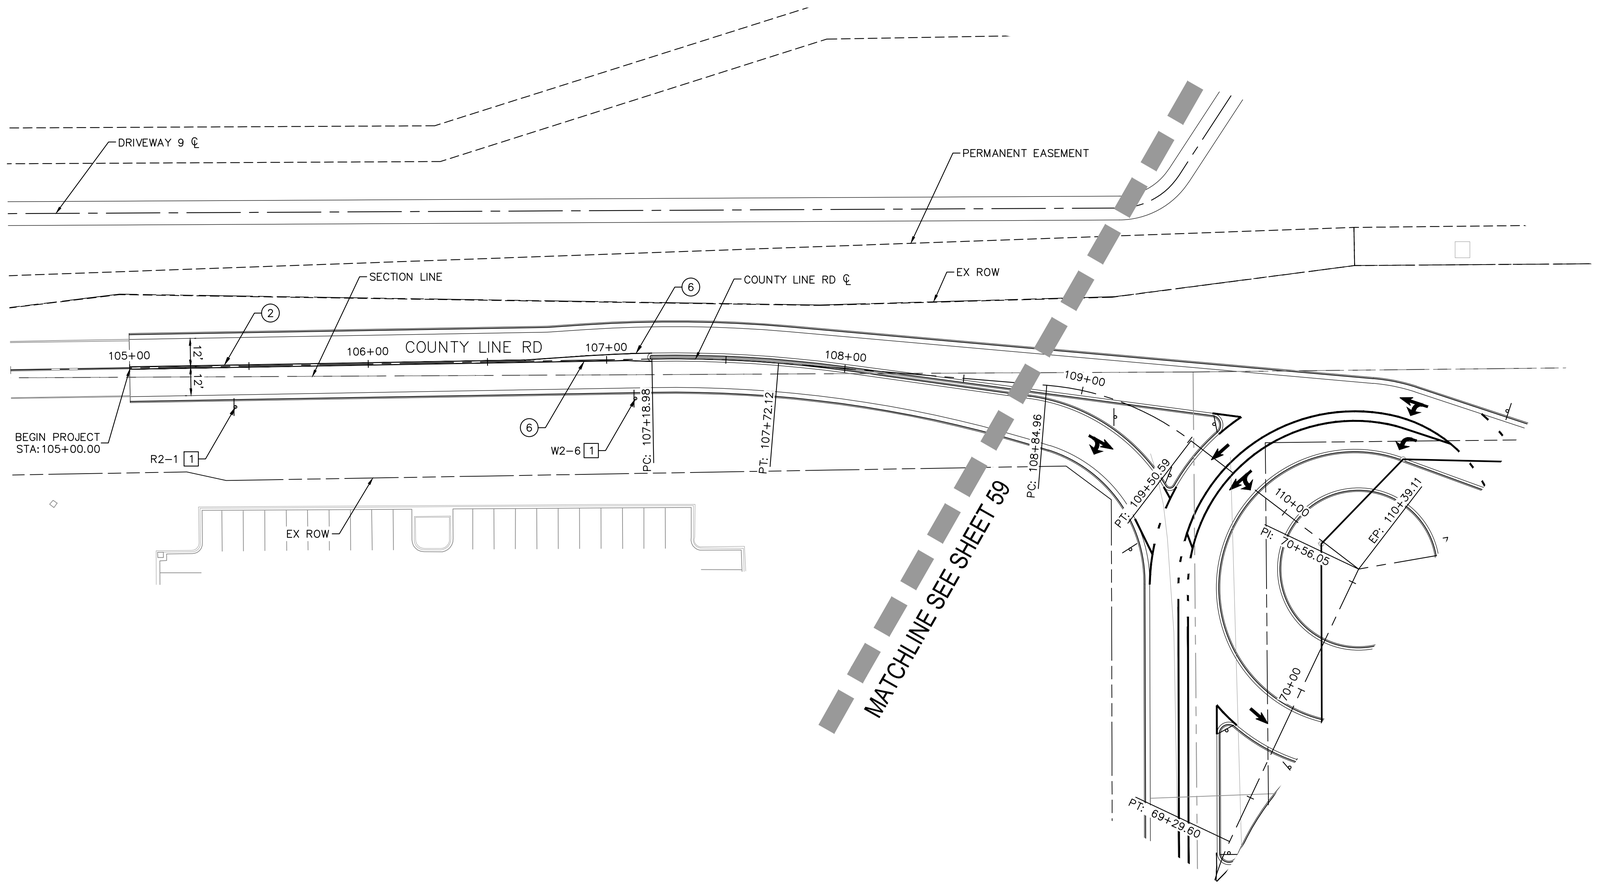

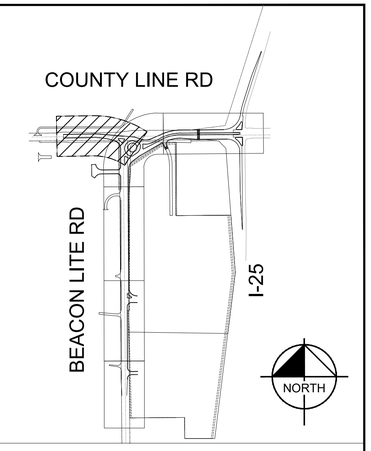


SIGNING NOTES

1 NEW SIGN PANEL WITH NEW POST

STRIPING NOTES

1. EDGE LINE: SOLID WHITE, 4" WIDE
2. SOLID DOUBLE YELLOW LINE: 4" WIDE
3. CHANNELIZING LINE: SOLID WHITE, 8" WIDE
4. LANE LINE: BROKEN WHITE, 4" WIDE – 10' SEGMENTS WITH 30' GAPS
5. LANE LINE: BROKEN WHITE, 4" WIDE – 2' SEGMENTS WITH 6' GAPS
6. LANE LINE: SOLID YELLOW, 4" WIDE
7. STOP BAR: SOLID WHITE, 2' WIDE
8. RIGHT TURN ARROW
9. LEFT TURN ARROW
10. RIGHT–THRU ARROW
11. LEFT–THRU ARROW
12. THRU ARROW
13. INTERSTATE ROUTE SHIELD
14. DIRECTIONAL MARKING
15. "ONLY" MARKING
16. YIELD ARROWS

PROPOSED SIGN LEGEND

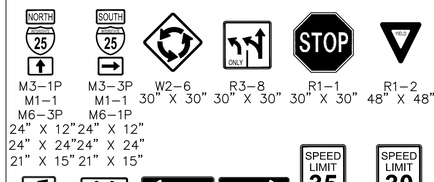


M3–1P, M1–1, M6–3P 24" X 12" / 24" X 24" / 21" X 15"
M3–3P, M1–1, M6–1P 24" X 12" / 24" X 24" / 21" X 15"
W2–6 30" X 30"
R3–8 30" X 30"
R1–1 30" X 30"
R1–2 48" X 48"
M6–2P 21" x 15"
W1–7 24" X 12"
R6–1L 36" x 12"
R6–1R 36" x 12"
R2–1 24" X 30"
R2–1 24" X 30"

PROPOSED SIGN LEGEND (CONTINUED)



D1–1d 36" x 18"
D1–1d 36" x 18"
R3–5L 30" x 36"
R3–5R 30" X 36"

CROWN LINE TRANSITION

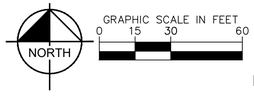

811 Know what's below. Call before you dig.

This document, together with the concepts and designs presented herein, as an instrument of service, is intended only for the specific purpose and client for which it was prepared. Reuse of and improper reliance on this document without written authorization and adaptation by Kimley-Horn and Associates, Inc. shall be without liability to Kimley-Horn and Associates, Inc.

Print Date: 5/19/26

Drawing File Name: epc-07_signing and markings.dwg

Kimley»Horn
KIMLEY-HORN AND ASSOCIATES, INC.
6200 SOUTH SYRACUSE WAY
SUITE 300
GREENWOOD VILLAGE, COLORADO 80111
(303) 228-2300

	Sheet Revisions		
	Date:	Comments:	Init.
R-X			
R-X			
R-X			
R-X			

EL PASO COUNTY
DEPARTMENT OF PUBLIC WORKS
3275 AKERS DRIVE
COLORADO SPRINGS, CO
80922

R-- FINAL
FOR REVIEW ONLY
NOT FOR CONSTRUCTION
Kimley»Horn
Kimley-Horn and Associates, Inc.

60% PLANS

No Revisions:

Revised:

Void:

EL PASO COUNTY TRAVEL CENTER
PREPARED FOR
BUC-EE'S, LTD.
SIGNING AND MARKING

Designer:	APW	Structure Numbers	
Detailer:	DJC		
Checked By:	MPF	Subset Sheet:	6 of 6

Project No./Code

KH 196094002

Sheet Number 61

LEGEND

- TRAFFIC SIGNAL POLE, FOUNDATION AND MAST ARM
- LEFT–TURN TRAFFIC SIGNAL HEAD WITH BACKPLATE
- LEFT–TURN TRAFFIC SIGNAL HEAD WITHOUT BACKPLATE
- TRAFFIC SIGNAL HEAD WITH BACKPLATE
- TRAFFIC SIGNAL HEAD WITHOUT BACKPLATE
- LUMINAIRE
- PEDESTAL POLE
- SIGNAL POLE/MAST ARM MOUNTED SIGN
- OPTICOM DETECTOR
- ITERIS VANTAGE VIDEO DETECTION SENSOR
- PULL BOX TYPE 4 – (24"X36"X24")
- PULL BOX TYPE 5 – (30"X48"X24")
- POWER METER
- CABINET WITH UNINTERRUPTED POWER SUPPLY
- CONNECTION TO POWER SOURCE
- CONDUIT
- FLOW DIRECTION ARROWS (DIAGRAMMATIC ONLY)

CONSTRUCTION NOTES


1. FURNISH AND INSTALL MAST ARM MOUNTED SIGN
2. FURNISH AND INSTALL CDOT TYPE 4 TRAFFIC SIGNAL PULL BOX
3. FURNISH AND INSTALL CDOT TYPE 5 TRAFFIC SIGNAL PULL BOX
4. FURNISH AND INSTALL VIDEO DETECTION CAMERA
5. FURNISH AND INSTALL NEW SIGNAL CONTROLLER CABINET AND UNINTERRUPTED POWER SUPPLY
6. FURNISH AND INSTALL SIGNAL POLE, MAST ARM, AND LUMINAIRE PER CDOT S–614–40A. SIGNAL POLE SHALL BE HOT DIPPED GALVANIZED INSIDE AND OUT ACCORDING TO ASTM A123.
7. FURNISH AND INSTALL PEDESTAL POLE PER CDOT S–614–44. PEDESTAL POLE TO BE HOT DIPPED GALVANIZED INSIDE AND OUT ACCORDING TO ASTM A123
8. COORDINATE ELECTRICAL CONNECTION WITH ELECTRIC SERVICE PROVIDER. INSTALL NEW METER AND OBTAIN ADDRESS FROM EL PASO COUNTY
9. FURNISH AND INSTALL ELECTRIC PEDESTAL SERVICE
10. FURNISH AND INSTALL EMERGENCY VEHICLE PREEMPTION (OPTICOM)


SIGNAL NOTES

1. SIGNAL PHASING SHOWN IS FOR REFERENCE ONLY. CONTRACTOR SHALL CONTACT EL PASO COUNTY TO COORDINATE SIGNAL TIMING. EL PASO COUNTY TO OWN AND OPERATE SIGNAL.
2. CONTRACTOR SHALL SUBMIT SHOP DRAWINGS REVIEWED BY THE ENGINEER OF RECORD TO EL PASO COUNTY STAFF FOR REVIEW PRIOR TO FABRICATION OF TRAFFIC SIGNALS. SHOP DRAWINGS SHALL NOT BE RETURNED TO THE FABRICATOR PRIOR TO REVIEW BY EL PASO COUNTY STAFF.
3. IF BEDROCK IS ENCOUNTERED DURING CAISSON EXCAVATION, CONTRACTOR SHALL CONTACT ENGINEER OF RECORD.
4. ALL SIGNAL HEADS SHOULD HAVE PELCO AIROFLEX BACKPLATES UNLESS OTHERWISE NOTED.
5. ALL PROPOSED CONDUIT IS TRENCHED UNLESS OTHERWISE NOTED.

PROPOSED PHASE DIAGRAM

- PROTECTED PHASE MOVEMENT
- PERMISSIVE PHASE MOVEMENT

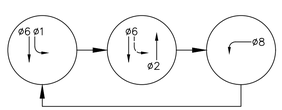

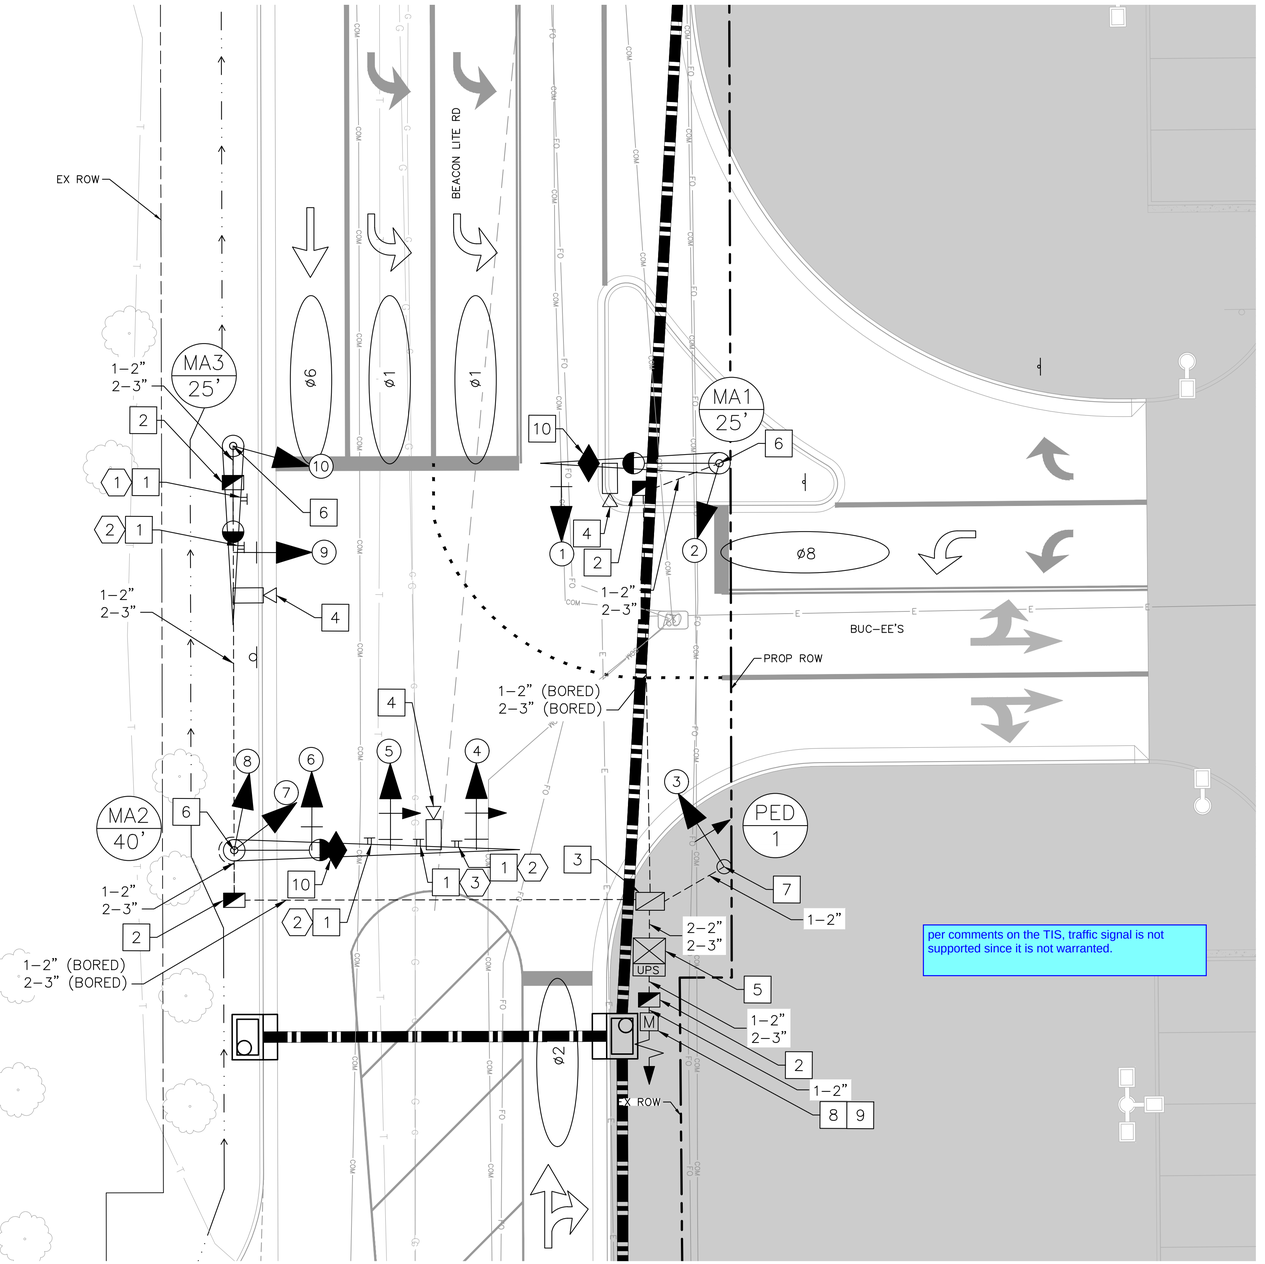

PROPOSED SIGN LEGEND


1 — VARIES — BEACON LITE RD

2 — ONLY — R3–5L (30"X36")

LEFT TURN YIELD ON FLASHING YELLOW ARROW

3 — R10–27A (30"X36")

PROPOSED SIGNAL FACES

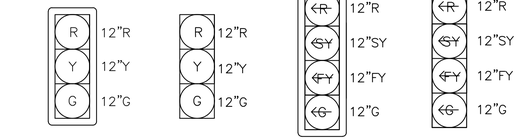

3–SECTION VERTICAL HEAD WITH RETRO–REFLECTIVE BACKPLATE — ①⑥⑨

3–SECTION VERTICAL HEAD WITHOUT BACKPLATE — ②⑦⑧⑩

4–SECTION VERTICAL HEAD WITH RETRO–REFLECTIVE BACKPLATE — ④⑤

4–SECTION VERTICAL HEAD WITHOUT BACKPLATE — ③

SIGNAL POLE SCHEDULE – BEACON LITE ROAD ACCESS				
POLE NUMBER	MA–1	MA–2	MA–3	PED–1
MAST ARM LENGTH	25'	40'	25'	N/A
FND. DIAMETER	36"	36"	36"	24"
FND. DEPTH	19'	19'	19'	5'
NORTHING/EASTING	N: 472142.49 E: 180573.25	N: 472088.39 E: 180505.43	N: 472144.91 E: 180505.29	N: 472086.08 E: 180573.90
DESIGN STANDARD	CDOT S–614–40A	CDOT S–614–40A	CDOT S–614–40A	CDOT S–614–44
APPROXIMATE TOP OF CAISSON ELEVATION	MATCH PROPOSED	MATCH PROPOSED	MATCH PROPOSED	MATCH PROPOSED

NORTH

GRAPHIC SCALE IN FEET 0 5 10 20

Know what's below. Call before you dig.

This document, together with the concepts and designs presented herein, as an instrument of service, is intended only for the specific purpose and client for which it was prepared. Reuse of and improper reliance on this document without written authorization and adaptation by Kimley-Horn and Associates, Inc. shall be without liability to Kimley-Horn and Associates, Inc.

Print Date: 5/19/26
Drawing File Name: epc-7.5_signal plans.dwg
Horiz. Scale: 1" = 10' Vert. Scale: N/A

Kimley»Horn
KIMLEY–HORN AND ASSOCIATES, INC.
6200 SOUTH SYRACUSE WAY
SUITE 300
GREENWOOD VILLAGE, COLORADO 80111
(303) 228–2300

Sheet Revisions		
Date:	Comments:	Init.
R–X		
R–X		
R–X		
R–X		

EL PASO COUNTY
DEPARTMENT OF PUBLIC WORKS
3275 AKERS DRIVE
COLORADO SPRINGS, CO
80922

FOR REVIEW ONLY
NOT FOR CONSTRUCTION
Kimley»Horn
Kimley-Horn and Associates, Inc.

60% PLANS
No Revisions:
Revised:
Void:


EL PASO COUNTY TRAVEL CENTER
PREPARED FOR
BUC–EE'S, LTD.
SIGNAL PLAN: BEACON LITE ROAD ACCESS

Designer: MG
Detailer: TJD
Checked By: MEC
Structure Numbers:
Subset Sheet: 1 of 1

Project No./Code
KH 196094002
Sheet Number 62


V1_Roadway Plan Sheets.pdf Markup Summary

Callout (28)

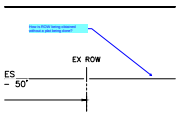


Subject: Callout
Page Label: [5] 5 BEACON LITE RD (2)
Status:
Color:
Layer:
Space:

How is ROW being obtained without a plat being done?

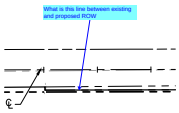

Subject: Callout
Page Label: [8] 8 HORIZONTAL CONTROL (BEACON LITE RD)
Status:
Color:
Layer:
Space:


What is this line between existing and proposed ROW

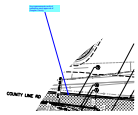

Subject: Callout
Page Label: [21] 21 EPC-06_PLAN AND PROFILE - 4
Status:
Color:
Layer:
Space:

Any improvements north of centerline need approval of Douglas County

---

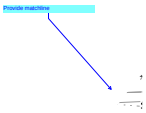

Subject: Callout
Page Label: [21] 21 EPC-06_PLAN AND PROFILE - 4
Status:
Color:
Layer:
Space:


Provide matchline



Subject: Callout
Page Label: [22] 22 EPC-06_PLAN AND PROFILE - 5
Status:
Color:
Layer:
Space:

Any improvements north of centerline need approval of Douglas County


---

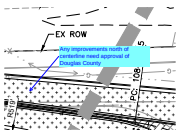

Subject: Callout
Page Label: [23] 23 EPC-06_PLAN AND PROFILE - 8
Status:
Color:
Layer:
Space:

Any improvements north of centerline need approval of Douglas County

---

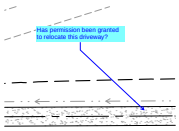

Subject: Callout
Page Label: [23] 23 EPC-06_PLAN AND PROFILE - 8
Status:
Color:
Layer:
Space:


Has permission been granted to relocate this driveway?



Subject: Callout
Page Label: [23] 23 EPC-06_PLAN AND PROFILE - 8
Status:
Color:
Layer:
Space:


Need to show limits of driveway and connection to existing road

---

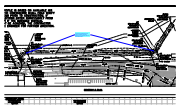

Subject: Callout
Page Label: [37] 37 DRIVEWAY 9
Status:
Color:
Layer:
Space:


Has it been confirmed that the types of vehicles using this driveway can maneuver with a 25' horizontal radius?

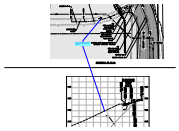

Subject: Callout
Page Label: [38] 38 DRIVEWAY 10
Status:
Color:
Layer:
Space:


Add note reference which plan set the continuation of the access is located in

---

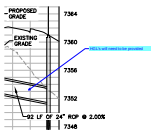


Subject: Callout
Page Label: [2] 43 BYPASS STORM P&P ABC
Status:
Color:
Layer:
Space:

HGL's will need to be provided

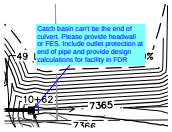


Subject: Callout
Page Label: [3] 44 BYPASS STORM P&P DEF
Status:
Color:
Layer:
Space:

Catch basin can't be the end of culvert. Please provide headwall or FES. Include outlet protection at end of pipe and provide design calculations for facility in FDR

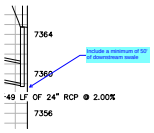


Subject: Callout
Page Label: [3] 44 BYPASS STORM P&P DEF
Status:
Color:
Layer:
Space:

Include a minimum of 50' of downstream swale

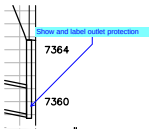


Subject: Callout
Page Label: [3] 44 BYPASS STORM P&P DEF
Status:
Color:
Layer:
Space:

Show and label outlet protection

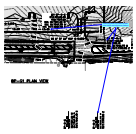

Subject: Callout
Page Label: [4] 45 BYPASS STORM P&P G1
Status:
Color:
Layer:
Space:


Stationing does not match up with other labels and alignment stations

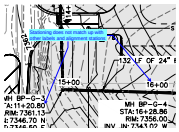

Subject: Callout
Page Label: [5] 46 BYPASS STORM P&P G2
Status:
Color:
Layer:
Space:

Stationing does not match up with other labels and alignment stations


---

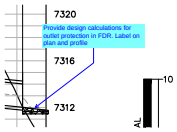

Subject: Callout
Page Label: [6] 47 BYPASS STORM P&P G3
Status:
Color:
Layer:
Space:


Provide design calculations for outlet protection in FDR. Label on plan and profile

---

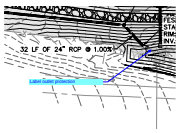


Subject: Callout
Page Label: [6] 47 BYPASS STORM P&P G3
Status:
Color:
Layer:
Space:

Label outlet protection

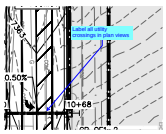


Subject: Callout
Page Label: [9] 50 OFFSITE STORM P&P
Status:
Color:
Layer:
Space:

Label all utility crossings in plan views

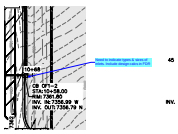


Subject: Callout
Page Label: [9] 50 OFFSITE STORM P&P
Status:
Color:
Layer:
Space:

Need to indicate types & sizes of inlets. Include design calcs in FDR

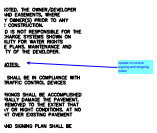


Subject: Callout
Page Label: [2] 2 GENERAL NOTES
Status:
Color:
Layer:
Space:

update to current signing and stripping notes

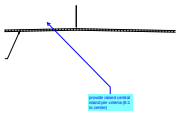

Subject: Callout
Page Label: [7] 7 ROUNDABOUTS
Status:
Color:
Layer:
Space:

provide raised central island per criteria (6:1 to center)

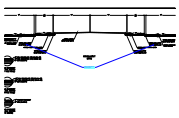

Subject: Callout
Page Label: [7] 7 ROUNDABOUTS
Status:
Color:
Layer:
Space:

revise to ramp curb at the truck apron




Subject: Callout
Page Label: [10] 10 HORIZONTAL CONTROL (ROUNDABOUT)
Status:
Color:
Layer:
Space:

extend concrete pan as far as possible (all splitter islands facing the roundabout)




Subject: Callout
Page Label: [10] 10 HORIZONTAL CONTROL (ROUNDABOUT)
Status:
Color:
Layer:
Space:

Per ECM 2.5.6 the min. raised median width shall be 4 feet. Revise accordingly.

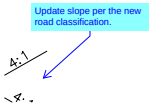

Subject: Callout
Page Label: [4] 4 BEACON LITE RD (1)
Status:
Color:
Layer:
Space:


Update slope per the new road classification.

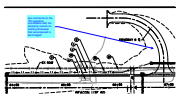

Subject: Callout
Page Label: [13] 13 EPC-05_REMOVALS - 3
Status:
Color:
Layer:
Space:

see comments on the TIS regarding coordination with the propoerty owners on existing driveways that are proposed to be changed


---

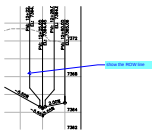

Subject: Callout
Page Label: [35] 35 DRIVEWAY 7
Status:
Color:
Layer:
Space:


show the ROW line

Cloud+ (6)

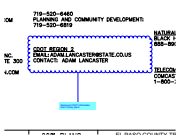


Subject: Cloud+
Page Label: [1] 1 COVER SHEET
Status:
Color:
Layer:
Space:

Removed CDOT information from County plans

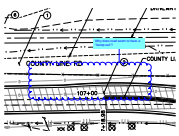


Subject: Cloud+
Page Label: [16] 16 EPC-05_REMOVALS - 8
Status:
Color:
Layer:
Space:

Why does road seem to have a "bump out"?

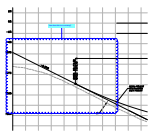

Subject: Cloud+
Page Label: [18] 18 EPC-06_PLAN AND PROFILE - 1
Status:
Color:
Layer:
Space:


How does this tie to existing?

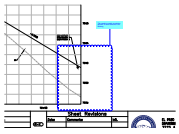

Subject: Cloud+
Page Label: [22] 22 EPC-06_PLAN AND PROFILE - 5
Status:
Color:
Layer:
Space:

This needs to match to existing ground, or show some tie-in to existing


---

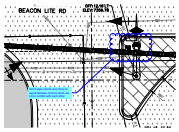

Subject: Cloud+
Page Label: [39] 39 MEDIAN 1
Status:
Color:
Layer:
Space:

Storm pipe seems very close to signal facilities. Ensure items are not in conflict with each other


---

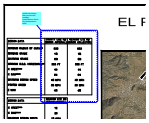


Subject: Cloud+
Page Label: [1] 1 COVER SHEET
Status:
Color:
Layer:
Space:

update the design data per the new roadway classifications due to the developments traffic


Highlight (6)

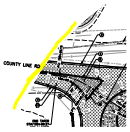


Subject: Highlight
Page Label: [21] 21 EPC-06_PLAN AND PROFILE - 4
Status:
Color:
Layer:
Space:

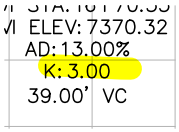


Subject: Highlight
Page Label: [37] 37 DRIVEWAY 9
Status:
Color:
Layer:
Space:

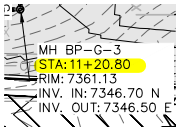


Subject: Highlight
Page Label: [4] 45 BYPASS STORM P&P G1
Status:
Color:
Layer:
Space:

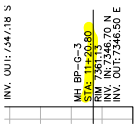

Subject: Highlight
Page Label: [4] 45 BYPASS STORM P&P G1
Status:
Color:
Layer:
Space:

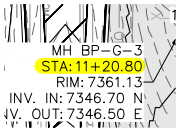


Subject: Highlight
Page Label: [5] 46 BYPASS STORM P&P G2
Status:
Color:
Layer:
Space:

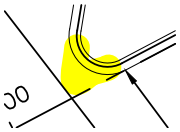

Subject: Highlight
Page Label: [10] 10 HORIZONTAL CONTROL (ROUNDABOUT)
Status:
Color:
Layer:
Space:


Length Measurement (1)

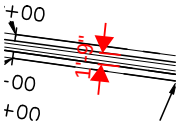


Subject: Length Measurement
Page Label: [10] 10 HORIZONTAL CONTROL (ROUNDABOUT)
Status:
Color:
Layer:
Space:

1'-9"

Line (2)

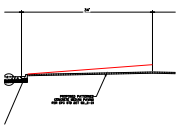

Subject: Line
Page Label: [7] 7 ROUNDABOUTS
Status:
Color:
Layer:
Space:

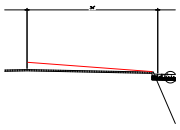

Subject: Line
Page Label: [7] 7 ROUNDABOUTS
Status:
Color:
Layer:
Space:

Text Box (24)




Subject: Text Box
Page Label: [1] 1 COVER SHEET
Status:
Color:
Layer:
Space:

Provide following signature blocks:

- Engineer's


- Owners/Developers

- EPC Administrator

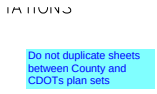


Subject: Text Box
Page Label: [1] 1 COVER SHEET
Status:
Color:
Layer:
Space:

Do not duplicate sheets between County and CDOTs plan sets

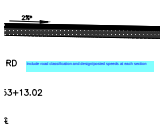

Subject: Text Box
Page Label: [4] 4 BEACON LITE RD (1)
Status:
Color:
Layer:
Space:

Include road classification and design/posted speeds at each section

 


Subject: Text Box
Page Label: [8] 8 HORIZONTAL CONTROL (BEACON LITE RD)
Status:
Color:
Layer:
Space:

Provide northing & eastings for beginning and end of project



Subject: Text Box
Page Label: [8] 8 HORIZONTAL CONTROL (BEACON LITE RD)
Status:
Color:
Layer:
Space:


Include adjacent property owner information

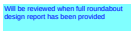

Subject: Text Box
Page Label: [10] 10 HORIZONTAL CONTROL (ROUNDABOUT)
Status:
Color:
Layer:
Space:

Will be reviewed when full roundabout design report has been provided


---

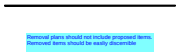

Subject: Text Box
Page Label: [12] 12 EPC-05_REMOVALS - 1-2
Status:
Color:
Layer:
Space:

Removal plans should not include proposed items. Removed items should be easliy discernible


---

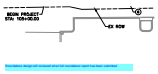

Subject: Text Box
Page Label: [16] 16 EPC-05_REMOVALS - 8
Status:
Color:
Layer:
Space:

Roundabout design will reviewed when full roundabout report has been submitted


---

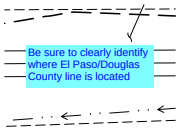

Subject: Text Box
Page Label: [16] 16 EPC-05_REMOVALS - 8
Status:
Color:
Layer:
Space:


Be sure to clearly identify where El Paso/Douglas County line is located

---

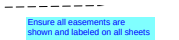


Subject: Text Box
Page Label: [16] 16 EPC-05_REMOVALS - 8
Status:
Color:
Layer:
Space:

Ensure all easements are shown and labeled on all sheets

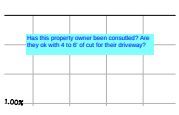


Subject: Text Box
Page Label: [34] 34 DRIVEWAY 5 & 6
Status:
Color:
Layer:
Space:

Has this property owner been consutled? Are they ok with 4 to 6' of cut for their driveway?

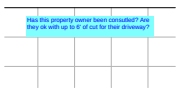


Subject: Text Box
Page Label: [35] 35 DRIVEWAY 7
Status:
Color:
Layer:
Space:

Has this property owner been consulted? Are they ok with up to 6' of cut for their driveway?

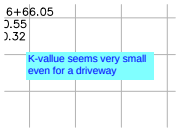


Subject: Text Box
Page Label: [37] 37 DRIVEWAY 9
Status:
Color:
Layer:
Space:

K-vallue seems very small even for a driveway

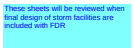

Subject: Text Box
Page Label: [2] 43 BYPASS STORM P&P ABC
Status:
Color:
Layer:
Space:


These sheets will be reviewed when final design of storm facilities are included with FDR

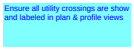

Subject: Text Box
Page Label: [2] 43 BYPASS STORM P&P ABC
Status:
Color:
Layer:
Space:


Ensure all utility crossings are show and labeled in plan & profile views

---

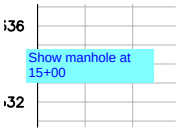

Subject: Text Box
Page Label: [5] 46 BYPASS STORM P&P G2
Status:
Color:
Layer:
Space:

Show manhole at 15+00

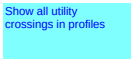


Subject: Text Box
Page Label: [9] 50 OFFSITE STORM P&P
Status:
Color:
Layer:
Space:

Show all utility crossings in profiles

Subject: Text Box
Page Label: [4] 59 EPC-07_SIGNING AND MARKING - 4
Status:
Color:
Layer:
Space:


Will need a lighting plan for the roundabout

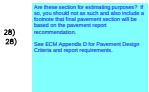

Subject: Text Box
Page Label: [7] 7 ROUNDABOUTS
Status:
Color:
Layer:
Space:

Are these section for estimating purposes? If so, you should not as such and also include a footnote that final pavement section will be based on the pavement report recommendation.

See ECM Appendix D for Pavement Design Criteria and report requirements.

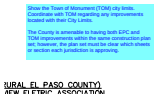

Subject: Text Box
Page Label: [1] 1 COVER SHEET
Status:
Color:
Layer:
Space:


Show the Town of Monument (TOM) city limits. Coordinate with TOM regarding any improvements located with their City Limits.

The County is amenable to having both EPC and TOM improvements within the same construction plan set; however, the plan set must be clear which sheets or section each jurisdiction is approving.



Subject: Text Box
Page Label: [1] 1 COVER SHEET
Status:
Color:
Layer:
Space:

All necessary offsite easement must be acquired by the owner/developer before plans are approved. It is the owner/developer's responsibility to obtain all necessary offsite easements.

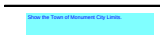


Subject: Text Box
Page Label: [12] 12 EPC-05_REMOVALS - 1-2
Status:
Color:
Layer:
Space:

Show the Town of Monument City Limits.



Subject: Text Box
Page Label: [1] Beacon Light Access
Status:
Color:
Layer:
Space:

per comments on the TIS, traffic signal is not supported since it is not warranted.

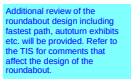

Subject: Text Box
Page Label: [10] 10 HORIZONTAL CONTROL (ROUNDABOUT)
Status:
Color:
Layer:
Space:

Additional review of the roundabout design including fastest path, autoturn exhibits etc. will be provided. Refer to the TIS for comments that affect the design of the roundabout.