





MARK	DATE	REVISIONS

NO. OF SHEETS: 01/15/2020
 DATE: 01/15/2020
 DRAWN: JBC
 CHECKED: JBC
 PROJECT: E100

GENERAL PHOTOMETRY NOTES

- A. THESE PHOTOMETRIC CALCULATIONS ARE BASED ON THE FOLLOWING ASSUMPTIONS AND CORRECTION FACTOR:

Measurement at Property Boundaries
 Light levels measured at the property line of the development site adjacent to residential property shall be not less than 0.1 foot candles as a direct result of the on-site lighting. All light fixtures mounted within 15' of the property line shall be classified as IES Type I or Type III, or shall be demonstrated to provide similar distribution patterns. All light fixtures shall be fitted with "shielding" reflectors on the sides facing the residential property line.

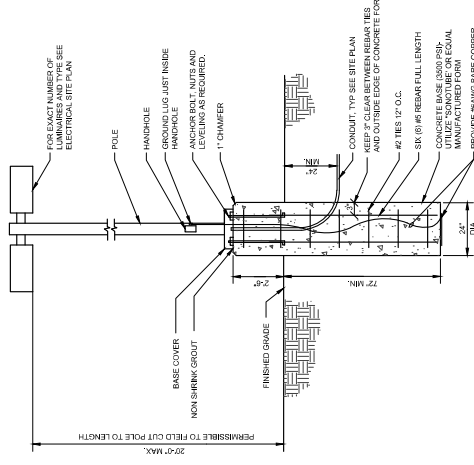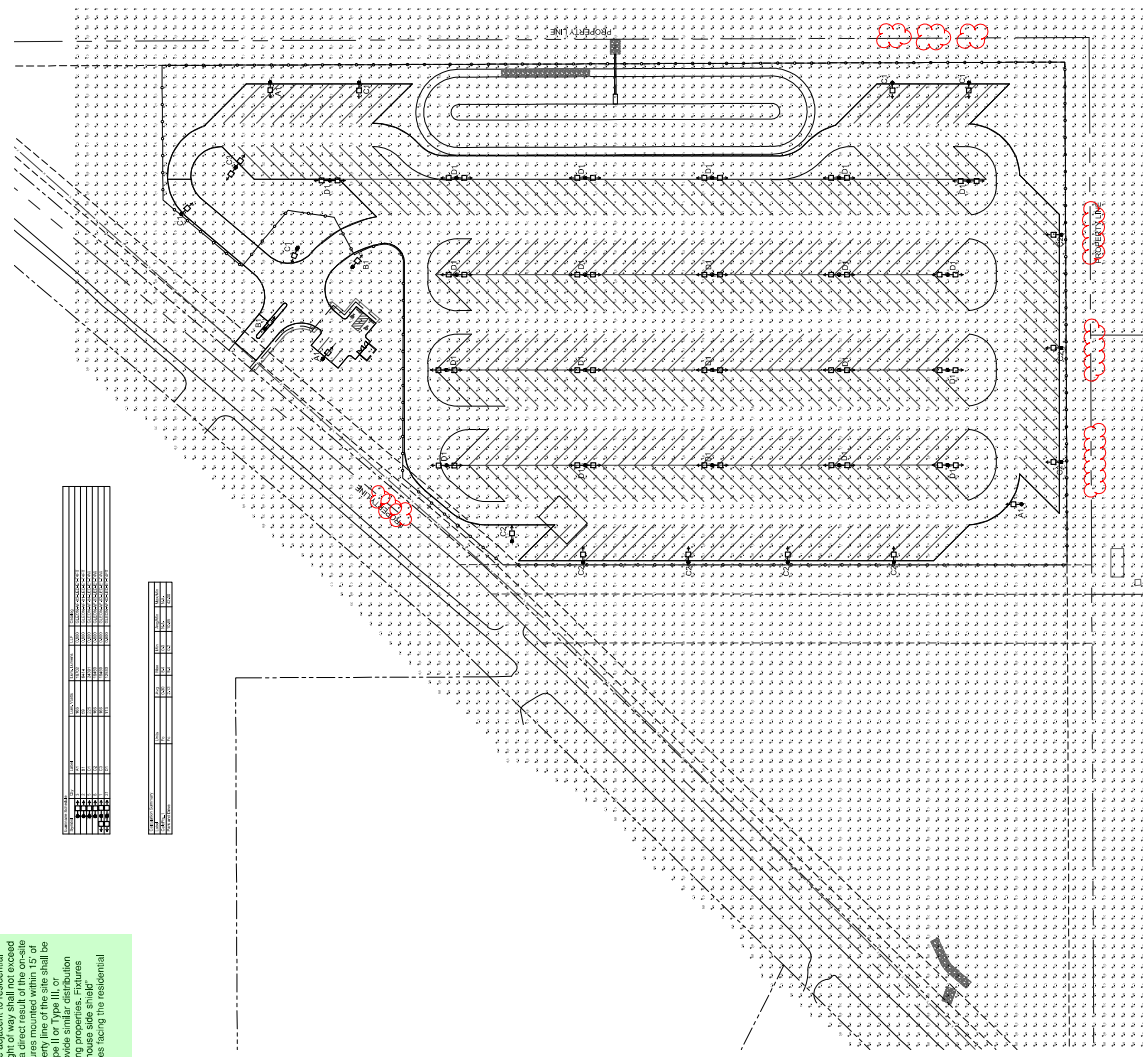

1 TYPICAL POLE BASE DETAIL
 NOT TO SCALE





REVISION	DATE	COMMENT
























