CIRCLE K FALCON
DETENTION POND AS-BUILT

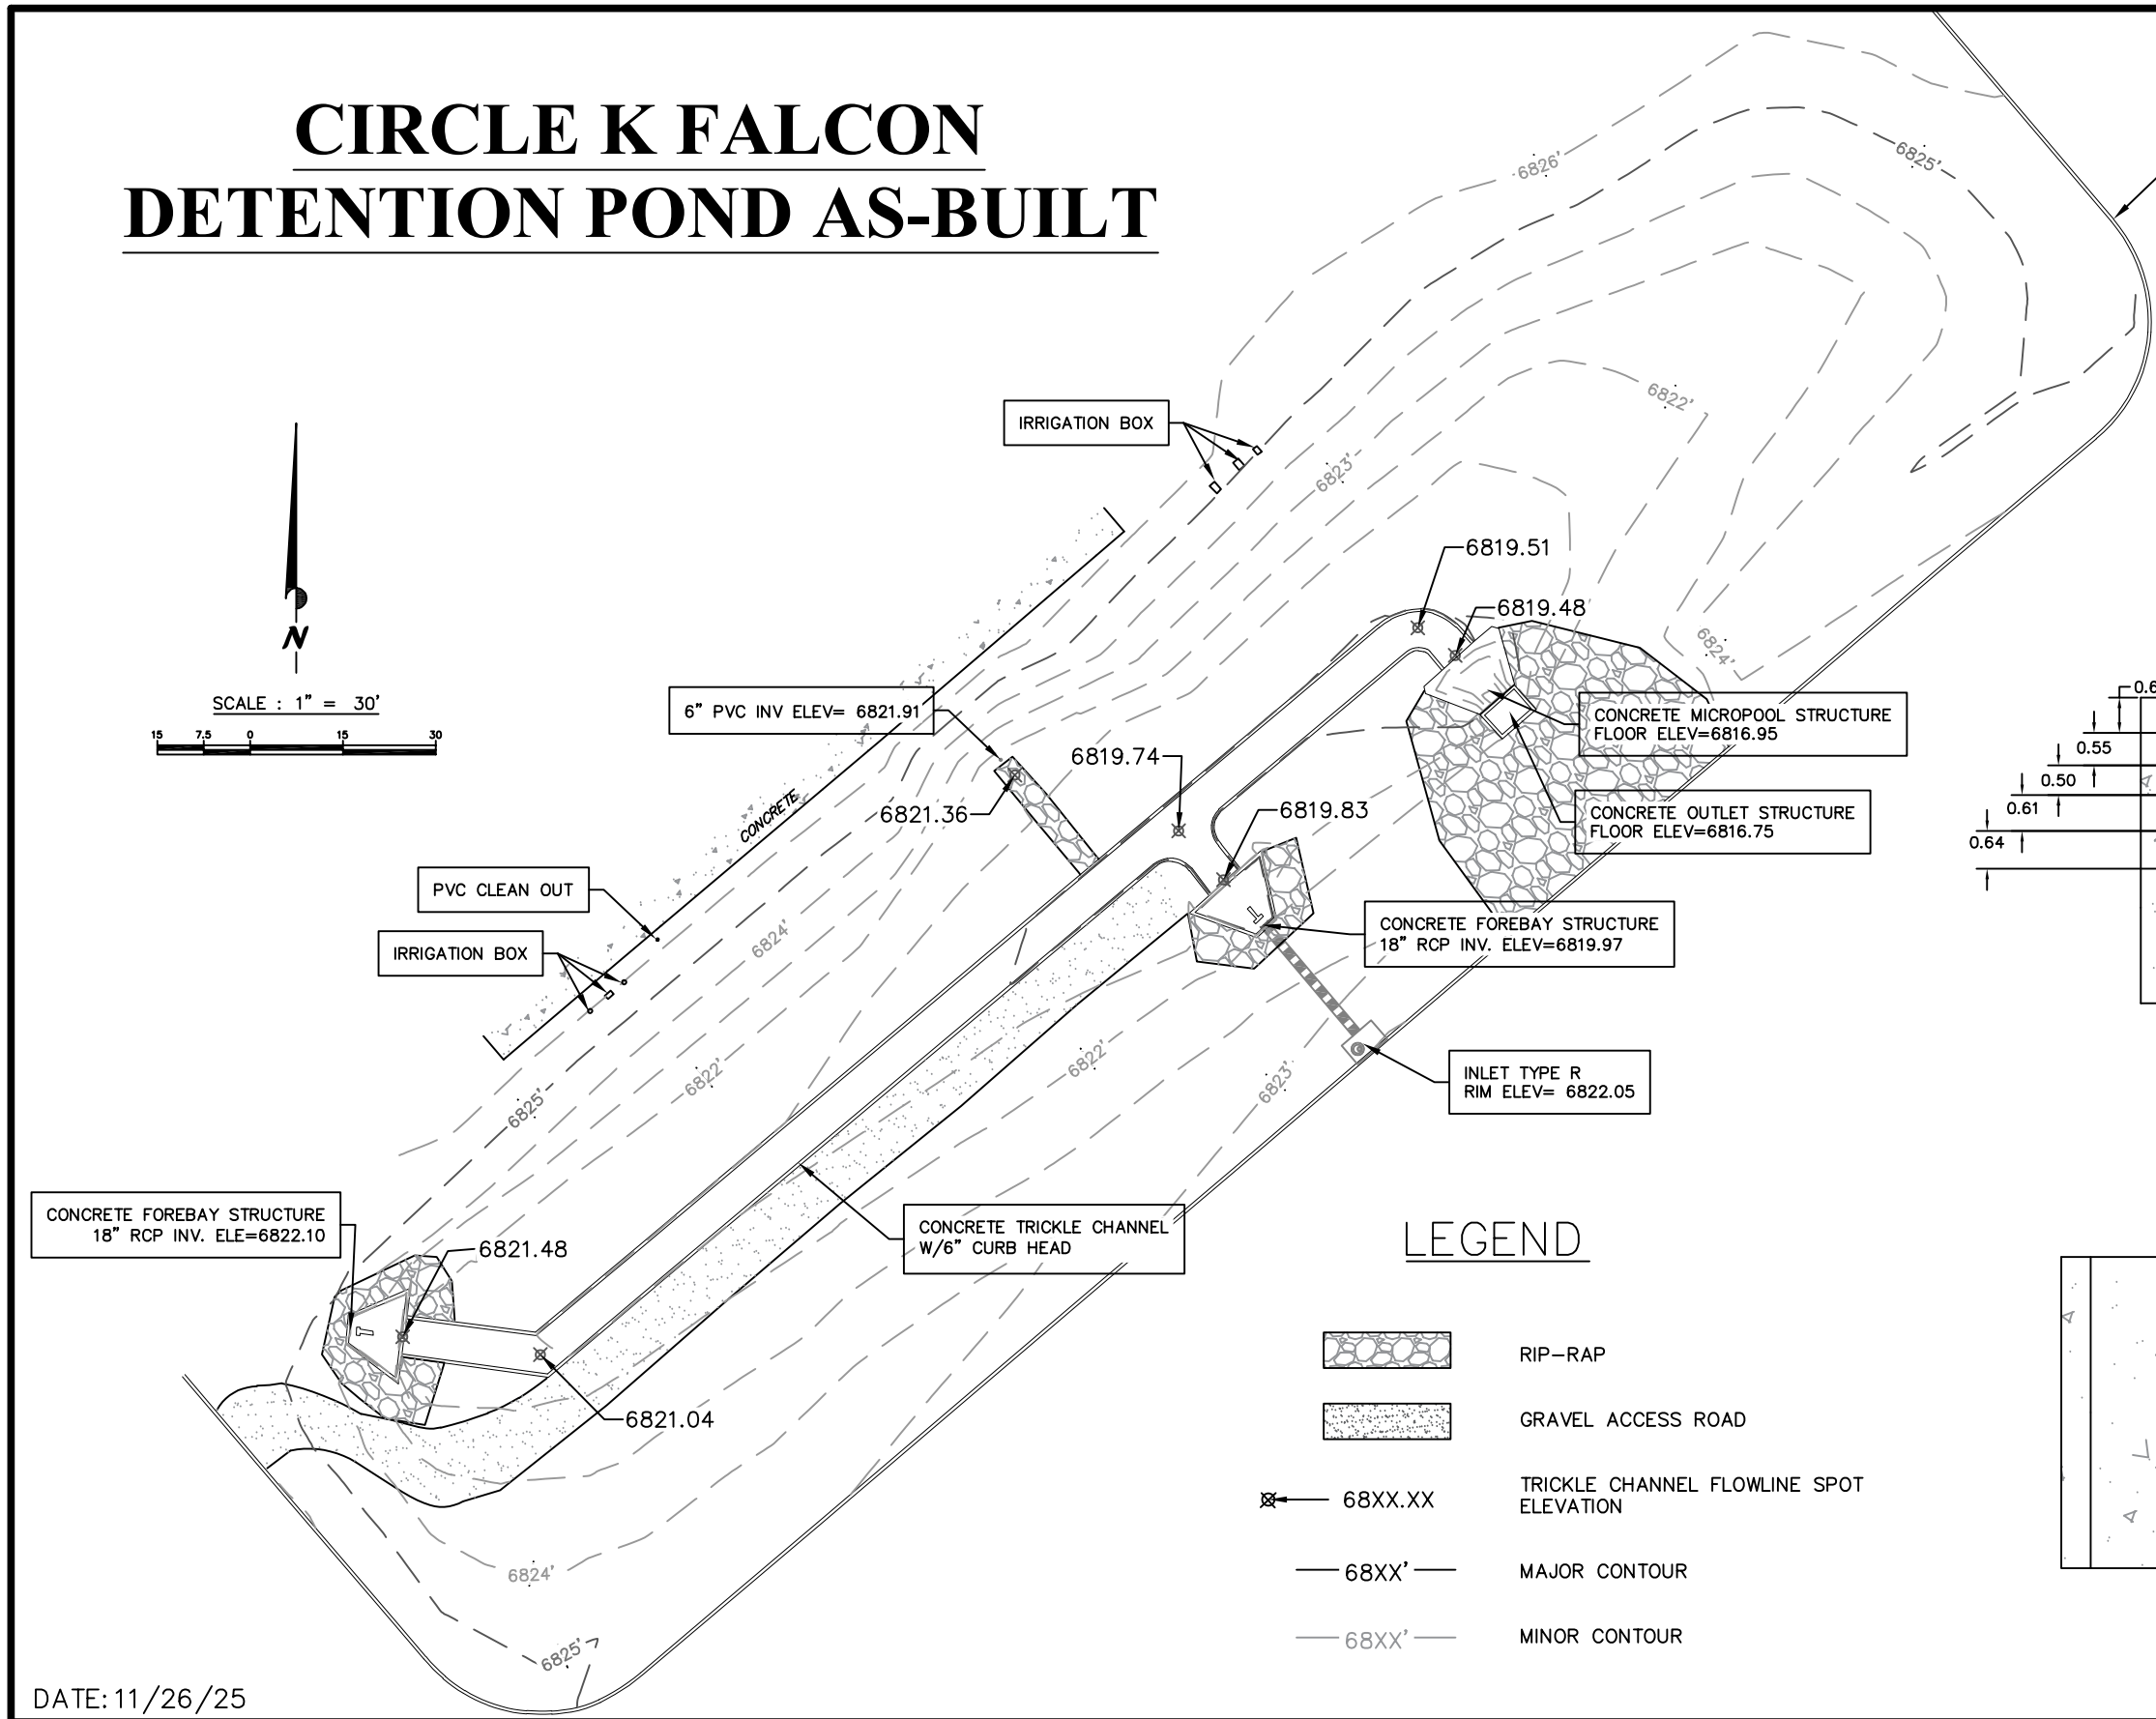

ORIFICE PLATE DETAIL

N.T.S.

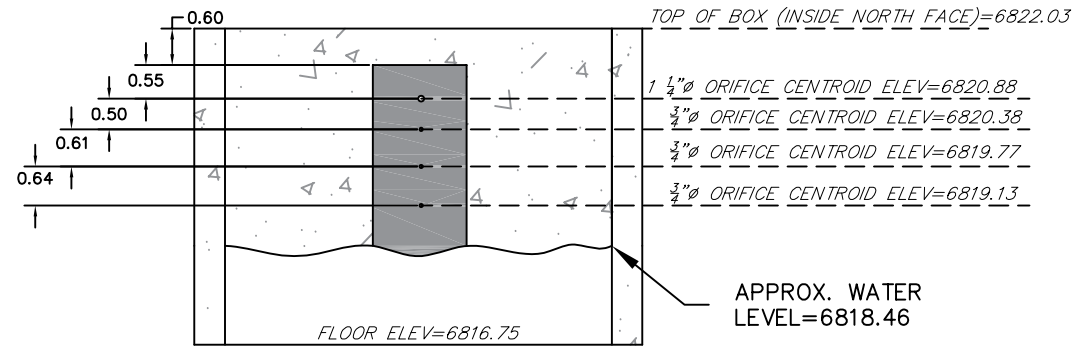

RESTRICTOR PLATE DETAIL

N.T.S.

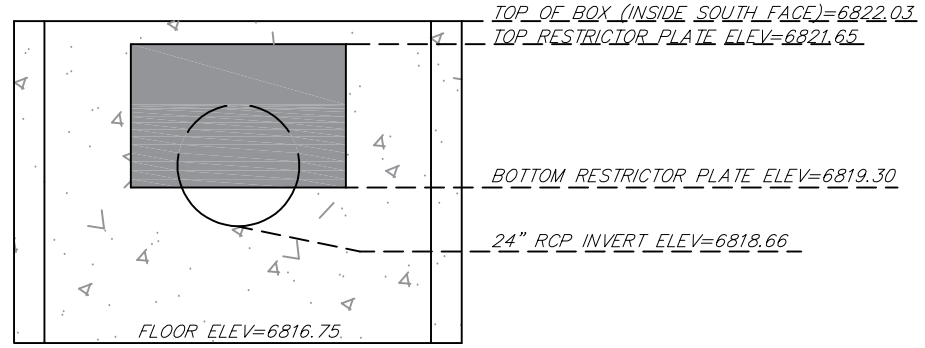

LEGEND

	RIP-RAP
	GRAVEL ACCESS ROAD
68XX.XX	TRICKLE CHANNEL FLOWLINE SPOT ELEVATION
68XX'	MAJOR CONTOUR
68XX'	MINOR CONTOUR

DATE: 11/26/25

CIRCLE K FALCON
HIGHWAY 24 & MERIDIAN ROAD – FALCON, COLORADO

POLARIS SURVEYING, INC.
1903 Lelaray Street, Suite 102
COLORADO SPRINGS, CO 80909
(719)448-0844 FAX (719)448-9225

N
SCALE 1" = 30'

COPESTONE