AG2032
PLAT 12902
PUD

5. BUILDING SETBACKS
   FRONT YARD – 25' (LOTS 1 AND 15 200' FRONT SETBACK)
   SIDE YARD – 25'
   REAR YARD – 25'
   STABLES AND CORRALS – 50' FROM ALL PROPERTY LINES

DISAPPROVED
Plan Review
08/14/2020 10:55:07 AM
dsdrangel
EPC Planning & Community Development Department

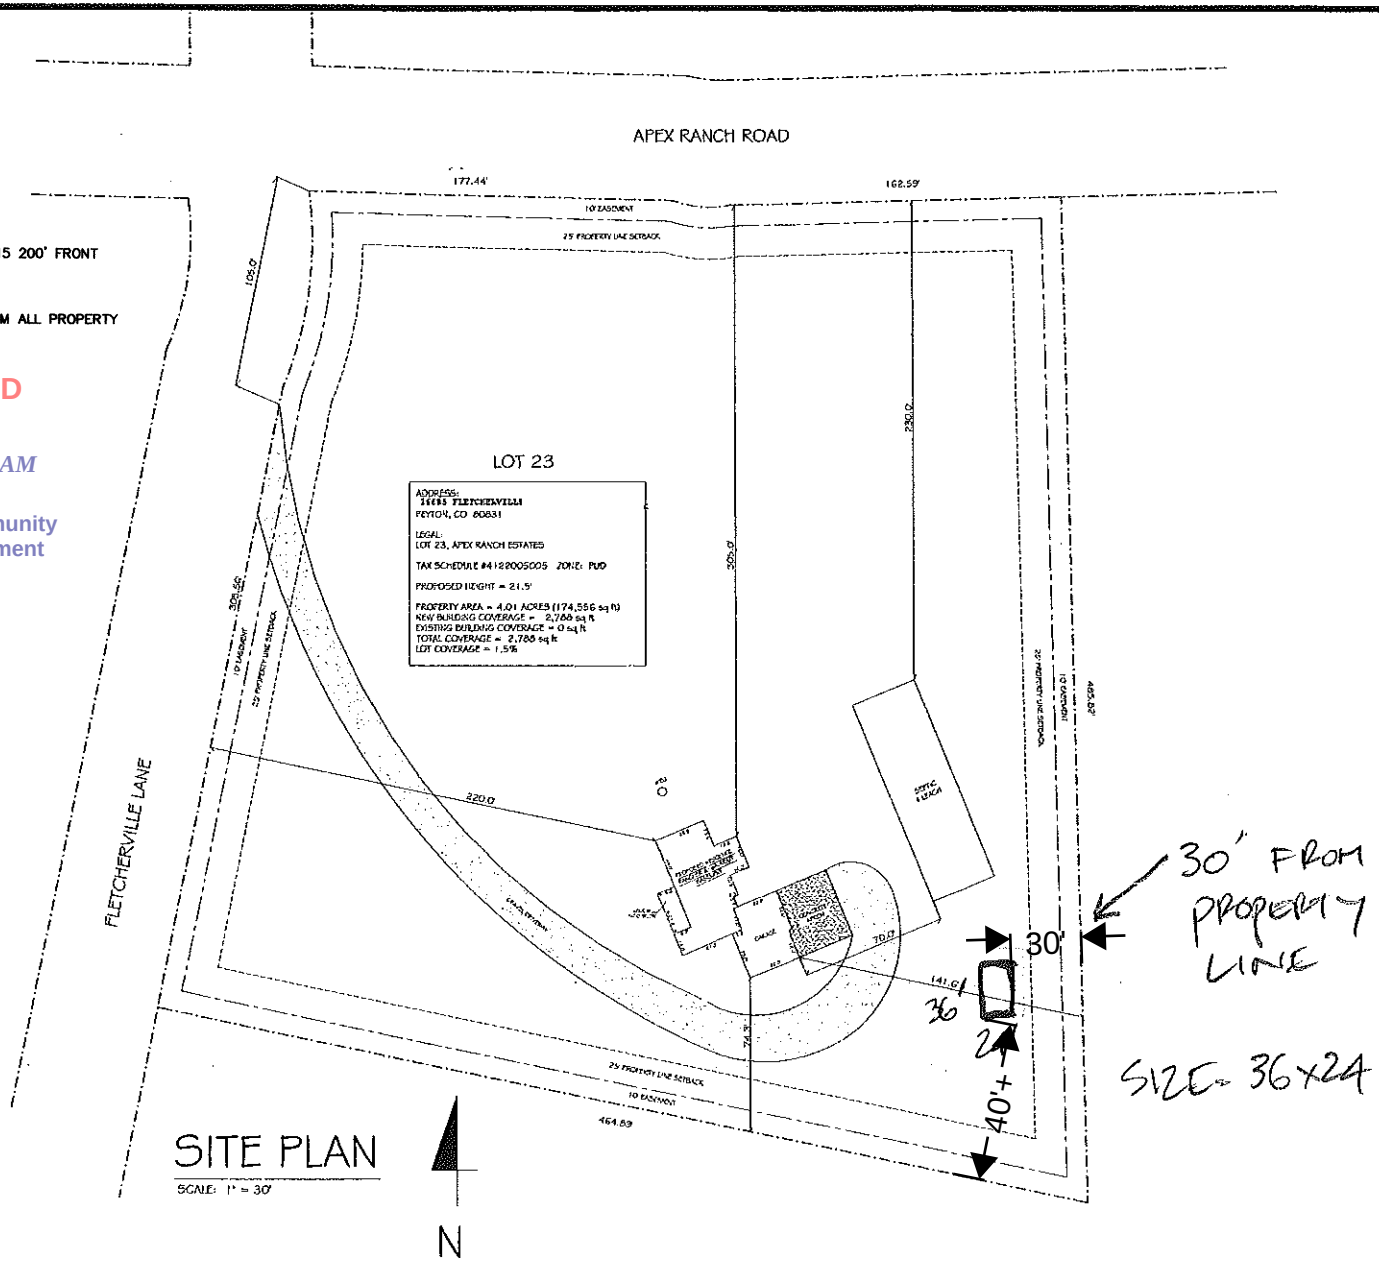

General Notes

BUILDER:
TIM TOUSSAINT
ELEVATION HOMES
FALCON, CO 80831
PHONE: (719)510-6253

No.	Revision/Issue	Date

DANA HENDERSON, LLC
RESIDENTIAL DESIGN & DRAFTING
1505 BIG VALLEY DRIVE
COLORADO SPRINGS, CO 80919
PHONE: (719)536-9952

SPECIFICATION HOME LOCATED AT
APEX RANCH ESTATES
16685 FLETCHERVILLE LN
PEYTON, CO 80831

Project
Date 8/6/12
Size 1" = 30'
SP - 1