


Please highlight the subject property.



ADJACENT PROPERTIES		
REFERENCE NUMBER	PARCEL NUMBER	PARCEL OWNER
1	7111301009	REDNER FAMILY TRUST
2	7111301010	TRI-LAKES CHAPEL INC
3	7111406056	WOODMOOR LAKEHOUSE ASSN INC
4	7111406055	WOODMOOR LAKEHOUSE ASSN INC
5	7111305005	WOODMOOR WATER & SANITATION
6	7111305034	VILLAGE AT MOOR-WOOD OWNERS ASSN
7	7114204018	TAHSK LLC
8	7114205032	DUNES AT WOODMOOR HOMEOWNERS ASSN
9	7114207014	DUNES AT WOODMOOR HOMEOWNERS ASSN
10	7114208019	DUNES AT WOODMOOR HOMEOWNERS ASSN
11	7114205011	FORRISTAL JEFFREY
12	7114205012	ILARRAZA ERIC
13	7114205013	MATTEA MELISSA
14	7114205014	FRIEND EVA K
15	7114205015	MCGOUGH ALBERT C
16	7114205016	TRASK CRAIG
17	7114205017	HARRIS NATHAN P
18	7114205018	FLORIA JOHN JR
19	7114205019	KRAEMER MAX W
20	7114205020	ULRICH DAN L
21	7114205021	HAMILTON-SMITH DAVID
22	7114205030	DUNES AT WOODMOOR HOMEOWNERS ASSN
23	7114200041	WOODMOOR WATER & SANITATION
24	7114112001	CS LAND COMPANY LLC
25	7114112002	CS LAND COMPANY LLC
26	7114109007	JONES JENNIFER KRISTEN
27	7114109008	SARGENT GREGORY LEE
28	7114100015	WOODMOOR WATER & SANITATION
29	7114109034	LAKE WOODMOOR DEVELOPMENT INC
30	7114107019	CAMPBELL HOMES LLC
31	7114107020	CAMPBELL HOMES LLC
32	7114107021	KANGAS GARY E JR
33	7114107022	MAGILL ROBERT T
34	7114107034	LAKE WOODMOOR DEVELOPMENT INC

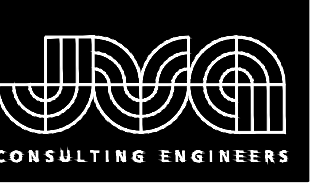


JVA, Inc. 1512 Larimer Street, Suite 710  
 Denver, CO 80202 303.444.1951  
 www.jvajva.com  
 Boulder • Fort Collins • Winter Park  
 Glenwood Springs • Denver

NO. DATE DESIGNED BY  
 REVISION DESCRIPTION

DESIGNED BY: RAH/MHT  
 DRAWN BY: MHT  
 CHECKED BY: JJM  
 JOB #: 1051.6e  
 DATE: MARCH 2021  
 © JVA, INC.

WOODMOOR WSD NO.1  
 LAKE PUMP STATION NO. 2 AND PIPELINE  
 EL PASO COUNTY, COLORADO  
 VICINITY MAP

SHEET NO.  
 FIG-1

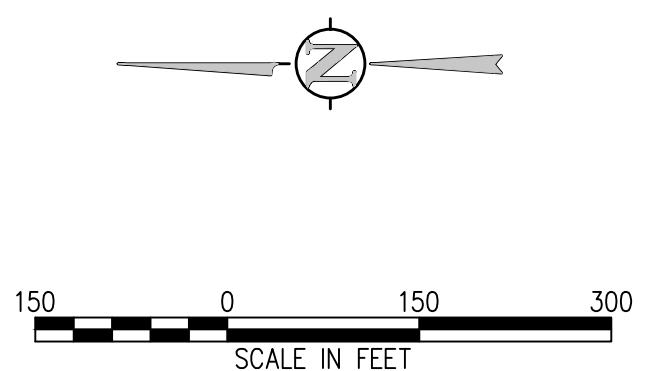

N:\1051.6e\Drawings\1051.6e - Site Development Plan - Key Map.dwg, 3/17/2021 - 8:48 AM, mht



# Vicinity Map\_V1.pdf Markup Summary

---

Sophie Kiepe (1)

---



**Subject:** Easements  
**Page Label:** [1] 24x36  
**Author:** Sophie Kiepe  
**Date:** 5/5/2021 12:43:58 PM  
**Status:**  
**Color:** ■  
**Layer:**  
**Space:**

Please highlight the subject property.