


C. Vicinity Map

For

Williams Creek Generating Station

Colorado Springs Utilities Williams Creek Generating Station

Vicinity/Location Map

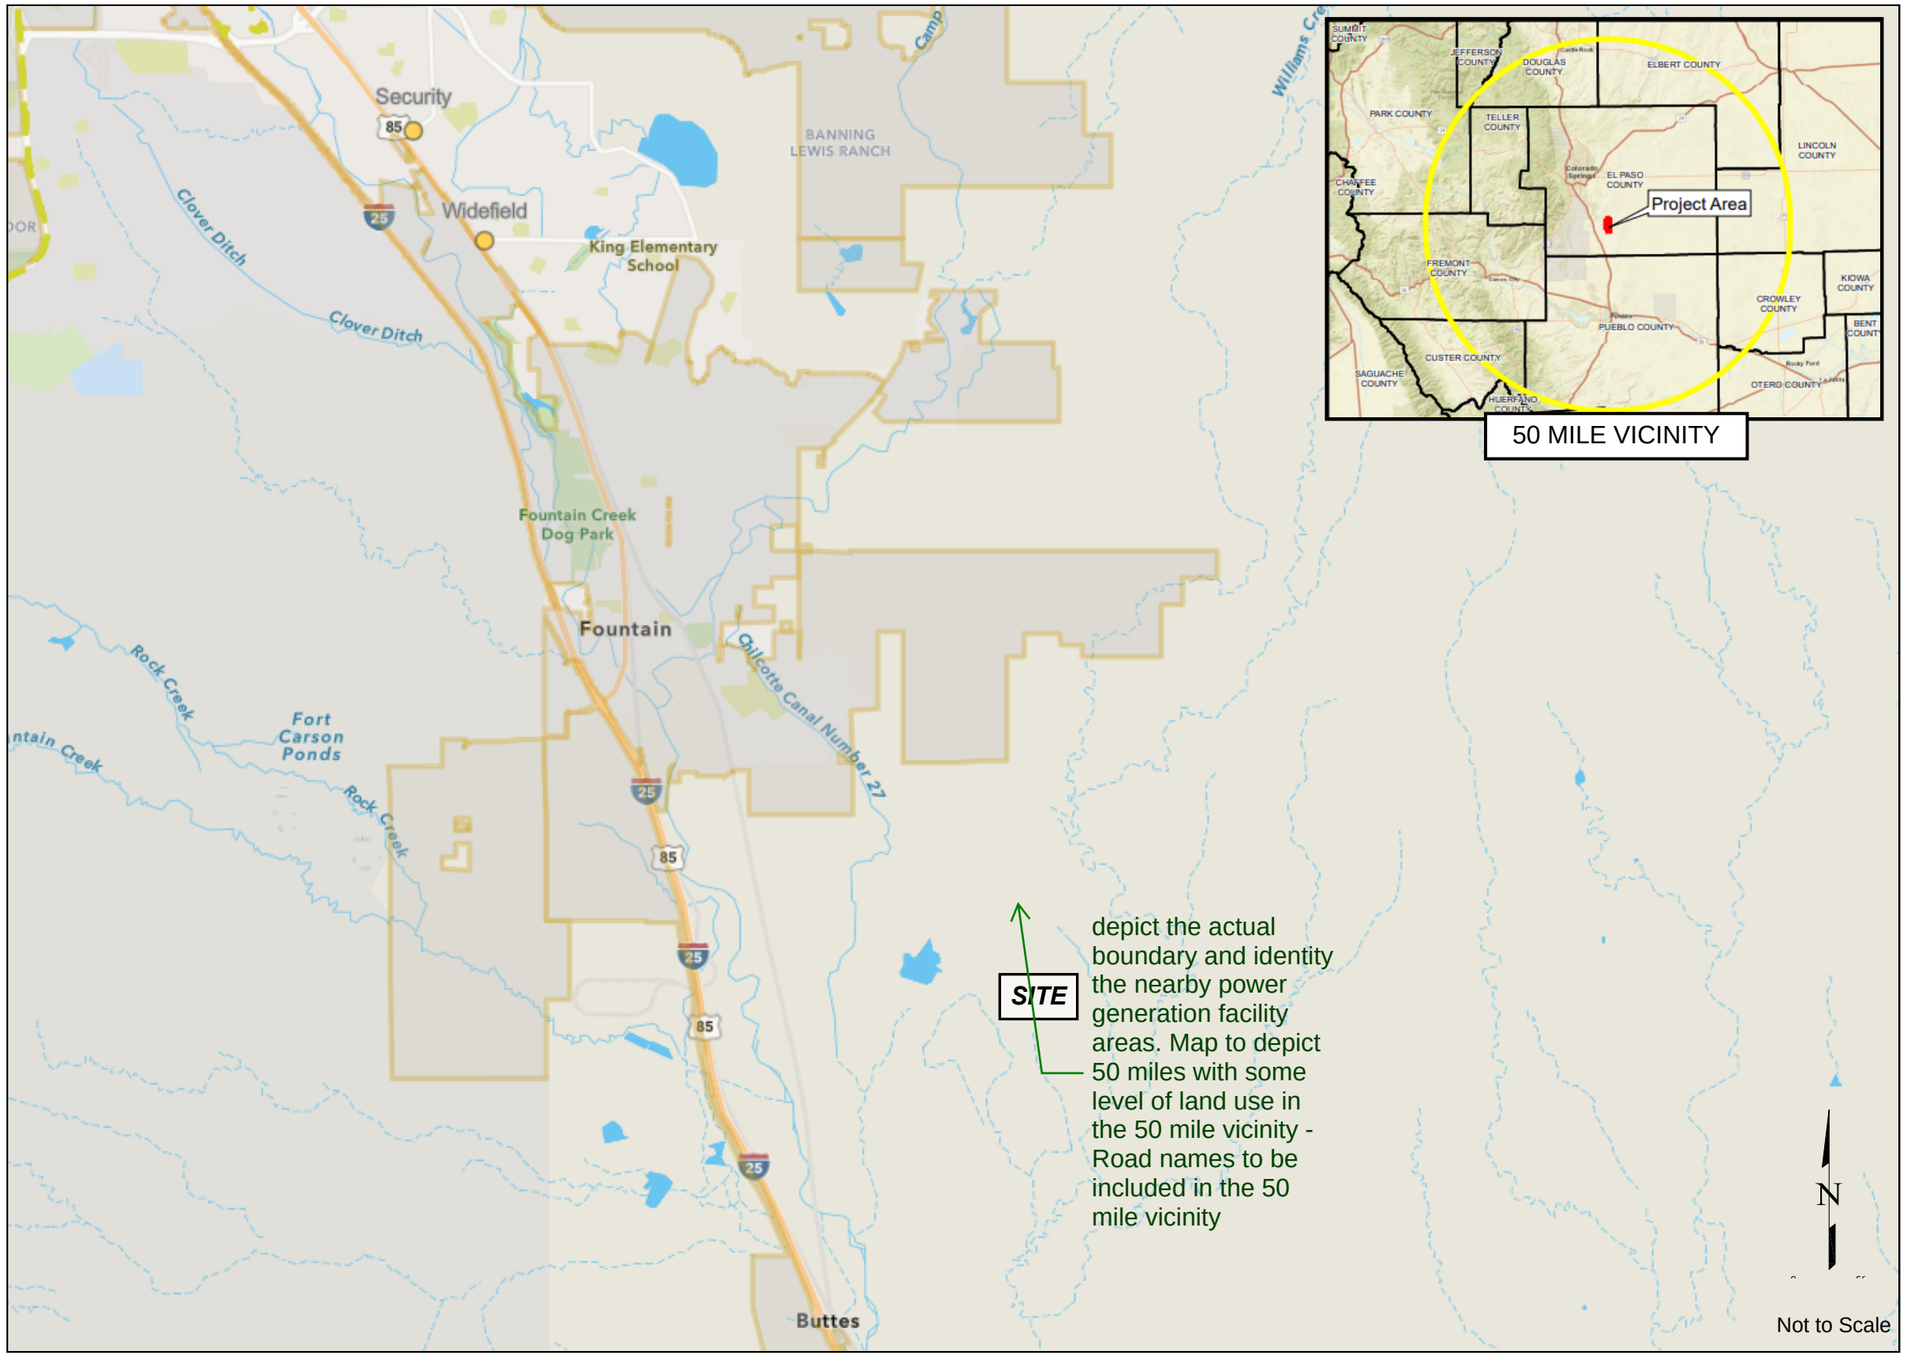

GENERAL NOTES


NO.	REVISION/ISSUE	DATE

VERTEX Consulting Services
5825 Delmonico Drive, Suite 320
Colorado Springs, CO 80919
303-906-8800

PROJECT NO.		SHEET
DATE	9/16/2026	1 of 1
PREPARED	APPROVED	
CAD	CAD	

V1_Vicinity-Location Map.pdf Markup Summary

dsdparsons (1)

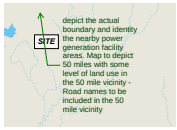

Subject: Callout
Page Label: 1
Author: dsdparsons
Date: 11/9/2026 9:52:34 AM
Status:
Color:
Layer:
Space:

depict the actual boundary and identity the nearby power generation facility areas. Map to depict 50 miles with some level of land use in the 50 mile vicinity - Road names to be included in the 50 mile vicinity