



**DD. Existing Transmission and Piping and Alternative Maps**

**For**

**Williams Creek Generating Station**

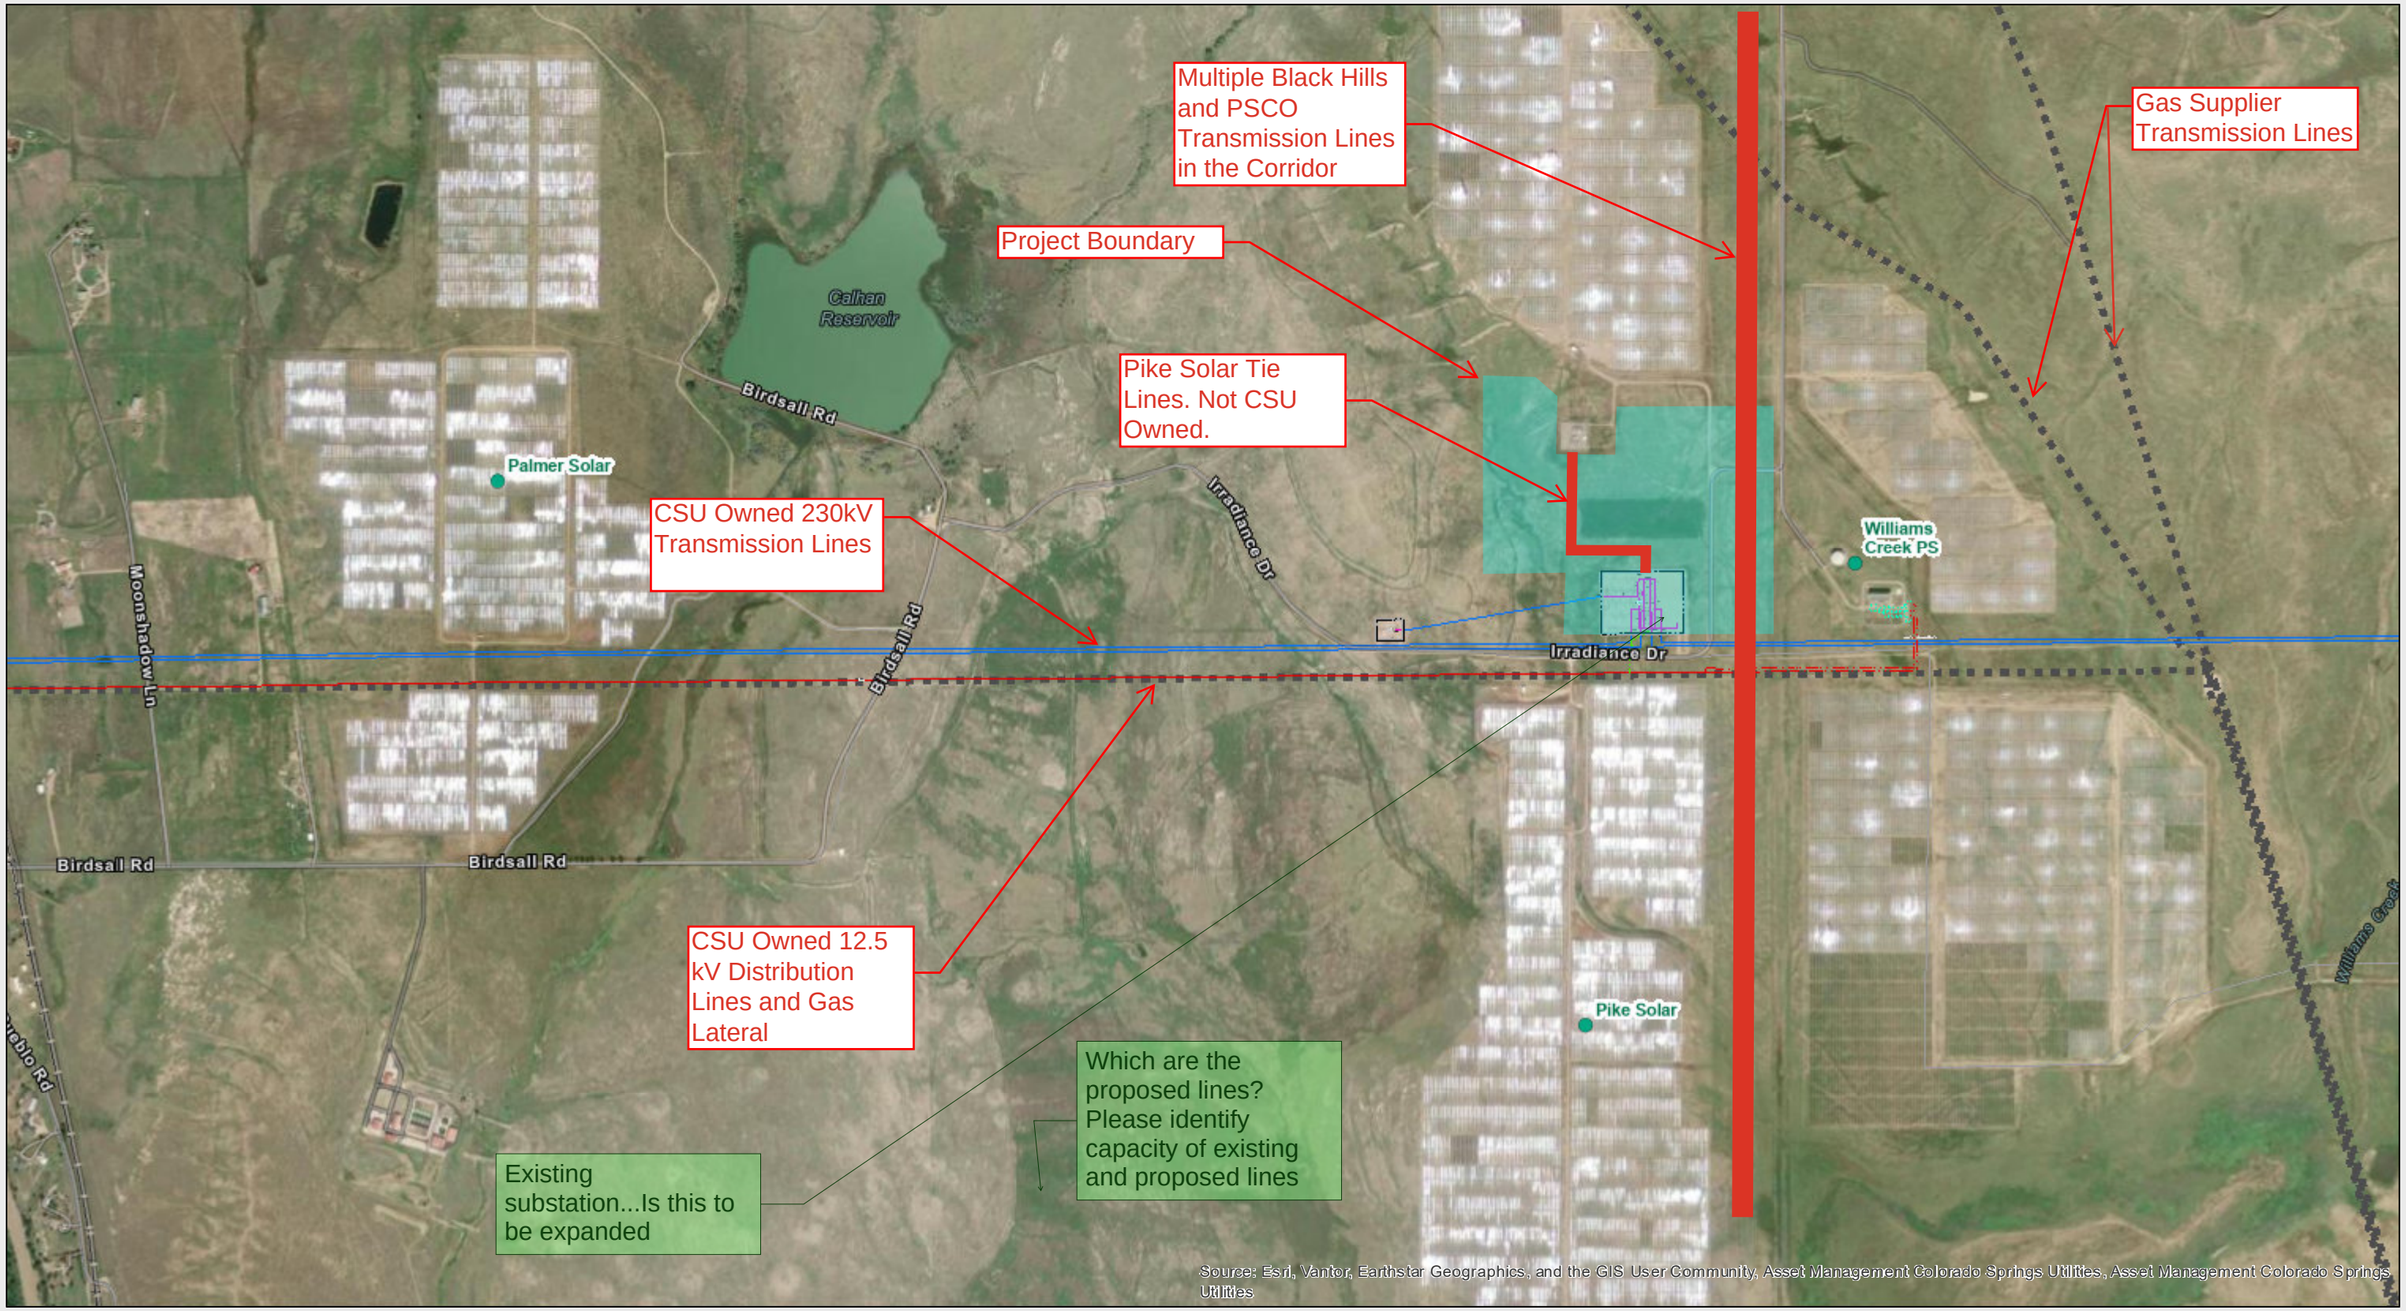


Colorado Springs Utilities
*It's how we're all connected*

1 inch = 1,505 feet


0 0.075 0.15 0.3 0.45 0.6

mi

Copyright © 2013 City of Colorado Springs on behalf of the Colorado Springs Utilities. All rights reserved.

**Plot File Created: September 21, 2026**

**ArcGIS Web AppBuilder**

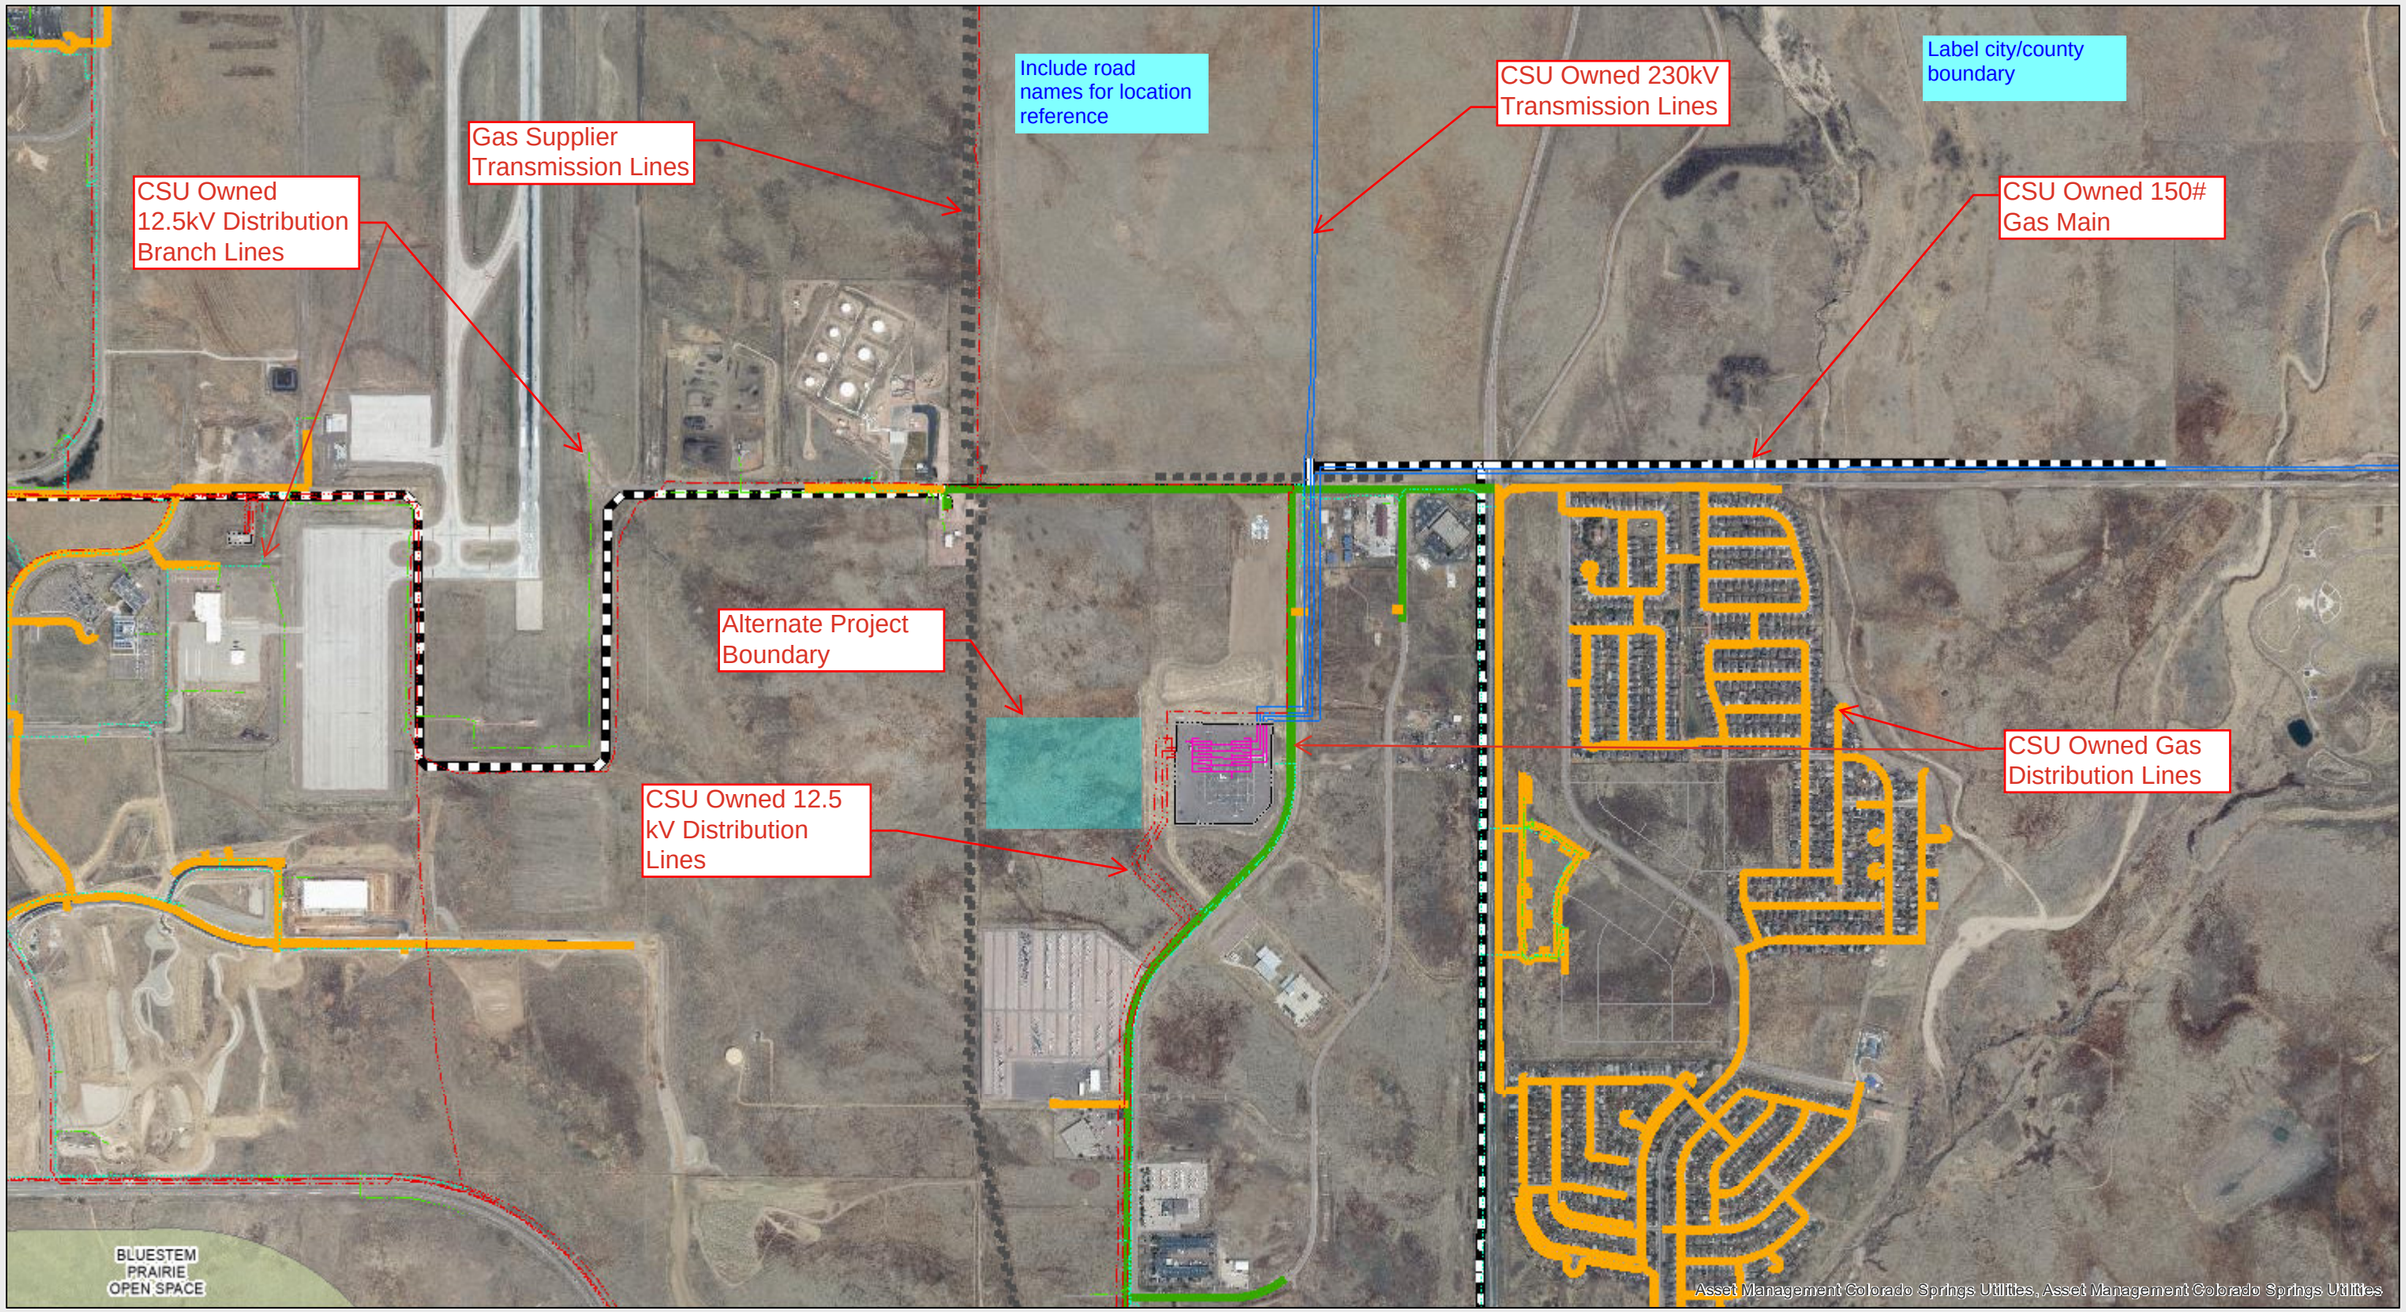


Colorado Springs Utilities
*It's how we're all connected*

1 inch = 1,505 feet

0 0.075 0.15 0.3 0.45 0.6

mi


**Plot File Created: September 21, 2026**

**ArcGIS Web AppBuilder**

Copyright © 2013 City of Colorado Springs on behalf of the Colorado Springs Utilities. All rights reserved.

# V1_Existing Transmission and Piping and Alternative Maps.pdf Markup Summary

## CDurham (2)

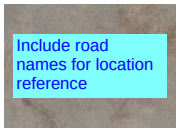


**Subject:** Text Box
**Page Label:** 3
**Author:** CDurham
**Date:** 11/5/2026 10:51:31 AM
**Status:**
**Color:**
**Layer:**
**Space:**

Include road names for location reference


---




**Subject:** Text Box
**Page Label:** 3
**Author:** CDurham
**Date:** 11/5/2026 10:54:40 AM
**Status:**
**Color:**
**Layer:**
**Space:**

Label city/county boundary


## dsdparsons (2)

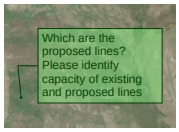


**Subject:** Planner
**Page Label:** 2
**Author:** dsdparsons
**Date:** 11/9/2026 9:55:26 AM
**Status:**
**Color:**
**Layer:**
**Space:**

Which are the proposed lines? Please identify capacity of existing and proposed lines

---

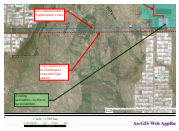

**Subject:** Planner
**Page Label:** 2
**Author:** dsdparsons
**Date:** 11/9/2026 9:55:46 AM
**Status:**
**Color:**
**Layer:**
**Space:**

Existing substation...Is this to be expanded