


LEGEND

- Chainlink Fence
- Wood Fence
- Wire Fence
- Fnd. Monument - Pipe
- Overhead Power Line

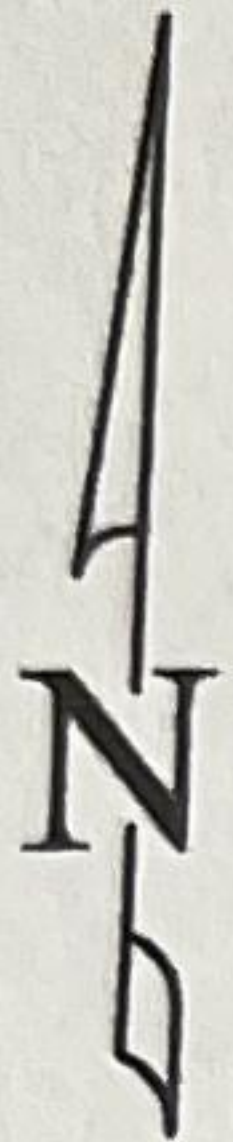


Scale: 1" = 100'

AG2232

APPROVED
Plan Review

08/24/2022 8:48:31 AM
dsdyounger

EPC Planning & Community
Development Department

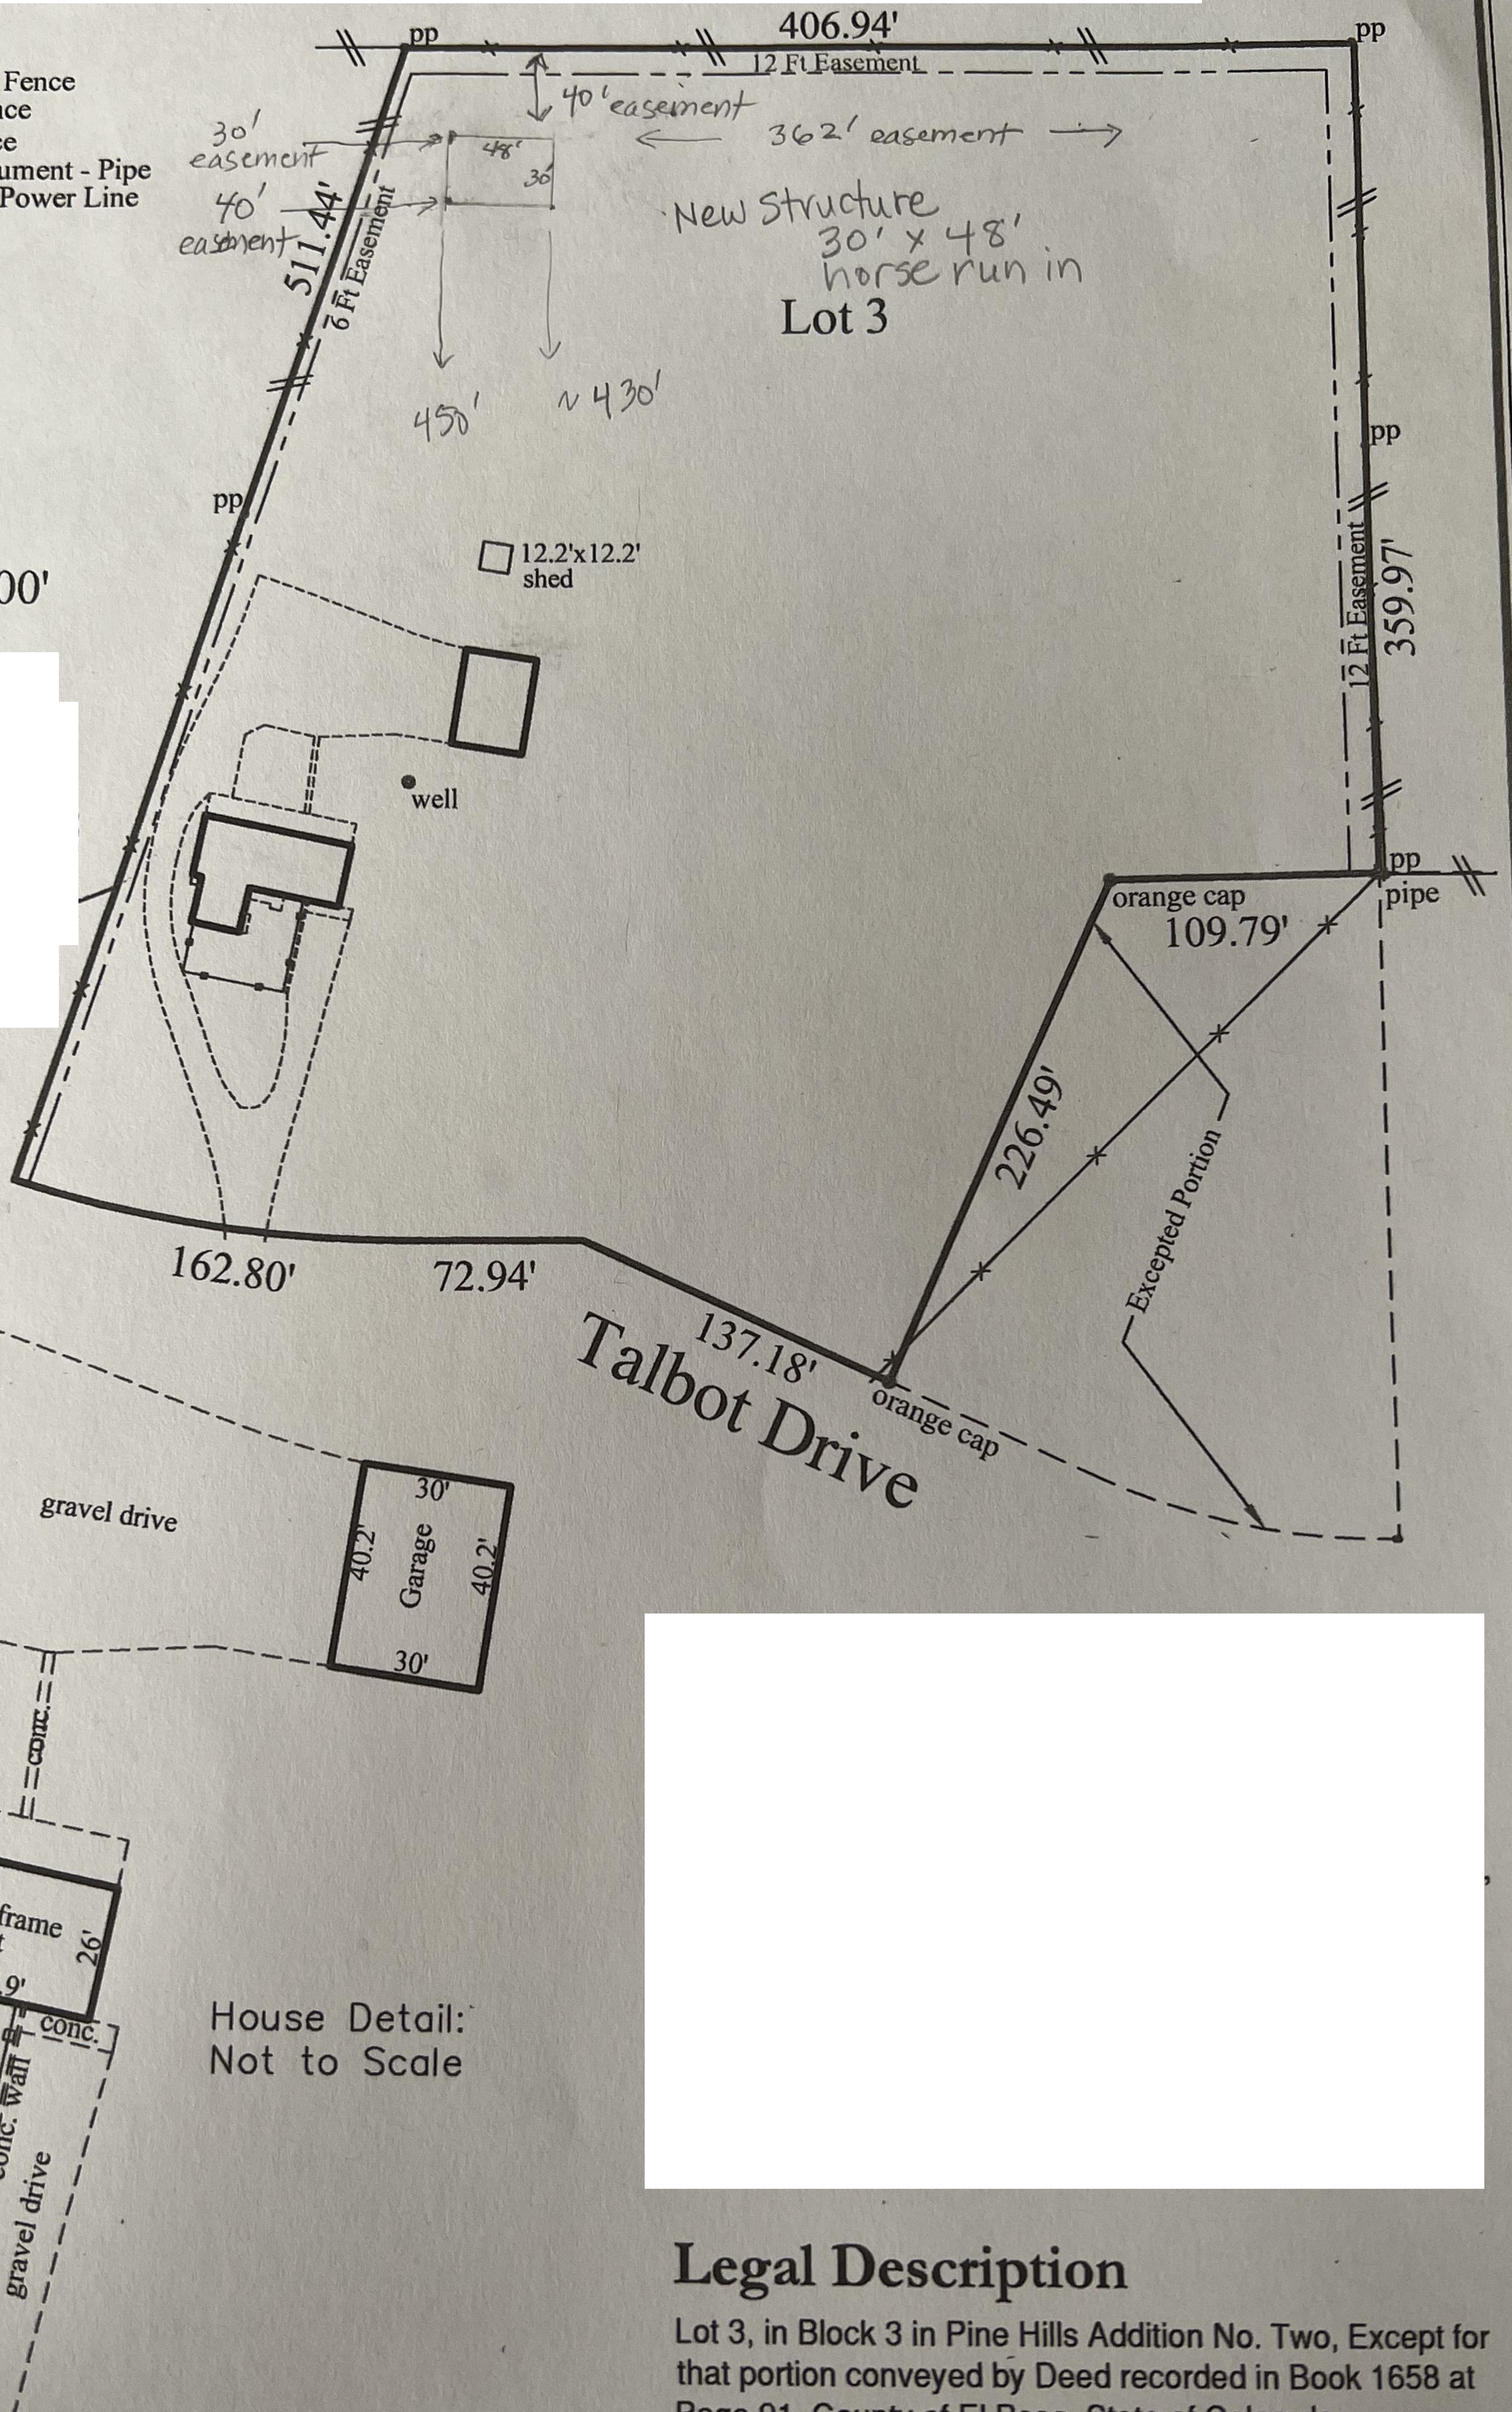

House Detail:
Not to Scale

Legal Description

Lot 3, in Block 3 in Pine Hills Addition No. Two, Except for that portion conveyed by Deed recorded in Book 1658 at Page 91. County of El Paso, State of Colorado